

923495

284-A-021

Permit # _____ City of Portland BUILDING PERMIT APPLICATION Fee _____ Zone _____ Map # _____ Lot# _____

Please fill out any part which applies to job. Proper plans must accompany form.

Owner: Marie Collins Phone # _____
Address: 30 Devon St. Portland

LOCATION OF CONSTRUCTION 36 Devon St.

Contractor: Ronny Duval Sub.: _____

Address: 10 White Birch Lane 04103 Phone # 797-7526

Est. Construction Cost: \$1,000.00 Proposed Use: attached/open deck

Past Use: _____

of Existing Res. Units _____ # of New Res. Units _____

Building Dimensions L _____ W _____ Total Sq. Ft. _____

Stories: _____ # Bedrooms _____ Lot Size: _____

Is Proposed Use: Seasonal _____ Condominium _____ Conversion _____

Explain Conversion to construct deck as per plans

For Official Use Only

Date: March 17, 1992 Subdivision: MAR 20 1992
 Inside Fire Limits _____ Name _____
 Bldg Code _____ Lot _____
 Time Limit _____ Ownership: Public
 Estimated Cost: \$1,000.00 Private

Zoning: R-3
Street Frontage Provided: _____
Provided Setbacks: Front _____ Back _____ Side _____

Review Required:
Zoning Board Approval: Yes _____ No _____ Date: _____
Planning Board Approval: Yes _____ No _____ Date: _____
Conditional Use: _____ Variance _____ Site Plan _____ Subdivision _____
Shoreland Zoning Yes _____ No _____ Floodplain Yes _____ No _____
Special Exception _____
Other (Explain) WRD-73-20-92

Foundation:

1. Type of Soil: _____
2. Set Backs - Front _____ Rear _____ Side(s) _____
3. Footings Size: _____
4. Foundation Size: _____
5. Other _____

Floor:

1. Sills Size: _____ Sills must be anchored.
2. Girder Size: _____
3. Lally Column Spacing: _____ Size: _____
4. Joists Size: _____ Spacing 16" O.C.
5. Bridging Type: _____ Size: _____
6. Floor Sheathing Type: _____ Size: _____
7. Other Material: _____

Exterior Walls:

1. Studding Size _____ Spacing _____
2. No. windows _____
3. No. Doors _____
4. Header Sizes _____ Span(s) _____
5. Bracing: Yes _____ No _____
6. Corner Posts Size _____
7. Insulation Type _____ Size _____
8. Sheathing Type _____ Size _____
9. Siding Type _____ Weather Exposure _____
10. Masonry Materials _____
11. Metal Materials _____

Interior Walls:

1. Studding Size _____ Spacing _____
2. Header Sizes _____ Span(s) _____
3. Wall Covering Type _____
4. Fire Wall if required _____
5. Other Materials _____

Ceiling:

1. Ceiling Joists Size: _____
 2. Ceiling Strapping Size _____ Spacing _____
 3. Type Ceilings: _____
 4. Insulation Type _____ Size _____
 5. Ceiling Height: _____
- HISTORIC PRESERVATION**
 Not in District nor Landmark.
 Does not require review.
 Requires Review.

Roof:

1. Truss or Rafter Size _____ Span _____
 2. Sheathing Type _____ Size _____
 3. Roof Covering Type _____
- Action: Approved
Approved with Conditions
Denied

Chimneys:

Type: _____ Number of Fire Places _____ Date: 3/19/92
Signature: _____

Heating:

Type of Heat: _____

Electrical:

Service Entrance Size: _____ Smoke Detector Required Yes _____ No _____

Plumbing:

1. Approval of soil test if required Yes _____ No _____
2. No. of Tubs or Showers _____
3. No. of Flushes _____
4. No. of Lavatories _____
5. No. of Other Fixtures _____

Swimming Pools:

1. Type: _____
2. Pool Size: _____ x _____ Square Footage _____
3. Must conform to National Electrical Code and State Law.

Permit Received By Latini

Signature of Applicant Ronny Duval Date 3/19/92

CEO's District _____

CONTINUED TO REVERSE SIDE

Ivory Tag - CEO

White - Tax Assessor

PLOT PLAN



Done w/out Insp.

FEES (Breakdown From Front)

Base Fee \$ 25.00
 Subdivision Fee \$ _____
 Site Plan Review Fee \$ _____
 Other Fees \$ _____
 (Explain) _____
 Late Fee \$ _____

Type	Inspection Record	Date
_____	_____	____/____/____
_____	_____	____/____/____
COMMENTS plot plan and construction plan submitted

CERTIFICATION

I hereby certify that I am the owner of record of the named property, or that the proposed work is authorized by the owner of record and that I have been authorized by the owner to make this application as has authorized agent and I agree to conform to all applicable laws of this jurisdiction. In addition, if a permit for work described in this application is issued, I certify that the code official or the code official's authorized representative shall have the authority to enter areas covered by such permit at any reasonable hour to enforce the provisions of the code(s) applicable to such permit.

Bernie Duval
SIGNATURE OF APPLICANT

10 White Birch Lane Portland Me.
ADDRESS

797-3526
PHONE NO.

RESPONSIBLE PERSON IN CHARGE OF WORK, TITLE

PHONE NO.

MORTGAGE LOAN INSPECTION PLAN

36 DEVON STREET
PORTLAND, MAINE



No. 576-00

TO THE LENDING INSTITUTION AND ITS TITLE INSURER
I hereby certify that the location of the dwelling shown
on this plan did conform with the local zoning
laws in effect at the time of construction. The property
does not fall within a special flood hazard zone.

BUYER MARIE A. COLLINS
SELLER HAZEL R. AUCLIN

BOOK 4135 PAGE 178 COUNTY CHAMBERLAND

PLAN BOOK 8 PAGE 11 LOT 157 PART OF 154,
155, + 156

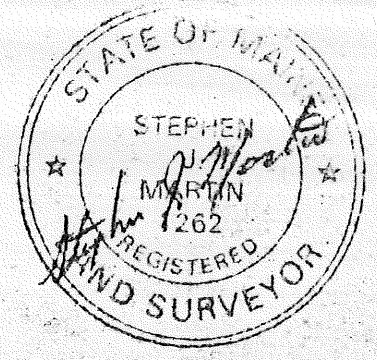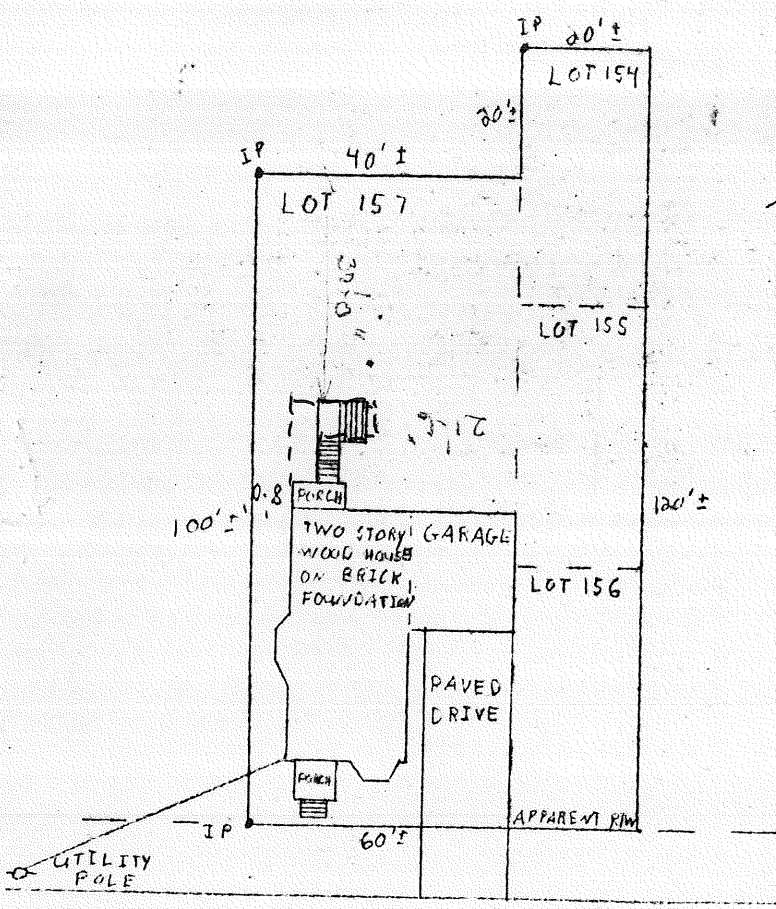

DEVON STREET
(BITUMINOUS)

RIGGS STREET
(BITUMINOUS)

RECEIVED
MAR 19 1992

DEPT. OF BUILDING INSPECTIONS
CITY OF PORTLAND

THIS IS NOT A BOUNDARY SURVEY. This plan is based strictly on information provided by others and does not take into consideration any conflicts which abutting descriptions may contain. This plan was not made from an instrument survey. The certifications are for mortgage purposes only. This plan applies only to conditions existing as of the date shown hereon. This plan is not for recording.

Date 6-17-86 Scale 1" = 30'

RP TITCOMB ASSOCIATES, INC. Falmouth, Maine

Drawn By JLV