

**1.1 REFERENCE MATERIAL FOR DESIGN CALCULATIONS**

- 2009 International Building Code
- American Concrete Institute (ACI) 318-08
- Embedment Properties for Headed Studs, TRW Nelson, Design Data Catalog
- Steel Construction Manual, AISC 360-05
- ASCE 7-05

**1.2 DESIGN CRITERIA USED IN CALCULATIONS**

- Reinforcing Steel Yield Strength =  $f_y = 60$  ksi
- Structural Steel is ASTM A 36/A 36M-05
- Unconfined Compressive Strength of Concrete =  $f'_c = 5000$  psi
- Weight of Concrete = 115 pcf
- Stud Yield Strength = 50 ksi

**1.3 INTERNATIONAL BUILDING CODE REQUIREMENTS**

The following is a summary of the Code requirements applicable to CellXion precast concrete equipment shelters.

**1.3.1 Occupancy Classification**

Occupancy may be Group S-2 per sec 311.3, Group B per sec 304.1 or Group U per sec 312.1.

**1.3.2 Construction Type**

Type V-B per section 602.5 and Table 601.

**1.3.3 Building Limitations**

Occupancy S-2 or B or U

Relative to the location of the nearest structure or property line:

Walls must be rated one hour if less than 10 feet. ( Table 602 )

Maximum size of S-2 building (Table 503) is 13,500 SF, 2 story. ( Table 503 )

Maximum size of B building (Table 503) is 9,000 SF, 2 story. ( Table 503 )

Maximum size of U building (Table 503) is 5,500 SF, 1 story. ( Table 503 )

**NOTE: STANDARD SHELTERS MAY BE RATED UP TO 2-HOURS.**

REF: Table 720.1(2), Item number 4-1.1, Sand-lightweight concrete 4 inches thick.

**IF PROTECTED OPENINGS ARE REQUIRED:**

**3/4 HOUR RATED OPENINGS ARE REQUIRED IN ONE HOUR ASSEMBLIES.**

**1.5 HOUR RATED OPENINGS ARE REQUIRED IN TWO HOUR ASSEMBLIES.**

<u>Unprotected Openings Allowed</u>	<u>Protected Openings Allowed</u>	Table 705.8
-------------------------------------	-----------------------------------	-------------

Not permitted up to 5 feet.	Not permitted up to 3 feet.
10% permitted > 5 feet to 10 feet.	15% permitted > 3 feet to 5 feet.
15% permitted > 10 feet to 15 feet.	25% permitted > 5 feet to 10 feet.
25% permitted > 15 feet to 20 feet.	45% permitted > 10 feet to 15 feet.
45% permitted > 20 feet to 25 feet.	75% permitted > 15 feet to 20 feet.
70% permitted > 25 feet to 30 feet.	No restriction > 20 feet.
No restriction > 30 feet.	

**1.4 FLOOR LOADS**

Floor live load required (Table 1607.1) for light storage is; 125 psf

The summary loading chart in Section 2.0.1 indicates allowable loads of:

251 psf 10.000 ft wide **OK**

For a 2 sq ft area per sec 2.3.6, a concentrated load of 2020 lbs can be placed anywhere.

If the concentrated load is next to the wall, 4522 lbs can be used.

For a 3 sq ft area per sec 2.3.6, a concentrated load of 4041 lbs can be placed anywhere.

**1.5 ROOF LOADS** Minimum roof live load required (2009 IBC 1607.11.2.1) is:

$$L_r = L_o R_1 R_2 \quad [\text{sec 1607.11.2.1, Eq 16-25}]$$

$$L_o = 20 \quad [\text{sec 1607.11.2.1}]$$

$$R_1 = 1.0 \quad (\text{worst case for smaller shelters}) \quad [\text{sec 1607.11.2.1, Eq 16-26}]$$

$$F = .167 \text{ in per ft slope} \quad R_2 = 1.0 \quad (\text{for } F < 4) \quad [\text{sec 1607.11.2.1, Eq 16-29}]$$

$$L_r = 20 \text{ psf}$$

The summary loading chart in Section 2.0.1 indicates allowable loads of:  
135 psf      10.00 ft wide **OK**

**Snow Loads** Section 1608.2 requires use of section 7 of ASCE 7-05

$$p_f = 0.7 C_e C_t I p_g \quad [\text{ASCE 7-05, Equation 7-1, Sec 7.3}]$$

$p_f =$  (Min. design load for roofs from section 2 of these calcs)  
 $=$  135 psf      10.00 ft wide

$C_e =$  1.2 (worst case-ASCE 7-05, Table 7-2, lesser factors may be used as appropriate)  
 $C_t =$  1.0 (From ASCE 7-05, Table 7-3, heated structure)  
 $I =$  1.0 (Category II, ASCE 7-05 Table 7-4)

Using the design load from section 2 for  $p_f$  and solving for  $p_g$ :

$$p_g = p_f / (0.7 C_e C_t I)$$

$=$  **(Allowable ground snow load)**  
 $=$  161 psf      10.00 ft wide

**1.6 WIND LOADS**

Sect. 1609.1.1 allows ASCE 7-05, Chapter 6; use sec 6.4, Method 1 - Simplified Procedure:

$V =$  160 mph      [ASCE 7-05, Section 6.5.4 and Figure 6-1]  
 $I =$  1.0      [ASCE 7-05, Category II, Table 6-1 >> Table 1-1]  
 Exposure Classification: C      [ASCE 7-05, section 6.5.6.3]  
 Exposure C category:  $\lambda = 1.21$       [ASCE 7-07, section 6.4.2 & Figure 6-2]  
 Enclosure Classification: enclosed [ASCE 7-05, section 6.2]  
 Roof angle: 0 to 5 degrees       $K_{zt} = 1.0$       [ASCE 7-05, sec 6.5.7.2]  
 MWFRS Design Wind Pressures: [from ASCE 7-05, Figure 6-2]  
 $p_s = \lambda K_{zt} I p_{s30}$       [ASCE 7-05, sec 6.4.2.1, Eq 6-1]

WALLS: **48.4 psf**      [zone A]  
 -25.4 psf      [zone B, negligible--> only 1 inch tall]  
 32.5 psf      [zone C]  
 -15.1 psf      [zone D, negligible--> only 1 inch tall]

Zone A controls, use it for analysis

Allowable load on walls: 87.3 psf (Calcs sec 2.0.1)      9.25 ft tall      **OK**

ROOF: **-59.0 psf**      [zone E]  
 -33.6 psf      [zone F]  
 -40.9 psf      [zone G]  
 -25.9 psf      [zone H]

Zone E controls, use it for analysis

Allowable negative load on roof: -53.1 psf (Calcs, sec 2)      10.00 ft wide  
 Plus .6 x DL ( 45.7 psf = 27.4 psf + Allow Neg Ld = -80.6 psf      **OK**

**1.6.1 Check structural connections for carrying wind loads to the foundation.**

The worst case for the windward forces are when they are projected onto the long walls. Half of the load is carried to the floor connections and half is carried to the roof connections. The walls are assumed to be 9.25 ft tall the worst case scenario. The connections which connect the long walls to the end walls are neglected for the purposes of this particular analysis. Analysis with Calculations from section 3

**1.6.1.1 Check connections for transfer of windward loads from wall to the floor and roof.**

The connections along the top and bottom of the walls are at a standard spacing of 56 inches. This will be the tributary width of wind load for each connection at the floor and roof. The load for this tributary area on the windward wall is then:

$$P'(w) = P(\text{windward wall}) \times \text{tributary area} \quad (\text{for } 9.25 \text{ ft tall wall})$$
$$\text{Where tributary area} = (9.25 \text{ ft} / 2) \times 4 \text{ ft } 8 \text{ in} = 21.58 \text{ sq. ft.}$$
$$= 48.4 \text{ psf} \times 21.58 \text{ sq. ft.}$$
$$P'(w) = 1,045 \text{ lbs}$$

This load is resisted by three main components of the connection at the floor:

- 5.95 kips Capacity of P/N 223100 in tension per Clacs Section 3.3.1
- 22.87 kips Capacity of the Floor Lifting Insert in shear per Clacs Section 3.7
- 8.35 kips Capacity of the weld which connects the plates per Clacs Section 3.8

**The capacity of all 3 components exceed the wind load OK**

This load is resisted by three main components of the connection at the roof:

- 3.52 kips Capacity of P/N 223000 in Y-shear per Clacs Section 3.4.3
- 5.95 kips Capacity of P/N 222000 in tension per Clacs Section 3.5.1
- 8.35 kips Capacity of the weld which connects the plates per Clacs Section 3.8

**The capacity of all 3 components exceed the wind load OK**

**1.6.1.2 Check connections for transfer of leeward loads from wall to the floor and roof.**

The leeward wall has similar construction, but the loads are less and are outward.

$$P'(l) = P(\text{leeward wall}) \times \text{tributary area}$$
$$\text{Where tributary area} = (9.25 \text{ ft} / 2) \times 4 \text{ ft } 8 \text{ in} = 21.58 \text{ sq. ft.}$$
$$= 48.4 \text{ psf} \times 21.58 \text{ sq. ft.}$$
$$P'(l) = 1,045 \text{ lbs} \quad (\text{negative indicating an outward direction})$$

This load is resisted by three main components of the connection at the floor:

- 5.95 kips Capacity of P/N 223100 in tension per Section 3.3.1
- 22.87 kips Capacity of Floor Lifting Insert in shear per Section 3.7
- 8.35 kips Capacity of the weld which connects the plates per Section 3.8

**The capacity of all 3 components exceed the wind load OK**

This load is resisted by three main components of the connection at the roof:

- 3.52 kips Capacity of P/N 223000 in Y-shear per Section 3.4.3
- 5.95 kips Capacity of P/N 222000 in tension per Section 3.5.1
- 8.35 kips Capacity of the weld which connects the plates per Section 3.8

**The capacity of all 3 components exceed the wind load OK**

**1.6.1.3 Windward and leeward loading transfer to endwalls:**

The loads on the top half of the shelter must be transferred to the ground through the connections on the endwalls. There are three connections from the roof to the endwall and three connec-

tions from the endwall to the floor. The load on the projected area of the top half of the long side of the shelter is resisted by these connections and is assumed to distribute half of the load to each endwall.

A shelter which is 18.00 feet long has a tributary area of:  
 Area = ( 9.667 feet / 2 ) x ( 18.0 feet / 2 )  
 43.502 sq. ft.  
 P(proj.)= 43.502 sq ft x 48.4 psf  
 = 2,105 lbs.

The roof connection consist of the same three components as were indicated in the sidewalls, except that they are loaded in a different direction. Their capacities are shown below.

- 7.04 kips Capacity of P/N 223000 in X-shear per Section 3.4.2
- 22.87 kips Capacity of the Wall Corner Insert per Section 3.6.1
- 8.35 kips Capacity of the weld which connects the plates per Section 3.8

Since there are three of these connections, the total capacity is: 21.12 kips **OK**

**1.6.1.4 Windward and Leeward loading transfer to floor:**

The same loads that are transferred to the endwalls from the roof need to be transferred to the floor panel. This is accomplished through the three connections at the base of the endwall. The floor connections consist of the same three components as were indicated in the sidewalls, except that they are loaded in a different direction. Their capacities are shown below.

- 14.54 kips Capacity of P/N 223100 in X-shear per Section 3.3.2
- 22.87 kips Capacity of Floor Lifting Insert in shear per Section 3.7
- 8.35 kips Capacity of the weld which connects the plates per Section 3.8

Since there are three of these connections, the total capacity is: 25.05 kips **OK**

**1.6.1.5 Find horizontal forces and overturning moments.**

This is used in the tie-down anchor analysis in 1.8 below.

Shelter Dims (feet)			Shelter Weight lbs	Hor.Wind (PxA-hor) lbs	Vert. Wind (PxA-vert.) lbs	Overturn Moment ft-lbs
Width	Length	Height				
10.00	18.00	10.083	35,103	8,785	10,629	97,432

**1.6.1.6 Components and Cladding:**

$$p_{net} = \lambda K_{zt} I p_{net30} \quad [ \text{ASCE 7-05, sec 6.4.2.2, Eq 6-2} ]$$

POS      NEG      [ from ASCE 7-05, Figure 6-3 ]

- ROOF ZONE 1: 18.0 -51.1 (100 sf effective wind area) use for analysis
- ROOF ZONE 2: 21.5 -84.1 (20 sf effective wind area)
- ROOF ZONE 3: 22.7 -141.3 (10 sf effective wind area)

Allowable positive load on roof: (From section 2)  
 135 psf      10.00 ft wide shelter

Allowable negative load on roof: (From section 2, neglecting DL)  
 -53.1 psf      10.00 ft wide shelter

Allowable negative load on roof: (From section 2, including .6 x DL)

Roof Dead Load: 45.7 psf X .6 = 27.4 psf  
 -80.6 psf      10.00 ft wide shelter **OK**

- WALL ZONE 4: 45.0 -49.6 (200 sf effective wind area) use for analysis
- WALL ZONE 5: 52.4 -67.8 (30 sf effective wind area)



Allowable load on walls: (From section 2)

87 psf                      9.25 ft tall wall                      **OK**

The larger load at the corners does not produce a significant bending stress, and the shear strength of the roof panel will be more than adequate to resist this uplift load. In addition, extra connections between the roof and endwalls anchor the roof at these end zones.

**1.7 SEISMIC LOADS**                      Section 1613.1, requires ASCE 7-05 for analysis.

Site Class is    E                      [ Section 1613.5.2 ]

Occupancy Category:                      II                      [ Table 1604.5 ]

Seismic Design Category:                      D                      [ sec 1613.5.6 ]

Seismic Importance Factor, I is:    1.50                      [ ASCE 7-05, sec 11.5, Table 11.5-1 ]

$V = C_s W$                       [ ASCE 7-05, sec 12.8.1, Eq. 12.8-1 ]

$W = D$                       [ ASCE 7-05, sec 12.7.2 ]

$C_s = S_{DS} / (R / I)$                       [ ASCE 7-05, sec 12.8.1.1, Eq. 12.8-2 ]

$V = (S_{DS} / (R / I)) D$

$R = 4$                       [ ASCE 7-05, Table 12.2-1, A.2 ]

$S_{DS} = 2/3 S_{MS}$                       [ Per 1613.5.4, Eq. 16-39 ]

$S_{MS} = F_a S_s$                       [ Per 1613.5.3, Eq. 16-37 ]

$F_a = 1.0$  [ Table 1613.5.3(1) ]

$S_s = 3.00$  [ Fig 1613.5(1), meets all US areas ]

$S_{MS} = 3.00$

$S_{DS} = 2.00$

$V = 0.750 D$                       [ Use for base shear ]

Determine E for use in load combinations on individual panel design.

$E = E_h + E_v$                       [ ASCE 7-05, sec 12.4.2, Eq. 12.4-1 ]

$E_h = \rho Q_E$                       [ ASCE 7-05, sec 12.4.2.1, Eq. 12.4-3 ]

$E_v = 0.2 S_{DS} D$                       [ ASCE 7-05, sec 12.4.2.2, Eq. 12.4-4 ]

$E = \rho Q_E + 0.2 S_{DS} D$                       [ ASCE 7-05, sec 12.4.2.1, Eq. 12.4-3 plus sec 12.4.2.2, Eq. 12.4-4 ]

$Q_E = V$                       [ ASCE 7-05, sec 12.4.2.1 ]                       $\rho = 1.0$                       [ ASCE 7-05, sec 12.3.4.2 ]

$E = \rho V + 0.2 S_{DS} D = 1.150 D$                       [ Use in load comb 4 & 6 ]

$E_m = E_{mh} - E_v$                       [ ASCE 7-05, sec 12.4.3, Eq. 12.4-6 ]

$E_{mh} = \Omega_0 Q_E$                       [ ASCE 7-05, sec 12.4.3.1 Eq. 12.4-7 ]

$E_m = \Omega_0 Q_E - 0.2 S_{DS} D$                        $\Omega_0 = 2.5$                       [ ASCE 7-05, Table 12.2-1, A.2 ]

$E_m = 1.475 D$                       [ Use in load comb 7 ]

$D_{wall} = 36.3 \text{ psf}$                        $D_{roof} = 45.7 \text{ psf}$                        $D_{floor} = 43.8 \text{ psf}$                       (calcs sec 4)

**Load combinations:**                      Section 1605.3.1 & ASCE 7-05 12.4.3.2

Comb 1    D                      [ Notes 1, 2, 3 ]

Comb 2    D + L                      [ Notes 1, 2, 3 ]

Comb 3    D + L + (Lr or S or R)                      [ Notes 1, 2, 3 ]

Comb 4    D + (W or 0.7E) + L + (Lr or S or R)                      [ Notes 1, 2, 3, 4 ]

Comb 5    0.6 D + W                      [ Notes 1, 2, 3 ]

Comb 6    0.6D + 0.7E                      [ Notes 1, 2, 3, 4 ]

Comb 7    (0.9-2S<sub>DS</sub>)D +  $\Omega_0 Q_E$                       See analysis below:

Note 1: Roof and floor panels are designed using 1.4D and 1.7L, exceeds req'd factors.

Note 2: Wall panels are designed using 1.4D and 1.7W, exceeds req'd factors.

Note 3: S, R, and Lr are used as L in panel calculations, see section 2 of these calcs.

Note 4: Wind loads control over Seismic.

			psf	Min. Design Loads	
Comb 7 check					
Walls:	$(0.9 \cdot 2S_{DS})D + \Omega_0 Q_E = 2.375 D_{wall} =$		86	87 psf	<b>OK</b>
Roof:	$(0.9 \cdot 2S_{DS})D + \Omega_0 Q_E = 2.375 D_{roof} =$		109	135 psf	<b>OK</b>
Floor:	$(0.9 \cdot 2S_{DS})D + \Omega_0 Q_E = 2.375 D_{floor} =$		104	251 psf	<b>OK</b>

**1.7.1 Seismic loads from top half of the wall panel are transferred to the roof.**

Equipment permanently installed in the building is estimated at 10,000 pounds. For a 18.00 ft long shelter, this is an average of 556 pounds per linear foot. If this equipment is mounted to the floor and braced at the top, then half the seismic load from the equipment should be added to the top of the walls. Analysis uses sec 3 of these calculations.

The weight of a wall section transferred to the connections at 56" on center is:

$$W(\text{wall}) = (56/12 \text{ ft width}) \times (9.25 \text{ ft high}) \times (4/12 \text{ ft thick}) \times (115 \text{ pcf}) = 827 \text{ lbs}$$

$$W(\text{equipment}) = (56/12 \text{ ft width}) \times (277.778 \text{ plf}) = 1296 \text{ lbs}$$

$$W(\text{top of wall}) = W(\text{wall}) + W(\text{equipment}) = 2,124 \text{ lbs}$$

For the wall panel, the seismic shear is:

$$V = 1,593 \text{ lbs} \quad \text{Seismic shear per connection plate at top of walls}$$

This load is resisted by three main components of the connection at the floor:

5.95 kips Capacity of P/N 223100 in tension per Section 3.3.1

22.87 kips Capacity of Floor Lifting Insert in shear per Section 3.7

8.35 kips Capacity of the weld which connects the plates per Section 3.8

**The capacity of all 3 components exceed the seismic load OK**

This load is resisted by three main components of the connection at the roof:

3.52 kips Capacity of P/N 223000 in Y-shear per Section 3.4.3

5.95 kips Capacity of P/N 222000 in tension per Section 3.5.1

8.35 kips Capacity of the weld which connects the plates per Section 3.8

**The capacity of all 3 components exceed the seismic load OK**

**1.7.2 Seismic loads from roof are transferred to the top of the endwall.**

The seismic load at the top connection plates of the endwalls includes the seismic loads from the top quarter of two sidewalls, one half of the roof, and one half of the total equipment.

Use a 9.25 ft tall x 17.33 ft long wall & use a 10.33 ft wide x 18.33 ft long roof.

$$W(\text{quarter wall}) = 9.25 \text{ ft} / 2 \times 17.33 \text{ ft} / 2 \times 4.00 / 12 \text{ ft} \times 115 \text{ pcf} = 1,537 \text{ lbs.} \times 2 = 3,073 \text{ lbs.}$$

$$W(\text{half roof}) = 10.33 \text{ ft} \times 18.33 \text{ ft} / 2 \times 4.50 / 12 \text{ ft} \times 115 \text{ pcf} = 4,085 \text{ lbs.}$$

$$W(\text{equipment}) = 9 \text{ ft} \times 277.7778 \text{ plf} = 2,500 \text{ lbs}$$

$$\text{TOTAL: } W(\text{top of endwall}) = 9,658 \text{ lbs.}$$

$$\text{The seismic load is then: } V(\text{top of endwall}) = 7,243 \text{ lbs.}$$

The roof connection consist of the same three components as were indicated in the sidewalls, except that they are loaded in a different direction. Their capacities are shown below.

- 7.04 kips Capacity of P/N 223000 in X-shear per Section 3.4.2
- 22.87 kips Capacity of the Wall Corner Insert per Section 3.6.1
- 8.35 kips Capacity of the weld which connects the plates per Section 3.8

Since there are three of these connections, the total capacity is:

21.12 kips **This capacity exceeds the seismic load** **OK**

**1.7.3 Seismic loads from endwall are transferred to the floor.**

The connections at the bottom of the endwalls have the same seismic load as the connections at the top, except that the seismic load from the endwall itself is added.

The weight of the endwall is:

$$W(\text{endwall}) = 10.00 \text{ ft} \times 4.00 / 12 \text{ ft} \times 115 \text{ pcf} \times 9.25 \text{ ft} = 3546 \text{ lbs}$$

$$V(\text{endwall}) = 2,659 \text{ lbs}$$

$$V(\text{bottom}) = V(\text{top of endwall}) + V(\text{endwall}) = 9,903 \text{ lbs}$$

The same loads that are transferred to the endwalls from the roof need to be transferred to the floor panel. This is accomplished through the three connections at the base of the endwall.

The floor connections consist of the same three components as were indicated in the sidewalls, except that they are loaded in a different direction. Their capacities are shown below.

- 14.54 kips Capacity of P/N 223100 in X-shear per Section 3.3.2
- 22.87 kips Capacity of Floor Lifting Insert in shear per Section 3.7
- 8.35 kips Capacity of the weld which connects the plates per Section 3.8

Since there are three of these connections, the total capacity is:

25.05 kips **This capacity exceeds the seismic load** **OK**

**1.8 Check shelter tie-downs to foundation**

For tie-down anchor capacity see Section 3.9 of these calcs:

Horizontal: 10472 lbs Per connection  
Vertical: 6615 lbs Per connection

Horizontal forces due to seismic/wind loads:

Shelter Dims (feet)			Shelter Weight	Contents Weight	Seis.Load (W x Cs)	Wind load 1.6.1.5	Control'g Load	Tie-down Capacity	CHECK	Safety Factor
10.00	18.00	10.083	35,103	10,000	33,827	8,785	SEISMIC	41,887	OK	1.24

Friction against sliding is ignored.

shelters under 24 ft in length have 4 tie-downs; lengths 24 ft and over have 8 tie-downs

Overturning forces due to seismic/wind loads:

Shelter Dims (feet)			Seis.load (W x Cs) lbs.	Overturn Force lbs.	Wind Over. See 1.6.1.5 ft-lbs.	Control'g Load	Overturn Resist. ft-lbs.	Tie-down Capacity lbs	CHECK	Safety Factor 1.5 req'd
10.00	18.00	10.083	33,827	170546	97,432	SEISMIC	157963	41,887	OK	2.15

Overturning resistance uses 0.9 x DL of shelter (no contents)

Weight of shelter and contents are the same as in the horizontal force chart above.

**2.0 DESIGN CRITERIA**

NOTE: These calculations represent the panels of a  
10.000 ft wide x 18.000 ft long x 9.250 ft tall shelter.

<u>STRUCTURAL PROPERTY</u>	<u>UNITS</u>	<u>LABEL</u>
Concrete Compressive Strength	5000 psi	f <sub>c</sub> (sand-lightweight)
Reinforcing bar Yield Stress	60000 psi	f <sub>y</sub> [REBAR]
Concrete Density	115 pcf	DENSITY
Maximum Building Width	10 feet	BLDGW
Maximum Building Length	18 feet	BLDGL
Maximum Wall Panel Height	9.25 feet	WALLH
Max. Est. weight of Shelter	35,103 LBS.	BLDGWT
Concrete volume req'd.	10.55 YDS.	CONCYDS
Roof thickness at peak	5 inches	H[ROOF]
Roof thickness at edge	4 inches	
Rebar size used in roof #	4 Rebar	REBARROOF
Steel mesh used in roof:	W4 Wire	
Steel spacing in roof (12"max.)	4 inches	
Lateral rebar spacing: roof	12 inches	ROOFSPACING12
Longitudinal rebar spacing-roof:	18 inches	
Steel mesh used in wall:	W4 Wire	REBARWALL
Add vert steel used in wall #	4 Rebar	REBARWALL2
Steel spacing in wall (12"max.)	4 inches	WALLSPACING
Vertical Rebar spacing in wall	36 inches	WALLSPACING2
Horizontal rebar spacing in wall	48 inches	
Wall panel thickness	4 inches	WALLTHICKNESS
Rebar size used in floor #	6 Rebar	REBARFLR
Number of rebar per floor rib	2 each	REBARFLRQTY
Spacing of ribs in floor	28 inches	FLOORSPACING
Floor thickness	5.75 inches	H[FLOOR]
Floor deck thickness	2.75 inches	H[DECK]
Floor rib width	4 inches	B[RIB]
Floor deck steel size	W4 Wire	
Floor deck steel spacing	4 inches	
Area per roof rebar	<b>0.200</b> sq. in.	A[REBARROOF]
Diameter of roof rebar	<b>0.500</b> inches	DIA[REBARROOF]
Area per roof wire	<b>0.040</b> sq. in.	
Area per wall wire	<b>0.040</b> sq. in.	A[REBARWALL]
Area per extra vert wall rebar	<b>0.200</b> sq. in.	A[REBARWALL2]
Diameter of wall wire	<b>0.225</b> inches	DIA[REBARWALL]
Diameter of wall rebar	<b>0.500</b> inches	
Area of floor rib rebar	<b>0.880</b> sq. in.	A[REBARFLR]
Diameter of floor rebar	<b>0.750</b> inches	DIA[REBARFLR]
Area of deck rebar/wire	<b>0.040</b> sq. in.	A[REBARDECK]
Diameter of deck rebar/wire	<b>0.225</b> inches	DIA[REBARDECK]
Area of deck steel per foot	<b>0.120</b> sq.in./ft.	A[DECKSTEEL]
Minimum req'd deck steel/foot	<b>0.059</b> sq.in./ft.	A[DECKSTEEL-MIN]

**2.0.1 STRUCTURAL LOADING SUMMARY FOR PANELS, AS DESIGNED.**

<u>PANEL</u>	<u>ALLOWABLE LOAD</u>	<u>TYPE</u>
	10.000 ft wide	
roof	<b>135</b> psf	LIVE
floor	<b>251</b> psf	LIVE
	9.250 ft tall	
wall	<b>87.3</b> psf	WIND

**2.0.2 CHECK STEEL RATIOS ( ACI 318-08, sec. 21.9.2.3 )**

	$\rho_t$	$\rho_v$	
$B_1 = 0.80$	ROOF: 0.0083	0.0069	<b>OK</b>
$\rho_b$ $\rho_{max}$ $\rho_{min}$	FLOOR: 0.0068		<b>OK</b>
0.0335 0.0252 0.0033	WALL: 0.0066	0.0062	<b>OK</b>
Min reqd. per ACI 318-08, sec 21.9.2.1	0.0025		

**2.0.3 CHECK DEVELOPMENT LENGTH ( ACI 318-08, sec. 21.7.5.1 )**

	Wall	Roof	Floor
Largest of:	10 $d_b = 2.3$ in	5.0 in	7.5 in
	7.5 in	7.5 in	7.5 in
$l_{dh} = 1.25 f_y d_b / ( 65 \times f'_c^{1/2} )$	3.7 in	8.2 in	12.2 in
All rebar development lengths are	18 in		<b>OK</b>

**2.1 ROOF PANEL CALCULATIONS**

Temperature steel required: A<sub>ts</sub>  
 Panels are 4 in thick, minimum.  
 Maximum thickness of roof panel is 5 inches at center peak.

$$A_{ts} = A_{conc} \times 0.0018$$

$$= 5 \text{ in.} \times 12 \text{ in.} \times 0.0018$$

$$= 0.1080 \text{ sq. in. per foot of width of roof panel.}$$

Use #4 rebar at 18 inches, longitudinal: A<sub>ts(actual)</sub> = 0.2533 sq. in. **OK**

**2.1.1 Determine shear strength: Vu[ROOF]**

$$b[\text{ROOF}] = 12.0 \text{ inches}$$

$$d[\text{ROOFSHEAR}] = 3 \text{ in.} - \text{DIA}[\text{REBARROOF}] / 2$$

$$= 2.75 \text{ inches}$$

$$V_u[\text{ROOF}] = .85 \times .85 \times 2 \times (f_c)^{.5} \times b[\text{ROOF}] \times d[\text{ROOFSHEAR}]$$

$$= 3372 \text{ lbs.}$$

**2.1.2 Determine allowable live load due to shear: w[ROOFSHEARLL]**

$$\text{ROOFSPANSHEAR} = \text{bldgw} - ( d[\text{ROOFSHEAR} + 4 ] \times 2 / 12 )$$

$$= 8.875 \text{ feet } 10.00 \text{ ft wide shelter}$$

$$w[\text{ROOFDL}] = \text{density} \times \text{thickness} \quad ( 4.5 \text{ in avg} ) = 43.1 \text{ psf (concrete only)}$$

$$w[\text{ROOFSHEARLL}] = ( V_u[\text{ROOF}] / \text{ROOFSPANSHEAR} - 1.4 \times w[\text{ROOFDL}] ) / 1.7$$

$$= 188 \text{ psf allowable roof live load due to shear strength } 10.00 \text{ ft wide}$$

**2.1.3 Determine allowable live load due to moment:  $w[\text{ROOFMOMENTLL}]$** 

$$\begin{aligned}
 A[\text{ROOFSTEEL12}] &= A[\text{REBARROOF}] \times 12 \text{ inches} / \text{ROOFSPACING} \\
 &= 0.20 \text{ sq. inches per foot of roof panel} \quad 10.00 \text{ ft wide shelter} \\
 d[\text{ROOFMOMENT}] &= (H[\text{ROOF}]) - (1 + \text{DIA}[\text{REBARROOF}] / 2) \\
 &= 3.75 \text{ inches} \\
 a[\text{ROOF12}] &= (A[\text{ROOFSTEEL12}] \times f_y[\text{REBAR}]) / (.85 \times f_c \times b[\text{ROOF}]) \\
 &= 0.235 \text{ inches} \\
 \text{Mu}[\text{ROOF12}] &= (.9/12) \times A[\text{ROOFSTEEL12}] \times f_y[\text{REBAR}] \times (d[\text{ROOFMOMENT}] - a[\text{ROOF12}] / 2) \\
 &= 3269 \text{ ft-lbs} \\
 l[\text{ROOFSPAN}] &= \text{BLDGW} - .5 = 9.50 \text{ feet} \quad 10.00 \text{ ft wide shelter} \\
 w[\text{ROOFMOMENTLL}] &= [ (8 \times \text{Mu}[\text{ROOF}] / l[\text{ROOFSPAN}]^2) - (1.4 \times w[\text{ROOFDL}]) ] / 1.7 \\
 &= 135 \text{ psf allowable roof live load due to bending strength.} \quad 10.00 \text{ ft wide}
 \end{aligned}$$

**2.1.4 Determine allowable negative live load due to moment:  $w[\text{ROOFNEG MOMENTLL}]$** 

$$\begin{aligned}
 d[\text{RFNEGMOMENT}] &= 1 + \text{DIA}[\text{REBARROOF}] / 2) \\
 &= 1.25 \text{ inches} \\
 a[\text{RFNEG12}] &= (A[\text{ROOFSTEEL12}] \times f_y[\text{REBAR}]) / (.85 \times f_c \times b[\text{ROOF}]) \\
 &= 0.235 \text{ inches} \\
 \text{Mu}[\text{RFNEG12}] &= (.9/12) \times A[\text{ROOFSTEEL12}] \times f_y[\text{REBAR}] \times (d[\text{RFNEGMOMENT}] - a[\text{RFNEG12}] / 2) \\
 &= 1019 \text{ ft-lbs} \\
 l[\text{ROOFSPAN}] &= \text{BLDGW} - .5 = 9.50 \text{ feet} \quad 10.00 \text{ ft wide shelter} \\
 w[\text{ROOFNEG MOMLL}] &= [ (8 \times \text{Mu}[\text{ROOF}]) / (l[\text{ROOFSPAN}]^2) ] / 1.7 \\
 &= \text{Allowable negative roof live load due to bending strength (neglecting dead load)} \\
 &= -53.1 \text{ psf} \quad 10.00 \text{ ft wide shelter}
 \end{aligned}$$

**2.1.5 CHECK SHEAR ALLOWED PARALLEL TO PLANE OF ROOF****2.1.5.1 CHECK SHEAR ALLOWED FOR ONE CURTAIN OF REINFORCEMENT**

Use a 4 inch panel, 4 foot length, for minimum  $A_{CV}$ . (ACI 318-08, 21.9.2.2)

$$2 A_{CV} \times \lambda \times f_c^{1/2} = 23080 \text{ lbs} \quad [\text{CONTROLS}]$$

**2.1.5.2 NOMINAL SHEAR FOR ROOF SECTION (per ACI 318-08, sec. 21.9.4.1, eq. 21-7)**

Use a 4 inch panel, 4 foot length, for minimum  $A_{CV}$ .

$$\begin{aligned}
 V_n &= A_{CV} (\alpha_c \times \lambda \times f_c^{1/2} + \rho_t \times f_y) & \alpha_c &= 2.0 \text{ (for } h_w / l_w > 2) \\
 A_{CV} &= 192 \text{ in}^2 & \lambda &= 0.85 \text{ (per ACI 318-08 sec. 8.6.1)} \\
 \rho_t &= A_s / A_{CV} = 0.0083
 \end{aligned}$$

$$= 118708 \text{ lbs} \quad [\text{DOES NOT CONTROL}]$$

**2.1.5.3 NOMINAL SHEAR FOR ROOF DIAPHRAGM (per ACI 318-08, sec 21.11.9.1, eq. 21-10)**

Use a 4 inch panel, 4 foot length, for minimum  $A_{CV}$ .

$$\begin{aligned}
 V_n &= A_{CV} (2 \times \lambda \times f_c^{1/2} + \rho_t \times f_y) \\
 &= 118708 \text{ lbs} \quad [\text{DOES NOT CONTROL}]
 \end{aligned}$$

**2.2 WALL PANEL CALCULATIONS**Temperature steel required:  $A_{ts}$ 

Panel thickness is: 4 inches

$$A_{ts} = A_{conc} \times 0.0018$$

$$= 4 \text{ in.} \times 12 \text{ in.} \times 0.0018$$

$$= 0.0864 \text{ sq. in. per foot of width of wall panel.}$$

(ACI 318-08, sec. 14.3.5; 18" MAX) use 4x4-W4xW4 mesh:

Use #4 rebar at 48 inches, longitudinal:  $A_{ts}(\text{actual}) = 0.1700 \text{ sq. in. per foot OK}$ **2.2.1 Determine allowable loads perpendicular to plane of wall****2.2.1.1 Determine shear strength perpendicular to plane of wall: ( $V_u$ )**

$$b[\text{WALL}] = 12 \text{ inches}$$

$$d[\text{WALL}] = 2 \text{ inches (Distance from outside face of panel to center of rebar)}$$

$$V_u[\text{WALL}] = .85 \times .85 \times 2 \times (f_c)^{.5} \times b[\text{WALL}] \times d[\text{WALL}]$$

$$= 2452 \text{ lbs.}$$

**2.2.1.2 Determine allowable live load due to shear:  $w[\text{WALLSHEARLL}]$** 

$$\text{WALLSPANSHEAR} = \text{WALLH} - (d[\text{WALL}] \times 2 / 12)$$

$$= 8.92 \text{ feet} \quad 9.25 \text{ ft tall wall}$$

$$w[\text{WALLDL}] = 38.33 \text{ psf (does not add to horizontal force)}$$

NOTE: WALL DEAD LOAD DOES NOT ACT PERPENDICULAR TO PLANE OF PANEL.

$$w[\text{WALLSHEARLL}] = V_u[\text{WALL}] / (\text{WALLSPANSHEAR}) \times 1.7$$

$$= \text{Allowable wall load due to shear strength}$$

$$= 162 \text{ psf} \quad 9.25 \text{ ft tall wall}$$

**2.2.1.3 Determine allowable live load due to WINDWARD moment:  $w[\text{WALLMOMENTLL}]$** 

$$A[\text{WALLSTEEL}] = A[\text{REBARWALL}] \times (12 / \text{WALLSPACING}) + A[\text{REBARWALL2}] \times 12 / \text{WALLSPACING2}$$

$$= 0.19 \text{ sq. inches per foot of wall panel}$$

$$a[\text{WALL}] = (A[\text{WALLSTEEL}] \times f_y[\text{REBAR}]) / (.85 \times f_c \times b[\text{WALL}])$$

$$= 0.220 \text{ inches}$$

$$M_u[\text{WALL}] = (.9/12) \times A[\text{WALLSTEEL}] \times f_y[\text{REBAR}] \times (d[\text{WALL}] - a[\text{WALL}] / 2)$$

$$= 1588 \text{ ft-lbs}$$

$$w[\text{WALLMOMENTLL}] = [ (8 \times M_u[\text{WALL}] / l[\text{WALLH}]^2) - (1.4 \times w[\text{WALLDL}]) ] / 1.7$$

$$= \text{Allowable wall live load due to bending strength.}$$

$$= 87.3 \text{ psf} \quad 9.25 \text{ ft tall wall}$$

**2.2.1.4 Determine allowable live load due to LEEWARD moment:  $w[\text{WALLMOMENTLL}]$** 

$$d[\text{LEEWARD}] = 2 \text{ inches (Distance from inside face of panel to center of rebar)}$$

$$a[\text{LEEWARD}] = (A[\text{WALLSTEEL}] \times f_y[\text{REBAR}]) / (.85 \times f_c \times b[\text{WALL}])$$

$$= 0.220 \text{ inches}$$

$$M_u[\text{LEEWARD}] = (.9/12) \times A[\text{WALLSTEEL}] \times f_y[\text{REBAR}] \times (d[\text{WALL}] - a[\text{WALL}] / 2)$$

$$= 1588 \text{ ft-lbs}$$

$$w[\text{LEEWARDMOMENTLL}] = [ (8 \times M_u[\text{WALL}] / l[\text{WALLH}]^2) - (1.4 \times w[\text{WALLDL}]) ] / 1.7$$

$$= \text{Allowable wall live load due to bending strength.}$$

$$= 87.3 \text{ psf} \quad 9.25 \text{ ft tall wall}$$

**2.2.2 CHECK SHEAR ALLOWED PARALLEL TO PLANE OF WALL**



**2.2.2.1 CHECK SHEAR ALLOWED FOR ONE CURTAIN OF REINFORCEMENT**

Use a 4 inch panel, 4 foot length, for minimum ( ACI 318-08, 21.9.2.2 )  
 $2 A_{CV} \lambda x \lambda x f'_c{}^{1/2} = 23080 \text{ lbs}$  [CONTROLS]

**2.2.2.2 NOMINAL SHEAR FOR WALL SECTION ( per ACI 318-08, sec. 21.9.4.1, eq. 21-7 )**

Use a 4 inch panel, 4 foot length, for minimum  $A_{CV}$ .  
 $V_n = A_{CV} ( \alpha_c x \lambda x f'_c{}^{1/2} + \rho_t x f_y )$        $A_{CV} = 192 \text{ in}^2$   
 $\alpha_c = 2.0$  ( for  $h_w / l_w > 2$  )       $\lambda = 0.85$  ( per ACI sec. 8.6.1 )  
 $\rho_t = A_s / A_{CV} = 0.0066$   
 $= 99264 \text{ lbs}$  [DOES NOT CONTROL]

**2.2.2.3 NOMINAL SHEAR FOR WALL DIAPHRAGM ( per ACI 318-08, sec. 21.11.9.1, eq. 21-10 )**

Use a 4 inch panel, 4 foot length, for minimum  $A_{CV}$ .  
 $V_n = A_{CV} ( 2 x \lambda x f'_c{}^{1/2} + \rho_t x f_y )$   
 $= 99264 \text{ lbs}$  [DOES NOT CONTROL]

**2.3 FLOOR PANEL CALCULATIONS****2.3.1 Determine temperature steel required for the deck:**

Deck temperature steel required is:

$$\begin{aligned} \text{ATS}[\text{DECK}] &= \text{H}[\text{DECK}] \times 12 \text{ in.} \times .0018 \\ &= 2.75 \text{ in.} \times 12 \text{ in.} \times 0.0018 \\ &= 0.0594 \text{ sq. in. per foot of width of floor panel.} \end{aligned}$$

$$\text{A}[\text{DECKSTEEL}] = 0.1200 \text{ sq. in per foot of panel.}$$

OK

**2.3.2 Determine floor deck strength:**

$$\begin{aligned} \text{DECKSPAN} &= \text{FLOORSPACING} - \text{B}[\text{RIB}] \\ &= 24.0 \text{ inches} \\ \text{d}[\text{DECK}] &= \text{H}[\text{DECK}] - 1 \quad (\text{Assumes mesh is 1" clear from bottom of deck}) \\ &= 1.75 \text{ inches} \\ \text{a}[\text{DECK}] &= (\text{A}[\text{DECKSTEEL}] \times \text{FY}[\text{REBAR}]) / (.85 \times \text{fc} \times 12 \text{ in.}) \\ &= 0.1412 \text{ inches} \\ \text{Mu}[\text{DECK}] &= 0.9/12 \times \text{A}[\text{DECKSTEEL}] \times \text{fy}[\text{REBAR}] \times (\text{d}[\text{DECK}] - (\text{a}[\text{DECK}] / 2)) \\ &= 907 \text{ ft-lbs} \\ \text{w}[\text{DECKTOTALMOM}] &= (\text{Mu}[\text{DECK}] \times 8) / (\text{DECKSPAN} \times 12 \text{ in. per ft.})^2 \\ &= 1814 \text{ psf} \\ \text{w}[\text{DECKDL}] &= (\text{H}[\text{DECK}] / 12 \text{ in. per ft.} \times 1 \text{ ft.}^2 \times \text{DENSITY}) \\ &= 26.4 \text{ psf} \\ \text{w}[\text{DECKLLMOM}] &= (\text{w}[\text{DECKTOTAL}] - 1.4 \times \text{w}[\text{DECKDL}]) / 1.7 \\ &= 1045 \text{ psf} \\ \text{Vu}[\text{DECK}] &= .85 \times .85 \times 2 \times (\text{fc}^{\wedge}.5) \times \text{d}[\text{DECK}] \times 12 \text{ in.} \\ &= 2146 \text{ lbs.} \\ \text{w}[\text{DECKTOTSHEAR}] &= 2 \times (\text{Vu}[\text{DECK}] / \text{L}) \\ &= 2146 \text{ psf} \\ \text{w}[\text{DECKLLSHEAR}] &= (\text{w}[\text{DECKTOTSHEAR}] - 1.4 \times \text{w}[\text{DECKDL}]) / 1.7 \\ &= 1240 \text{ psf} \end{aligned}$$

Allowable live load for the floor deck is: **1045 psf** (FLOOR DECK MOMENT CONTROLS)

**2.3.3 Determine floor rib strength:**

Effective width of flange: ACI 318-08, sec. 8.12.2 flange width  
 1/4 span: = **28.5** inches

Effective width of overhang: ACI 318-08, sec. 8.12.2 (a) & (b)  
 (a) 8 times H[DECK] = **22** inches **48.0** inches  
 OR (b) 1/2 clear dist. = **12.0** inches **28.0** inches <controls>

bf= **28.0** inches  
 $d[FLOOR] = H[FLOOR] - (.75" + DIA[REBARFLR] / 2)$   
 = **4.625** inches  
 $a[FLOOR] = ( A[REBARFLR] \times fy[REBAR] ) / (.85 \times fc \times bf)$   
 = **0.444** inches  
 $Mu[FLOOR] = (.9/12) \times A[REBARFLR] \times fy[REBAR] \times (d[FLOOR] - a[FLOOR] / 2)$   
 = **17436** ft-lbs  
 FLOORSPANMOM= BLDGW - .5 ft. = **9.50** feet 10.00 ft wide shelter  
 $w[FLOORMOMTOT] = 8 \times Mu[FLOOR] / (FLOORSPANMOM)^2$   
 = **1546** plf 10.00 ft wide shelter  
 $w[FLOORDL] = ( ( H[DECK] \times bf / 144 ) + b[RIB] \times ( H[FLOOR] - H[DECK] ) / 144 ) \times 1 \text{ ft.} \times \text{DENSITY}$   
 = **71.1** plf (PER RIB) = **30.5** psf  
 $w[FLOORMOMLL] = [ W[FLOORMOMTOT] - (1.4 \times w[FLOORDL] ) ] / (1.7 \times \text{trib})$   
 = **365** psf 10.00 ft wide shelter

**2.3.4 Determine rib shear strength: Vu[FLOOR]**

b[RIB] = **4.00** inches  
 $A[RIBSHEAR] = ( H[FLOOR] - (.75" + DIA[REBARFLR]/2 ) ) \times B[RIB]$   
 = **18.50** sq. in.  
 ACI 318-08, sec. 11.2.2.1 Eq. 11-5  $\lambda = 0.85$   
 $Vc[FLOOR] = ( 1.9 \times \lambda \times (fc)^{.5} + ( 2500 \times \rho_w \times A[REBARFLR] / (b[RIB] \times d[FLOOR] ) ) ) \times b[RIB] \times d[FLOOR]$   
 = **4313** lbs.  
 But not greater than:  $3.5 \times \lambda \times fc^{.5} \times b[RIB] \times d[FLOOR]$   
 = **3892** lbs.  
 USE **3892** lbs.  
 ACI 318-08, 8.13.8  $Vc[FLOORALLOW] = 1.1 \times Vc[FLOOR] =$  **4281** lbs.

**2.3.5 Determine allowable live load due to shear: w[FLOORSHEARLL]**

$$\begin{aligned}
 \text{FLOORSPANSHEAR} &= \text{bldgw} - (d[\text{FLOOR} + 8.5] \times 2 / 12) \\
 &= \mathbf{7.81} \text{ feet} \quad 10.00 \text{ ft wide shelter} \\
 w[\text{FLOORSHEARLL}] &= (V_c[\text{FLOORALLOW}] / (.5 \times \text{FLOORSPANSHEAR}) - 1.4 \times w[\text{FLOORDL}]) / (1.7 \times \text{FLOORSPACING} / 12) \\
 &= \text{Allowable floor live load due to shear strength} \\
 &= \mathbf{251} \text{ psf} \quad 10.00 \text{ ft wide shelter} \\
 \text{Allowable LL for the } &10.00 \text{ ft wide floor rib is: } \mathbf{251} \text{ psf} \quad (\text{FLOOR RIB SHEAR CONTROLS}) \\
 \text{Gross allowable floor load; LL + } &44 \text{ psf DL} = \mathbf{295} \text{ psf} \quad 10.00 \text{ ft wide}
 \end{aligned}$$

**2.3.6 Determine allowable concentrated load over 2 sq ft and 3 sq ft.**

2 square foot area is equivalent to approximately 17 inch x 17 inch, or 1.41 feet x 1.41 feet.  
Assume one rib takes the entire concentrated load.

Allowable load based on shear is: 251 psf

For a 10.00 foot wide shelter with a 9.00 ft span, the equivalent concentrated load is:

$$\begin{aligned}
 P[\text{shear}] &= 9.00 \text{ ft} \times 251 \text{ lbs.} \times 2 \\
 &= \mathbf{4522} \text{ lbs} \quad \text{Maximum concentrated load (shear).}
 \end{aligned}$$

Maximum live load for bending on one rib is:

$$\begin{aligned}
 w[\text{FLOORRIBLL}] &= w[\text{FLOORMOMLL}] \times \text{BF} / 12 = 851 \text{ plf} \\
 \text{Make uniform load moment equal to concentrated load moment and solve for P.} \\
 w[\text{FLOORRIBLL}] \times (\text{FLOORSPANMOM}^2) / 8 &= P \times \text{FLOORSPANMOM} / 2 \\
 P(\text{moment}) &= w[\text{FLOORRIBLL}] \times (\text{FLOORSPANMOM}) / 4 \\
 &= \mathbf{2020} \text{ LBS} \quad \text{Max concentrated load in center of floor (bending).}
 \end{aligned}$$

If the load is next to the wall (as is usually the case with batteries) :

$$\begin{aligned}
 w[\text{FLOORRIBLL}] \times (\text{FLOORSPANMOM}^2) / 8 &= P \times 1.5 \\
 P(\text{moment}) &= w[\text{FLOORRIBLL}] \times (\text{FLOORSPANMOM}^2) * (2 \times 8) \\
 &= \mathbf{6398} \text{ LBS} \quad \text{Max concentrated load next to wall (bending).} \\
 &\text{Shear controls}
 \end{aligned}$$

**Shear controls when load is next to wall.**

For a 3 square foot area the concentrated load will be supported by two ribs.


Maximum live load for bending on two ribs is:

$$\begin{aligned}
 w[\text{FLOORRIBLL}] &= w[\text{FLOORMOMLL}] \times \text{BF} / 12 = 1701 \text{ plf} \\
 \text{Make uniform load moment equal to concentrated load moment and solve for P.} \\
 w[\text{FLOORRIBLL}] \times (\text{FLOORSPANMOM}^2) / 8 &= P \times \text{FLOORSPANMOM} / 2 \\
 P(\text{moment}) &= w[\text{FLOORRIBLL}] \times (\text{FLOORSPANMOM}) / 4 \\
 &= \mathbf{4041} \text{ LBS} \quad \text{Max concentrated load in center of floor (bending).}
 \end{aligned}$$

**3.0 INSERT PLATE ANALYSIS**  
(Analysis per ACI 318-08, Appendix D)

**3.1 Material Properties**

- $f'_c = 5000$  psi (sand-lightweight)
- $f_{uta} = 61$  ksi
- $A_{se} = 0.196$  in<sup>2</sup>
- $A_{brg} = 0.589$  in<sup>2</sup>
- $h_{ef} = 2$  in
- $d_a = 0.5$  in

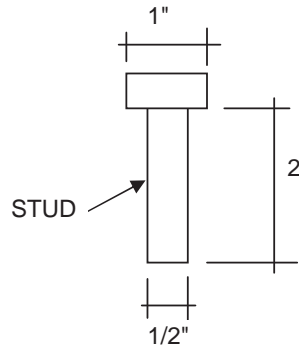

**3.2 Stud Analysis**

**3.2.1** Per D.5.3.4, Eq D-15, Pullout strength in tension shall not exceed:

$$N_p = 8 A_{brg} f'_c = 23,562 \text{ lbs/stud}$$

(due to crushing strength of concrete at the head of the stud.)

**3.2.2** Basic tension breakout strength of stud shall not exceed:

$$N_b = k_c \lambda (f'_c)^{1/2} h_{ef}^{1.5} \quad [\text{Eq D-7}] \text{ Sec D.5.2.2}$$

$$\lambda = 0.85 \text{ Sec 8.6.1 (sand-lightweight)} \quad k_c = 24 \text{ (for cast-in anchors)}$$

$$N_b = 4080 \text{ lbs/stud}$$

**3.2.3** Check ductile strength of stud.

$$N_{sa} = A_{se} f_{uta} = 11.98 \text{ kips/stud}$$

$$\phi = 0.75 \quad [\text{See D.4.4 a) i) ]}$$

$$\phi N_{sa} = 8.98 \text{ kips/stud}$$


**3.2.3** Check shear strength of stud.

$$V_{sa} = A_{se} f_{uta} = 11.98 \text{ kips/stud}$$

$$\phi = 0.65 \quad [\text{See D.4.4 a) ii) ]}$$

$$\phi N_{sa} = 7.79 \text{ kips/stud}$$

**3.3 INSERT PLATE "P/N 223100" ANALYSIS**

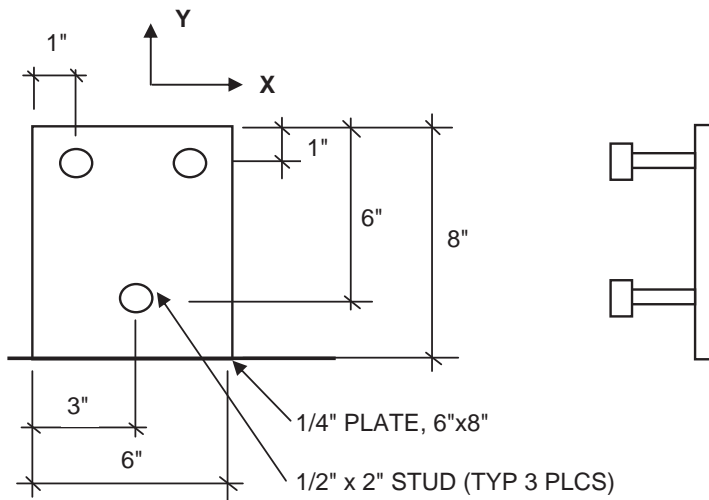

**3.3.1 Tension Capacity of "P/N 223100" plate:**

$$N_{cbg} = (A_{nc}/A_{nco}) \psi_{ec,N} \psi_{ed,N} \psi_{c,N} \psi_{cp,N} N_b$$

$$A_{Nco} = 9h_{ef}^2 =$$

Find  $A_{Nc}$  for just the two upper studs.

$$A_{Nc} = A_{Nco} + 4(3)(h_{ef}) =$$

$$\psi_{ec,N} = 1.0 \text{ assume no eccentricity}$$

$$\psi_{ed,N} = 1.0 \text{ (} c_a \text{ min} > 1.5 h_{ef} \text{ for 2 studs)}$$

$$\psi_{c,N} = 1.25 \text{ (for cast-in anchors)}$$

$$\psi_{cp,N} = 1.0 \text{ (for cast-in anchors)}$$

$$N_{cbg} = 8500 \text{ lbs} \quad \phi = 0.70 \text{ [Sec D.4.4 (c) condition B]}$$


$$\phi N_{cbg} = 5950 \text{ lbs}$$

**TENSION CAPACITY OF "P/N 223100" PLATE**

[Eq D-5] Sec D.5.2.1

$$36 \text{ in}^2$$

$$60 \text{ in}^2$$

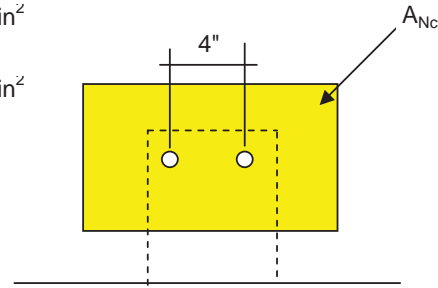

**3.3.2 Shear Capacity of "P/N 223100" plate in the X-direction:**

This shear force is parallel to the edge of the panel. (equals two times perpendicular)

$$V_{cbg} = 2(A_{vc}/A_{vco}) \psi_{ec,V} \psi_{ed,V} \psi_{c,V} \psi_{h,V} V_b \quad \text{[Eq D-22 x 2] Sec D.6.2.1 (c)}$$

$$V_b = 7(l_e/d_a)^{0.2} (d_a)^{1/2} \lambda (f'_c)^{1/2} (c_{a1})^{1.5} \quad \text{[Eq D-24] Sec D.6.2.2}$$

$$l_e = h_{ef} = 2 \text{ inches} \quad \lambda = 0.85 \text{ Sec 8.6.1}$$

$$d_a = 0.5 \text{ inches} \quad c_{a1} = 7 \text{ inches}$$

$$V_b = 7270 \text{ lbs/stud} \quad \psi_{h,V} = 1.0 \text{ [D.6.2.8]}$$

$$\psi_{ec,V} = 1.0 \text{ assume no eccentricity} \quad \psi_{ed,V} = 1.0$$

$$\psi_{c,V} = 1.2 \text{ (for #4 bar between anchor and edge)}$$

$$h_a = 4 \text{ inches} \quad s_1 = 4 \text{ inches}$$

$$A_{vco} = 2(1.5 c_{a1}) h_a = 84 \text{ in}^2$$

$$A_{vc} = (2(1.5 c_{a1}) + s_1) h_a = 100 \text{ in}^2$$

$$V_{cbg} = 20772 \text{ lbs} \quad \phi = 0.70 \text{ [D.4.4 (c) condition B]}$$

$$\phi V_{cbg} = 14540 \text{ lbs}$$

**SHEAR CAPACITY OF "P/N 223100" PLATE IN X-DIRECTION**

**3.3.3 Shear Capacity of "P/N 223100" plate in the (negative) Y-direction:**

This shear force is perpendicular to the edge of the panel.

NOTE: The lower stud is ignored since it is close to the free edge.

$$V_{cbg} = (A_{vc}/A_{vco}) \psi_{ec,V} \psi_{ed,V} \psi_{c,V} \psi_{h,V} V_b \quad \text{[Eq D-22] Sec D.6.2.1 (b)}$$

$$V_b = 7270 \text{ lbs/stud} \quad \text{from 3.3.2 above}$$

$$\psi_{ec,V} = 1.0 \text{ assume no eccentricity}$$

$$\psi_{ed,V} = 1.0 \text{ } c_{a2} > 1.5c_{a1} \quad \psi_{h,V} = 1.0 \text{ [D.6.2.8]}$$

$$\psi_{c,V} = 1.2 \text{ (for #4 bar between anchor and edge)}$$

$$h_a = 4 \text{ inches} \quad s_1 = 4 \text{ inches}$$


$$A_{vco} = 84 \text{ in}^2 \quad A_{vc} = 100 \text{ in}^2 \quad \text{from 3.3.2 above}$$

$$V_{cbg} = 10386 \text{ lbs} \quad \phi = 0.70 \text{ [D.4.4 (c) condition B]}$$

$$\phi V_{cbg} = 7270 \text{ lbs}$$

**SHEAR CAPACITY OF "P/N 223100" PLATE IN Y-DIRECTION**

**3.4 INSERT PLATE "P/N 223000" ANALYSIS**

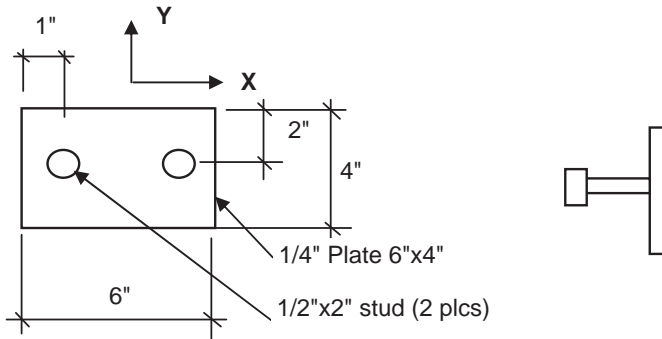


**3.4.1 Tension Capacity of "P/N 223000" plate:**

$$N_{cbg} = (A_{nc}/A_{nco}) \psi_{ec,N} \psi_{ed,N} \psi_{c,N} \psi_{cp,N} N_b \quad [\text{Eq D-5}] \text{ Sec D.5.2.1 (b)}$$

$$A_{Nco} = 9h_{ef}^2 = 36 \text{ in}^2$$

Find  $A_{Nc}$  for just the two upper studs.

$$A_{Nc} = A_{Nco} + 4(3)(h_{ef}) = 60 \text{ in}^2$$

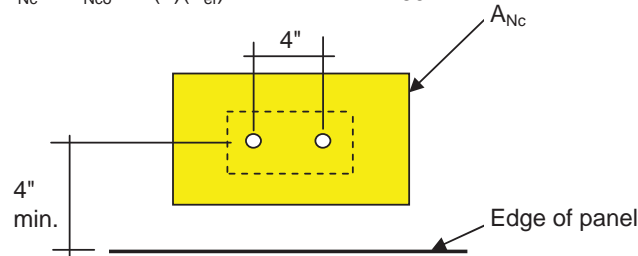

- $\psi_{ec,N} = 1.0$  assume no eccentricity
- $\psi_{ed,N} = 1.0$  ( $c_a \text{ min} > 1.5 h_{ef}$  for 2 studs considered)
- $\psi_{c,N} = 1.25$  (for cast-in anchors)
- $\psi_{cp,N} = 1.0$  (for cast-in anchors)
- $N_{cbg} = 8500 \text{ lbs}$
- $\phi = 0.70$  [Use condition B, D.4.4]

$\phi N_{cbg} = 5950 \text{ lbs}$
-----------------------------------

**TENSION CAPACITY OF "P/N 223000" PLATE**

**3.4.2 Shear Capacity of "P/N 223000" plate in the X-direction:**

This shear force is parallel to the edge of the panel. (equals two times perpendicular)

$$V_{cbg} = 2(A_{vc}/A_{vco}) \psi_{ec,V} \psi_{ed,V} \psi_{c,V} \psi_{h,V} V_b \quad [\text{Eq D-22 x 2}] \text{ Sec D.6.2.1 (c)}$$

where:  $V_b = 7(l_e/d_a)^{0.2} (d_a)^{1/2} \lambda (f'_c)^{1/2} (c_{a1})^{1.5}$  [Eq D-24] Sec D.6.2.2

- $l_e = h_{ef} = 2 \text{ inches}$        $\lambda = 0.85$  Sec 8.6.1
- $d_a = 0.5 \text{ inches}$        $c_{a1} = 4 \text{ inches}$

$$\begin{aligned}
 V_b &= 3140 \text{ lbs/stud} & \psi_{h,V} &= 1.0 \text{ [D.6.2.8]} \\
 \psi_{ec,V} &= 1.0 \text{ assume no eccentricity} & \psi_{ed,V} &= 1.0 \\
 \psi_{c,V} &= 1.2 \text{ (for \#4 bar between anchor and edge)} \\
 h_a &= 3.5 \text{ inches [at step-joint]} & s_1 &= 4 \text{ inches} \\
 A_{vco} &= 2(1.5 c_{a1}) h_a = 42 \text{ in}^2 \\
 A_{vc} &= (2 (1.5 c_{a1}) + s_1) h_a = 56 \text{ in}^2 \\
 V_{cbg} &= 10049 \text{ lbs} \\
 \phi &= 0.70 \text{ [Use condition B, D.4.4]}
 \end{aligned}$$

$\phi V_{cbg} = 7035 \text{ lbs}$   
**SHEAR CAPACITY OF "P/N 223000" PLATE IN X-DIRECTION**


**3.4.3 Shear Capacity "P/N 223000" in the neg Y-direction (toward free edge):**

This shear force is perpendicular to the edge of the panel.

$$\begin{aligned}
 V_{cbg} &= (A_{vc}/A_{vco}) \psi_{ec,V} \psi_{ed,V} \psi_{c,V} \psi_{h,V} V_b & \text{[Eq D-22] Sec D.6.2.1 (b)} \\
 V_b &= 3140 \text{ lbs/stud} & \text{from 3.4.2 above} \\
 \psi_{ec,V} &= 1.0 \text{ assume no eccentricity} \\
 \psi_{ed,V} &= 1.0 \text{ } c_{a2} > 1.5 c_{a1} & \psi_{h,V} &= 1.0 \text{ [D.6.2.8]} \\
 \psi_{c,V} &= 1.2 \text{ (for \#4 bar between anchor and edge)} \\
 A_{vco} &= 42 \text{ in}^2 & A_{vc} &= 56 \text{ in}^2 \text{ from 3.4.2 above} \\
 V_{cbg} &= 5025 \text{ lbs} & \phi &= 0.70 \text{ [Use condition B, D.4.4]}
 \end{aligned}$$

$\phi V_{cbg} = 3517 \text{ lbs}$   
**SHEAR CAPACITY OF "P/N 223000" PLATE IN Y-DIRECTION**


**3.5 INSERT ANGLE "P/N 222000" ANALYSIS**

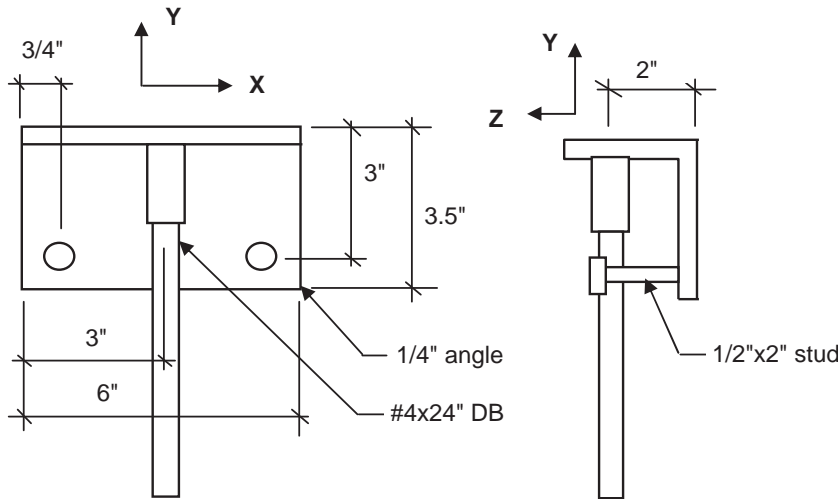

**3.5.1 Tension Capacity of "P/N 222000" Insert Angle: (negative Z)**

$$\begin{aligned}
 N_{cbg} &= (A_{nc}/A_{nco}) \psi_{ec,N} \psi_{ed,N} \psi_{c,N} \psi_{cp,N} N_b & \text{[Eq D-5] Sec D.5.2.1 (b)} \\
 A_{Nco} &= 9h_{ef}^2 = 36 \text{ in}^2 \\
 \text{Find } A_{Nc} &\text{ for just the two studs.}
 \end{aligned}$$



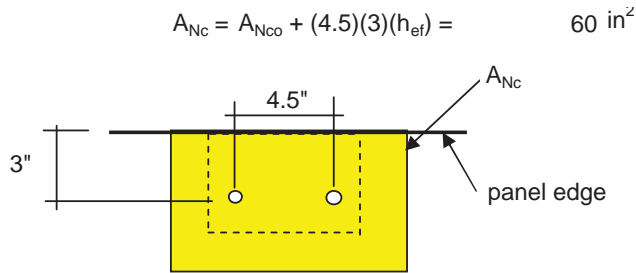

$\psi_{ec,N} = 1.0$  assume no eccentricity  
 $\psi_{ed,N} = 1.0$  ( $c_a \text{ min} > 1.5 h_{ef}$  for 2 studs considered)  
 $\psi_{c,N} = 1.25$  (for cast-in anchors)  
 $\psi_{cp,N} = 1.0$  (for cast-in anchors)  
 $N_{cbg} = 8500 \text{ lbs}$        $\phi = 0.70$  [Use condition B, D.4.4]

$\phi N_{cbg} = 5950 \text{ lbs}$   
**TENSION CAPACITY OF "P/N 222000" INSERT**

**3.5.2 Shear Capacity of "P/N 222000" Insert Angle in X direction:**

This shear force is parallel to the edge of the panel. (equals two times perpendicular)

$V_{cbg} = 2(A_{vc}/A_{vco}) \psi_{ec,V} \psi_{ed,V} \psi_{c,V} \psi_{h,V} V_b$  [Eq D-22 x 2] Sec D.6.2.1 (c)

where:

$V_b = 7(l_e/d_a)^{0.2} (d_a)^{1/2} \lambda (f'_c)^{1/2} (c_{a1})^{1.5}$  [Eq D-24] Sec D.6.2.2

$l_e = h_{ef} = 2 \text{ inches}$        $\lambda = 0.85$  Sec 8.6.1

$d_a = 0.5 \text{ inches}$        $c_{a1} = 3 \text{ inches}$

$V_b = 2040 \text{ lbs/stud}$        $\psi_{h,V} = 1.0$  [D.6.2.8]

$\psi_{ec,V} = 1.0$  assume no eccentricity       $\psi_{ed,V} = 1.0$

$\psi_{c,V} = 1.2$  (for #4 bar between anchor and edge)

$h_a = 4 \text{ inches}$  [at step-joint]

$s_1 = 4.5 \text{ inches}$

$A_{vco} = 2(1.5 c_{a1}) h_a = 36 \text{ in}^2$

$A_{vc} = (2(1.5 c_{a1}) + s_1) h_a = 54 \text{ in}^2$

$V_{cbg} = 7343 \text{ lbs}$        $\phi = 0.70$  [Use condition B, D.4.4]

$\phi V_{cbg} = 5140 \text{ lbs}$   
**SHEAR CAPACITY OF "P/N 222000" INSERT, X-DIRECTION**

**3.5.3 Shear Capacity of "P/N 222000" Insert Angle in Y direction:**

This is for uplift forces from the roof panel.

$V_{cbg} = (A_{vc}/A_{vco}) \psi_{ec,V} \psi_{ed,V} \psi_{c,V} \psi_{h,V} V_b$  [Eq D-22] Sec D.6.2.1 (b)

$V_b = 2040 \text{ lbs/stud}$  from 3.5.2 above


$\psi_{ec,V} = 1.0$  assume no eccentricity

$\psi_{ed,V} = 1.0$   $c_{a2} > 1.5 c_{a1}$        $\psi_{h,V} = 1.0$  [D.6.2.8]

$$\begin{aligned} \psi_{c,V} &= 1.2 \text{ (for \#4 bar between anchor and edge)} \\ A_{vco} &= 36 \text{ in}^2 \text{ from 3.5.2 above} \\ A_{vc} &= 54 \text{ in}^2 \text{ from 3.5.2 above} \\ V_{cbg} &= 3672 \text{ lbs} \\ \phi &= 0.70 \text{ [Use condition B, D.4.4]} \end{aligned}$$

$\phi V_{cbg} = 2570 \text{ lbs}$
<b>SHEAR CAPACITY OF "P/N 222000" INSERT, Y-DIRECTION</b>

**3.6 WALL CORNER INSERT ANALYSIS**

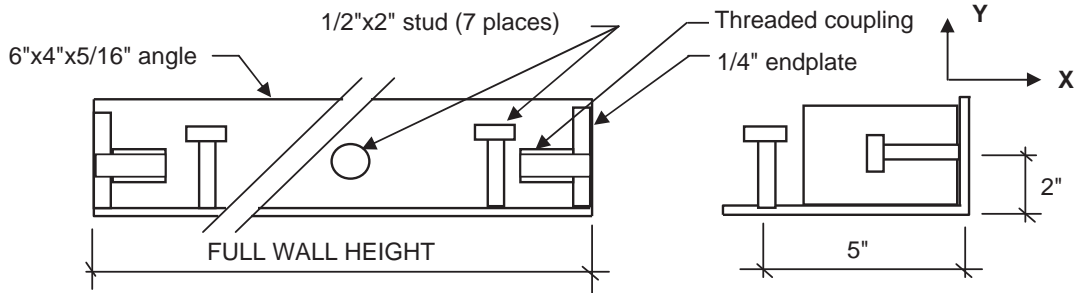

This insert is used on the vertical sides of the endwalls. The 4" leg forms the outside edge of the endwalls, and the 6" leg is abutted to the side walls and is used for the welded connection to the side wall, the roof, and the floor.

The primary loads on this insert are those from wind and seismic forces as they are transferred to/from the floor/roof panel by using the endwall as a shearwall against the forces as they are applied to the side walls.

The shearwall forces are applied in the X-direction as applied to the end view on the right side of the picture above. Of the 7 studs (minimum) that are on the insert, three of them would be analyzed for tension and the other four would be in shear. Depending on the direction of shear, (+X or -X direction), the free edge will come into play. This analysis will only consider the free edge allowable loads with the assumption that the insert will exceed that capacity when loaded in the opposite direction.

**3.6.1 Capacity of Wall Corner Inserts in X-direction**

Check capacity of individual studs on the 6" leg of the angle.  
These studs would be in shear toward the free edge.

$$V_{cb} = (A_{vc}/A_{vco}) \psi_{ed,V} \psi_{c,V} \psi_{h,V} V_b \quad \text{[Eq D-21 Sec D.6.2.1 (a)]}$$

where:

$$V_b = 7(l_e/d_a)^{0.2} (d_a)^{1/2} \lambda (f'_c)^{1/2} (c_{a1})^{1.5} \quad \text{[Eq D-24] Sec D.6.2.2}$$

$$l_e = h_{ef} = 2 \text{ inches} \quad \lambda = 0.85 \text{ Sec 8.6.1}$$

$$d_a = 0.5 \text{ inches} \quad c_{a1} = 5 \text{ inches}$$

$$V_b = 4389 \text{ lbs/stud}$$

$$\psi_{ed,V} = 1.0 \quad \psi_{h,V} = 1.0 \text{ [D.6.2.8]}$$

$$\psi_{c,V} = 1.2 \text{ (for \#4 bar between anchor and edge)}$$

$$h_a = 4 \text{ inches [at step-joint]} \quad s_1 = 24 \text{ inches}$$

$$A_{vco} = 4.5 c_{a1}^2 = 112.5 \text{ in}^2$$

$$A_{vc} = 2(1.5 c_{a1}) h_a = 60 \text{ in}^2$$

$$V_{cb} = 5618 \text{ lbs} \quad \phi = 0.70 \text{ [Use condition B, D.4.4]}$$

$$\phi V_{cb} = 3932 \text{ lbs}$$

Shear capacity of studs on 6" leg, X direction.


To this, add the tension load from the studs on the 4" leg.

$$N_{cb} = (A_{nc}/A_{nco}) \psi_{ed,N} \psi_{c,N} \psi_{cp,N} N_b \quad \text{[Eq D-4] Sec D.5.2.1 (a)}$$

$$A_{Nco} = 9h_{ef}^2 = 36 \text{ in}^2$$

Find  $A_{Nc}$        $c_{a1} = 2 \text{ inches}$        $h_{ef} = 2 \text{ inches}$

$$A_{Nc} = 2(c_{a1}) \times 2(1.5 h_{ef}) = 24 \text{ in}^2$$

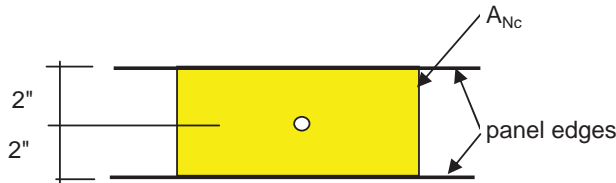

$$\psi_{ed,N} = 1.0 \text{ (} c_a \text{ min} > 1.5 h_{ef} \text{ for 2 studs considered)}$$

$$\psi_{c,N} = 1.25 \text{ (for cast-in anchors)}$$

$$\psi_{cp,N} = 1.0 \text{ (for cast-in anchors)}$$

$$N_{cb} = 3400 \text{ lbs} \quad \phi = 0.70 \text{ [Use condition B, D.4.4]}$$

$$\phi N_{cb} = 2380 \text{ lbs}$$

Shear capacity of studs on 6" leg, X direction.

These two were analyzed as individual studs since they are spaced 12 inches apart, far enough to act alone, not as a group. In this direction, there would be a minimum of 4 studs in shear, and three studs in tension. The total allowable load is:

$$P_x = 4(\phi V_{cb}) + 3(\phi N_{cb}) = 22870 \text{ lbs}$$

SHEAR CAPACITY OF WALL INSERT, +/- X-direction

### 3.7 FLOOR LIFTING INSERT ANALYSIS

The floor lifting inserts are made from 5"x5"x5/16" angle with a 5"x5/16" plate welded on the open top, to form a channel, and extend across the entire width of the floor panel at each end of the shelter. The inserts are similar to the wall corner inserts in design as they have no less than 6 studs, 1/2"x4" long, on 12" centers and two studs, 1/2"x2" long. These inserts provide three connection points for the endwall, and the two outer connections also double as side wall connections. The floor panel side inserts are made from a 5"x5"x5/16" angle with one side up and one side out, and extend the entire length of the shelter. They are also similar to the wall corner inserts in design by having a minimum of 6 studs, 1/2"x4" long, on 12" centers and four # 6 x 30" rebar splices. These inserts provide three or more connection points for the sidewall. By inspection these inserts are highly integrated into the floor structure. A failure would require much more than the shear cone failures as provided by the stud design manual. Therefore, the connections will be considered as equivalent to the analysis of the wall corner insert (sec 3.6.1).

**3.8 CAPACITY OF WELDS AT CONNECTION PLATES**

Welds to be made with SMAW, E70XX electrodes.  
All standard connection plates will have a 3/16" weld, 3 inches long.  
E70XX welds are good for .928 kips per inch per sixteenth inch of weld.  
Weld capacity is then:


$$P_w = (0.928 \text{ k/inch/sixteenth}) \times (3 \text{ inches}) \times (3 \text{ sixteenths})$$

$P_w = 8.352 \text{ kips}$ CAPACITY OF ALL STANDARD CONNECTION PLATE WELDS
---

**3.9 CAPACITY OF TIE-DOWN CONNECTION PLATES**

Three failure modes are noted:

- A: Failure of the connection plate.
  - B: Failure of the bolts connecting the plate to the shelter.
  - C: Failure of the expansion anchor connecting the plate to the foundation.
- t = 0.25 " (plate thickness)

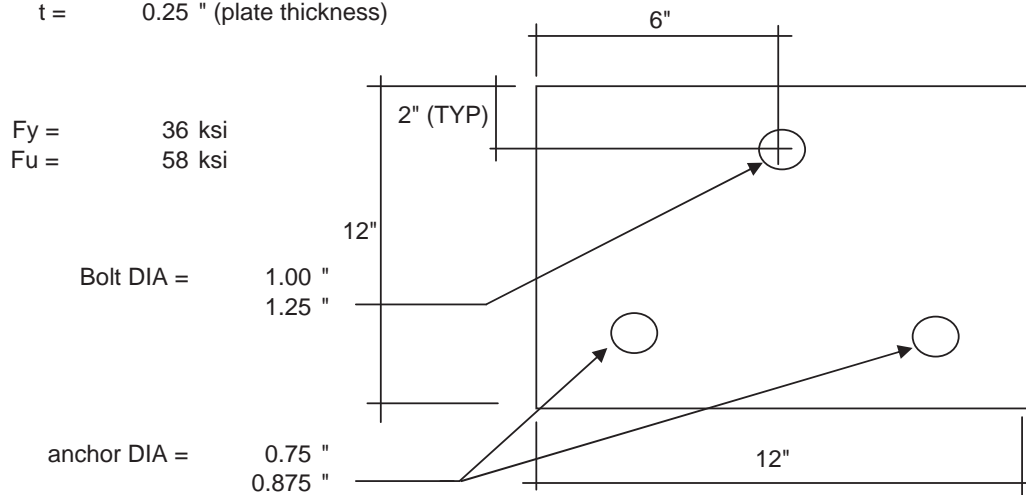

**A: Shear through edge of plate at one hole is:**

HoleArea(bolt)= D(top) x t	=	0.3125 in <sup>2</sup>	
HoleArea(anchor)= D(bot) x t	=	0.21875 in <sup>2</sup>	
PL-Area = t x ( 2" - (.5 x 1.25" ) )	=	0.34375 in <sup>2</sup>	
cannot exceed t x 4t	=	0.25 in <sup>2</sup>	<b>CONTROLS</b>
OK [exceeds 2/3 hole area, AISC, LRFD (1999), D3.2]			

Bearing on hole area:            Apl(bolt)=            0.25 in<sup>2</sup>  
    Apl(anchor)=        0.1875 in<sup>2</sup>  
    Fp(hole) = 1.0 Fu       =                    58 ksi  
    PL-bearing =        14.50 kips/ bolt hole  
    PL-bearing =        10.88 kips/ anchor hole  
    Transient load factor:    1.333  
 Capacity of connection plate is:    19.33 kips            (using 1 bolt and 2 anchors)  
    19333 lbs per connection

**B: 1" bolt capacity:**        Use A307 bolts or better  
    Fv =            10.0 ksi  
    A(bolt) =        0.785 in<sup>2</sup>  
    Transient load factor:    1.333  
    P(bolt) =        10.47 kips / bolt       =                    10472 lbs per connection

**C: Expansion anchor capacity from Hilti charts:**

**Reference ICC report #ESR-1385 & Tables 2 & 5**

Anchor is Hilti Stainless Steel Kwik Bolt 3, 3/4" x 6.5"

Shear in horizontal direction (due to sliding of shelter):

See Table 5, 3000 psi normal weight concrete, in ICC report.

Embedment depth:        4.75 in    OK

Allowable load:            4225 lbs per anchor

See Table 2, 3000 psi normal weight concrete, in ICC report.

Edge distance for max load:    9.75 in    OK    (in direction of load)

Spacing req'd for full load:    10.75 in

Min. spacing allowed:        4.75 in    (10% reduction per note 4, table 2)

Actual spacing:            8 in

Interpolated reduction for spacing:    4.6 %

Transient load factor:        1.333

Modified allowable horizontal shear load:    5375 lbs per anchor

   times 2 =        10750 lbs per connection

Shear in vertical direction (due to uplift of shelter):

Hilti Kwik Bolt 3 requirements

4.75" embedment

4.875" min. edge dist. allowed => use 50% of chart loads (note 6, table 2)

   9.75" required for full load strength

6" edge distance =>        38.46% Interpolated reduction

Allowable vertical load in 3000 psi concrete:

61.54%            x        4225 lbs       =        2600 lbs per anchor

Reduction for spacing (same as above):        4.6 %

   Transient load factor:        1.333

Modified allowable vertical shear load:        3308 lbs per anchor

   times 2 =        6615 lbs per connection

<b>Controlling loads for tie-down connections:</b>	
Horizontal (sliding):	10472 lbs
Vertical (uplift):	6615 lbs

**4 CONCRETE BUILDING WEIGHT CALCULATOR**

Concrete Density = 115 pcf  
Concrete Required = 10.5 yards

**4.1 Shelter Dimensions:**

Width:	10.000	ft
Length:	18.000	ft
Height:	9.250	ft,(wall height)
		Weight, lbs

**4.2 ROOF**

Material	Weight, lbs
CONCRETE	8377
2.25" INSULATION	63
7/16" OSB PANELING	238
3/8" OSB W/FINISH	202
<b>Total Roof Wt. 8880</b>	
<b>Avg. Dead Load, psf 45.7</b>	

**4.3 WALLS**

CONCRETE	17331
1.75" INSULATION	140
7/16" OSB PANELING	466
3/8" OSB W/FINISH	400
<b>Total Wall Wt. 18337</b>	
<b>Avg. Dead Load, psf 36.3</b>	

**4.4 FLOOR**

CONCRETE	7044
L5x5x5/16 PERIMETER BEAM	577
STYROFOAM (2 PCF DENSITY)	50
TILE, 1/8"	215
<b>Total Floor Wt. 7886</b>	
<b>Avg. Dead Load, psf 43.8</b>	

**4.5 WEIGHT SUMMARY:**

<b>Total Overall : lbs</b>	<b>35103</b>	<b>Width x</b>	<b>Building Length x</b>	<b>Height</b>
		<b>10.000</b>	<b>18.000</b>	<b>9.250</b>



**CODE SUMMARY**

2000	INTERNATIONAL BUILDING CODE
2000	STANDARD BUILDING CODE
2003	INTERNATIONAL BUILDING CODE
2006	INTERNATIONAL BUILDING CODE
2009	INTERNATIONAL BUILDING CODE
2012	INTERNATIONAL BUILDING CODE
1994	UNIFORM MECHANICAL CODE
1996	BOCA MECHANICAL CODE
1997	STANDARD MECHANICAL CODE
1997	UNIFORM MECHANICAL CODE
2000	INTERNATIONAL MECHANICAL CODE
2000	STANDARD MECHANICAL CODE
2003	INTERNATIONAL MECHANICAL CODE
2006	INTERNATIONAL MECHANICAL CODE
2009	INTERNATIONAL MECHANICAL CODE
2012	INTERNATIONAL MECHANICAL CODE
2000	MINNESOTA STATE ENERGY CODE (CH. 1323)
2004	CHICAGO BUILDING CODE
2007	KENTUCKY BUILDING CODE
2007	MINNESOTA STATE MECHANICAL CODE (CH. 1346-2000 IMC & 2000 IFGC W/ AMEND.)
2007	MINNESOTA STATE BUILDING CODE
2009	NEW MEXICO COMMERCIAL BUILDING CODE
2008	NEW MEXICO ELECTRICAL CODE
2009	NEW MEXICO MECHANICAL CODE
2009	MICHIGAN BUILDING CODE
2009	MICHIGAN MECHANICAL CODE
2010	CALIFORNIA BUILDING CODE
2010	CALIFORNIA GREEN BUILDING STANDARDS
2010	CALIFORNIA ENERGY CODE
2010	BUILDING CODE OF NEW YORK STATE
2010	ELECTRICAL CODE OF NEW YORK STATE
2010	MECHANICAL CODE OF NEW YORK STATE
2010	NORTH DAKOTA ELECTRICAL WIRING STANDARDS
2010	FLORIDA BUILDING CODE
2010	FLORIDA BUILDING CODE ENERGY CONSERVATION
2011	MASSACHUSETTS ELECTRICAL CODE
8TH	MASSACHUSETTS STATE BUILDING CODE
2011	OHIO BUILDING CODE
2011	OHIO MECHANICAL CODE
	CALIFORNIA TITLE 25
2010	OREGON STRUCTURAL SPECIALTY CODE
2010	OREGON MECHANICAL SPECIALTY CODE
2010	OREGON ENERGY EFFICIENCY SPECIALTY CODE
2012	NORTH CAROLINA BUILDING CODE
2008	NORTH CAROLINA ELECTRICAL CODE
2012	NORTH CAROLINA MECHANICAL CODE
2012	NORTH CAROLINA ENERGY CONSERVATION CODE
2012	NORTH CAROLINA ENERGY CONSERVATION CODE
2012	TEXAS ACCESSIBILITY STANDARDS
1996-2011	NATIONAL ELECTRICAL CODE
1989,1999,2001,2004,2007	ASHRAE 90.1
2000,2003,2006,2009	2012 INTERNATIONAL ENERGY CONSERVATION CODE
2000,2003,2005,2006,2009	NFPA 101 LIFE SAFETY CODE
2002	ARKANSAS FIRE PREVENTION CODE
2009	NORTH CAROLINA FIRE PREVENTION CODE

**NOTES**

- LISTED CODES INCLUDE LATEST STATE ADOPTED AMENDMENTS.
- THIS SHELTER IS AN "ENCLOSED STRUCTURE" NOT INTENDED FOR HUMAN HABITATION.
- APPROVED MODEL MAY BE MIRROR IMAGE.
- OCCUPANT LOAD = 0, OHIO = 2
- SPECIAL CONDITIONS AND PERMISSIBLE TYPES OF GASES: N/A
- SHELTER HAS NO COUNTY PLACEMENT RESTRICTION IN THE STATE OF MARYLAND.
- STATE INSIGNIA LABEL/DECAL IS LOCATED NEAR MAIN ELECTRICAL SERVICE PANEL.
- DOOR MUST BE MINIMUM 90 MINUTE FIRE RATED IF USED IN 2 HOUR FIRE RATED SHELTER AND MINIMUM 45 MINUTE FIRE RATED IF USED IN 1 HOUR FIRE RATED SHELTER.
- ENERGY CODE EVALUATION BASED ON COMCHECK-EZ AND ENERGY GAUGE FLACOM SOFTWARE.
- NOT SUBJECT TO FLORIDA FIRE SAFETY CODE, COMPLIANCE IS THE RESPONSIBILITY OF THE LOCAL JURISDICTION CODE OFFICIAL.
- ACCESS TO SHELTER SHALL COMPLY WITH MARYLAND ACCESSIBILITY CODE COMAR .05.02.02.07/ADAAG SECTION 4.1.2.
- ALL WELDS SHALL BE VERIFIED BY SPECIAL INSPECTION SHOWING CONFORMANCE TO THE DESIGN DRAWINGS AND SPECIFICATIONS.
- APPLICABLE INTERNAL PRESSURE COEFFICIENT (N/A) - THESE SHELTERS CONFORM TO THE REQUIREMENTS OF (2000,03,06,09 IBC), ASCE 7-05, METHOD 1 SIMPLIFIED PROCEDURE; (2012 IBC, 2010 FBC) ASCE 7-10 SIMPLIFIED DIAPHRAM LOW-RISE BUILDINGS.
- WIND IMPORTANCE FACTOR - IW = 1.000
- THESE PLANS ARE DESIGNED TO BE USED FOR THE CONSTRUCTION OF COMMERCIAL MODULAR UNITS, IN ACCORDANCE WITH CA HEALTH AND SAFETY CODE SECTION 18028, 1991 UBC, 1993 NEC, ANSI A117.1-1986.
- THE 2005 NEC IS MORE STRINGENT THAN THE 2002 NEC, 2012 NEC.
- HVAC UNITS ARE SIZED PER CUSTOMER REQUIREMENTS.
- EXTERNAL GROUNDING BY OTHERS.
- SHELTER CONSTRUCTED IN ACCORDANCE WITH 9N-3 FAC.
- THIS BUILDING DOES NOT CONTAIN PLUMBING FACILITIES.

**INDEX OF SHEETS**

**LAYOUT DRAWINGS**

0-0	COVER SHEET
0-1	PARTS LIST
0-2	PART CONT./CUT LIST/OPTIONAL COMPONENTS
*1-0	EXTERIOR ELEVATION "A"
*1-1	EXTERIOR ELEVATION "C"
*1-2	EXTERIOR ELEVATION "B" (PRE-HEMP)
*1-2A	EXTERIOR ELEVATION "B" (POST-HEMP)
*1-3	EXTERIOR ELEVATION "D"
2-0	FLOOR PLAN
2-1	EQUIPMENT LAYOUT
3-0	REFLECTED CEILING VIEW - ELECTRICAL
3-1	REFLECTED CEILING VIEW - MECHANICAL
4-0	INTERIOR ELEVATION "A"
4-1	INTERIOR ELEVATION "C"
4-1A	INTERIOR ELEVATION "C" ("A" SIDE)
4-1B	INTERIOR ELEVATION "C" ("B" SIDE)
4-2	INTERIOR ELEVATION "B" (PRE-HEMP)
4-2A	INTERIOR ELEVATION "B" (POST-HEMP)
4-3	INTERIOR ELEVATION "D"
4-4	TERMINATION DETAILS
*5-0	ELECTRICAL SCHEMATIC
5-1	LOW VOLTAGE WIRING SCHEMATIC
5-2	HVAC/FIKE SYSTEM SCHEMATIC
5-3	AUTODIALER SCHEMATIC
5-4	PHONE/DATA WIRING
5-5	HVAC/FIKE SYSTEM SCHEMATIC DETAIL
5-6	ELECTRICAL PANEL CALC (PRE HEMP)
5-7	ELECTRICAL PANEL CALC (POST HEMP)
6-0	WORK BENCH MOUNTING DETAIL
6-1	GROUND BAR DETAILS
6-2	INTERIOR INTAKE PLATE ASSEMBLY (LOWER)
6-3	INTERIOR EXHAUST PLATE ASSEMBLY (UPPER)
6-4	EXTERIOR EXHAUST PLATE ASSEMBLY (UPPER)
6-4	EXTERIOR INTAKE PLATE ASSEMBLY (LOWER)
7-0	INTERIOR PANELING R/U CALCULATIONS
7-1	INTERIOR PANELING R/U CALCULATIONS
7-2	6" SLAB FOUNDATION FLAT TIEDOWN DETAILS
7-3	CONCRETE SHELTER PANEL CONNECTION DETAILS
7-4	DETAILS DRAWINGS
7-5	GENERAL ELECTRICAL NOTES & LEGEND

\* = DENOTES SHEETS WHICH MAY CONTAIN FIELDWORK

**REFERENCE DRAWINGS**

108-007	ABBREVIATIONS AND SYMBOLS
108-016	GENERAL CASTING SPECIFICATIONS (4 SHEETS)
108-088	SHELTER LIFTING DETAILS (3 SHEETS)

**STRUCTURAL DRAWINGS (MANUFACTURE ONLY)**

1 OF 6	STRUCTURAL SPECIFICATIONS
2 OF 6	STRUCTURAL LAYOUT WALL "A"
3 OF 6	STRUCTURAL LAYOUT WALL "B"
4 OF 6	STRUCTURAL LAYOUT WALL "C"
5 OF 6	STRUCTURAL LAYOUT WALL "D"
6 OF 6	STRUCTURAL LAYOUT ROOF
221-1000X1800-02	CONCRETE FLOOR ASSEMBLY
222-1000X0903-008	CONCRETE END WALL ASSEMBLY
223-1800X0903-001	CONCRETE SIDE WALL ASSEMBLY
223-1800X0903-002	CONCRETE SIDE WALL ASSEMBLY
226-1000X1800X4-00	CONCRETE ROOF ASSEMBLY

**DESIGN PARAMETERS**

USE GROUP: B (BOCA, MASBC)  
S-2 (FBC, IBC, SBC, UBC)  
U (OBC)

CONSTRUCTION TYPE: 5B (BOCA, MASBC)  
IV-UNP (SBC)  
V-B (IBC, FBC)  
V-N (UBC)

ROOF LIVE LOAD: 136 PSF

FLOOR LIVE LOAD: 251 PSF

GROUND SNOW LOAD: 161 PSF (N/A FOR FBC 2007)

WIND SPEED: 156 MPH/EXPOSURE C

SEISMIC ZONE FOR SBC & UBC: 4  
SEISMIC DESIGN CATEGORY FOR IBC: E (IBC)

Ss=3.00  
S = 2.00  
Ip = 1.5  
SPC=D  
USE GROUP-III (OBC)  
SITE CLASS-D (OBC)


CONCRETE f'c: 5000 PSI AT 28 DAYS  
CONCRETE UNIT WEIGHT: 115 PCF  
FIRE RATING: 2 HOUR WALL AND ROOF (LIMITATIONS MAY APPLY DUE TO OPENINGS AND PROXIMITY ON SITE)  
FIRE SEPARATION DISTANCE: 10'-0" MINIMUM

**PHYSICAL PROPERTIES**

SHELTER DIMENSIONS: 10'-0"W X 18'-0"L  
SHIPPING DIMENSIONS: 10'-8"W X 19'-9 1/8"L X 10'-1"H  
SHELTER WEIGHT: 39,400 # (SHELTER ONLY)


**GENERAL NOTE:**

- DIMENSIONS MARKED WITH A "D" ARE DESIGN DIMENSIONS THAT NEED TO BE CHECKED. THEY TYPICALLY DICTATE A POSITION OF A SERVICE TERMINATION OR DIMENSION THAT NEEDS TO MATCH A POSITION OR DIMENSION AT THE INSTALLATION SITE.
- PAINT UNGALVANIZED OR UNPAINTED CARBON STEEL COMPONENTS WITH  
A. TWO (2) COATS OF 201H UNIVERSAL EPOXY PRIMER 2-3 mil DFT OR TWO COATS OF DEVCOE BAR-RUST 235 MULTIPURPOSE PRIMER 4-8 mil DFT THEN  
B. THEN ONE(1) COAT OF DEVTHANE 389 POLYURETHANE TWO-PART SYSTEM 4-8 mil DFT.
- ALL EXTERNAL FASTENERS TO BE OF STAINLESS STEEL UNLESS OTHERWISE NOTED.

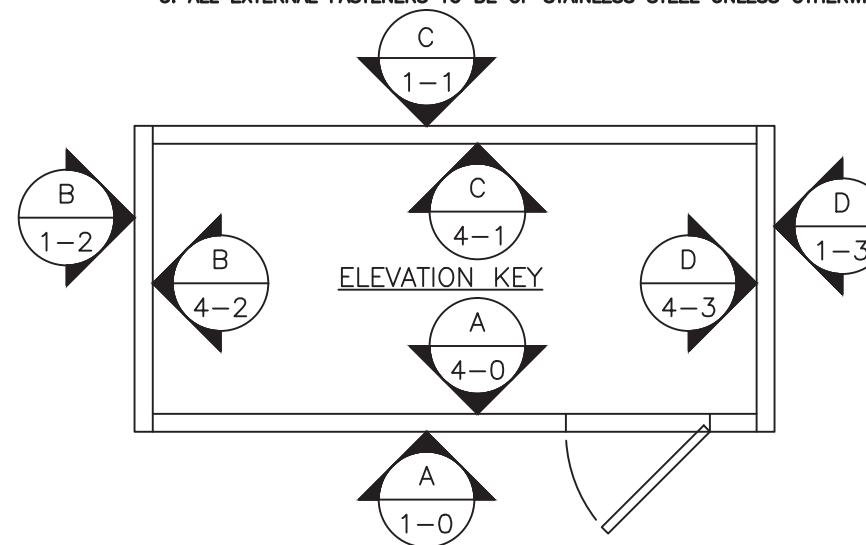

ZONE	EXTERIOR COMPONENTS AND CLADDING POSITIVE AND NEGATIVE PRESSURES IN TERMS OF PSF			
	2000 IBC, 120 MPH WIND SPEED	2003 IBC, 2006 IBC, 120 MPH WIND SPEED	2000,2003,2006,2009,2012 IBC, 150 MPH WIND SPEED	2010 FBC, 180 MPH WIND SPEED
ROOF ZONE 1 (100 SF EFFECTIVE WIND AREA)	+12.1/-28.7	+10.0/-28.7	+15.7/-44.8	+22.7/-64.5
ROOF ZONE 2 (20 SF EFFECTIVE WIND AREA)	+12.1/-46.9	+12.0/-46.9	+18.6/-73.4	+26.9/-105.8
ROOF ZONE 3 (10 SF EFFECTIVE WIND AREA)	+12.7/-79.1	+12.7/-79.1	+20.0/-123.7	+28.7/-178.1
WALL ZONE 4 (200 SF EFFECTIVE WIND AREA)	+25.8/-28.4	+25.8/-28.4	+39.8/-43.4	+58.2/-64.1
WALL ZONE 5 (30 SF EFFECTIVE WIND AREA)	+29.3/-38.0	+29.3/-38.0	+45.9/-59.2	+65.9/-92.3

REV	BY	DATE	DESCRIPTION	APP. BY	DATE
P	RRG	10/31/12	ADDED SHEETS	LJL	10/31/12
N	JWR	6/29/12	CORRECTED NOTES	LJL	6/29/12

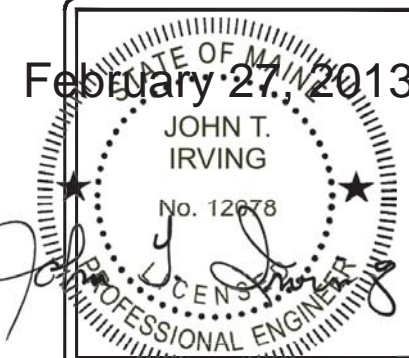

THIS DRAWING IS THE CONFIDENTIAL PROPERTY AND CONTAINS TRADE SECRETS OF CELLXION, LLC. ANY USE OF THESE DRAWINGS OR THE INFORMATION CONTAINED HEREIN FOR ANY REASON OTHER THAN AS EXPRESSLY AUTHORIZED BY SABRE INDUSTRIES, INC. IS STRICTLY PROHIBITED. THIS DRAWING HAS BEEN DISTRIBUTED WITH THE UNDERSTANDING THAT ANYONE RECEIVING OR OTHERWISE OBTAINING POSSESSION OF IT WILL BE EXPRESSLY NOTIFIED OF ITS CONFIDENTIAL NATURE.

**Cellxion**

5031 Hazel Jones Road  
Bossier City, Louisiana 71111  
voice: (318) 213-2900  
fax: (318) 213-2919  
www.cellxion.com

CUSTOMER:  
**KELLOGG BROWN & ROOT FEMA (PEP) EXPANSION PROGRAM**

PROJECT:  
**10'-0" X 18'-0" CONCRETE SHELTER COVER SHEET**


FILENAME: KBR/SKBRO2	
SCALE: N.T.S.	TOLERANCE:
DRWN. BY: M. FOWLER	DATE: 03/24/2010
CHK. BY: V. HASSELL	DATE: 03/24/2010
ENG. BY:	DATE:
APP. BY: A. DUMAS	DATE: 03/24/2010

SHEET NO. 0-0	DRAWING NO.:	REV.:
	SKBR02	P



PARTS LIST

ITEM	QTY	U/M	P/N	DESCRIPTION	ITEM	QTY	U/M	P/N	DESCRIPTION
1	4.0000	EA.	168177	BOLT,1/2"x2" UNC,STAINLESS STEEL (INSTALL DEPT.)	77	10.0000	FT.	400846	WIRE,#22,4 PAIR,SOLID,NO SHLD,8757
2	4.0000	EA.	168186	WASHER,1/2" FLAT,STAINLESS (INSTALL DEPT.)	78	4.0000	EA.	400893	CORD,POWERSUPPLY,12/3,PIGTAIL,8FT
3	4.0000	EA.	168188	WASHER,1/2" LOCK,STAINLESS (INSTALL DEPT.)	79	2.0000	EA.	410000	CONDULET,BODY COVER,1" ALUM
4	4.0000	EA.	168488	ANCHOR,DROP IN,1/2"x2",SS (INSTALL DEPT.)	80	2.0000	EA.	410041	CONDULET,GASKET 1",GASKO35N
5	3.0000	EA.	440093	TELEPHONE,JACK,WALL MOUNT,DUPLEX (INSTALL DEPT.)	81	6.0000	FT.	410112	CONDUIT,LFMC,1/2",SEALTITE
6	2.0000	EA.	480034	TELEPHONE,RJ-11 PLUG,325954UL (INSTALL DEPT.)	82	7.0000	EA.	410117	CONNECTOR,LFMC,1/2",STRAIGHT,ST
7	1.0000	EA.	480175	SHelf RISER,96",WORK BENCH,R-1096 (INSTALL DEPT.)	83	2.0000	EA.	410118	CONNECTOR,LFMC,1/2",90D,SEALTITE
8	1.0000	EA.	480176	WORK BENCH,96"x30",WB-1-3096P (INSTALL DEPT.)	84	1.0000	EA.	410120	CONNECTOR,LFMC,3/4",90D,SEALTITE
9	1.0000	EA.	900102	HEMP CABINET (INSTALL DEPT.) (PROVIDED BY OTHERS)	85	1.0000	EA.	410129	CONNECTOR,LFMC,3/4",STRAIGHT,ST
10	1.0000	EA.	168283	BUSHING,PLASTIC,1/2",SNAP-IN,HEYCO	86	1.0000	EA.	410446	CONNECTOR,CORD GRIP,1",CG1003A
11	1.0000	EA.	170112	PIPE CAP,PLASTIC,NPT,NIAGARA #249	87	1.0000	EA.	420006	LABEL,BLK,ELECT,"GFCI"
12	1.0000	EA.	170113	PIPE CAP,PLASTIC,NPT,NIAGARA #205	88	1.0000	EA.	420009	LABEL,BLK,ELECT,"INTERIOR LIGHT"
13	5.0000	EA.	170114	PIPE CAP,PLASTIC,NPT,NIAGARA #195F	89	1.0000	EA.	420016	LABEL,BLK,ELECT,"LEAD-LAG CONTROLLER"
14	1.0000	EA.	170125	PIPE CAP,PLASTIC,NPT,NIAGARA #257	90	80.0000	EA.	420033	LABEL,SELF TRANSFER,PANDUIT TTSL2
15	1.0000	EA.	390003	ALARM,F/C,PANEL,FIKE,051	91	1.0000	EA.	420036	LABEL,BLK,ELECT,"HVAC DISCONNECT"
16	1.0000	EA.	390006	ALARM,F/C,MANUAL PULL,FIKE,3710	92	1.0000	EA.	420041	LABEL,"ARC FLASH AND SHOCK WARNING"
17	1.0000	EA.	390036	ALARM, RED WP BACK BOX, FIKE	93	7.0000	EA.	420047	LABEL,BLK,ELECT,"120V RECEPT"
18	1.0000	EA.	400666	CARD HOUSING W/AC DC 48V ADAPT	94	1.0000	EA.	420079	LABEL,BLK,ELECT,"CKT 8"
19	1.0000	EA.	410004	CONDULET,BODY COVER,1/2" ALUM (OR EQUAL)	95	1.0000	EA.	420080	LABEL,BLK,ELECT,"CKT 10"
20	2.0000	EA.	410006	CONDULET,BODY AL LB,1",LB100D	96	1.0000	EA.	420091	LABEL,BLK,ELECT,"CKT 11"
21	1.0000	EA.	410025	CONDULET,BODY AL LL,1/2",LL50D (OR EQUAL)	97	1.0000	EA.	420111	LABEL, BLK, ELECT, "CKT 07"
22	1.0000	EA.	410039	CONDULET,GASKET 1/2",GASKO15N (OR EQUAL)	98	1.0000	EA.	420143	LABEL,RED, ELECT,BONDING TAG
23	1.0000	EA.	410045	LOCKNUT,EMT,1/2"	99	2.0000	EA.	420155	LABEL,BLK,ELECT,"CKT 9"
24	12.0000	EA.	410047	LOCKNUT,EMT,1"	100	1.0000	EA.	420167	LABEL,BLK,ELECT,"CKT 23 & 25"
25	1.0000	EA.	410075	BUSHING,1/2",PLASTIC	101	1.0000	EA.	420168	LABEL,BLK,ELECT,"CKT 27 & 29"
26	0.0000	EA.	410077	BUSHING,EMT,1",PLASTIC	102	2.0000	EA.	420169	LABEL,BLK,ELECT,"208V RECEPT"
27	5.0000	EA.	410079	BUSHING,EMT,1 1/2",PLASTIC	103	1.0000	EA.	420174	LABEL,BLK,ELECT,"CKT 18"
28	2.0000	EA.	410080	BUSHING,2",PLASTIC	104	2.0000	EA.	420192	LABEL,BLK,ELECT,"CKT 20"
29	1.5000	EA.	410111	CONDUIT,LFMC,3/4",SEALTITE	105	1.0000	EA.	420194	LABEL,BLK,ELECT,"CKT 22"
30	4.5000	FT.	410112	CONDUIT,LFMC,1/2",SEALTITE	106	2.0000	EA.	420196	LABEL,BLK,ELECT,"CKT 24"
31	2.0000	EA.	410182	NIPPLE,RIGID,3/4"x8 1/2"	107	1.0000	EA.	420197	LABEL,BLK,ELECT,"CKT 12&14&16"
32	2.0000	EA.	410184	NIPPLE,RIGID,1/2"x7 1/2"	108	1.0000	EA.	420201	LABEL,BLK,ELECT,"OPTICAL CONNECTOR"
33	1.0000	EA.	410205	NIPPLE,RIGID,2"x8"	109	1.0000	EA.	420202	LABEL,BLK,ELECT,"208V 3-PHASE"
34	1.0000	EA.	410217	NIPPLE,RIGID,1"x8"	110	1.0000	EA.	420203	LABEL,BLK,ELECT,"CIRCUIT BREAKER BOX"
35	4.0000	EA.	410224	NIPPLE,RIGID,1 1/2"x8"	111	1.0000	EA.	420205	LABEL,BLK,ELECT,"CKT 17&19&21"
36	1.0000	EA.	410281	NIPPLE,RIGID,1 1/2"x8 1/2"	112	1.0000	EA.	420245	LABEL,BLK,ELECT,"HUMIDISTAT"
37	1.0000	EA.	410289	NIPPLE,RIGID,1/2"x3 1/2"LONG	113	1.0000	EA.	420321	LABEL,BLK,ELECT,"NORMAL"
38	3.0000	EA.	410347	NIPPLE,RIGID,1"x4 1/2"	114	1.0000	EA.	420322	LABEL,BLK,ELECT,"BYPASS"
39	2.0000	EA.	410352	NIPPLE,RIGID,1"x9"	115	1.0000	EA.	420325	LABEL,BLK,ELEC,"FEMA PHONE JACK #1"
40	1.0000	EA.	410357	NIPPLE,RIGID,1/2"x5"	116	1.0000	EA.	420326	LABEL,BLK,ELEC,"PHONE JACK #2"
41	1.0000	EA.	410519	CONNECTOR,FLEX CORD,.5-.75"	117	1.0000	EA.	420327	LABEL,BLK,ELEC,"PHONE JACK #3"
42	5.0000	EA.	430003	BOX,JUNCT,4 OCT X1 1/2,3/4&1/2KO	118	1.0000	EA.	420329	LABEL,YEL,"OSHA CLEARANCE REQUIRE"
43	21.0000	EA.	430005	BOX,JUNCT,4"x4",2-1/8D,1/2"-3/4KO	119	6.0000	EA.	430001	COVER,BLANK PLATE,4X2,HANDY (OR EQUAL)
44	6.0000	EA.	430029	BOX,JUNCT,4-11/16"x4-11/16"D-2 1/8"	120	1.0000	EA.	430006	COVER,SWITCH PLATE,4X4,1 SWITCH
45	1.0000	EA.	430030	BOX,JUNCT,2X4,WP,(3) 1/2"HOLES	121	2.0000	EA.	430007	COVER,RECPT PLATE,4X4,1 REC,IND
46	4.0000	EA.	430034	RECEPTACLE,DUPLEX,125V,20A,IVORY	122	11.0000	EA.	430012	COVER,BLANK PLATE,4X4
47	5.0000	EA.	430054	BOX,JUNCT,2"x4",1 7/8" (OR EQUAL)	123	1.0000	EA.	430013	COVER,PLAST RING,4X4,1/4" RISE
48	1.0000	EA.	430146	BOX,6X6X4,SCREW COVER,NEMA 3A,6R64	124	6.0000	EA.	430014	COVER,BLANK PLATE,4 11/16
49	1.0000	EA.	430148	BOX,10X8X6,SCREW COVER,NEMA1,	125	6.0000	EA.	430025	COVER,RECPT PLATE,4X4,2R
50	1.0000	EA.	430208	DISCONNECT,SQD,60A,NOFUSED,DU322RB	126	1.0000	EA.	430033	RECEPTACLE,GFCI,120V,20A,IVORY
51	1.0000	EA.	430240	BOX,BACK,GEN RECPT 60A,MELTRIC	127	6.0000	EA.	430034	RECEPTACLE,DUPLEX,125V,20A,IVORY
52	1.0000	EA.	430367	COVER,BLANK PLATE,4X4 WP	128	2.0000	EA.	430052	HUB,3/4",SS,MYERS,SSTG-2
53	1.0000	EA.	430568	BOX,6X6X6,SCREW COVER,NEMA6P	129	1.0000	EA.	430084	SWITCH,SPST,20A,120V,IVORY
54	1.0000	EA.	430720	LOADCENTER,SQD,BOX,MH32	130	1.0000	EA.	430176	RECEPT,DECONTACTOR,FEMALE,MELTRIC
55	1.0000	EA.	430992	BOX,JUNCT,WP,DEEP,(3)1/2 HOLES, COMPLETE WITH (2) THREADED HOLE PLUGS	131	1.0000	EA.	430180	RECEPT,DECONTACTOR,MALE,MELTRIC
56	1.0000	EA.	431328	BOX,ENCLOSURE,16X16X8,HASP,NEMA1	132	1.0000	EA.	430181	GEN RECEPT,HANDLE,METAL,MELTRIC
57	20.0000	EA.	440074	SURGE PROTECT. MODULE,CIRCA,4B3S-75	133	3.0000	EA.	430286	BOX,ENCLOSURE,16X16X6,HINGED,NEMA3
58	1.0000	EA.	440079	AUTO DIALER,DUAL IN,VIKING K-202-DVA	134	1.0000	EA.	430384	COVER,GFCI,2 REC,HORZ,WTS15A-C
59	5.0000	EA.	440098	SURGE PROTECT,MODULE,CIRCA,3B1E	135	0.3500	EA.	430521	RAIL,DIN,AS,35MM X 7.5MM X 17.5IN
60	1.0000	EA.	460116	CONTROLLER,COMSTAT 3,MARVAR,S/04581					
61	1.0000	EA.	900154	MONITOR,FUEL,INCON,TS-550 (PROVIDED BY OTHERS)					
62	2.0000	EA.	390004	ALARM,F/C,DET,PHOTOELECTIC,FIKE					
63	1.0000	EA.	390007	ALARM,F/C,HORN/STROBE,FIKE,098					
64	1.0000	EA.	390008	ALARM,F/C,BATTERY ASSEMBLY					
65	2.0000	EA.	390033	ALARM,F/C,DET,BASE,FIKE					
66	1.0000	EA.	390034	ALARM,F/C,MODULE OPTIONAL,FIKE,RM4					
67	1.0000	EA.	390035	ALARM,F/C,EXTERIOR WP,STROBE					
68	12.0000	FT.	400072	WIRE,#6/5,TYPE W MULTICONDUCTOR CAB					
69	9.0000	EA.	400272	BREAKER,SQD,1P 20A,BOLT ON,QOB120					
70	4.0000	EA.	400273	BREAKER,SQD,1P 15A,BOLT ON,QOB115					
71	1.0000	EA.	400303	BREAKER,SQD,3P 100A,BOLT ON,QOB3100					
72	1.0000	EA.	400315	BREAKER,SQD,3P 30A,BOLT ON,QOB330					
73	1.0000	EA.	400316	BREAKER,SQD,3P 35A,BOLT ON,QOB335					
74	1.0000	EA.	400359	BREAKER,SQD,3P 40A,BOLT ON,QOB340					
75	1.0000	EA.	400665	CONTACT,RX CARD,RLH,8C4-M2STR-01					
76	1.0000	EA.							

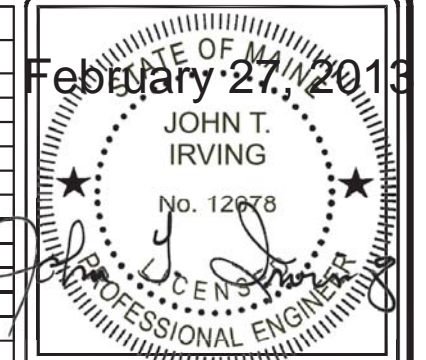

THIS DRAWING IS THE CONFIDENTIAL PROPERTY AND CONTAINS TRADE SECRETS OF CELLXION, LLC. ANY USE OF THESE DRAWINGS OR THE INFORMATION CONTAINED HEREIN FOR ANY REASON OTHER THAN AS EXPRESSLY AUTHORIZED BY SABRE INDUSTRIES, INC. IS STRICTLY PROHIBITED. THIS DRAWING HAS BEEN DISTRIBUTED WITH THE UNDERSTANDING THAT ANYONE RECEIVING OR OTHERWISE OBTAINING POSSESSION OF IT WILL BE EXPRESSLY NOTIFIED OF ITS CONFIDENTIAL NATURE.

**cellxion**  
 5031 Hazel Jones Road  
 Bossier City, Louisiana 71111  
 voice: (318) 213-2900  
 fax: (318) 213-2919  
 www.cellxion.com

CUSTOMER:  
**KELLOGG  
 BROWN & ROOT  
 FEMA (PEP)  
 EXPANSION PROGRAM**

PROJECT:  
**10'-0" X 18'-0"  
 CONCRETE SHELTER  
 PARTS LIST**

FILENAME: KBR/SKBR02	
SCALE: N.T.S.	TOLERANCE:
DRWN. BY: M. FOWLER	DATE: 03/24/2010
CHK. BY: V. HASSELL	DATE: 03/24/2010
ENG. BY:	DATE:
APP. BY: A. DUMAS	DATE: 03/24/2010
SHEET NO. 0-1	
DRAWING NO.:	REV.:
SKBR02	P

P	RRG	10/31/12	UPDATED PARTS LIST	LJL	10/31/12
N	JWR	6/29/12	UPDATED PARTS LIST	LJL	6/29/12
N	RRG	6/13/12	UPDATED PARTS LIST	LJL	6/13/12
REV	BY	DATE	DESCRIPTION	APP.BY	DATE

PARTS LIST (CONTINUED)

ITEM	QTY	U/M	P/N	DESCRIPTION
136	1.0000	EA.	430721	PANELBOARD,SQD,COVER,NC32S
137	1.0000	EA.	430792	PANELBOARD,SQD,100A,30P,3PH,NQ430L1
138	1.0000	EA.	430923	ALARM BLOCK,CIRCA,1880ECA1-25 (TELCO CONNECTION BOX)
139	10.0000	EA.	430925	TERMINAL BLOCK,40A,35 SECTIONS
140	2.0000	EA.	430994	TERMINAL BLOCK,END,BARRIER,9080GK6
141	2.0000	EA.	431361	RECEPTACLE,SINGLE,125V,15A,STRAIGHT
142	1.0000	EA.	440071	SURGE ARRESTOR,SQ-D,3PHASE,SDSA3650
143	1.0000	EA.	440114	UPS,SYSTEM,5130 SERIES,EATON
144	1.0000	EA.	440115	UPS,SYSTEM,3105 SERIES,EATON
145	5.0000	EA.	470083	LIGHT FIXTURE,60W/250V,PORCELAIN
146	5.0000	EA.	470085	LIGHT,STEEL GUARD FOR INCANSCENT
147	5.0000	EA.	470217	LIGHT BULB,60W,INCANDESCENT,120V
148	1.0000	EA.	490000	ALARM,MAGNETIC DOOR CONTACT
149	1.0000	EA.	490104	DETECTOR,HUMIDITY,DG115EZIAQ,HONEYWELL
150	1.0000	EA.	504678	SWITCH,KEYED,SECURITY,SDC702U
151	1.0000	EA.	540211	G-BAR KIT,SQUARE D,PK23GTAL
152	1.0000	EA.	900114	INTERCONNECT CENTER,WALL,WIC-012
153	2.0000	EA.	146011-007	PLATE,COVER,BLOCKOUT,22"x30",GALV.
154	2.0000	EA.	146011-008	PLATE,COVER,BLOCKOUT,22"x30",GALV.
155	1.0000	EA.	146556-003	GROUND STRIP,SS,1"x4" 18 GA
156	8.0000	EA.	168031	WASHER,3/8" FLAT,STAINLESS STEEL
157	8.0000	EA.	168032	NUT,3/8"-UNC,HEX,STAINLESS STEEL
158	8.0000	EA.	168118	BOLT,CARRIAGE,GALV.3/8"x8"
159	82.0000	EA.	168215	SCREW,OVAL,#14X1 1/2",PH,SS
160	82.0000	EA.	168216	WASHER,#14 FLANGE SS
161	8.0000	EA.	168280	NUT,3/8",ACORN,STAINLESS STEEL
162	12.0000	EA.	168536	SCREW,WOOD,#8X1/2IN,PH,ROUND,SS
163	16.0000	EA.	168553	SCREW,WOOD,#10X3/4IN,ST,ROUND,SS
164	2.0000	EA.	350054	PLATE,MOUNT,HVAC,EXT,3/4"x22"x29"
165	2.0000	EA.	350055	PLATE,MOUNT,HVAC,INT,3/4"x22"x29"
166	4.5000	FT.	400073	WIRE,#4 THHN,STRAND,GRN
167	12.0000	EA.	400371	LUG,2H,#6,BLU,1/4"BOLT,3/4"C/C,LBFW
168	1.0000	EA.	400377	LUG,2H,#4,GRY,1/4"BOLT,3/4"C/C,LBFW
169	7.0000	EA.	400390	LUG,2H,#2,BRN,1/4"BOLT,3/4"C/C,LBFW
170	4.0000	EA.	410396	BUSHING,INSULATING,CEILING BRACKET
171	2.0000	EA.	410397	BUSHING,INSULATING,WALL MOUNT BRACK
172	1.0000	EA.	420445	LABEL,BLK,"INTAKE ONLY LWR OPENING"
173	1.0000	EA.	420446	LABEL,BLK,"EXHAUST UPPER OPENING"
174	1.0000	EA.	420447	LABEL,BLK,"INTAKE ONLY, CAP VACANT"
175	1.0000	EA.	420448	LABEL,BLK,"EXHAUST ONLY, CAP VACANT"
176	1.0000	EA.	470423	LOUVER,8"x9 1/2",HOFFMAN,AVK86
177	4.0000	EA.	470468	SCREEN MESH,SS,1/8"WIRE,6"DIA
178	2.0000	EA.	470646	VENT,INTAKE,6" FIXED W/BUG SCREEN
179	2.0000	EA.	470647	VENT,EXHAUST,6" GRAVITY OPERATED
180	1.0000	EA.	480005	CELLXION BRASS GREEN SERIAL NO.PLAT
181	1.0000	EA.	510000	CABLE LADDER,12"x9'8 1/2",YELLOW ZI
182	1.0000	EA.	510006	CABLE LADDER,12",CLOSING BAR,Y/Z
183	2.0000	EA.	510074	CABLE LADDER,FLOOR BRKT,3.5"x1.5"
184	2.0000	EA.	510079	UNISTRUT,1 5/8"CHANNEL,GOLDGALV,15"
185	4.0000	EA.	510155	CABLE LADDER,TRAY HANGER,17"
186	1.0000	EA.	521001	HVAC,GRILL,SUPPLY,8"x20"
187	1.0000	EA.	521101	HVAC,GRILL,RETURN,12"x20"
188	1.0000	EA.	522001-00014	HVAC,SLEEVE,8"x20"x6"
189	1.0000	EA.	522001-00015	HVAC,SLEEVE,11 3/4"x20"x6"
190	1.0000	EA.	530031	WAVEGUIDE ENTRY,1 PORT,4"
191	1.0000	EA.	530075	COAX ADAPTER PLATE,15"x17",SAT
192	4.0000	EA.	530077	ADAPTER,AMPHENOL,CO82-66-RFX
193	4.0000	EA.	530078	ADAPTER,AMPHENOL,CO83-1F
194	4.0000	EA.	530079	ADAPTER,L-COM,WPRJ-FTCAT5E
195	4.0000	EA.	530080	ADAPTER,AMPHENOL,C531-40084-1
199	91.0000	FT.	540009	GROUND STRAP FLAT COPPER 4"WX100'L
199	1.0000	EA.	P540299-01	G-BAR,KIT,CU,540299-01
200	3.0000	EA.	504000	DOOR,HINGES,STAINLESS STEEL 32D
201	1.0000	EA.	504100	DOOR,CLOSER,SARGENT 1104,ALUM
202	1.0000	EA.	504102	DOOR,BUMPER,SS RUBBER STOP,BLACK
203	1.0000	EA.	504113	DOOR,HOLD OPEN,T-LATCH,6" SS
204	1.0000	EA.	504300	DOOR,LOCKGUARD,10" 32D
205	1.0000	EA.	504400	DOOR,DRIP CAP,NGF16A-48"
206	1.0000	EA.	504409	DOOR,THRESHOLD 42"x4.75",.090 ALUM
207	1.0000	EA.	504437	DOOR,THRESHOLD 42"x6.25",.090 ALUM
208	1.0000	EA.	504501	CORE,LOCKSET,BEST,CONSTRUCT,GREEN
209	2.0000	EA.	504504	DOOR,PULL HANDLE KASON,CAST,382
210	1.0000	EA.	540129	GROUND BAR, COPPER, 1/8" X 1" X 4"
211	1.0000	EA.	540216	GROUND STRAP ASSY,1/2 BRAIDED,18"
212	1.0000	EA.	146514-005	DRIP CAP,48"x3",HVAC

ITEM	QTY	U/M	P/N	DESCRIPTION
213	1.0000	EA.	520005	HVAC,2T,6KW,3PHASE,MARVAIR,ECON,REHT,DEHUM
214	2.0000	EA.	520343	HVAC,PORTABLE,FREIDRICH,P12B(REMOVE FOR SHIPPING)
215	1.0000	EA.	420048	LABEL,DATA,STANDARD SHELTER
216	1.0000	EA.	480001	PLATE,DATA,ALUM,8"x12",GRAY
217	3.5000	EA.	504201	DOOR,SWEEP WEATHERSTRIPPING,42"
218	1.0000	EA.	504222	DOOR,WEATHERSTRIPPING,303-TF-3670
219	1.0000	EA.	146546-006	BRACKET,HANGING,18 GA,GALV,3"x8"x2" (PACKING LIST ITEM)
220	8.0000	FT.	400036	WIRE,#8 THHN,STRAND,GRN (PACKING LIST ITEM)
221	32.0000	FT.	400567	WIRE,#2 THHN,STRAND,BLK (PACKING LIST ITEM)
222	1.0000	EA.	430134	DISCONNECT,100A,4P,DOUBLE THROW,WK (PACKING LIST ITEM)
223	2.0000	EA.	470005	LIGHT FIXTURE,70W,EXTERIOR,WALL W/PHOTOCELL (PACKING LIST ITEM)
224	1.0000	EA.	480000	TRAY,WALL FILE PLASTIC,LR-SMOKE (PACKING LIST ITEM)
225	1.0000	EA.	480087-01	PACKING KIT,TYPICAL EVERY SHELTER (PACKING LIST ITEM)
226	2.0000	EA.	480227	CHAIR,RUVIA MID-BACK,BLACK,676710 (PACKING LIST ITEM)
227	8.0000	EA.	168540	BOLT,CARRIAGE,GALV.3/8"x9"

CUT LIST				
ITEM	P/N	DESCRIPTION	CUT	PCS
29	410111	CONDUIT,LFMC,3/4",SEALTITE	18"	1
30	410112	CONDUIT,LFMC,1/2",SEALTITE	18"	3
68	400072	WIRE,#6/5,TYPE W MULTICONDUCTOR CAB	144"	1
77	400846	WIRE,#22,4 PAIR,SOLID,NO SHLD,8757	120"	1
78	400893	CORD,POWERSUPPLY,12/3,PIGTAIL,8FT	48"	1
81	410112	CONDUIT,LFMC,1/2",SEALTITE	72"	1
166	400073	WIRE,#4 THHN,STRAND,GRN	54"	1
181	510000	CABLE LADDER,12"x9'8 1/2",YELLOW ZI	72"	1
196	540009	GROUND STRAP FLAT COPPER 4"WX100'L	108"	2
197	540009	GROUND STRAP FLAT COPPER 4"WX100'L	360"	1
198	540009	GROUND STRAP FLAT COPPER 4"WX100'L	516"	1
205	504400	DOOR,DRIP CAP,NGF16A-48"	46"	1
217	504201	DOOR,SWEEP WEATHERSTRIPPING,42"	42"	1
220	400036	WIRE,#8 THHN,STRAND,GRN (PACKING LIST ITEM)	96"	1
221	400567	WIRE,#2 THHN,STRAND,BLK (PACKING LIST ITEM)	384"	1

OPTIONAL COMPONENTS								
OPT.	OPT. NO.	TAG NO.	QTY	U/M	PART NO.	DESCRIPTION	CUT	PCS
A	A1	1	1	EA.	500000	DOOR,3670,CURRIES,LH/RH,18G		
		2	3.5	FT.	504216	DOOR,WEATHERSTRIP,SPONGE NEOPRENE	42	1
		3	1	EA.	504222	DOOR,WEATHERSTRIPPING,303-TF-3670		
		4	1	EA.	504503	LOCKSET,DEAD BOLT,CYLINDRICAL,BEST		
		5	1	EA.	504555	DOOR,STRIKER PLATE,STANDARD		
A2 (FLORIDA OPTION)	A2	1	1	EA.	500083	DOOR,3670,CURRIES,RH,16GA,REINFO		
		2	3.5	FT.	504432	DOOR,THRESHOLD,42",#8135	42	1
		3	1	EA.	504220	DOOR,WEATHERSTRIP,P&S,S88BK-204		
		4	1	EA.	504626	LOCKSET,LATCH/DEADBOLT,LH,RUSSWIN		
B	B1	1	-	-	-	NOT REQUIRED		
		B2	1	1	EA.	226116	ICE SHIELD SHELTER CVR,21'6"x11'10"	


NOTE:  
1. A2 OPTIONS: FLORIDA ONLY

SHELTER REQUIRES ONE OPTION NUMBER FROM EACH OPTION LISTED.

NOTE THAT SOME OPTION NUMBERS ARE A KIT W/ MULTIPLE PARTS.

OPTIONS ARE IDENTIFIED ON THE DRAWING BY THE OPTION LETTER [X], BY OPTION NO. [XX], OR BY THE OPTION TAG NO. [XX-X]

P	RRG	10/31/12	UPDATED PARTS LIST	LJL	10/31/12
N	JWR	6/29/12	ADDED CUT LENGTH TO P/N 400893	LJL	6/29/12
N	RRG	6/13/12	UPDATED PARTS LIST	LJL	6/13/12
REV	BY	DATE	DESCRIPTION	APP.BY	DATE

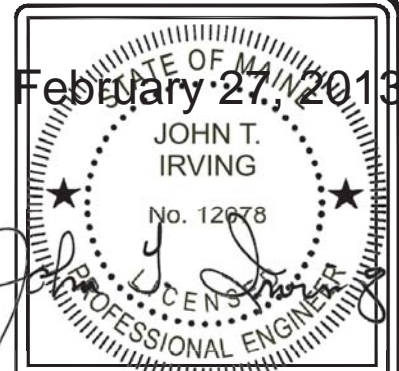

THIS DRAWING IS THE CONFIDENTIAL PROPERTY AND CONTAINS TRADE SECRETS OF CELLXION, LLC. ANY USE OF THESE DRAWINGS OR THE INFORMATION CONTAINED HEREIN FOR ANY REASON OTHER THAN AS EXPRESSLY AUTHORIZED BY SABRE INDUSTRIES, INC. IS STRICTLY PROHIBITED. THIS DRAWING HAS BEEN DISTRIBUTED WITH THE UNDERSTANDING THAT ANYONE RECEIVING OR OTHERWISE OBTAINING POSSESSION OF IT WILL BE EXPRESSLY NOTIFIED OF ITS CONFIDENTIAL NATURE.

**ion**  
5031 Hazel Jones Road  
Bossier City, Louisiana 71111  
voice: (318) 213-2900  
fax: (318) 213-2919  
www.cellxion.com


CUSTOMER:  
**KELLOGG BROWN & ROOT FEMA (PEP) EXPANSION PROGRAM**

PROJECT:  
**10'-0" X 18'-0" CONCRETE SHELTER PART CONT./CUT LIST/OPTIONAL COMPONENTS**

FILENAME: KBR/SKBRO2	
SCALE: N.T.S.	TOLERANCE:
DRWN. BY: M. FOWLER	DATE: 03/24/2010
CHK. BY: V. HASSELL	DATE: 03/24/2010
ENG. BY:	DATE:
APP. BY: A. DUMAS	DATE: 03/24/2010
SHEET NO. 0-2	
DRAWING NO.: SKBR02	REV.: P




SUB-PARTS LIST			
ITEM	P/N	ORIGINAL DESCRIPTION	CUT
205	504400	DOOR, DRIP CAP, NGF16A-48"	46"

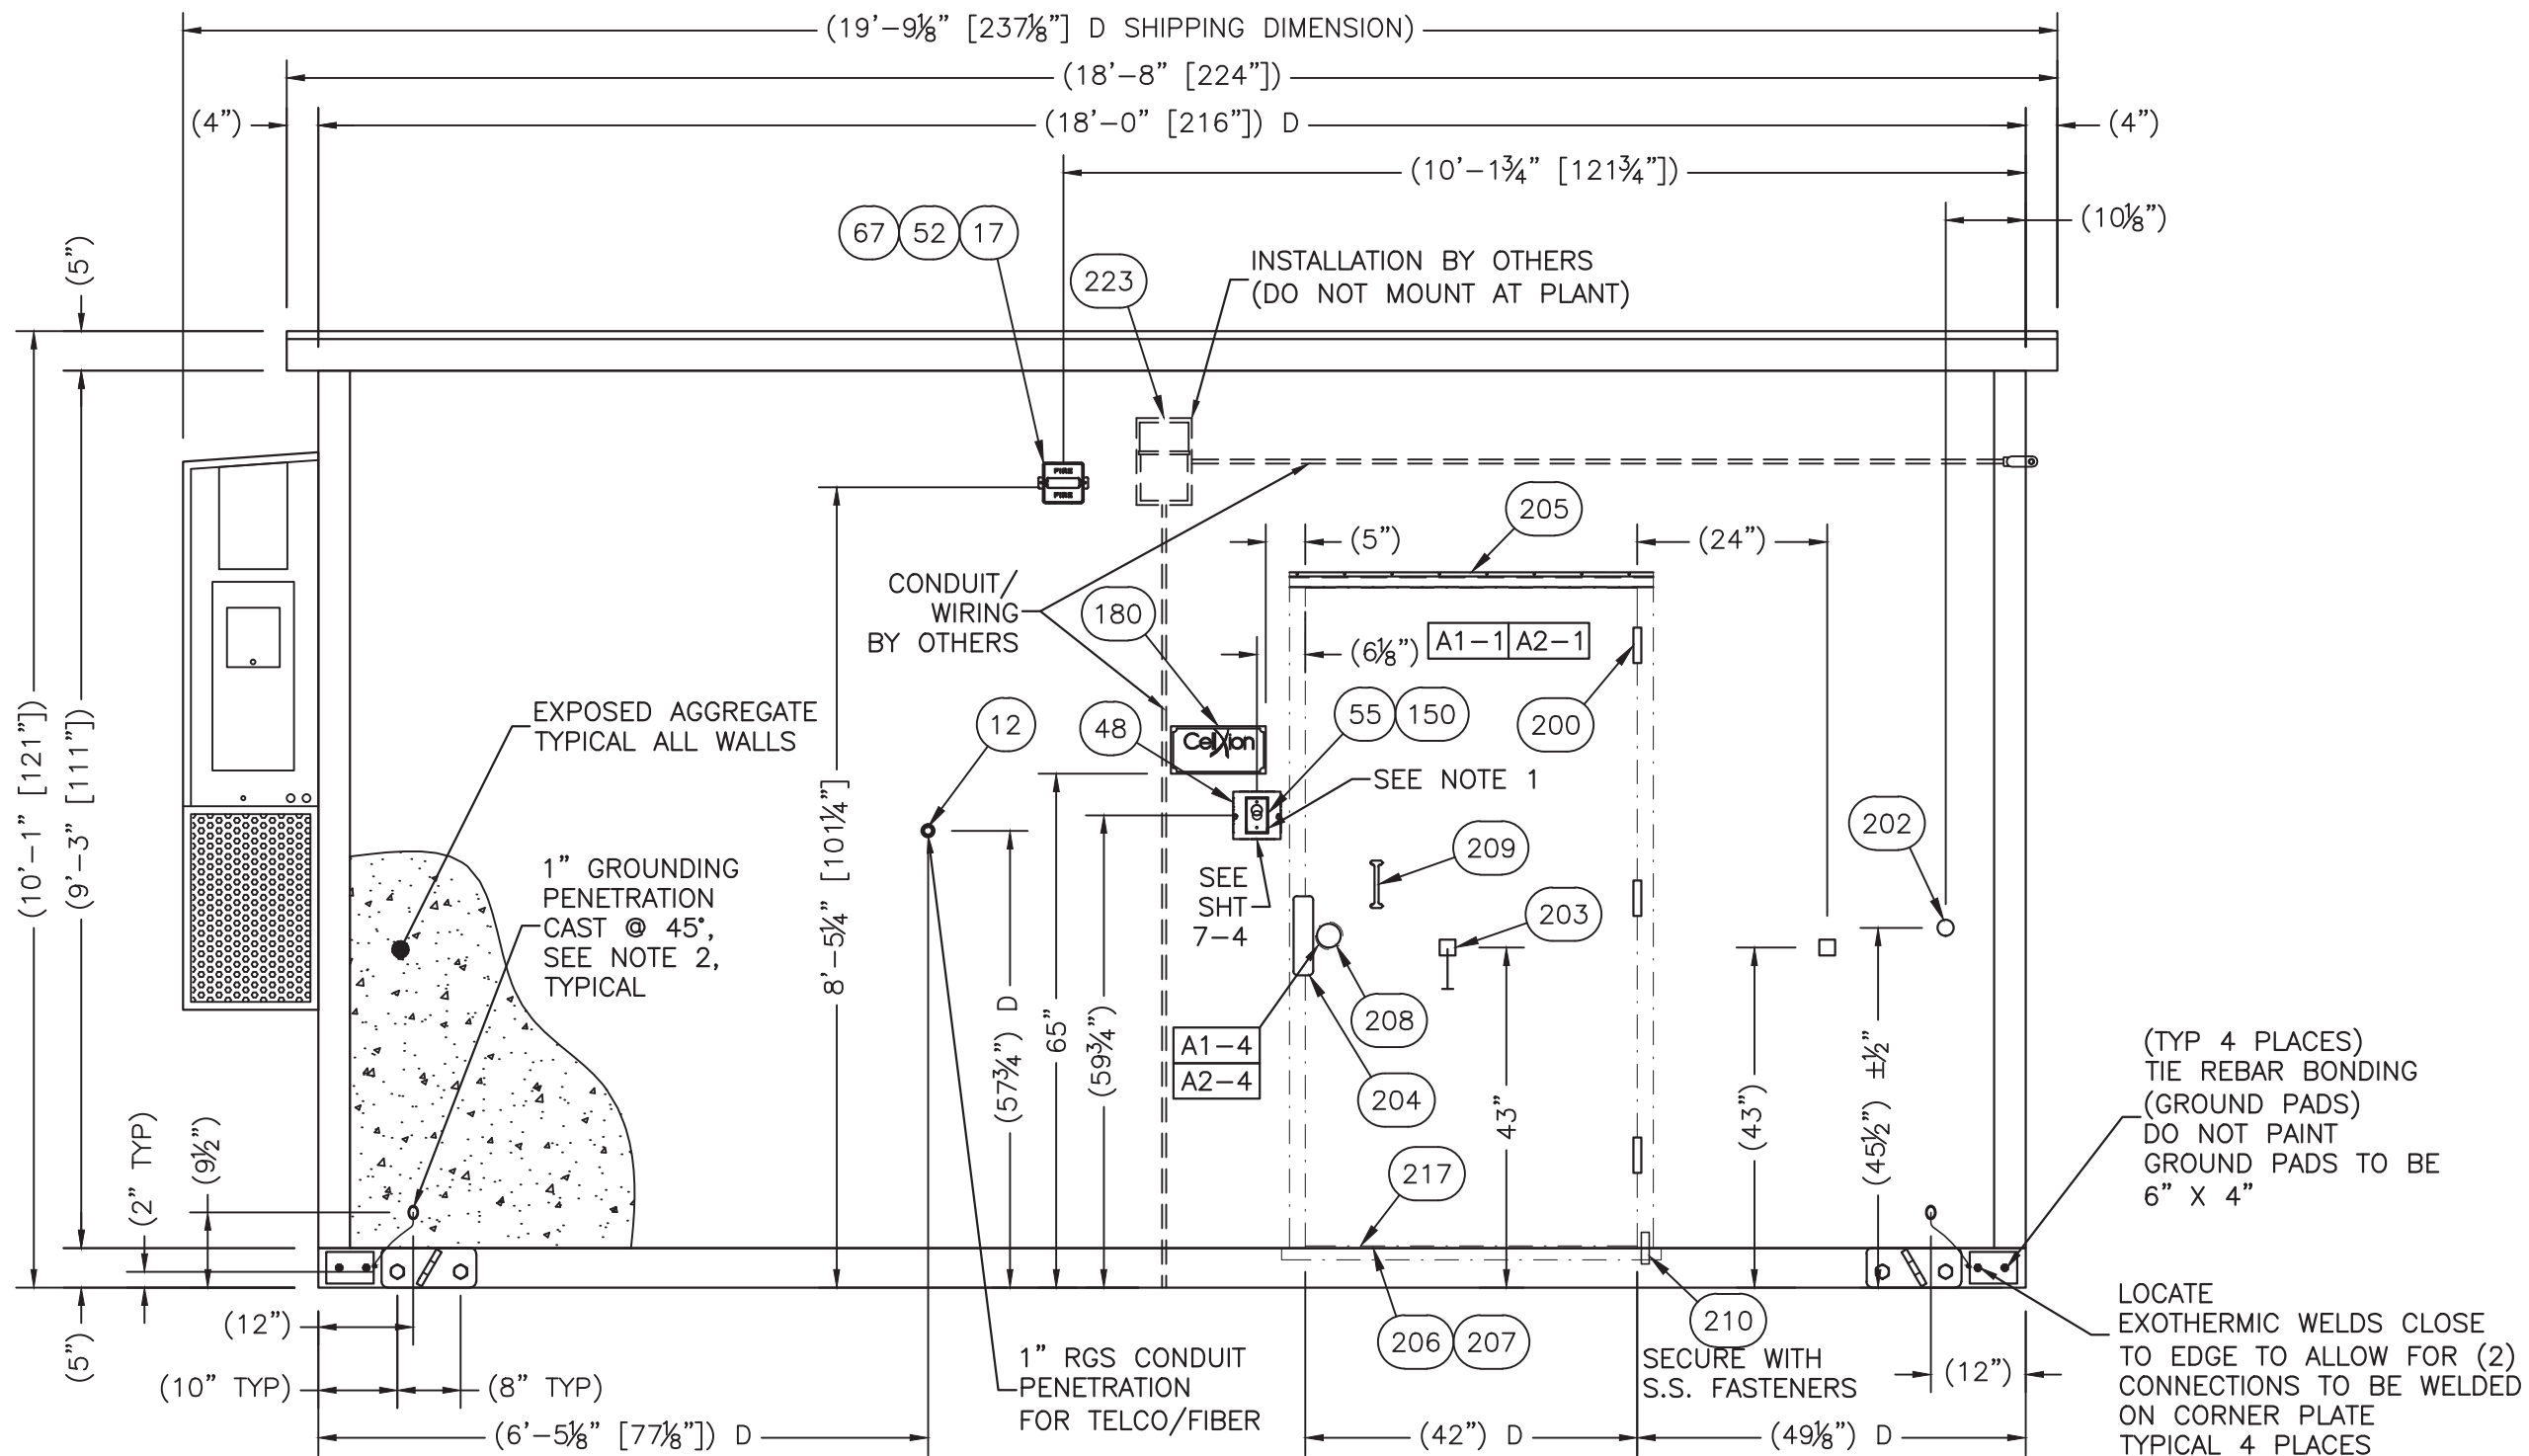

EXTERIOR ELEVATION "A"

- NOTES:
1. GROUT FILL GAPS AROUND BOX, SEAL WITH CAULK.
  2. FILL ALL OPEN PVC PENETRATIONS WITH CAULK

REV	BY	DATE	DESCRIPTION	APP. BY	DATE
N	RRG	6/13/12	ADDED & UPDATED DIMENSIONS/REMOVED NOTE	LJL	6/13/12
M	JJ	11/09/11	CHANGE DOOR SWEEP/ ADD 6X6X4 BOX	LJL	11/09/11
L	RRG	04/21/11	ADDED NOTES	LJL	04/21/11
K	JJ	4/7/11	ADDED TAMPER KEYSWITCH	LJL	4/7/11
J	AMM	02/10/11	ADDED NIPPLE FOR PENETRATION	LJL	02/10/11

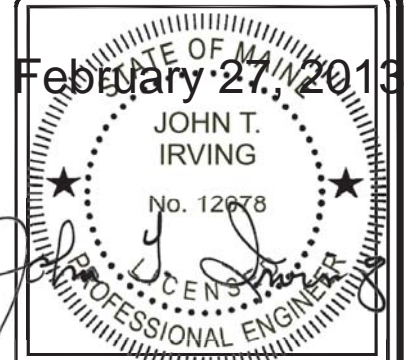

THIS DRAWING IS THE CONFIDENTIAL PROPERTY AND CONTAINS TRADE SECRETS OF CELLXION, LLC. ANY USE OF THESE DRAWINGS OR THE INFORMATION CONTAINED HEREIN FOR ANY REASON OTHER THAN AS EXPRESSLY AUTHORIZED BY SABRE INDUSTRIES, INC. IS STRICTLY PROHIBITED. THIS DRAWING HAS BEEN DISTRIBUTED WITH THE UNDERSTANDING THAT ANYONE RECEIVING OR OTHERWISE OBTAINING POSSESSION OF IT WILL BE EXPRESSLY NOTIFIED OF ITS CONFIDENTIAL NATURE.


**cellxion**  
 5031 Hazel Jones Road  
 Bossier City, Louisiana 71111  
 voice: (318) 213-2900  
 fax: (318) 213-2919  
 www.cellxion.com

CUSTOMER:  
**KELLOGG BROWN & ROOT FEMA (PEP) EXPANSION PROGRAM**

PROJECT:  
**10'-0" X 18'-0" CONCRETE SHELTER EXTERIOR ELEVATION "A"**

FILENAME: KBR/SKBR02	
SCALE: 1/2"=1'-0"	TOLERANCE:
DRWN. BY: M. FOWLER	DATE: 03/24/2010
CHK. BY: V. HASSELL	DATE: 03/24/2010
ENG. BY:	DATE:
APP. BY: A. DUMAS	DATE: 03/24/2010
SHEET NO. 1-0	
DRAWING NO.:	REV.:
SKBR02	P

February 27, 2013

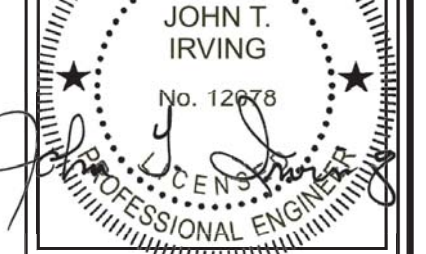


THIS DRAWING IS THE CONFIDENTIAL PROPERTY AND CONTAINS TRADE SECRETS OF CELLXION, LLC. ANY USE OF THESE DRAWINGS OR THE INFORMATION CONTAINED HEREIN FOR ANY REASON OTHER THAN AS EXPRESSLY AUTHORIZED BY SABRE INDUSTRIES, INC. IS STRICTLY PROHIBITED. THIS DRAWING HAS BEEN DISTRIBUTED WITH THE UNDERSTANDING THAT ANYONE RECEIVING OR OTHERWISE OBTAINING POSSESSION OF IT WILL BE EXPRESSLY NOTIFIED OF ITS CONFIDENTIAL NATURE.

**cellxion**  
 5031 Hazel Jones Road  
 Bossier City, Louisiana 71111  
 voice: (318) 213-2900  
 fax: (318) 213-2919  
 www.cellxion.com

CUSTOMER:  
**KELLOGG  
 BROWN & ROOT  
 FEMA (PEP)  
 EXPANSION PROGRAM**


PROJECT:  
**10'-0" X 18'-0"  
 CONCRETE SHELTER  
 EXTERIOR, ELEVATION "C"**

FILENAME: KBR/SKBRO2	
SCALE: 1/2"=1'-0"	TOLERANCE:
DRWN. BY: M. FOWLER	DATE: 03/24/2010
CHK. BY: V. HASSELL	DATE: 03/24/2010
ENG. BY:	DATE:
APP. BY: A. DUMAS	DATE: 03/24/2010
SHEET NO. 1-1	
DRAWING NO.:	REV.:
SKBR02	P

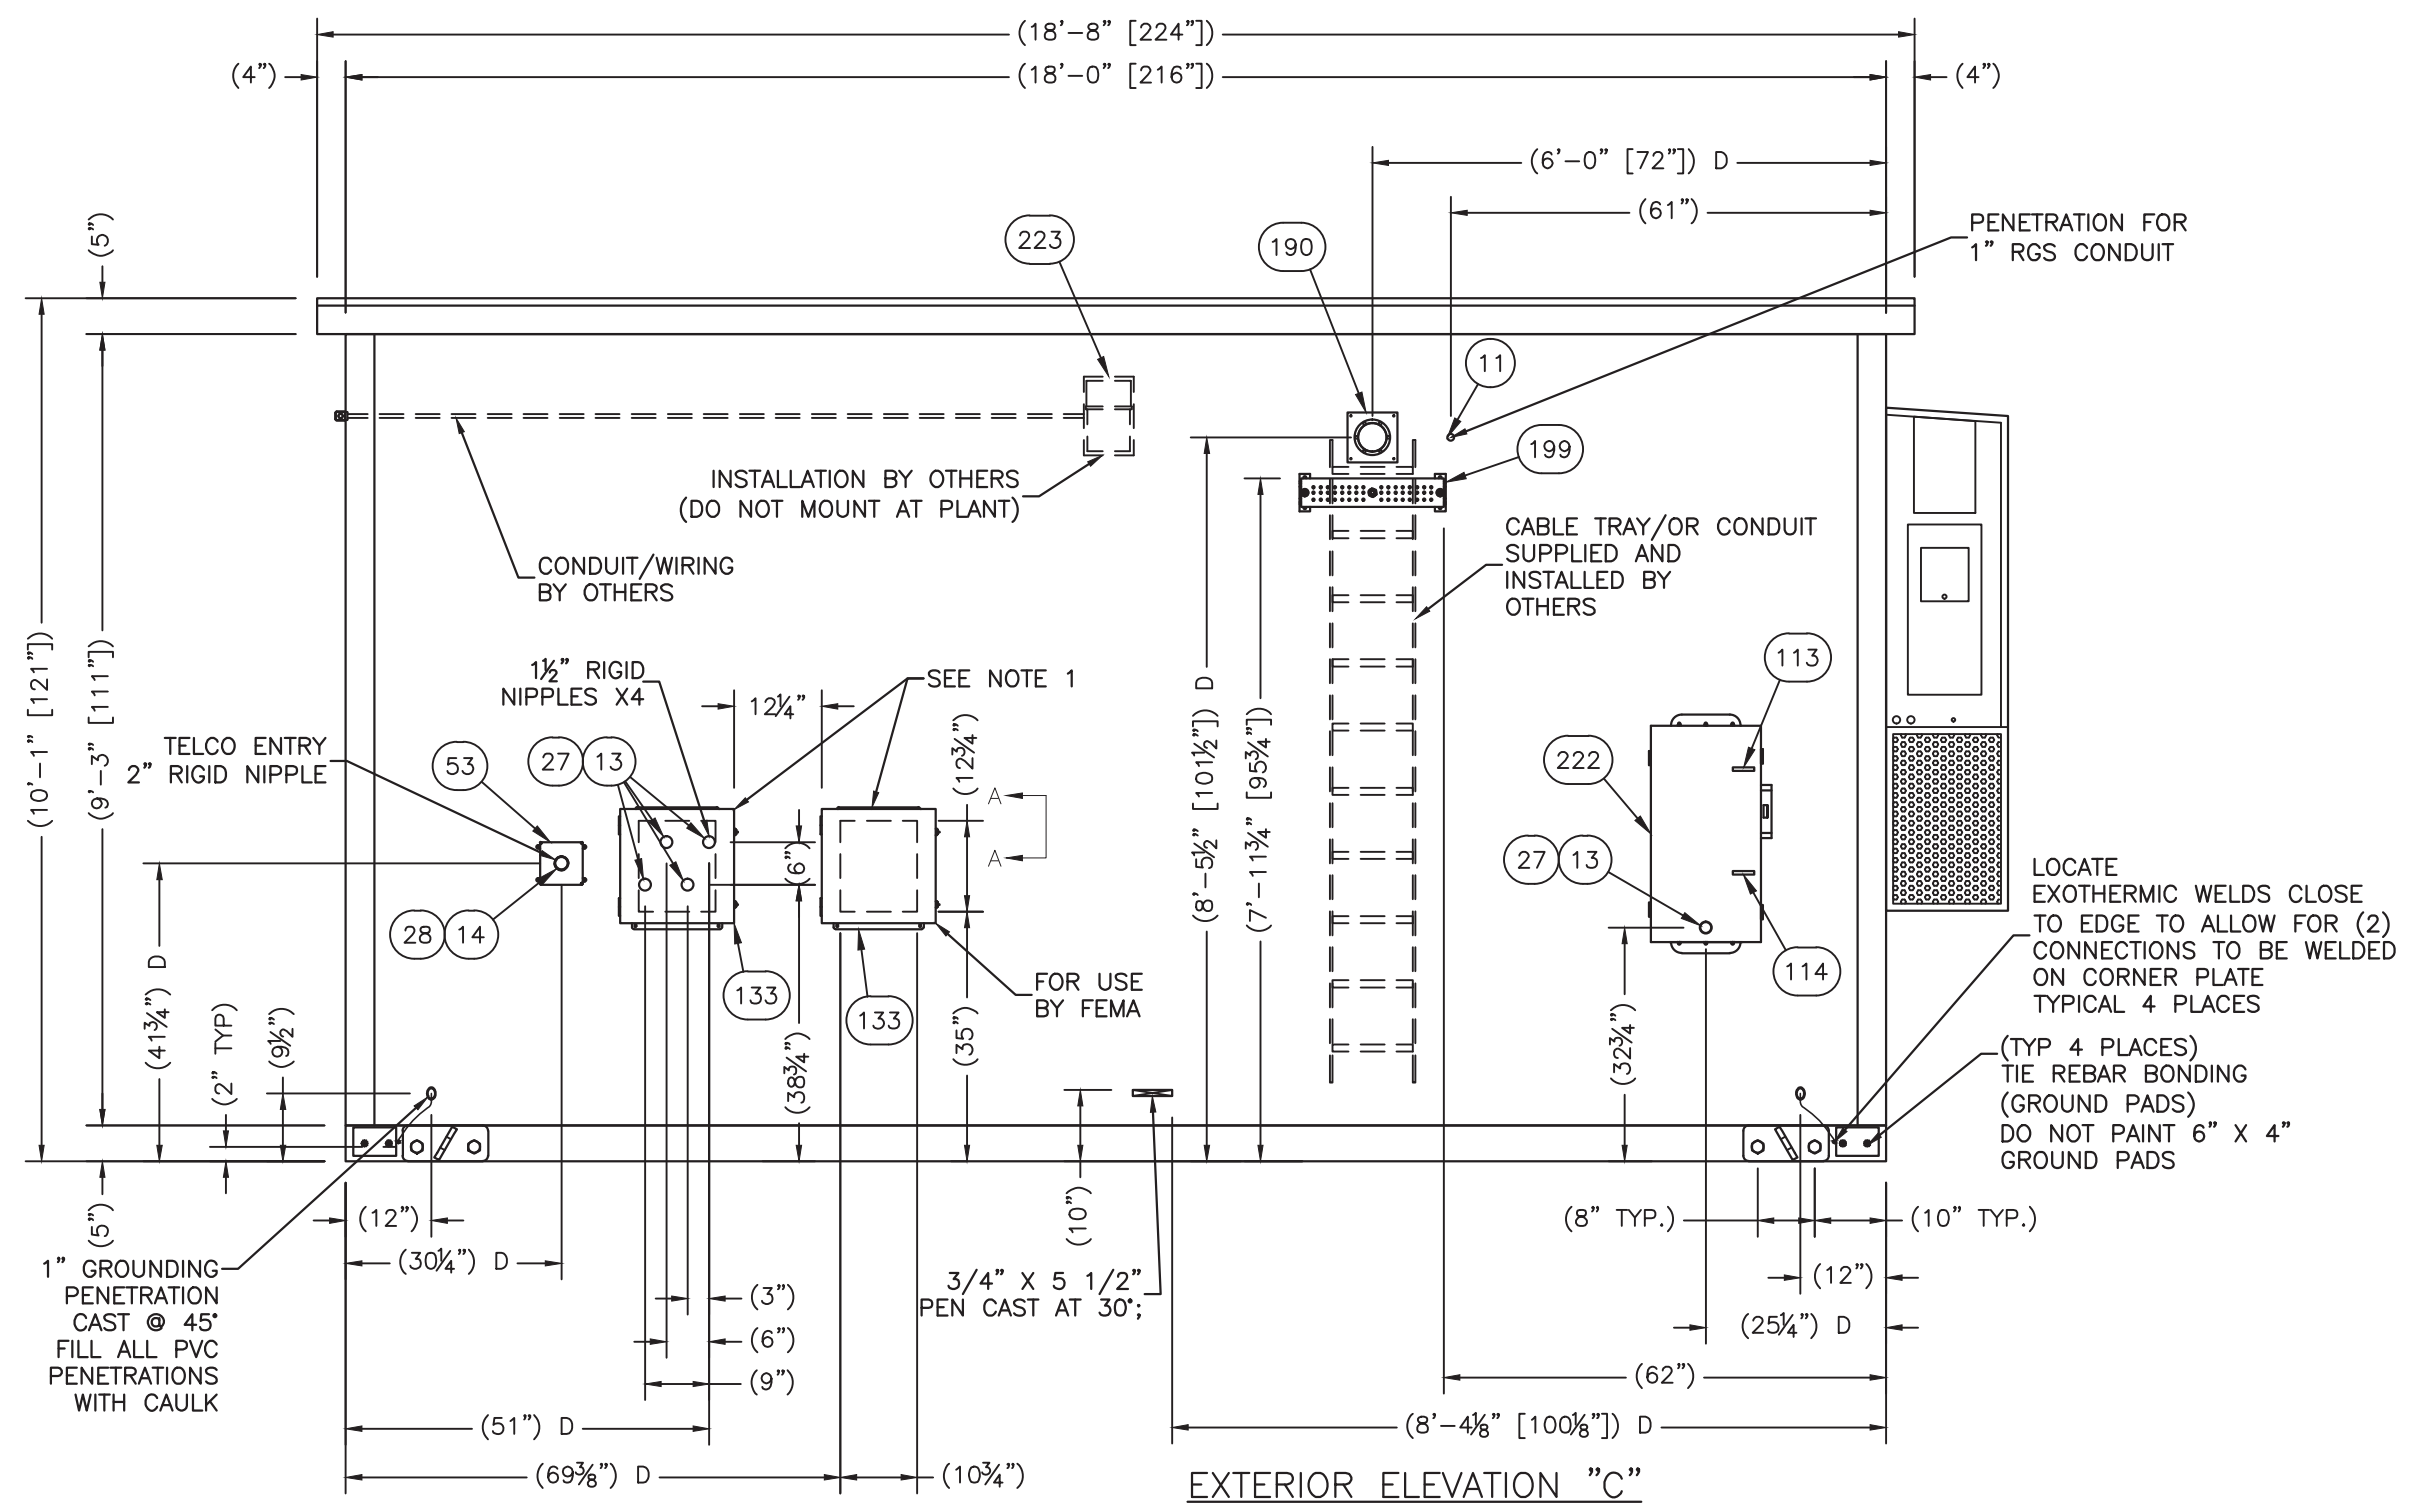


NOTE:  
 1. INSTALL BOXES (133) WITH RAIN LIPS TOP

REV	BY	DATE	DESCRIPTION	APP. BY	DATE
N	RRG	6/13/12	ADDED LABELS/CORRECTED NOTE	LJL	6/13/12
L	RRG	04/21/11	ADDED NOTES	LJL	04/21/11
K	JJ	4/7/11	HOLE LOCATION PER CUSTOMER MARKUPS	LJL	4/7/11
J	AMM	2/3/11	CHANGED TELCO NIPPLE FROM PVC TO RIGID	LJL	2/3/11
H	MST	01/21/11	PER CUSTOMER MARKUPS	WAR	01/21/11
G	MST	12/21/10	REVISED PIPE CAPS TO BE 1 1/2" (4)	WAR	12/21/10
REV	BY	DATE	DESCRIPTION	APP. BY	DATE

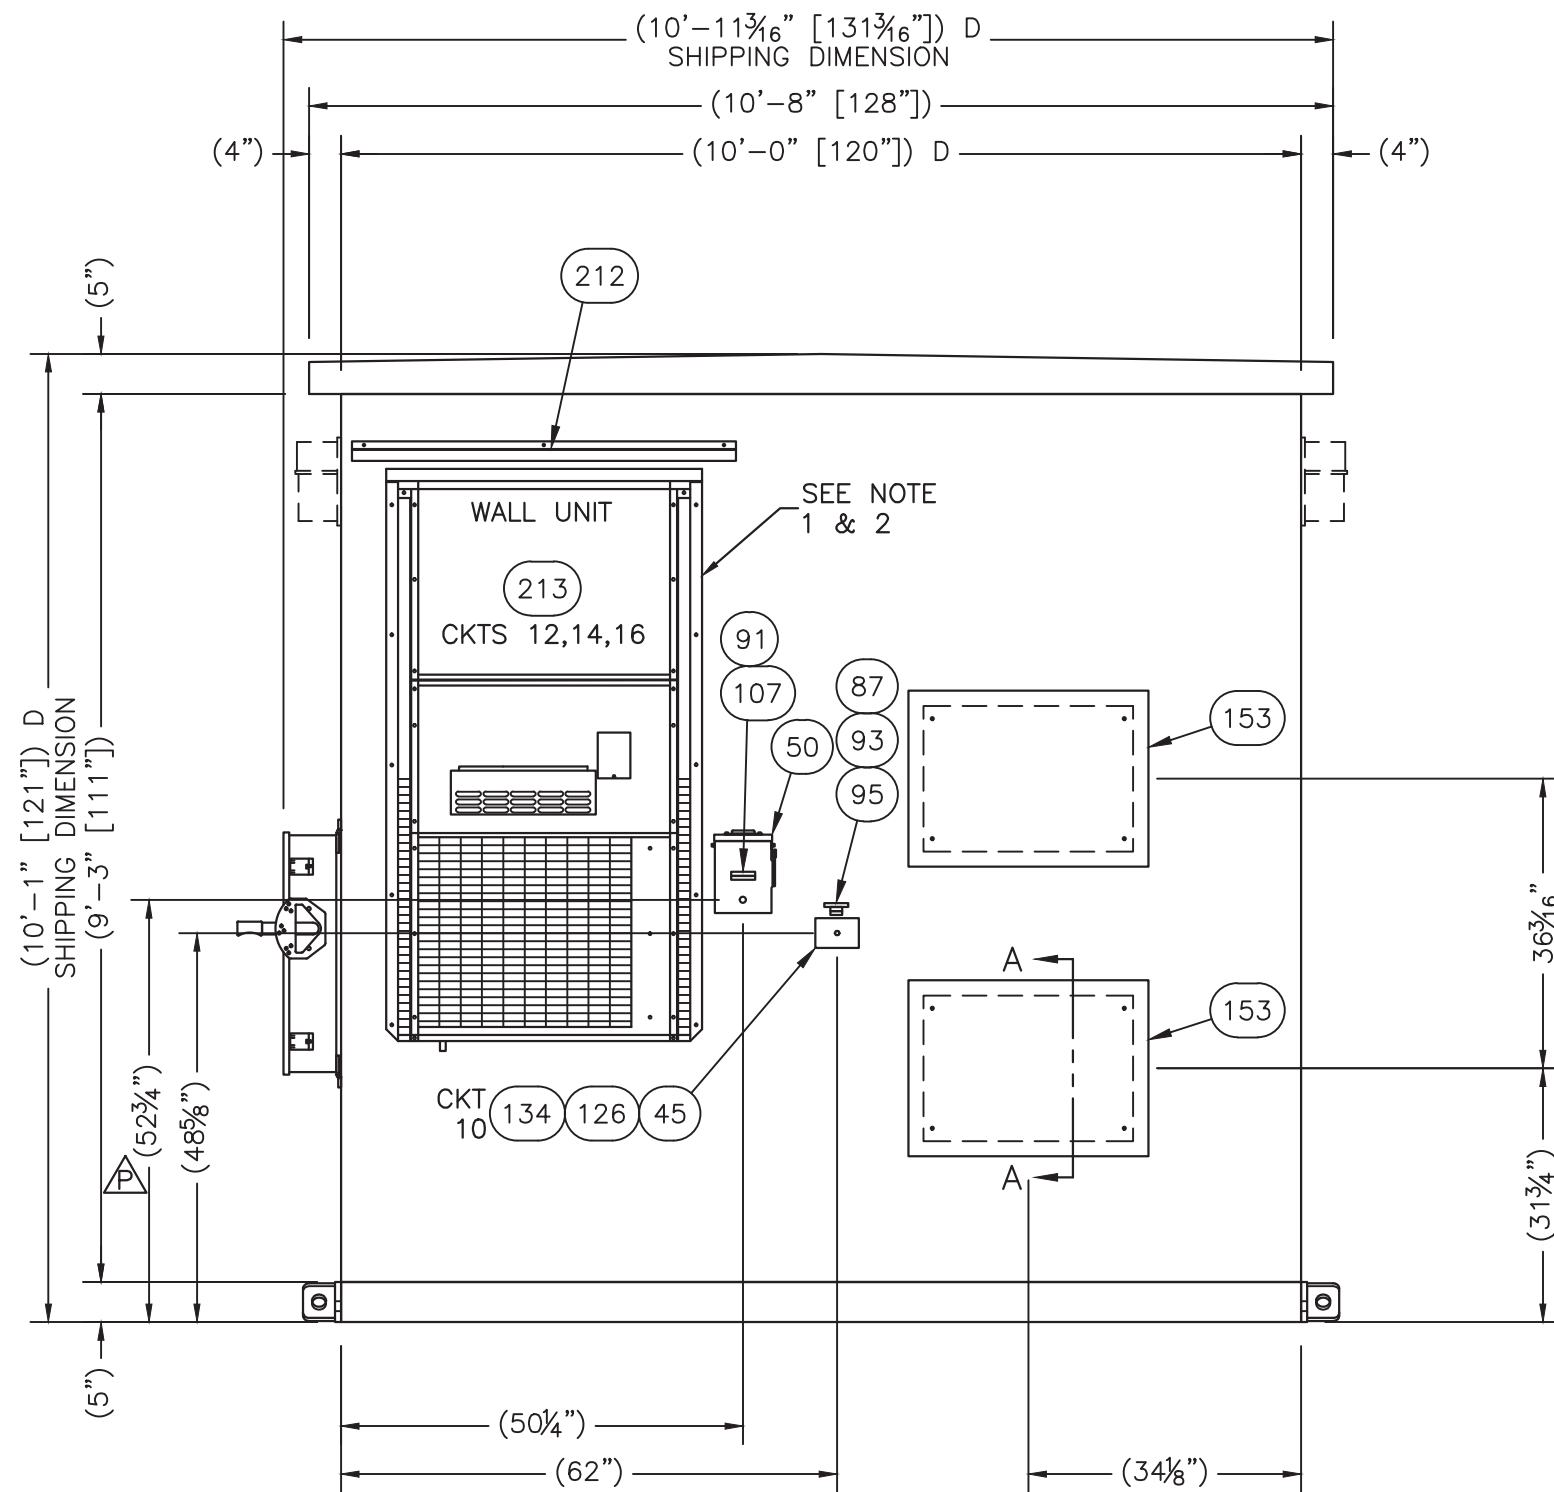


EXTERIOR ELEVATION "B"  
PRE-HEMP

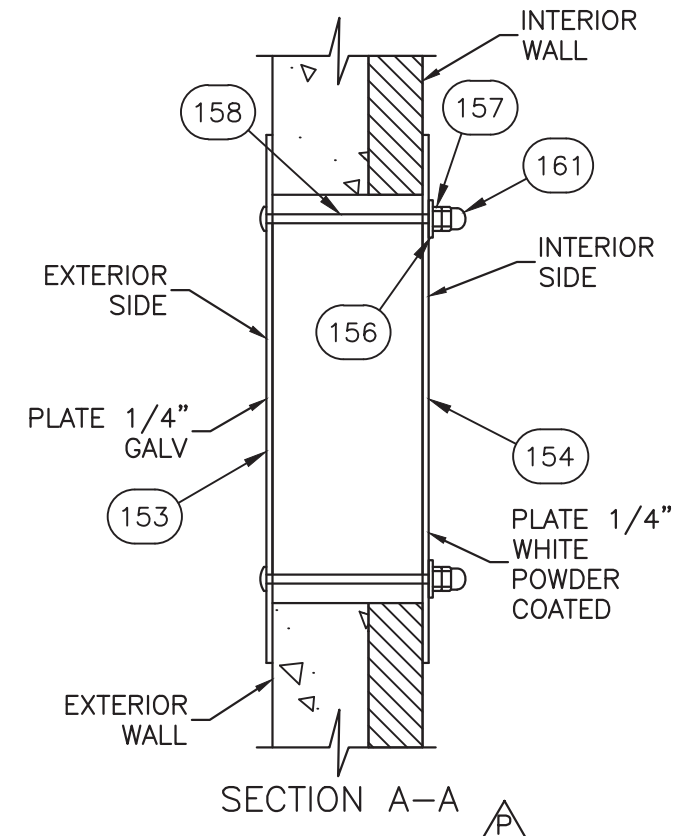

COMPLETE STEPS BEFORE  
INSTALLING COVERS:

- NOTES:**
- 1. CHECK TRANSFORMER & WIRE FOR 208VAC OPERATION PER MANUFACTURER'S INSTRUCTIONS. SET TIMER TO MAX TO REDUCE SHORT CYCLING PER MANUFACTURER'S INSTRUCTIONS.
  - 2. A/C POWER CONDUCTORS SHALL BE ROUTED SEPERATE FROM CONTROL CONDUCTORS

REV	BY	DATE	DESCRIPTION	APP. BY	DATE
P	RRG	10/31/12	MOVED HVAC DISCONNECT/CHANGED A/C FRAME/UPDATED DETAIL & NOTES	LJL	10/31/12
N	RRG	6/13/12	ADDED NOTES	LJL	6/13/12
M	JJ	11/09/11	ADDED NOTES TO SECTION A	LJL	11/09/11
L	RRG	04/21/11	ADDED NOTES TO DIMENSIONS	LJL	04/21/11
H	MST	01/21/11	PER CUSTOMER MARKUPS	WAR	01/21/11

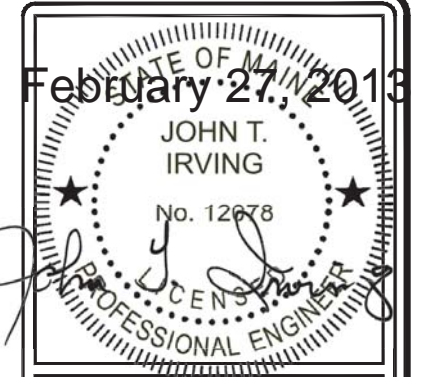

THIS DRAWING IS THE CONFIDENTIAL PROPERTY AND CONTAINS TRADE SECRETS OF CELLXION, LLC. ANY USE OF THESE DRAWINGS OR THE INFORMATION CONTAINED HEREIN FOR ANY REASON OTHER THAN AS EXPRESSLY AUTHORIZED BY SABRE INDUSTRIES, INC. IS STRICTLY PROHIBITED. THIS DRAWING HAS BEEN DISTRIBUTED WITH THE UNDERSTANDING THAT ANYONE RECEIVING OR OTHERWISE OBTAINING POSSESSION OF IT WILL BE EXPRESSLY NOTIFIED OF ITS CONFIDENTIAL NATURE.

**cellxion**  
5031 Hazel Jones Road  
Bossier City, Louisiana 71111  
voice: (318) 213-2900  
fax: (318) 213-2919  
www.cellxion.com

CUSTOMER:  
**KELLOGG  
BROWN & ROOT  
FEMA (PEP)  
EXPANSION PROGRAM**


PROJECT:  
**10'-0" X 18'-0"  
CONCRETE SHELTER  
EXTERIOR ELEVATION  
"B" PRE-HEMP**

FILENAME: KBR/SKBR02	
SCALE: 1/2"=1'-0"	TOLERANCE:
DRWN. BY: M. FOWLER	DATE: 03/24/2010
CHK. BY: V. HASSELL	DATE: 03/24/2010
ENG. BY:	DATE:
APP. BY: A. DUMAS	DATE: 03/24/2010


SHEET NO.  
1-2

DRAWING NO.:  
SKBR02


REV.:  
P

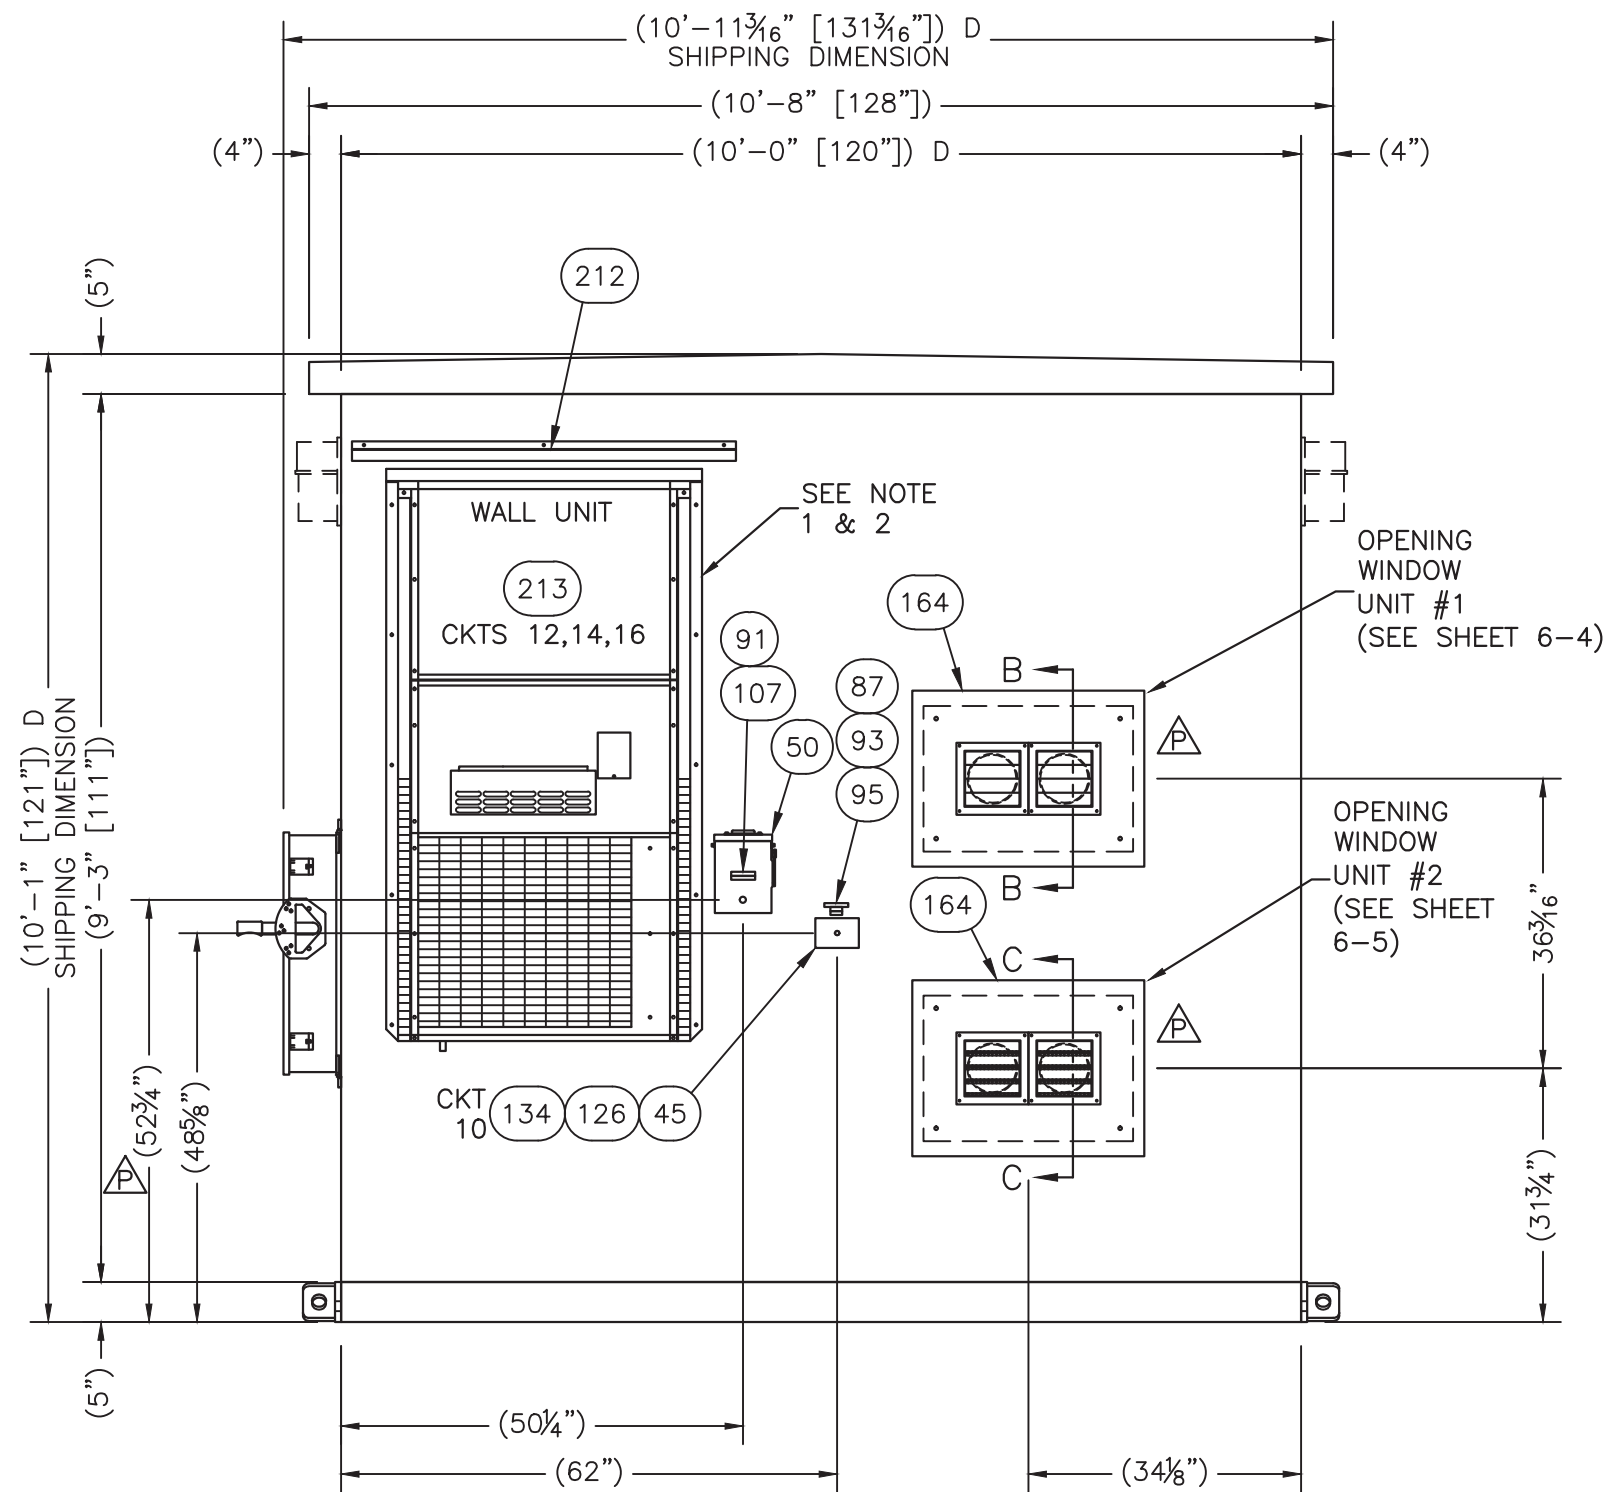

EXTERIOR ELEVATION "B"  
POST-HEMP

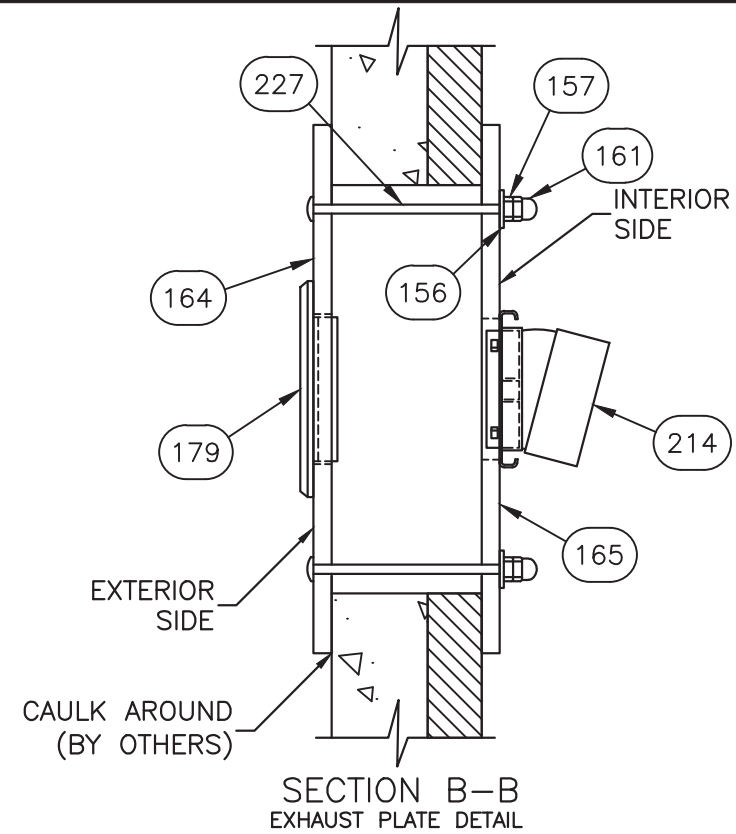


SECTION B-B  
EXHAUST PLATE DETAIL

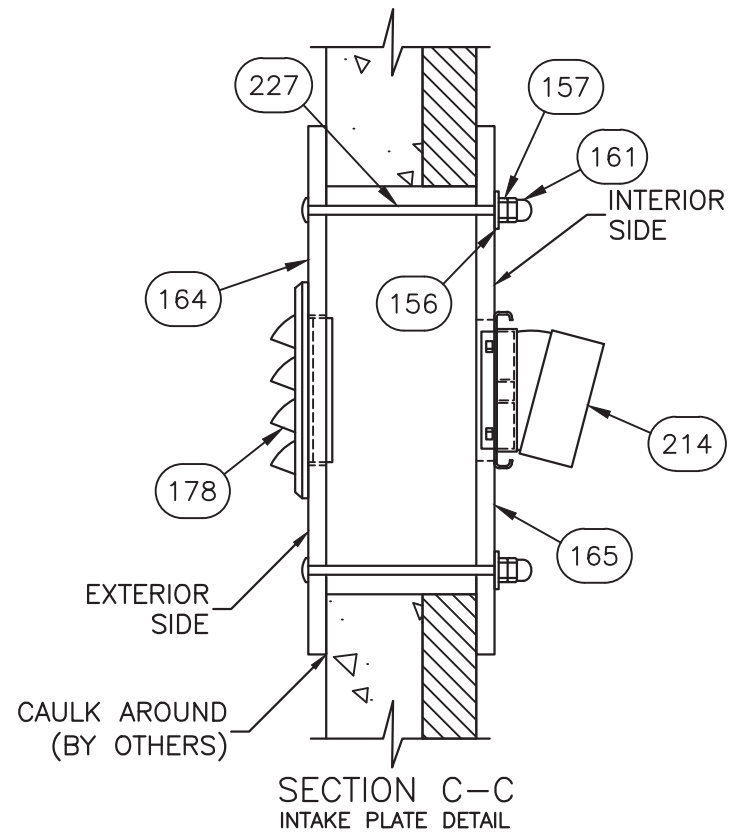

SECTION C-C  
INTAKE PLATE DETAIL

February 27, 2013

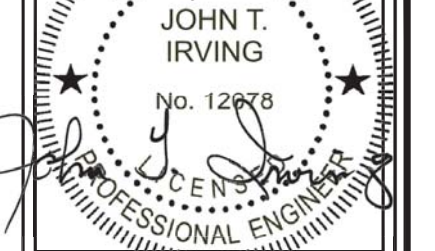

THIS DRAWING IS THE CONFIDENTIAL PROPERTY AND CONTAINS TRADE SECRETS OF CELLXION, LLC. ANY USE OF THESE DRAWINGS OR THE INFORMATION CONTAINED HEREIN FOR ANY REASON OTHER THAN AS EXPRESSLY AUTHORIZED BY SABRE INDUSTRIES, INC. IS STRICTLY PROHIBITED. THIS DRAWING HAS BEEN DISTRIBUTED WITH THE UNDERSTANDING THAT ANYONE RECEIVING OR OTHERWISE OBTAINING POSSESSION OF IT WILL BE EXPRESSLY NOTIFIED OF ITS CONFIDENTIAL NATURE.

**cellxion**  
5031 Hazel Jones Road  
Bossier City, Louisiana 71111  
voice: (318) 213-2900  
fax: (318) 213-2919  
www.cellxion.com


CUSTOMER:  
KELLOGG  
BROWN & ROOT  
FEMA (PEP)  
EXPANSION PROGRAM

PROJECT:  
10'-0" X 18'-0"  
CONCRETE SHELTER  
EXTERIOR ELEVATION  
"B" POST-HEMP

FILENAME: KBR/SKBR02	
SCALE: 1/2"=1'-0"	TOLERANCE:
DRWN. BY: M. FOWLER	DATE: 03/24/2010
CHK. BY: V. HASSELL	DATE: 03/24/2010
ENG. BY:	DATE:
APP. BY: A. DUMAS	DATE: 03/24/2010
SHEET NO. 1-2A	
DRAWING NO.: SKBR02	REV.: P


P	RRG	10/31/12	NEW SHEET ADDED	LJL	10/31/12
REV	BY	DATE	DESCRIPTION	APP. BY	DATE



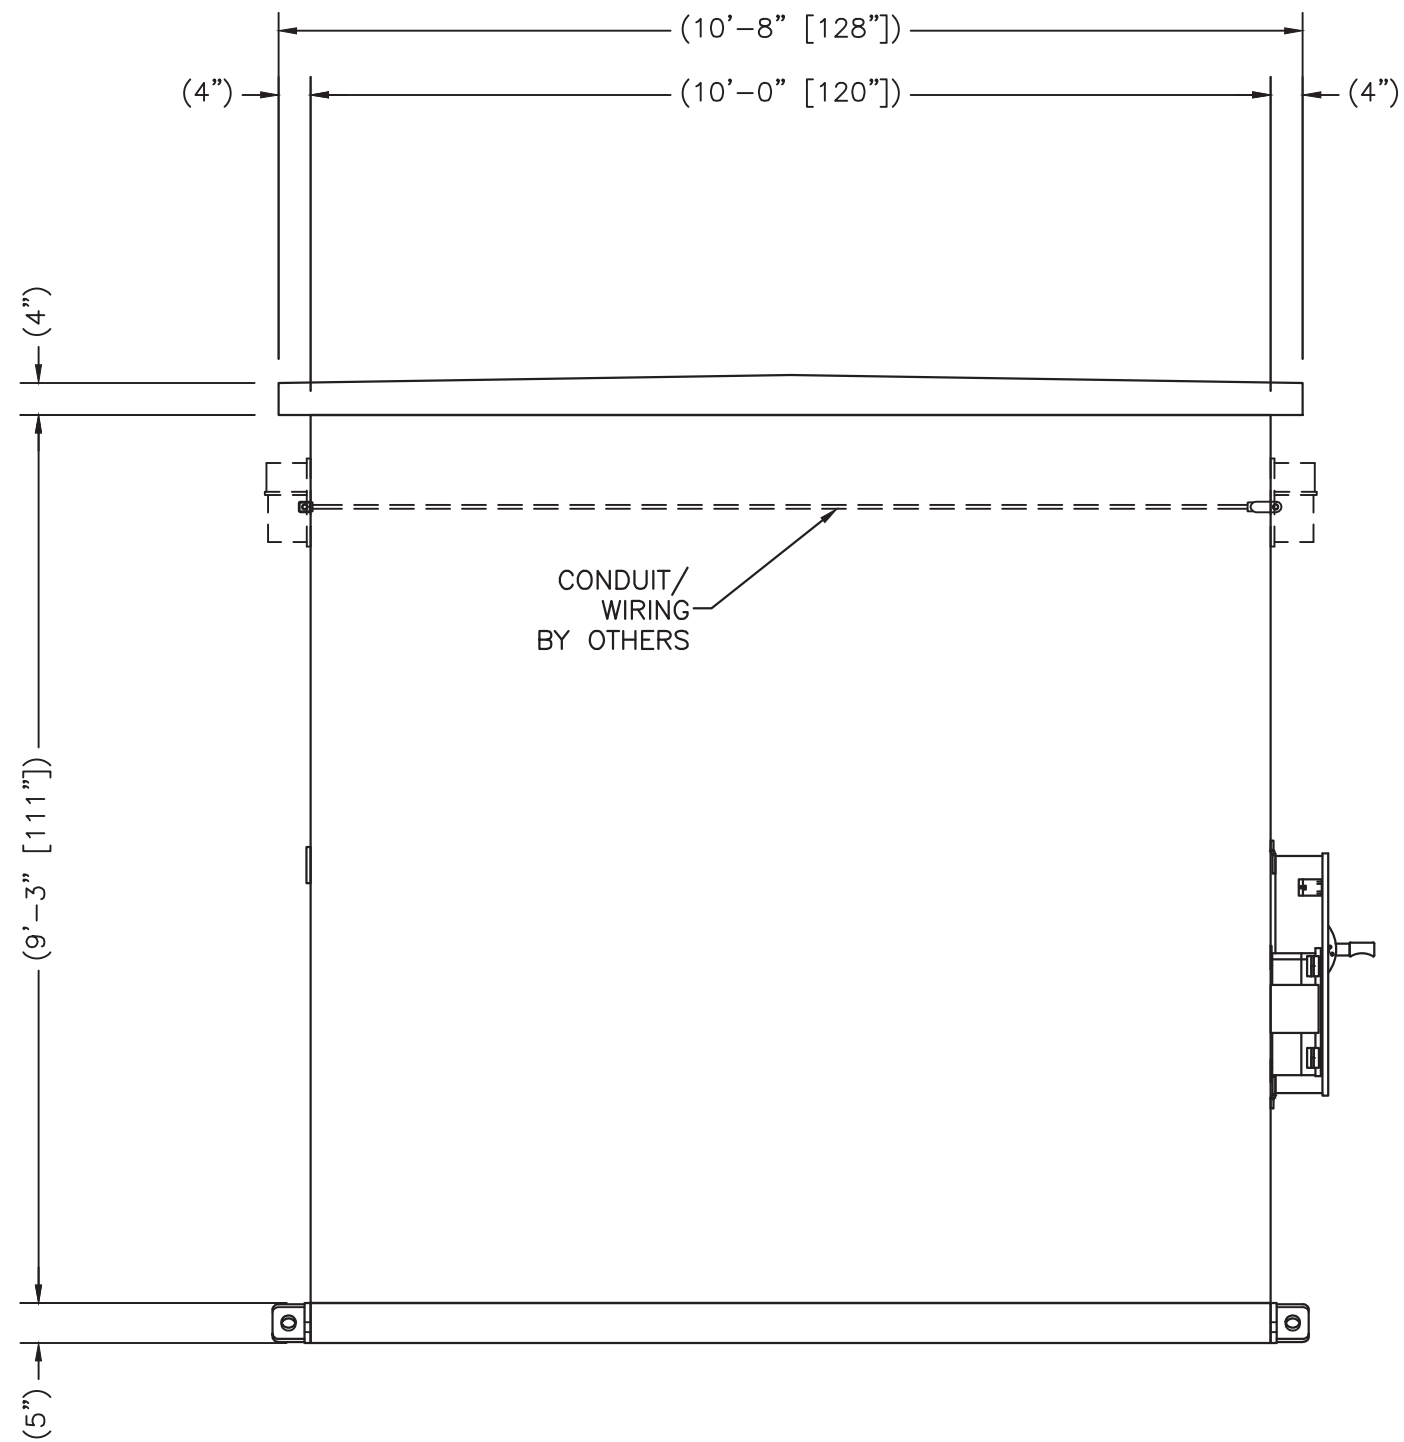

EXTERIOR ELEVATION "D"

February 27, 2013

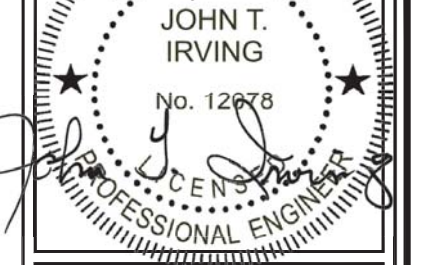

THIS DRAWING IS THE CONFIDENTIAL PROPERTY AND CONTAINS TRADE SECRETS OF CELLXION, LLC. ANY USE OF THESE DRAWINGS OR THE INFORMATION CONTAINED HEREIN FOR ANY REASON OTHER THAN AS EXPRESSLY AUTHORIZED BY SABRE INDUSTRIES, INC. IS STRICTLY PROHIBITED. THIS DRAWING HAS BEEN DISTRIBUTED WITH THE UNDERSTANDING THAT ANYONE RECEIVING OR OTHERWISE OBTAINING POSSESSION OF IT WILL BE EXPRESSLY NOTIFIED OF ITS CONFIDENTIAL NATURE.

**cellxion**  
 5031 Hazel Jones Road  
 Bossier City, Louisiana 71111  
 voice: (318) 213-2900  
 fax: (318) 213-2919  
 www.cellxion.com


CUSTOMER:  
**KELLOGG  
 BROWN & ROOT  
 FEMA (PEP)  
 EXPANSION PROGRAM**

PROJECT:  
**10'-0" X 18'-0"  
 CONCRETE SHELTER  
 EXTERIOR "D"**

FILENAME: KBR/SKBR02	
SCALE: 1/2"=1'-0"	TOLERANCE:
DRWN. BY: M. FOWLER	DATE: 03/24/2010
CHK. BY: V. HASSELL	DATE: 03/24/2010
ENG. BY:	DATE:
APP. BY: A. DUMAS	DATE: 03/24/2010
SHEET NO. 1-3	
DRAWING NO.: SKBR02	REV.: P

REV	BY	DATE	DESCRIPTION	APP. BY	DATE
L	RRG	04/21/11	ADDED MISSING PROFILES	LJL	04/21/11
H	MST	01/21/11	PER CUSTOMER MARKUPS	WAR	01/21/11
G	MST	12/21/10	DASHED EXTERIOR LIGHTS TO MATCH VIEWS	WAR	12/21/10



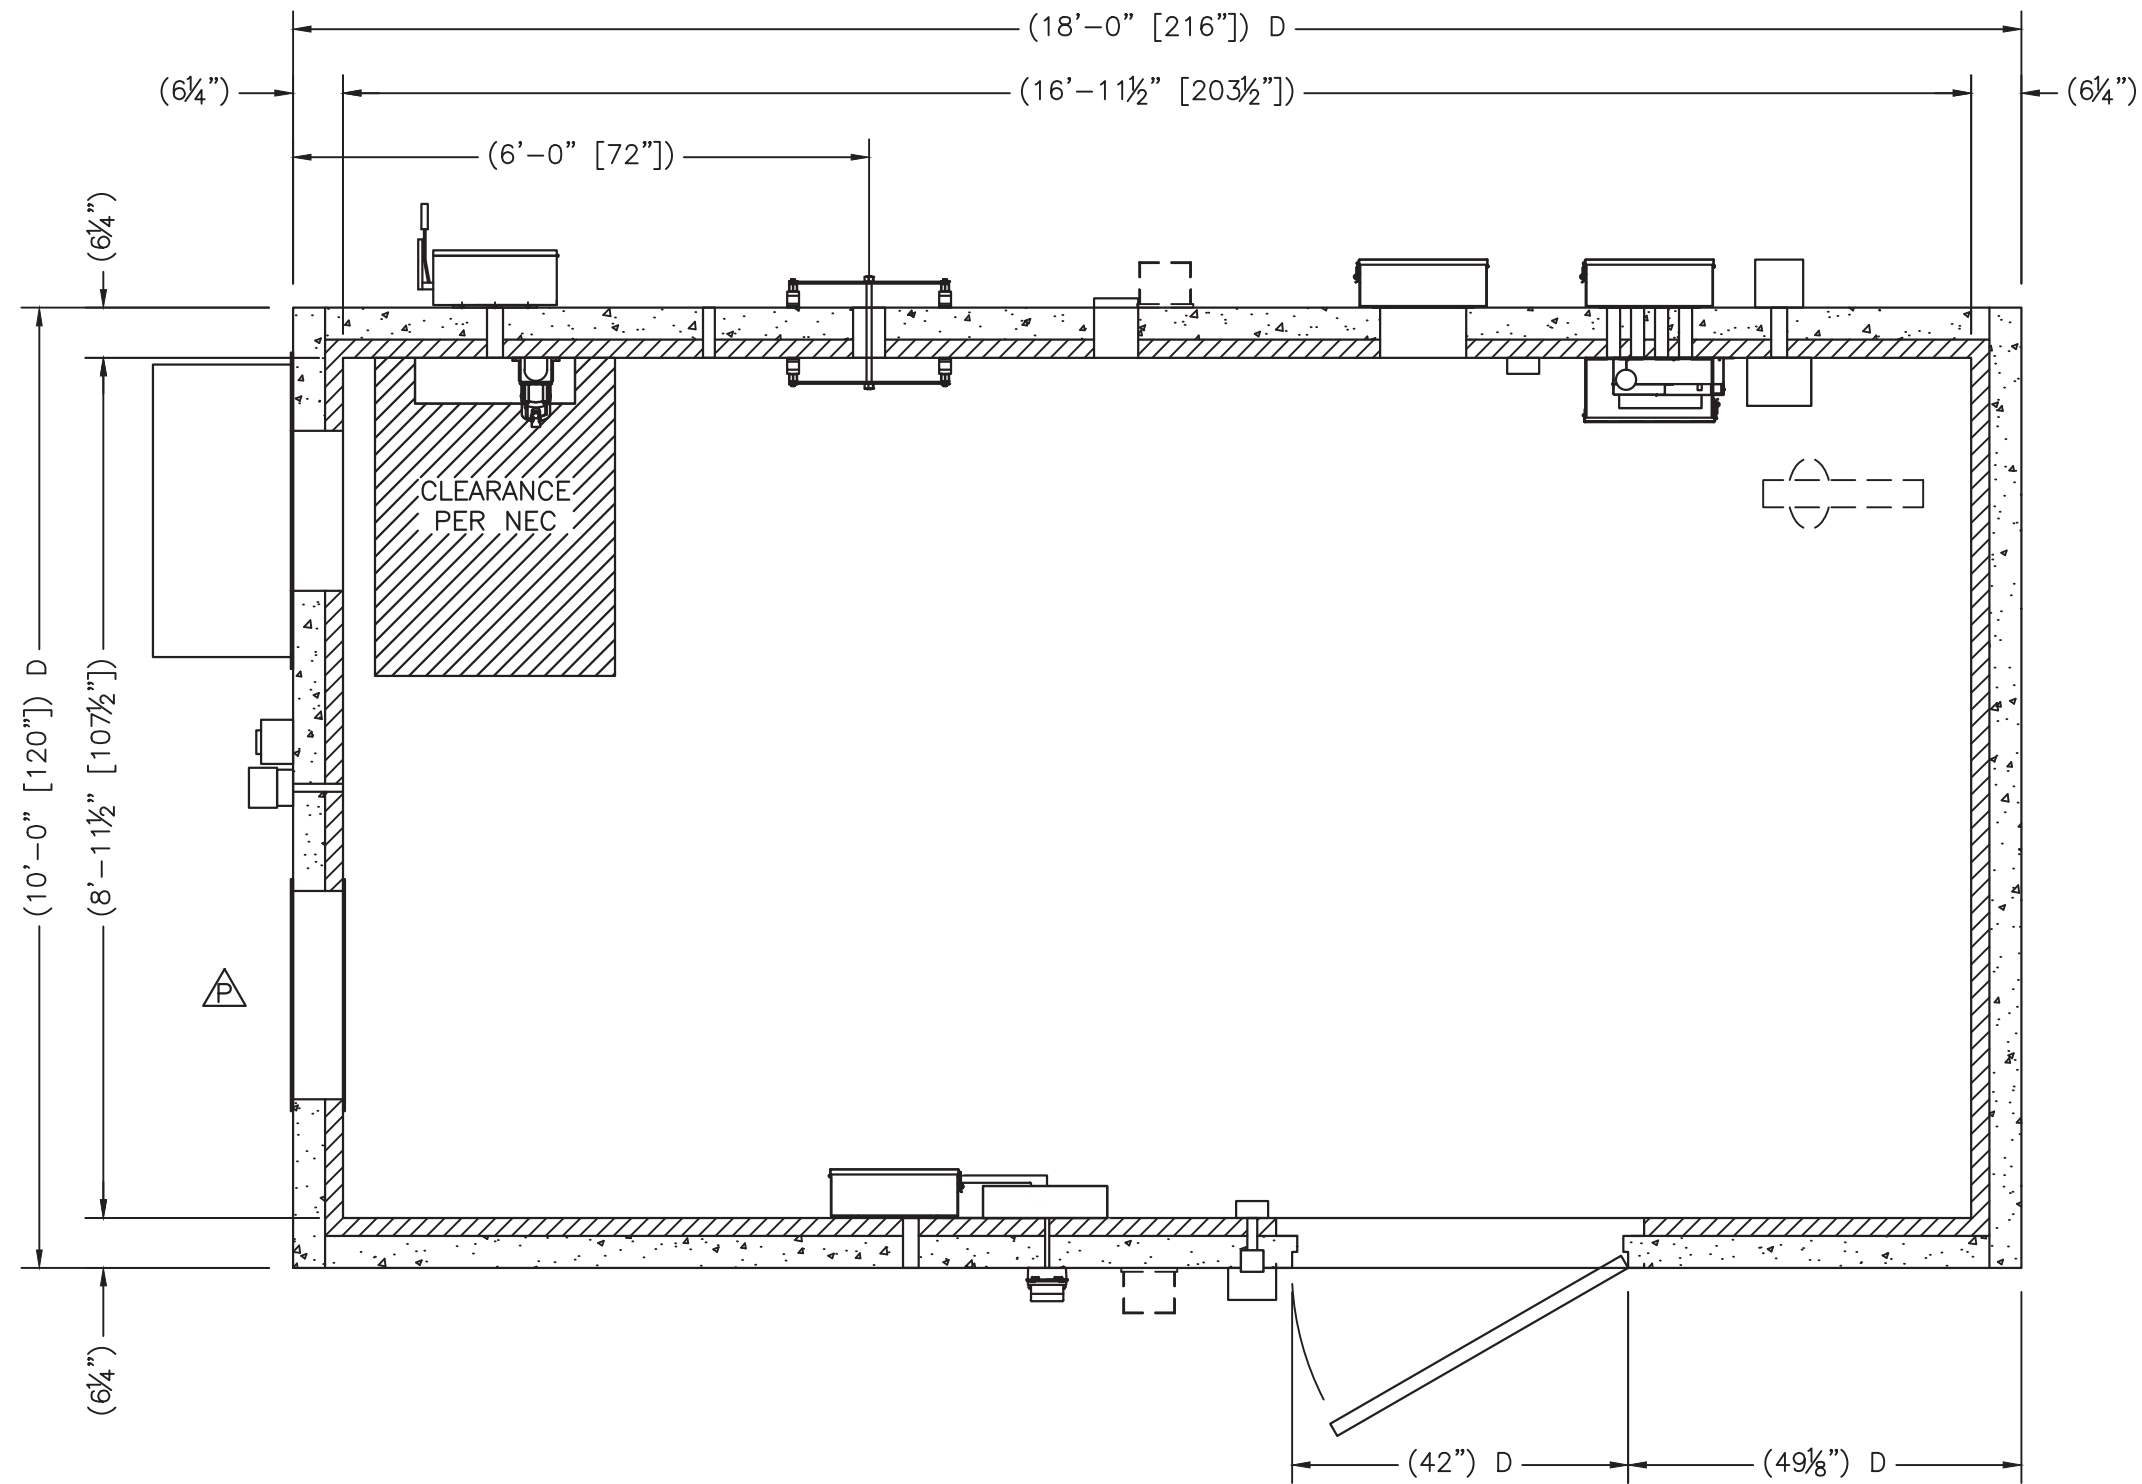

STATE OF MISSISSIPPI  
 February 27, 2013  
 JOHN T. IRVING  
 No. 12678  
 PROFESSIONAL ENGINEER

THIS DRAWING IS THE CONFIDENTIAL PROPERTY AND CONTAINS TRADE SECRETS OF CELLXION, LLC. ANY USE OF THESE DRAWINGS OR THE INFORMATION CONTAINED HEREIN FOR ANY REASON OTHER THAN AS EXPRESSLY AUTHORIZED BY SABRE INDUSTRIES, INC. IS STRICTLY PROHIBITED. THIS DRAWING HAS BEEN DISTRIBUTED WITH THE UNDERSTANDING THAT ANYONE RECEIVING OR OTHERWISE OBTAINING POSSESSION OF IT WILL BE EXPRESSLY NOTIFIED OF ITS CONFIDENTIAL NATURE.

**cellxion**  
 5031 Hazel Jones Road  
 Bossier City, Louisiana 71111  
 voice: (318) 213-2900  
 fax: (318) 213-2919  
 www.cellxion.com

CUSTOMER:  
**KELLOGG  
 BROWN & ROOT  
 FEMA (PEP)  
 EXPANSION PROGRAM**

PROJECT:  
**10'-0" X 18'-0"  
 CONCRETE SHELTER  
 FLOOR PLAN**


FILENAME: KBR/SKBR02	
SCALE: 1/2"=1'-0"	TOLERANCE:
DRWN. BY: M. FOWLER	DATE: 03/24/2010
CHK. BY: V. HASSELL	DATE: 03/24/2010
ENG. BY:	DATE:
APP. BY: A. DUMAS	DATE: 03/24/2010
SHEET NO. 2-0	
DRAWING NO.:	REV.:
SKBR02	P

NOTES:  
 1. FLOORING PROTECTIVE COVERING TO BE IN PLACE DURING INSTALL ACTIVITIES. TO BE REMOVED BY KBR FIELD PERSONEL

**FLOOR PLAN**  
 180.00 SQ. FT. EXTERIOR AREA  
 151.92 SQ. FT. INTERIOR AREA

REV	BY	DATE	DESCRIPTION	APP. BY	DATE
P	RRG	10/31/12	UPDATED HVAC BLOCKOUT	LJL	10/31/12
N	RRG	6/13/12	CORRECTED OVERLAYS & ADDED UPS	LJL	6/13/12
M	JJ	11/09/11	CHANGE VIEW OF INCON BOXES	LJL	11/09/11
L	RRG	04/21/11	ADDED NOTES TO DIMENSIONS	LJL	04/21/11
K	JJ	4/7/11	PER CUSTOMER MARKUPS	LJL	4/7/11

February 27, 2013

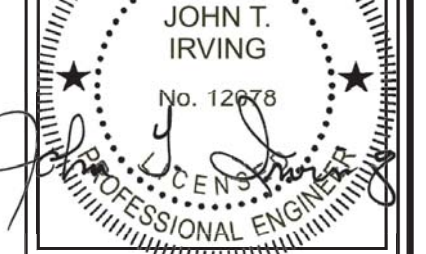


THIS DRAWING IS THE CONFIDENTIAL PROPERTY AND CONTAINS TRADE SECRETS OF CELLXION, LLC. ANY USE OF THESE DRAWINGS OR THE INFORMATION CONTAINED HEREIN FOR ANY REASON OTHER THAN AS EXPRESSLY AUTHORIZED BY SABRE INDUSTRIES, INC. IS STRICTLY PROHIBITED. THIS DRAWING HAS BEEN DISTRIBUTED WITH THE UNDERSTANDING THAT ANYONE RECEIVING OR OTHERWISE OBTAINING POSSESSION OF IT WILL BE EXPRESSLY NOTIFIED OF ITS CONFIDENTIAL NATURE.

**cellxion**  
 5031 Hazel Jones Road  
 Bossier City, Louisiana 71111  
 voice: (318) 213-2900  
 fax: (318) 213-2919  
 www.cellxion.com

CUSTOMER:  
**KELLOGG  
 BROWN & ROOT  
 FEMA (PEP)  
 EXPANSION PROGRAM**

PROJECT:  
**10'-0" X 18'-0"  
 CONCRETE SHELTER  
 EQUIPMENT LAYOUT**

FILENAME: KBR/SKBRO2	
SCALE:	TOLERANCE:
DRWN. BY: M. FOWLER	DATE: 03/24/2010
CHK. BY: V. HASSELL	DATE: 03/24/2010
ENG. BY:	DATE:
APP. BY: A. DUMAS	DATE: 03/24/2010
SHEET NO. 2-1	
DRAWING NO.:	REV.:
SKBR02	P

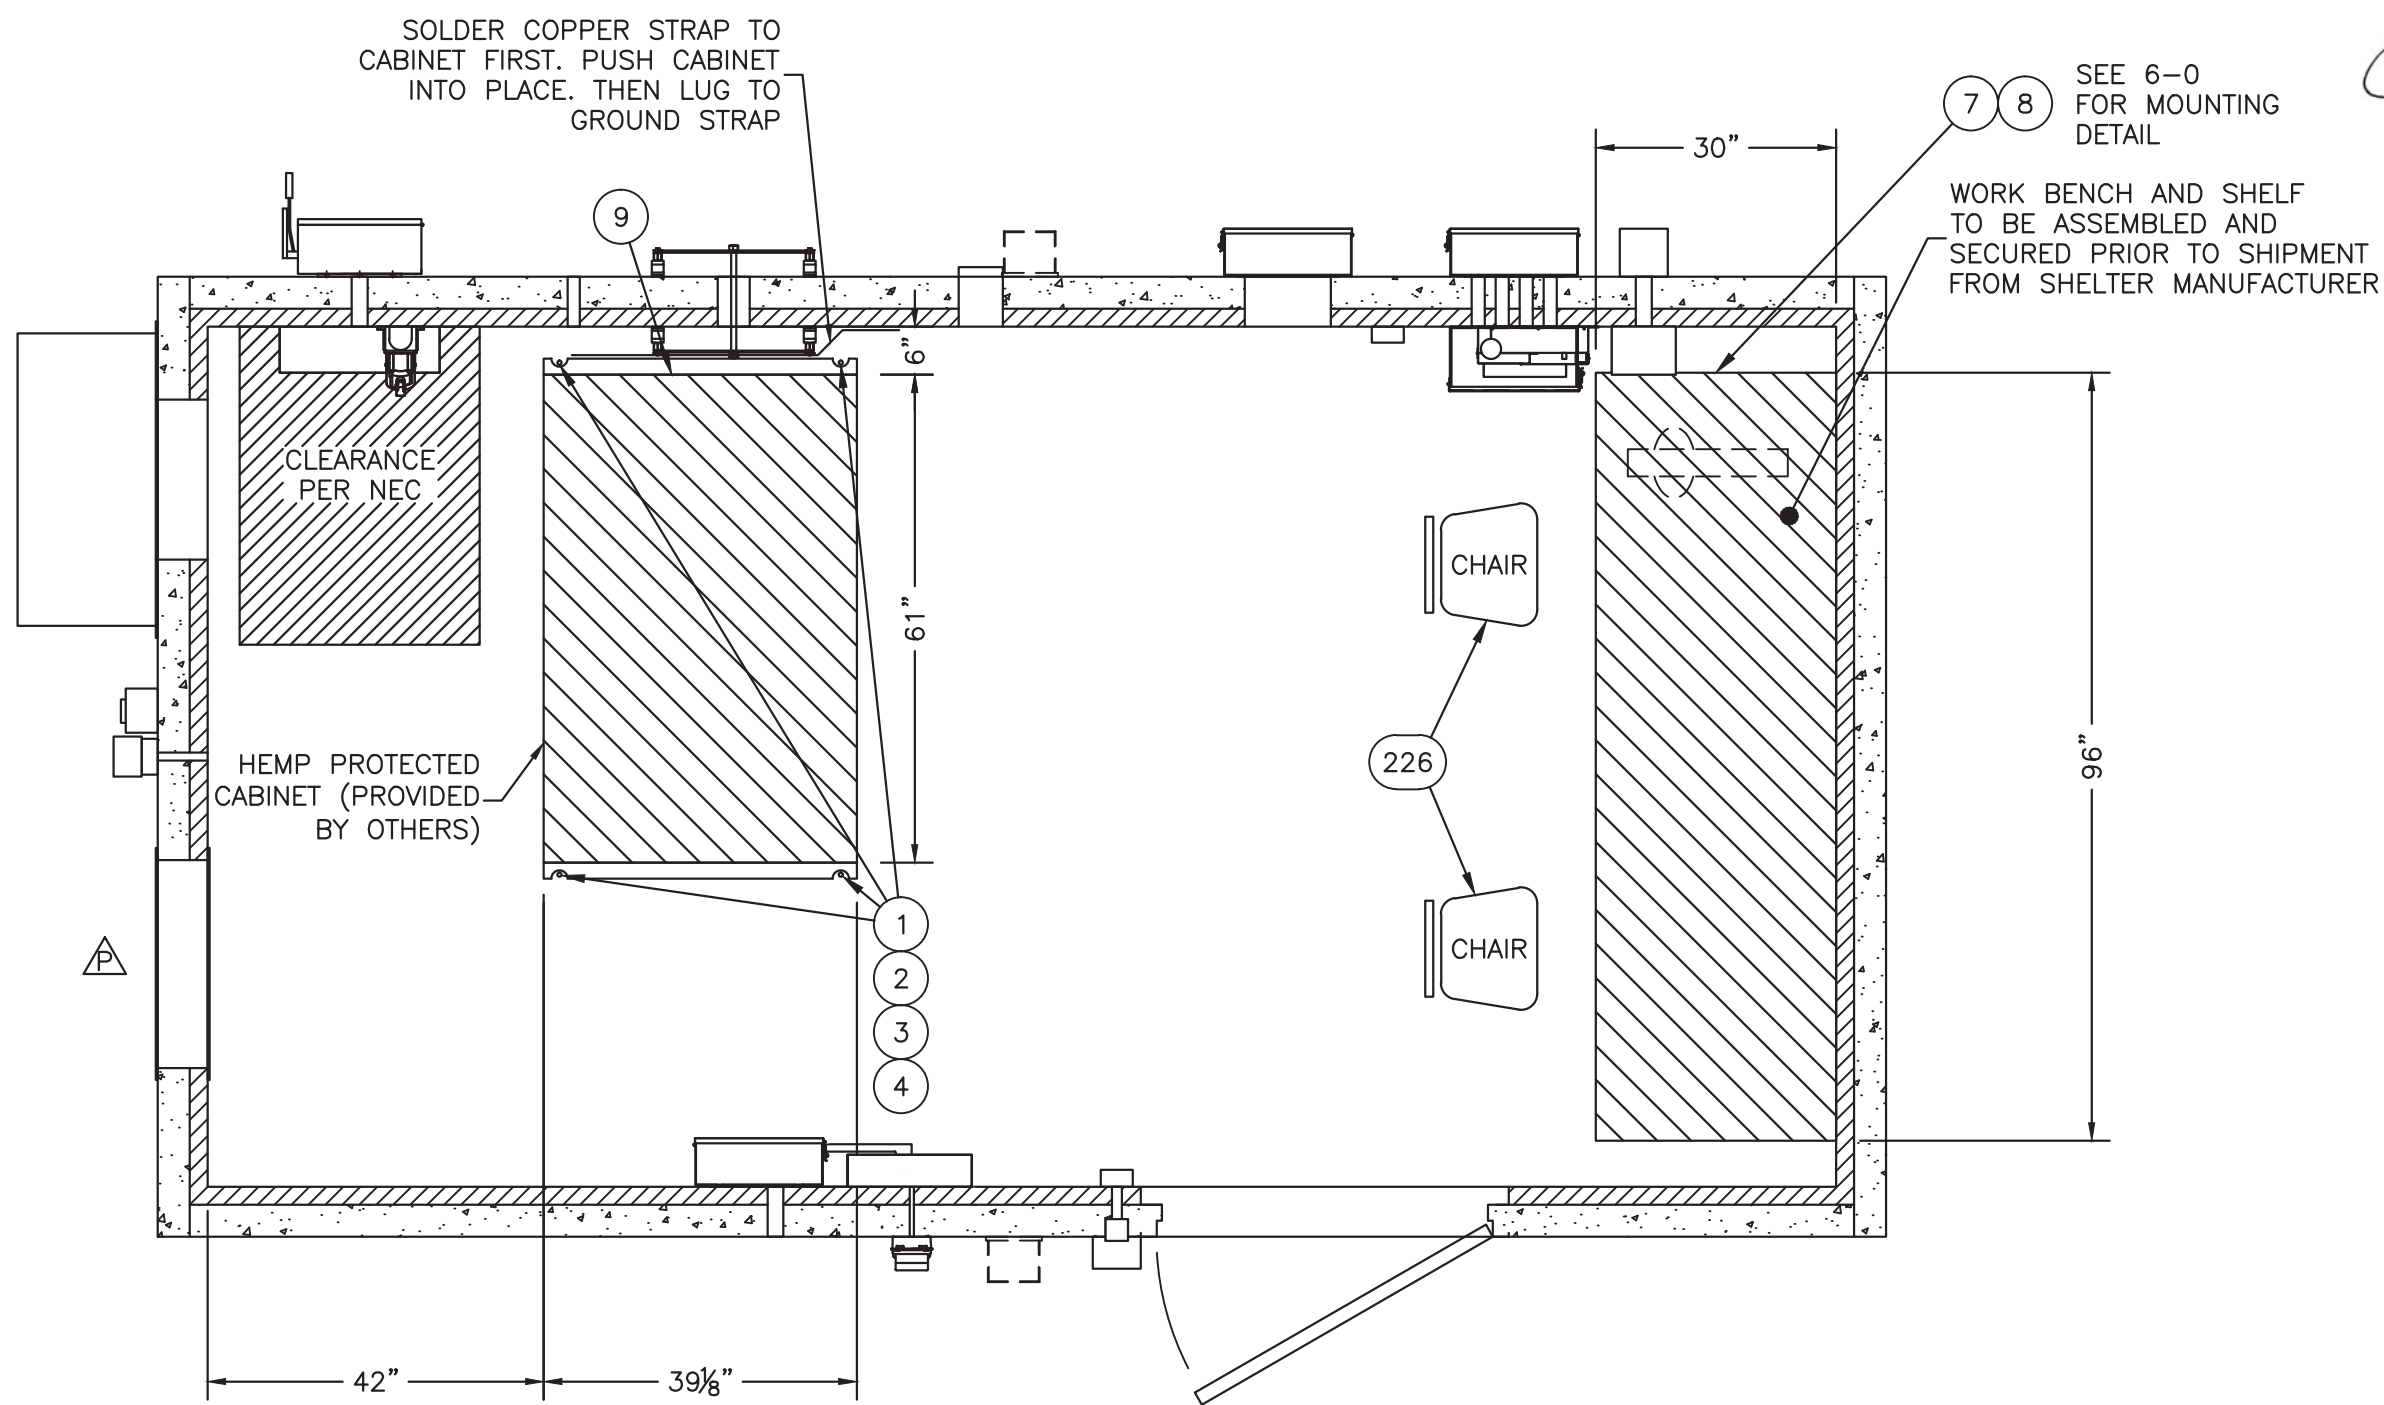

EQUIPMENT LAYOUT

REV	BY	DATE	DESCRIPTION	APP. BY	DATE
P	RRG	10/31/12	UPDATED HVAC BLOCKOUT	LJL	10/31/12
N	RRG	6/13/12	UPDATED DIMENSIONS OF HEMP CABINET & ADDED UPS	LJL	6/13/12
L	RRG	04/21/11	ADDED NOTE	LJL	04/21/11
H	MST	01/21/11	PER CUSTOMER MARKUPS	WAR	01/21/11
G	MST	12/21/10	PER CUSTOMER MARKUPS	WAR	12/21/10
F	MST	12/17/10	PER CUSTOMER MARKUPS	WAR	12/17/10

STATE OF MISSISSIPPI  
 February 27, 2013  
 JOHN T. IRVING  
 No. 12678  
 PROFESSIONAL ENGINEER


THIS DRAWING IS THE CONFIDENTIAL PROPERTY AND CONTAINS TRADE SECRETS OF CELLXION, LLC. ANY USE OF THESE DRAWINGS OR THE INFORMATION CONTAINED HEREIN FOR ANY REASON OTHER THAN AS EXPRESSLY AUTHORIZED BY SABRE INDUSTRIES, INC. IS STRICTLY PROHIBITED. THIS DRAWING HAS BEEN DISTRIBUTED WITH THE UNDERSTANDING THAT ANYONE RECEIVING OR OTHERWISE OBTAINING POSSESSION OF IT WILL BE EXPRESSLY NOTIFIED OF ITS CONFIDENTIAL NATURE.

**cellxion**  
 5031 Hazel Jones Road  
 Bossier City, Louisiana 71111  
 voice: (318) 213-2900  
 fax: (318) 213-2919  
 www.cellxion.com

CUSTOMER:  
**KELLOGG  
 BROWN & ROOT  
 FEMA (PEP)  
 EXPANSION PROGRAM**

PROJECT:  
**10'-0" X 18'-0"  
 CONCRETE SHELTER  
 REFLECTED CEILING  
 VIEW - ELECTRICAL**

FILENAME: KBR/SKBRO2	
SCALE: 1/2"=1'-0"	TOLERANCE:
DRWN. BY: M. FOWLER	DATE: 03/24/2010
CHK. BY: V. HASSELL	DATE: 03/24/2010
ENG. BY:	DATE:
APP. BY: A. DUMAS	DATE: 03/24/2010
SHEET NO. 3-0	
DRAWING NO.:	REV.:
SKBR02	P

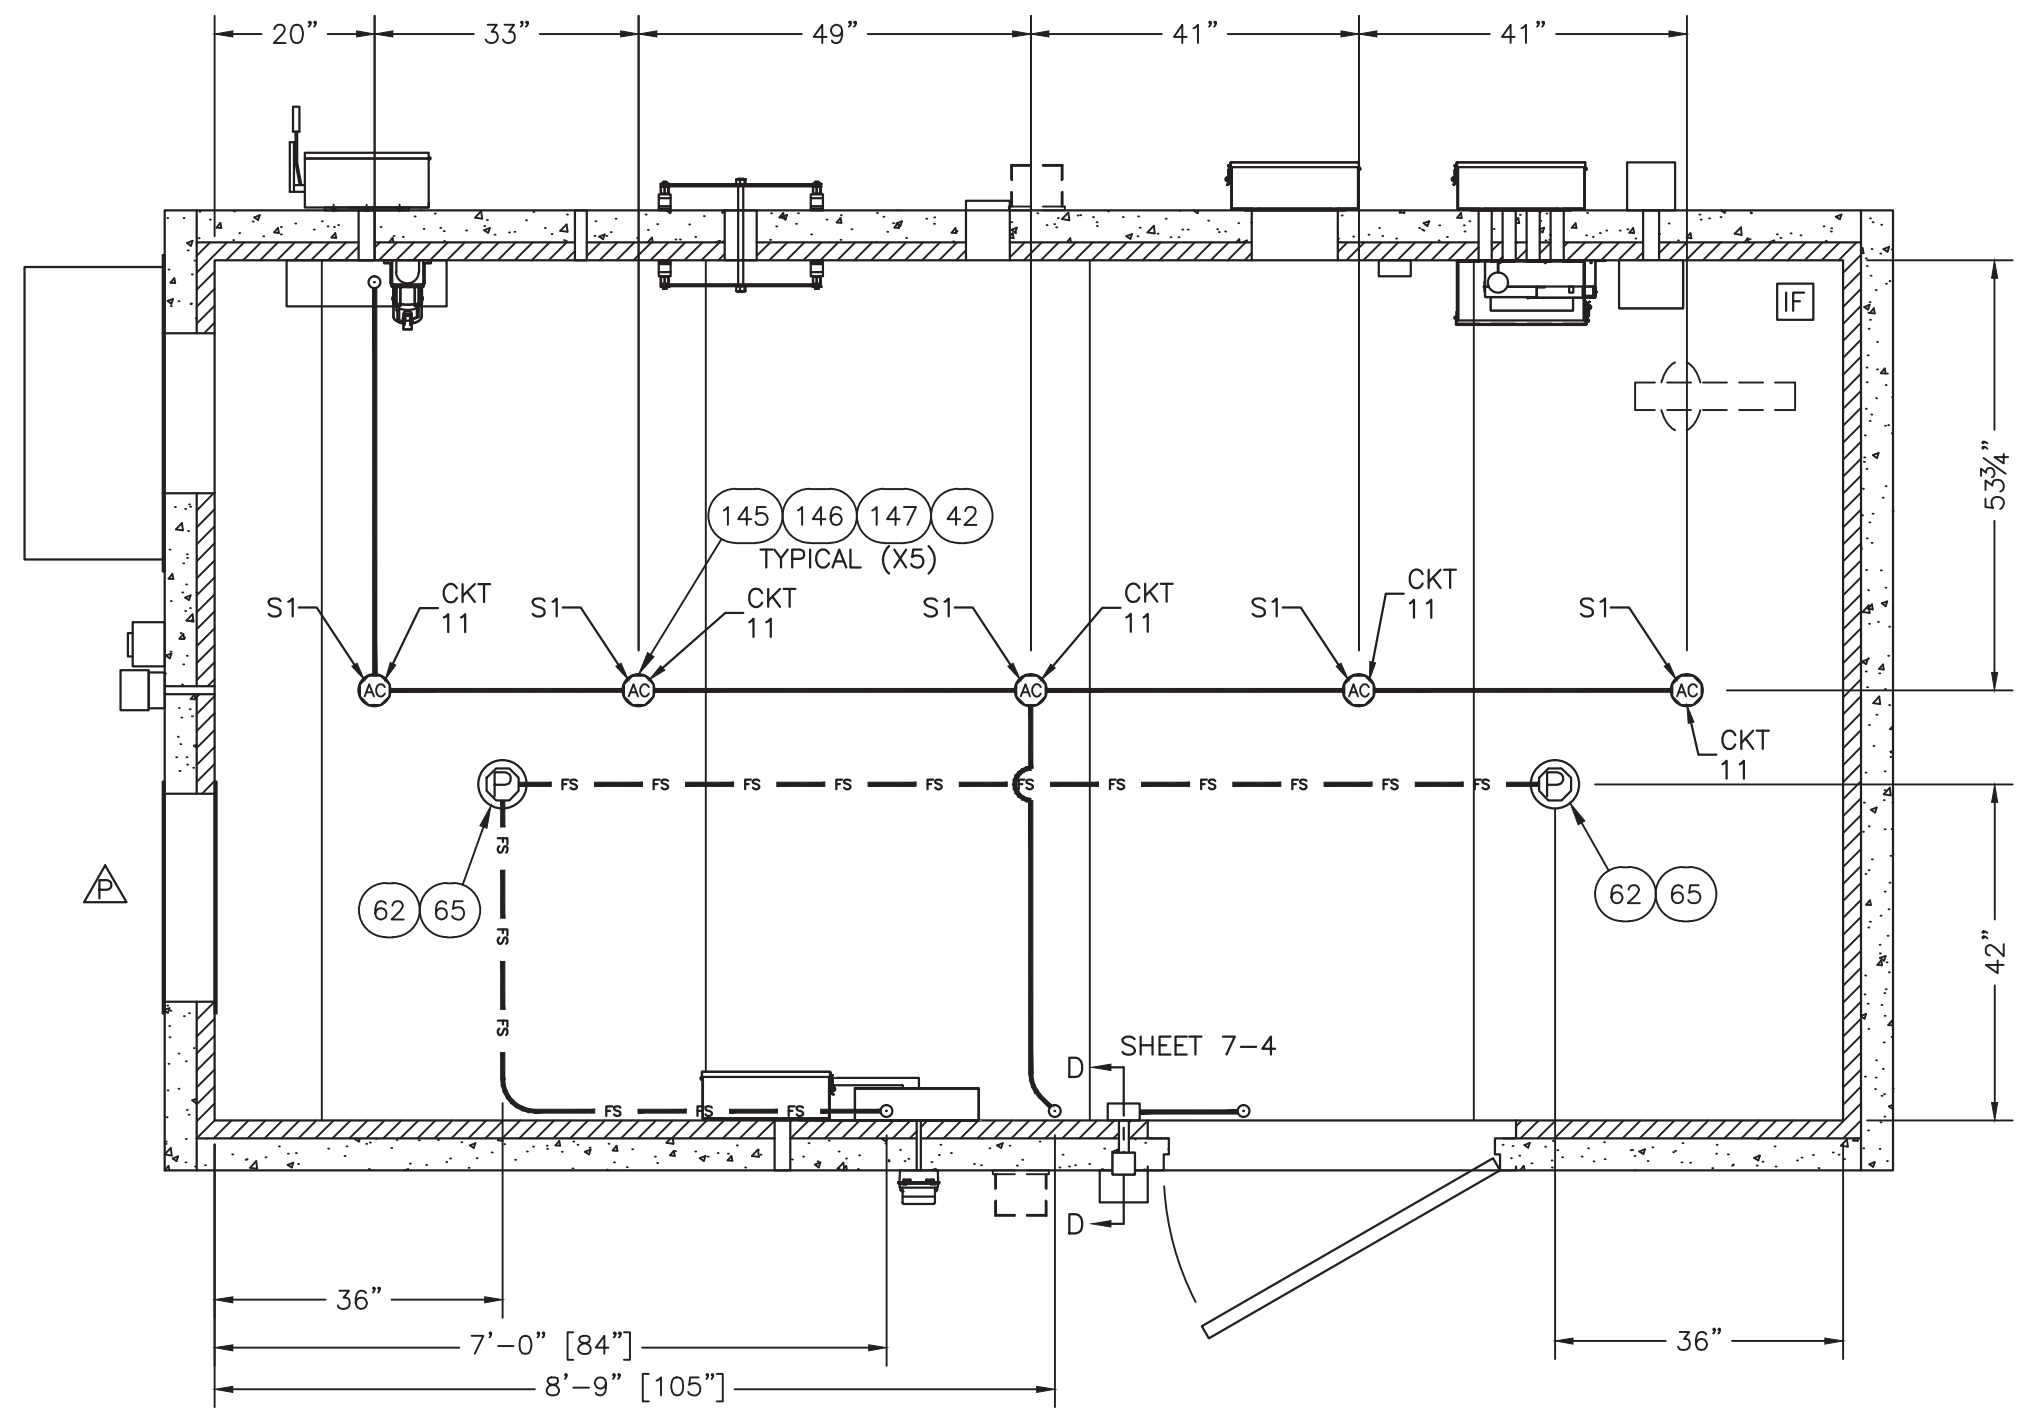


**LEGEND:**

- 1. IF = INTERIOR FINISH START PANEL

**REFLECTED CEILING VIEW  
 ELECTRICAL**

REV	BY	DATE	DESCRIPTION	APP. BY	DATE
P	RRG	10/31/12	UPDATED HVAC BLOCKOUT	LJL	10/31/12
N	RRG	6/13/12	ADDED UPS	LJL	6/13/12
L	RRG	04/21/11	ADDED NOTE	LJL	04/21/11
H	MST	01/21/11	PER CUSTOMER MARKUPS	WAR	01/21/11
G	MST	12/21/10	PER CUSTOMER MARKUPS	WAR	12/21/10
F	MST	12/17/10	PER CUSTOMER MARKUPS	WAR	12/17/10

SUB-PARTS LIST			
ITEM	P/N	ORIGINAL DESCRIPTION	CUT
181	510000	CABLE LADDER, 12" X 9' 8 1/2", YELLOW ZI	72"

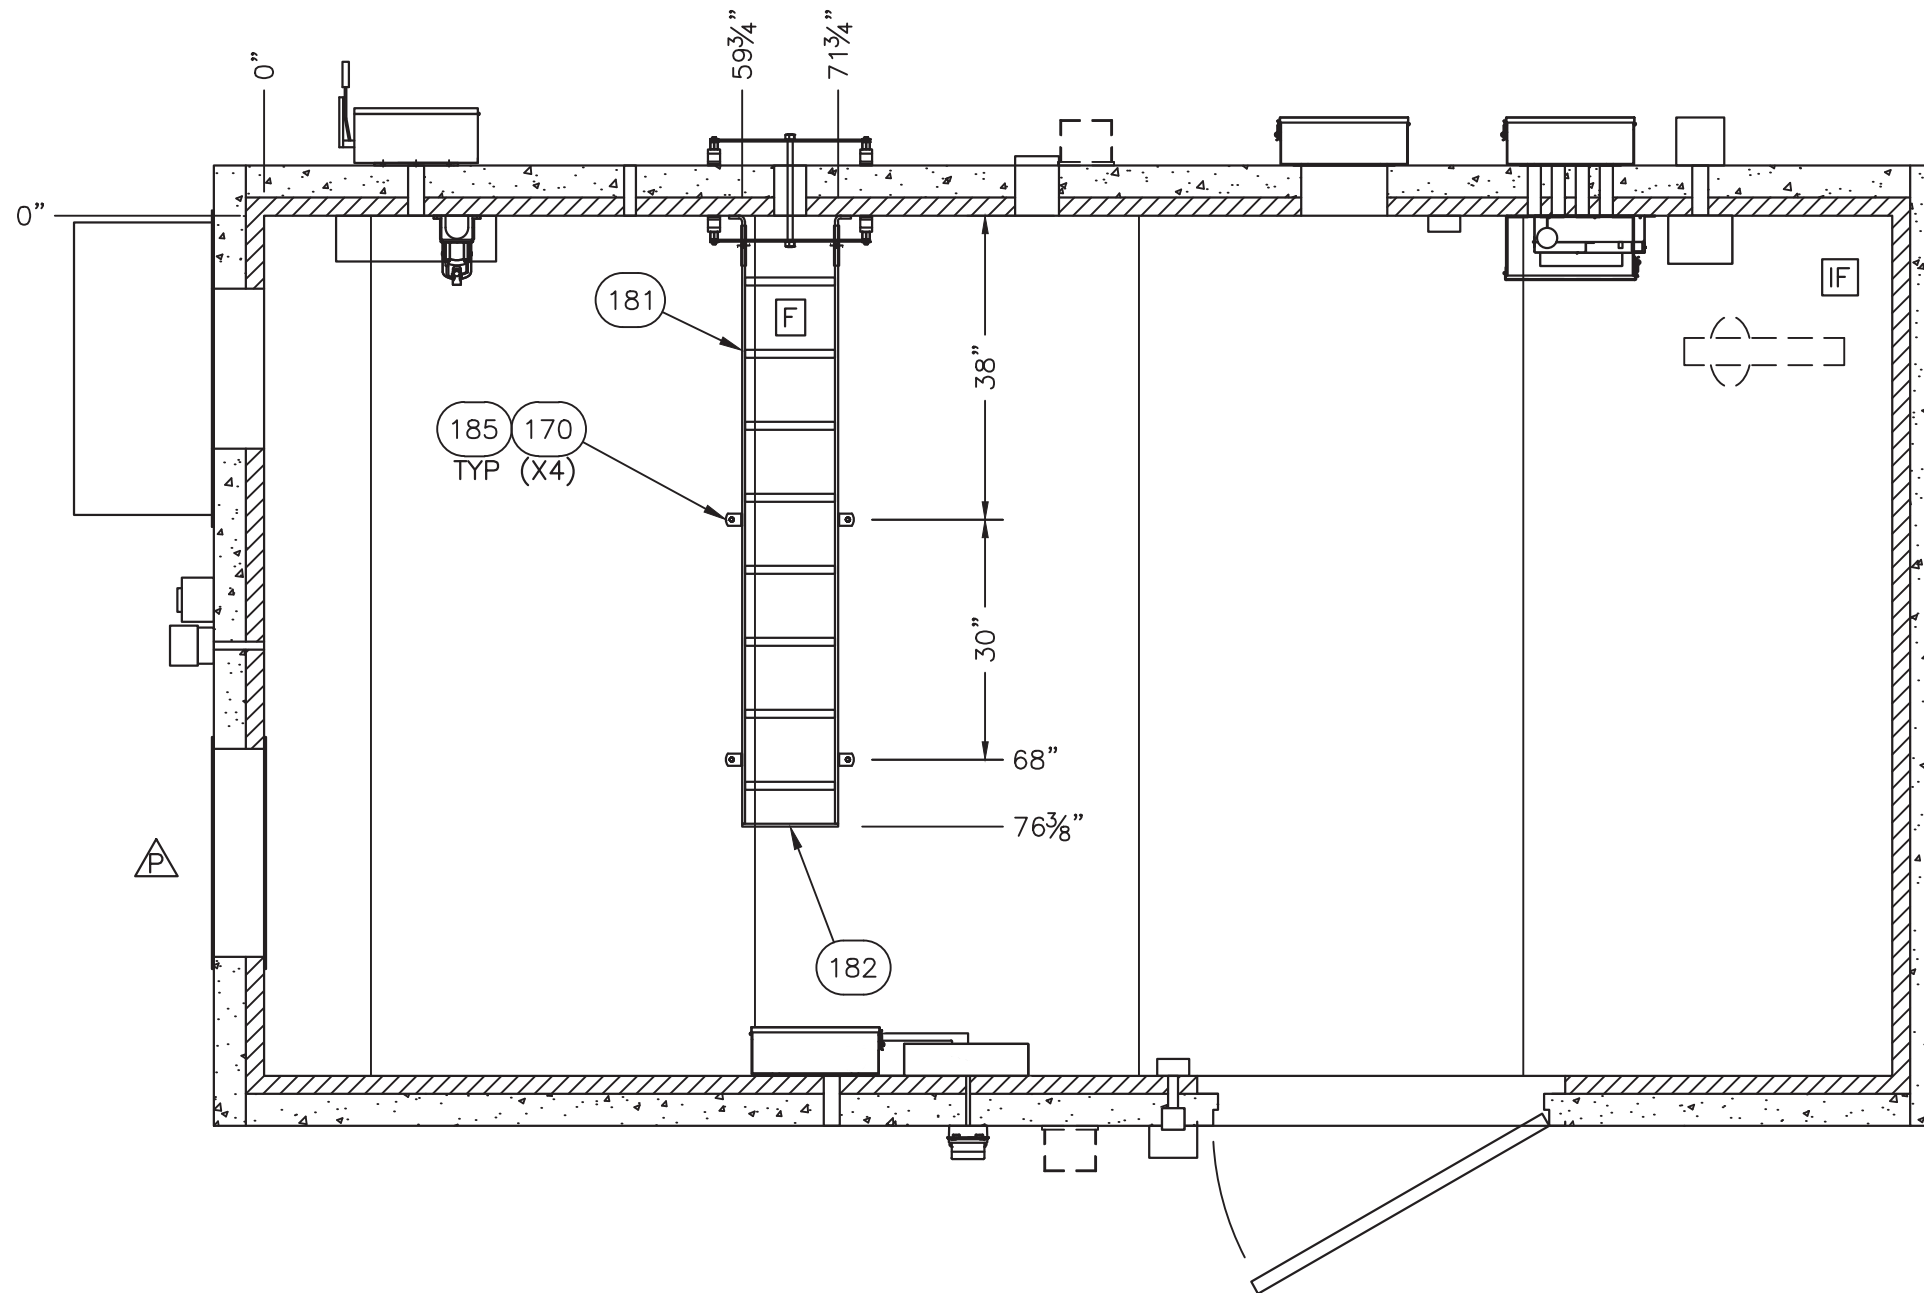


**LEGEND:**

1. [F] = CABLE LADDER FACTORY END
2. [IF] = INTERIOR FINISH START PANEL
3. CABLE LADDER TO BE MOUNTED 7'-6 1/2" (90 1/2") A.F.F.

**REFLECTED CEILING VIEW  
MECHANICAL**

REV	BY	DATE	DESCRIPTION	APP. BY	DATE
P	RRG	10/31/12	UPDATED HVAC BLOCKOUT	LJL	10/31/12
N	RRG	6/13/12	ADDED UPS	LJL	6/13/12
L	RRG	04/21/11	ADDED NOTE	LJL	04/21/11
H	MST	01/21/11	PER CUSTOMER MARKUPS	WAR	01/21/11
G	MST	12/21/10	PER CUSTOMER MARKUPS	WAR	12/21/10
F	MST	12/17/10	PER CUSTOMER MARKUPS	WAR	12/17/10

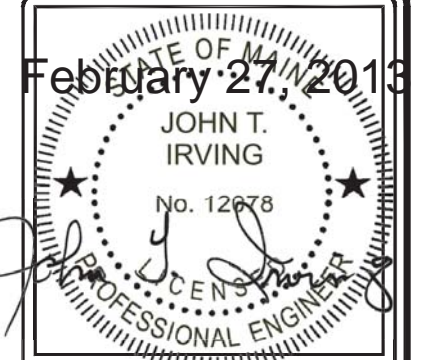

THIS DRAWING IS THE CONFIDENTIAL PROPERTY AND CONTAINS TRADE SECRETS OF CELLXION, LLC. ANY USE OF THESE DRAWINGS OR THE INFORMATION CONTAINED HEREIN FOR ANY REASON OTHER THAN AS EXPRESSLY AUTHORIZED BY SABRE INDUSTRIES, INC. IS STRICTLY PROHIBITED. THIS DRAWING HAS BEEN DISTRIBUTED WITH THE UNDERSTANDING THAT ANYONE RECEIVING OR OTHERWISE OBTAINING POSSESSION OF IT WILL BE EXPRESSLY NOTIFIED OF ITS CONFIDENTIAL NATURE.

**cellxion**  
5031 Hazel Jones Road  
Bossier City, Louisiana 71111  
voice: (318) 213-2900  
fax: (318) 213-2919  
www.cellxion.com


CUSTOMER:  
**KELLOGG  
BROWN & ROOT  
FEMA (PEP)  
EXPANSION PROGRAM**

PROJECT:  
**10'-0" X 18'-0"  
CONCRETE SHELTER  
REFLECTED CEILING  
VIEW - MECHANICAL**

FILENAME: KBR/SKBR02	
SCALE: 1/2"=1'-0"	TOLERANCE:
DRWN. BY: M. FOWLER	DATE: 03/24/2010
CHK. BY: V. HASSELL	DATE: 03/24/2010
ENG. BY:	DATE:
APP. BY: A. DUMAS	DATE: 03/24/2010
SHEET NO. 3-1	
DRAWING NO.:	REV.:
SKBR02	P




SUB-PARTS LIST			
ITEM	P/N	DESCRIPTION	CUT
197	540009	GROUND STRAP FLAT COPPER 4"W X 100'L	360"

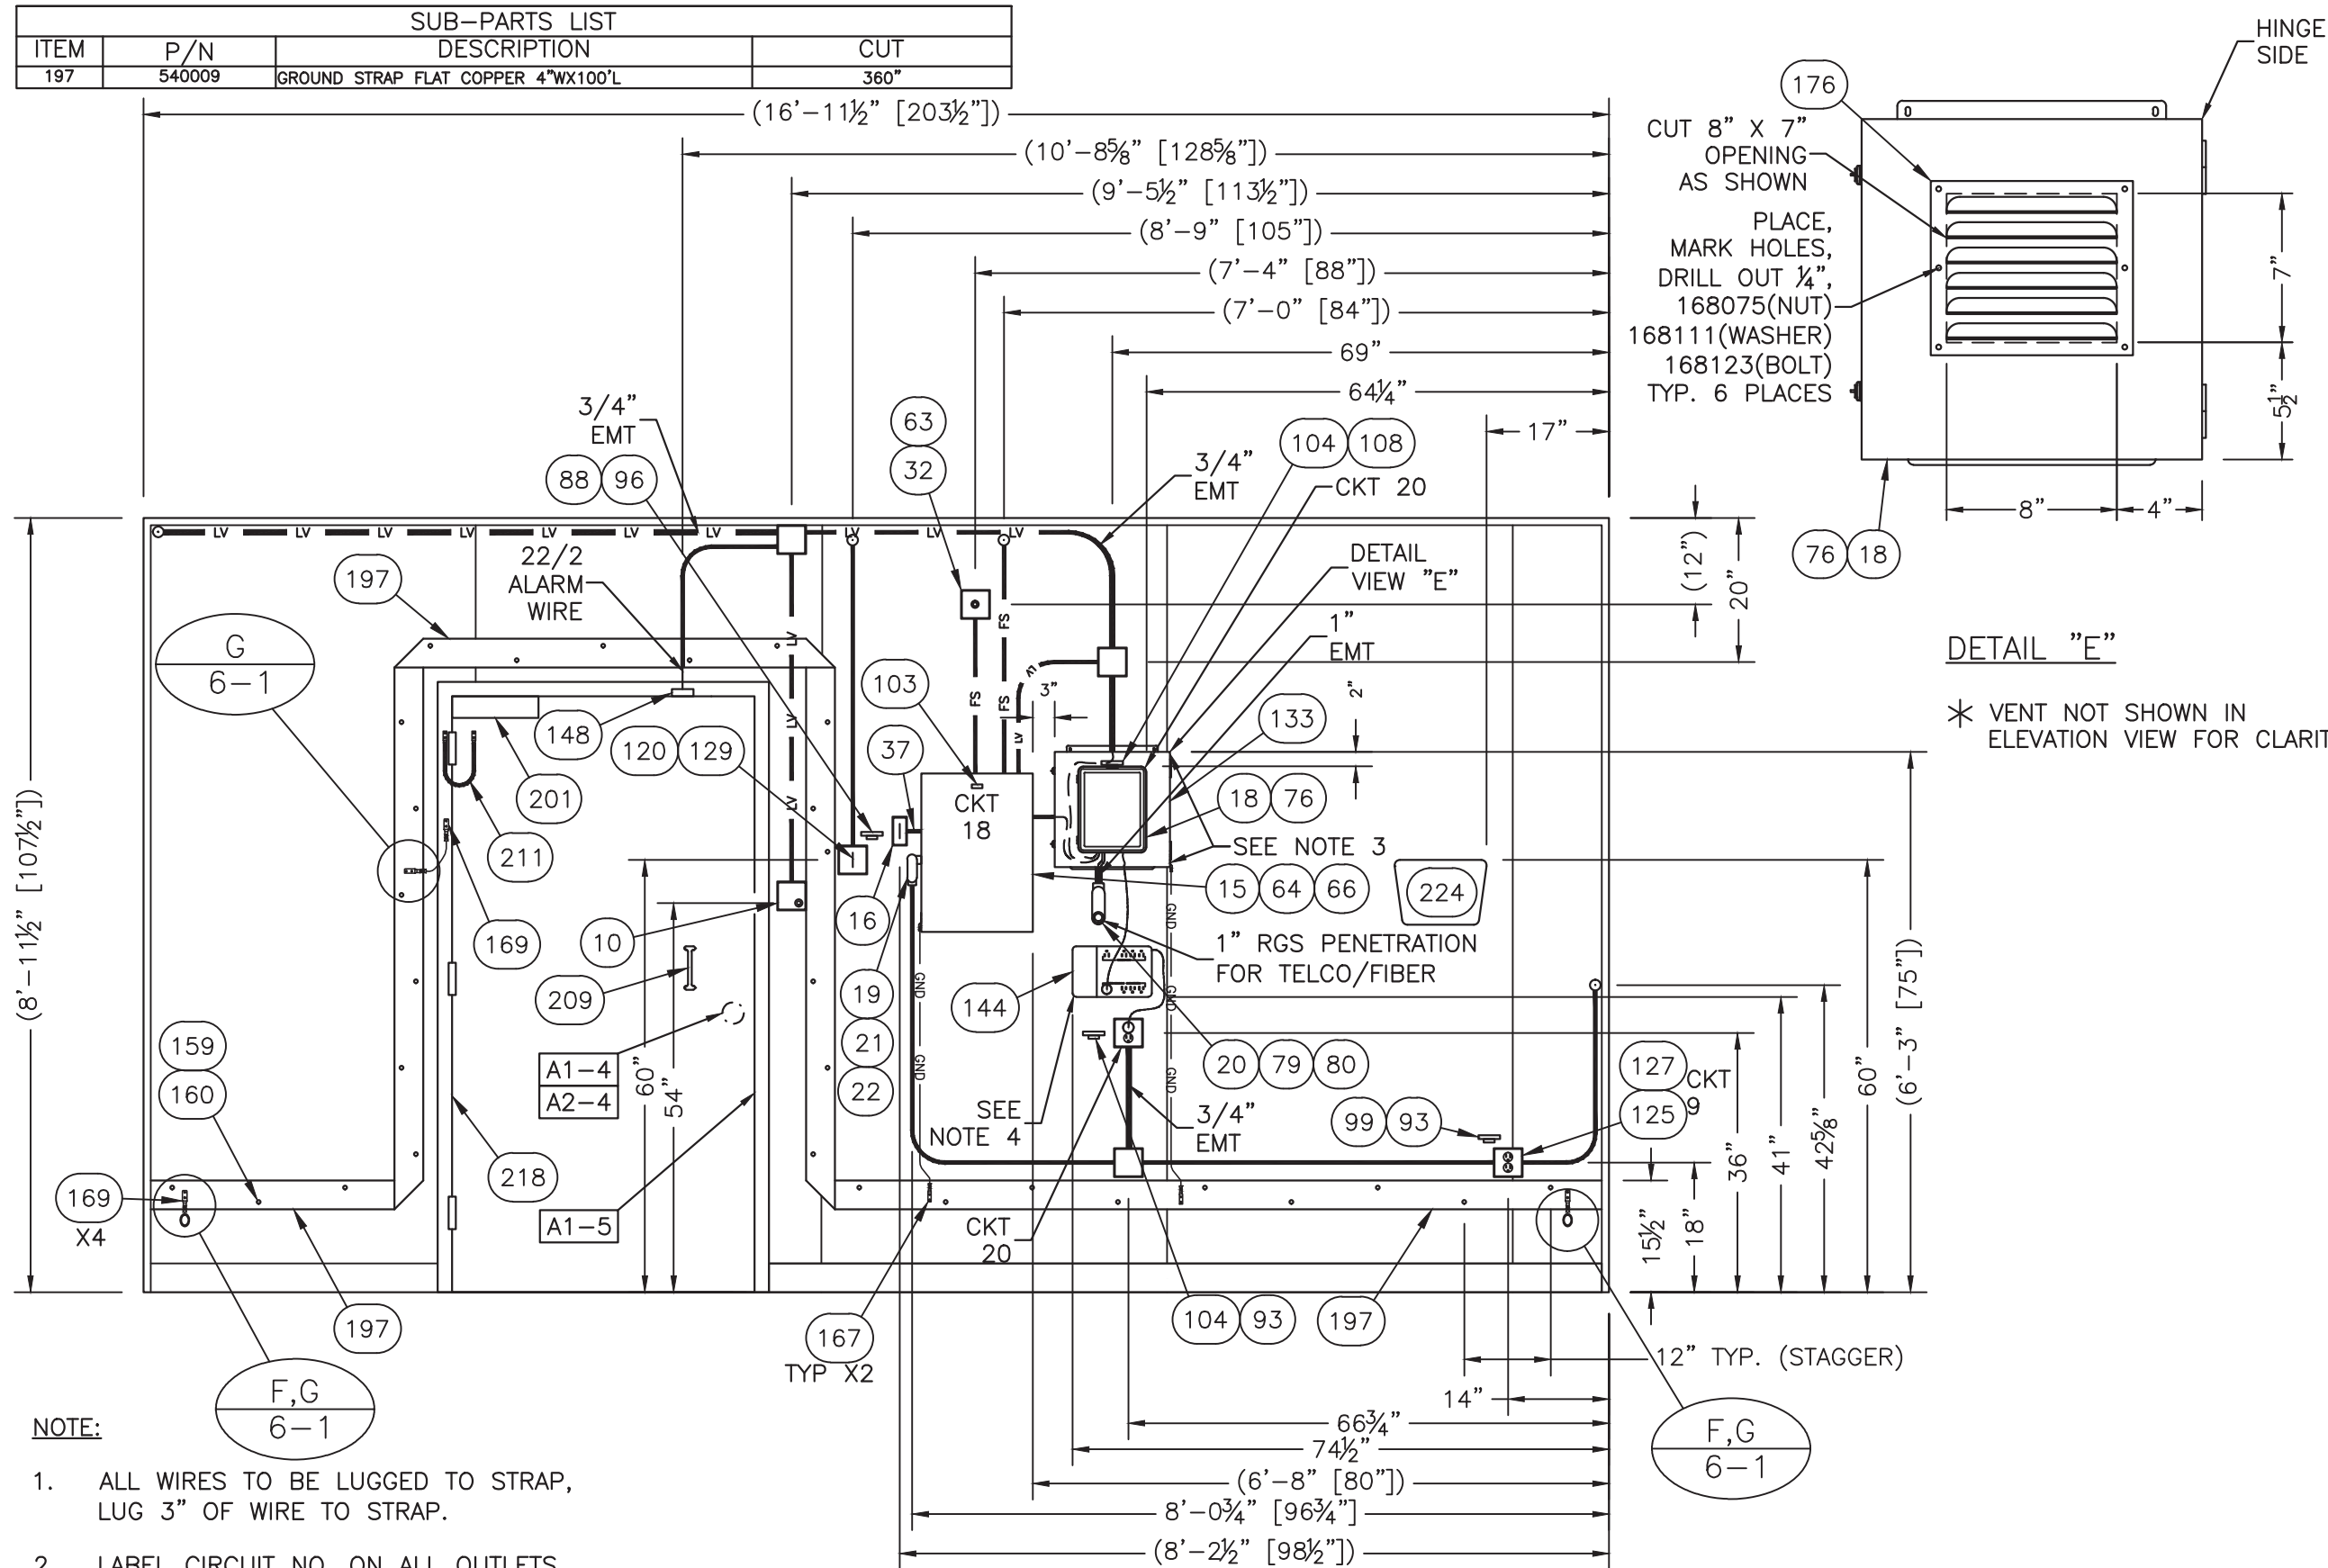

- NOTE:**
- ALL WIRES TO BE LUGGED TO STRAP, LUG 3" OF WIRE TO STRAP.
  - LABEL CIRCUIT NO. ON ALL OUTLETS.
  - BOX, ITEM (176) SHOWN WITHOUT DOOR ON ELEVATION VIEW ITEMS (18) (76).
  - MOUNT UPS TO MOUNTING SCREWS.

INTERIOR ELEVATION "A"

REV	BY	DATE	DESCRIPTION	APP. BY	DATE
N	JWR	6/29/12	ADDED BOTTOM TRIM TO VIEW	LJL	6/29/12
N	RRG	6/13/12	ADDED UPS/REROUTED FIKE CONDUIT/REMOVED CONDUIT/MOVED AND ADDED RECEPTACLES	LJL	6/13/12
M	JJ	11/09/11	MOVE GROUND FROM FIKE PANEL TO J BOX ITEM 103	LJL	04/21/11

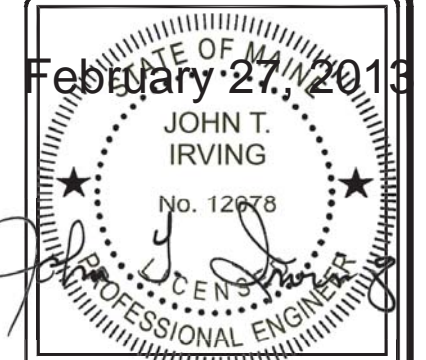

THIS DRAWING IS THE CONFIDENTIAL PROPERTY AND CONTAINS TRADE SECRETS OF CELLIXION, LLC. ANY USE OF THESE DRAWINGS OR THE INFORMATION CONTAINED HEREIN FOR ANY REASON OTHER THAN AS EXPRESSLY AUTHORIZED BY SABRE INDUSTRIES, INC. IS STRICTLY PROHIBITED. THIS DRAWING HAS BEEN DISTRIBUTED WITH THE UNDERSTANDING THAT ANYONE RECEIVING OR OTHERWISE OBTAINING POSSESSION OF IT WILL BE EXPRESSLY NOTIFIED OF ITS CONFIDENTIAL NATURE.

**cellixon**  
 5031 Hazel Jones Road  
 Bossier City, Louisiana 71111  
 voice: (318) 213-2900  
 fax: (318) 213-2919  
 www.cellixon.com


CUSTOMER:  
**KELLOGG  
 BROWN & ROOT  
 FEMA (PEP)  
 EXPANSION PROGRAM**

PROJECT:  
**10'-0" X 18'-0"  
 CONCRETE SHELTER  
 INTERIOR ELEVATION  
 "A"**

FILENAME: KBR/SKBRO2	
SCALE: 1/2"=1'-0"	TOLERANCE:
DRWN. BY: M. FOWLER	DATE: 03/24/2010
CHK. BY: V. HASSELL	DATE: 03/24/2010
ENG. BY:	DATE:
APP. BY: A. DUMAS	DATE: 03/24/2010
SHEET NO. 4-0	
DRAWING NO.:	REV.:
SKBR02	P

SUB-PARTS LIST			
ITEM	P/N	DESCRIPTION	CUT
68	400072	WIRE, #6/5, TYPE W MULTICONDUCTOR CAB	144"
166	400073	WIRE, #4 THHN, STRAND, GRN	54"
198	540009	GROUND STRAP FLAT COPPER 4"WX100'L	516"

February 27, 2013

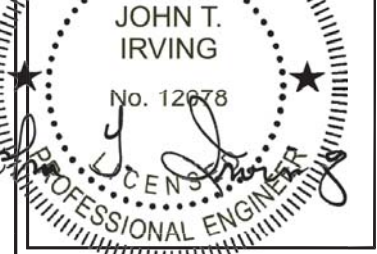


THIS DRAWING IS THE CONFIDENTIAL PROPERTY AND CONTAINS TRADE SECRETS OF CELLXION, LLC. ANY USE OF THESE DRAWINGS OR THE INFORMATION CONTAINED HEREIN FOR ANY REASON OTHER THAN AS EXPRESSLY AUTHORIZED BY SABRE INDUSTRIES, INC. IS STRICTLY PROHIBITED. THIS DRAWING HAS BEEN DISTRIBUTED WITH THE UNDERSTANDING THAT ANYONE RECEIVING OR OTHERWISE OBTAINING POSSESSION OF IT WILL BE EXPRESSLY NOTIFIED OF ITS CONFIDENTIAL NATURE.

**Cellxion**  
 5031 Hazel Jones Road  
 Bossier City, Louisiana 71111  
 voice: (318) 213-2900  
 fax: (318) 213-2919  
 www.cellxion.com

CUSTOMER:  
**KELLOGG  
 BROWN & ROOT  
 FEMA (PEP)  
 EXPANSION PROGRAM**

PROJECT:  
**10'-0" X 18'-0"  
 CONCRETE SHELTER  
 INTERIOR "C"**

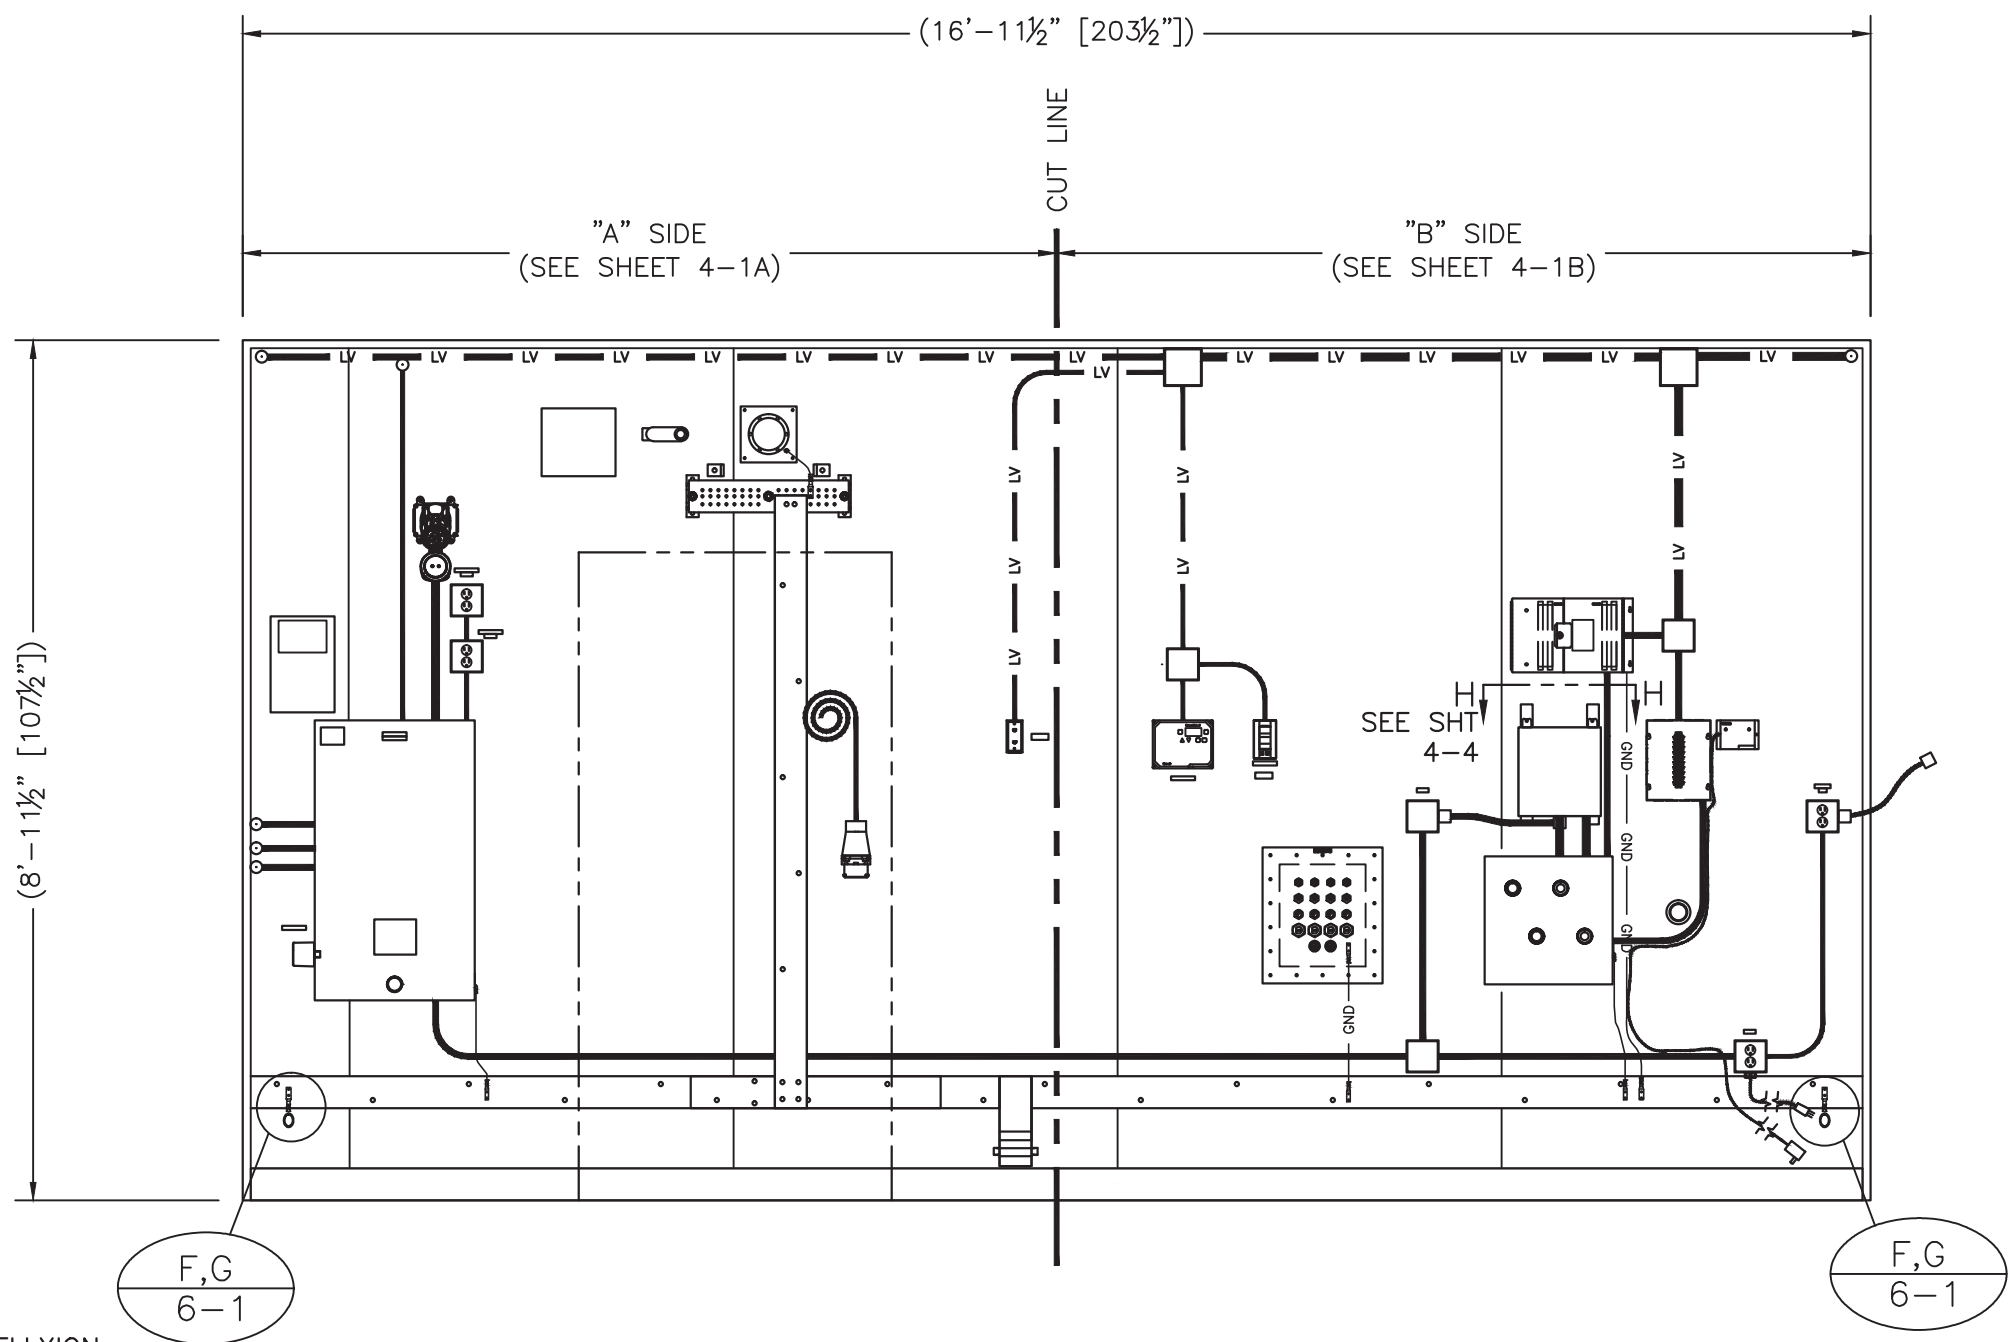

**NOTES:**

1. INSTALLED BY CELLXION WIRED BY OTHERS.
2. LUG 3" OF WIRE TO STRAP.
3. LABEL CIRCUIT NO. ON ALL OUTLETS.
4. MATCH LOCATE FLEX CONDUIT HOLES TO FUEL MONITOR AND NIPPLES THROUGH WALL (ITEM 30)(SEE SHT 4-1B)
5. SEE SHT 4-4 FOR POSITIONS
6. FUEL SYSTEM CONTROLLER FURNISHED BY OTHERS & INSTALLED BY CELLXION


INTERIOR ELEVATION "C"

REV	BY	DATE	DESCRIPTION	APP. BY	DATE
N	JWR	6/29/12	ADDED BOTTOM TRIM TO VIEW	LJL	6/29/12
N	RRG	6/13/12	SEPERATED SHEET INTO HALVES/ADJUSTED COPPER STRAPS	LJL	6/13/12
M	JJ	11/09/11	ADDED LABEL, NOTES, GROUND WIRE & CONDUIT SIZE	LJL	11/09/11
L	RRG	04/21/11	ADDED LABEL & NOTES	LJL	04/21/11

FILENAME: KBR/SKBRO2	
SCALE: 1/2"=1'-0"	TOLERANCE:
DRWN. BY: M. FOWLER	DATE: 03/24/2010
CHK. BY: V. HASSELL	DATE: 03/24/2010
ENG. BY:	DATE:
APP. BY: A. DUMAS	DATE: 03/24/2010
SHEET NO. 4-1	
DRAWING NO.:	REV.:
SKBR02	P

SUB-PARTS LIST			
ITEM	P/N	DESCRIPTION	CUT
68	400072	WIRE, #6/5, TYPE W MULTICONDUCTOR CAB	144"
166	400073	WIRE, #4 THHN, STRAND, GRN	54"
198	540009	GROUND STRAP FLAT COPPER 4"WX100'L	516"

February 27, 2013

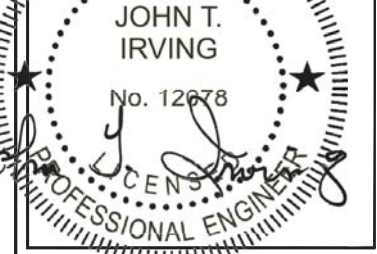


THIS DRAWING IS THE CONFIDENTIAL PROPERTY AND CONTAINS TRADE SECRETS OF CELLXION, LLC. ANY USE OF THESE DRAWINGS OR THE INFORMATION CONTAINED HEREIN FOR ANY REASON OTHER THAN AS EXPRESSLY AUTHORIZED BY SABRE INDUSTRIES, INC. IS STRICTLY PROHIBITED. THIS DRAWING HAS BEEN DISTRIBUTED WITH THE UNDERSTANDING THAT ANYONE RECEIVING OR OTHERWISE OBTAINING POSSESSION OF IT WILL BE EXPRESSLY NOTIFIED OF ITS CONFIDENTIAL NATURE.

**cellxion**  
 5031 Hazel Jones Road  
 Bossier City, Louisiana 71111  
 voice: (318) 213-2900  
 fax: (318) 213-2919  
 www.cellxion.com

CUSTOMER:  
**KELLOGG  
 BROWN & ROOT  
 FEMA (PEP)  
 EXPANSION PROGRAM**

PROJECT:  
**10'-0" X 18'-0"  
 CONCRETE SHELTER  
 INTERIOR ELEVATION "C"  
 ("A" SIDE)**

FILENAME: KBR/SKBRO2	
SCALE: 1/2"=1'-0"	TOLERANCE:
DRWN. BY: M. FOWLER	DATE: 03/24/2010
CHK. BY: V. HASSELL	DATE: 03/24/2010
ENG. BY:	DATE:
APP. BY: A. DUMAS	DATE: 03/24/2010
SHEET NO. 4-1A	
DRAWING NO.:	REV.:
SKBR02	P

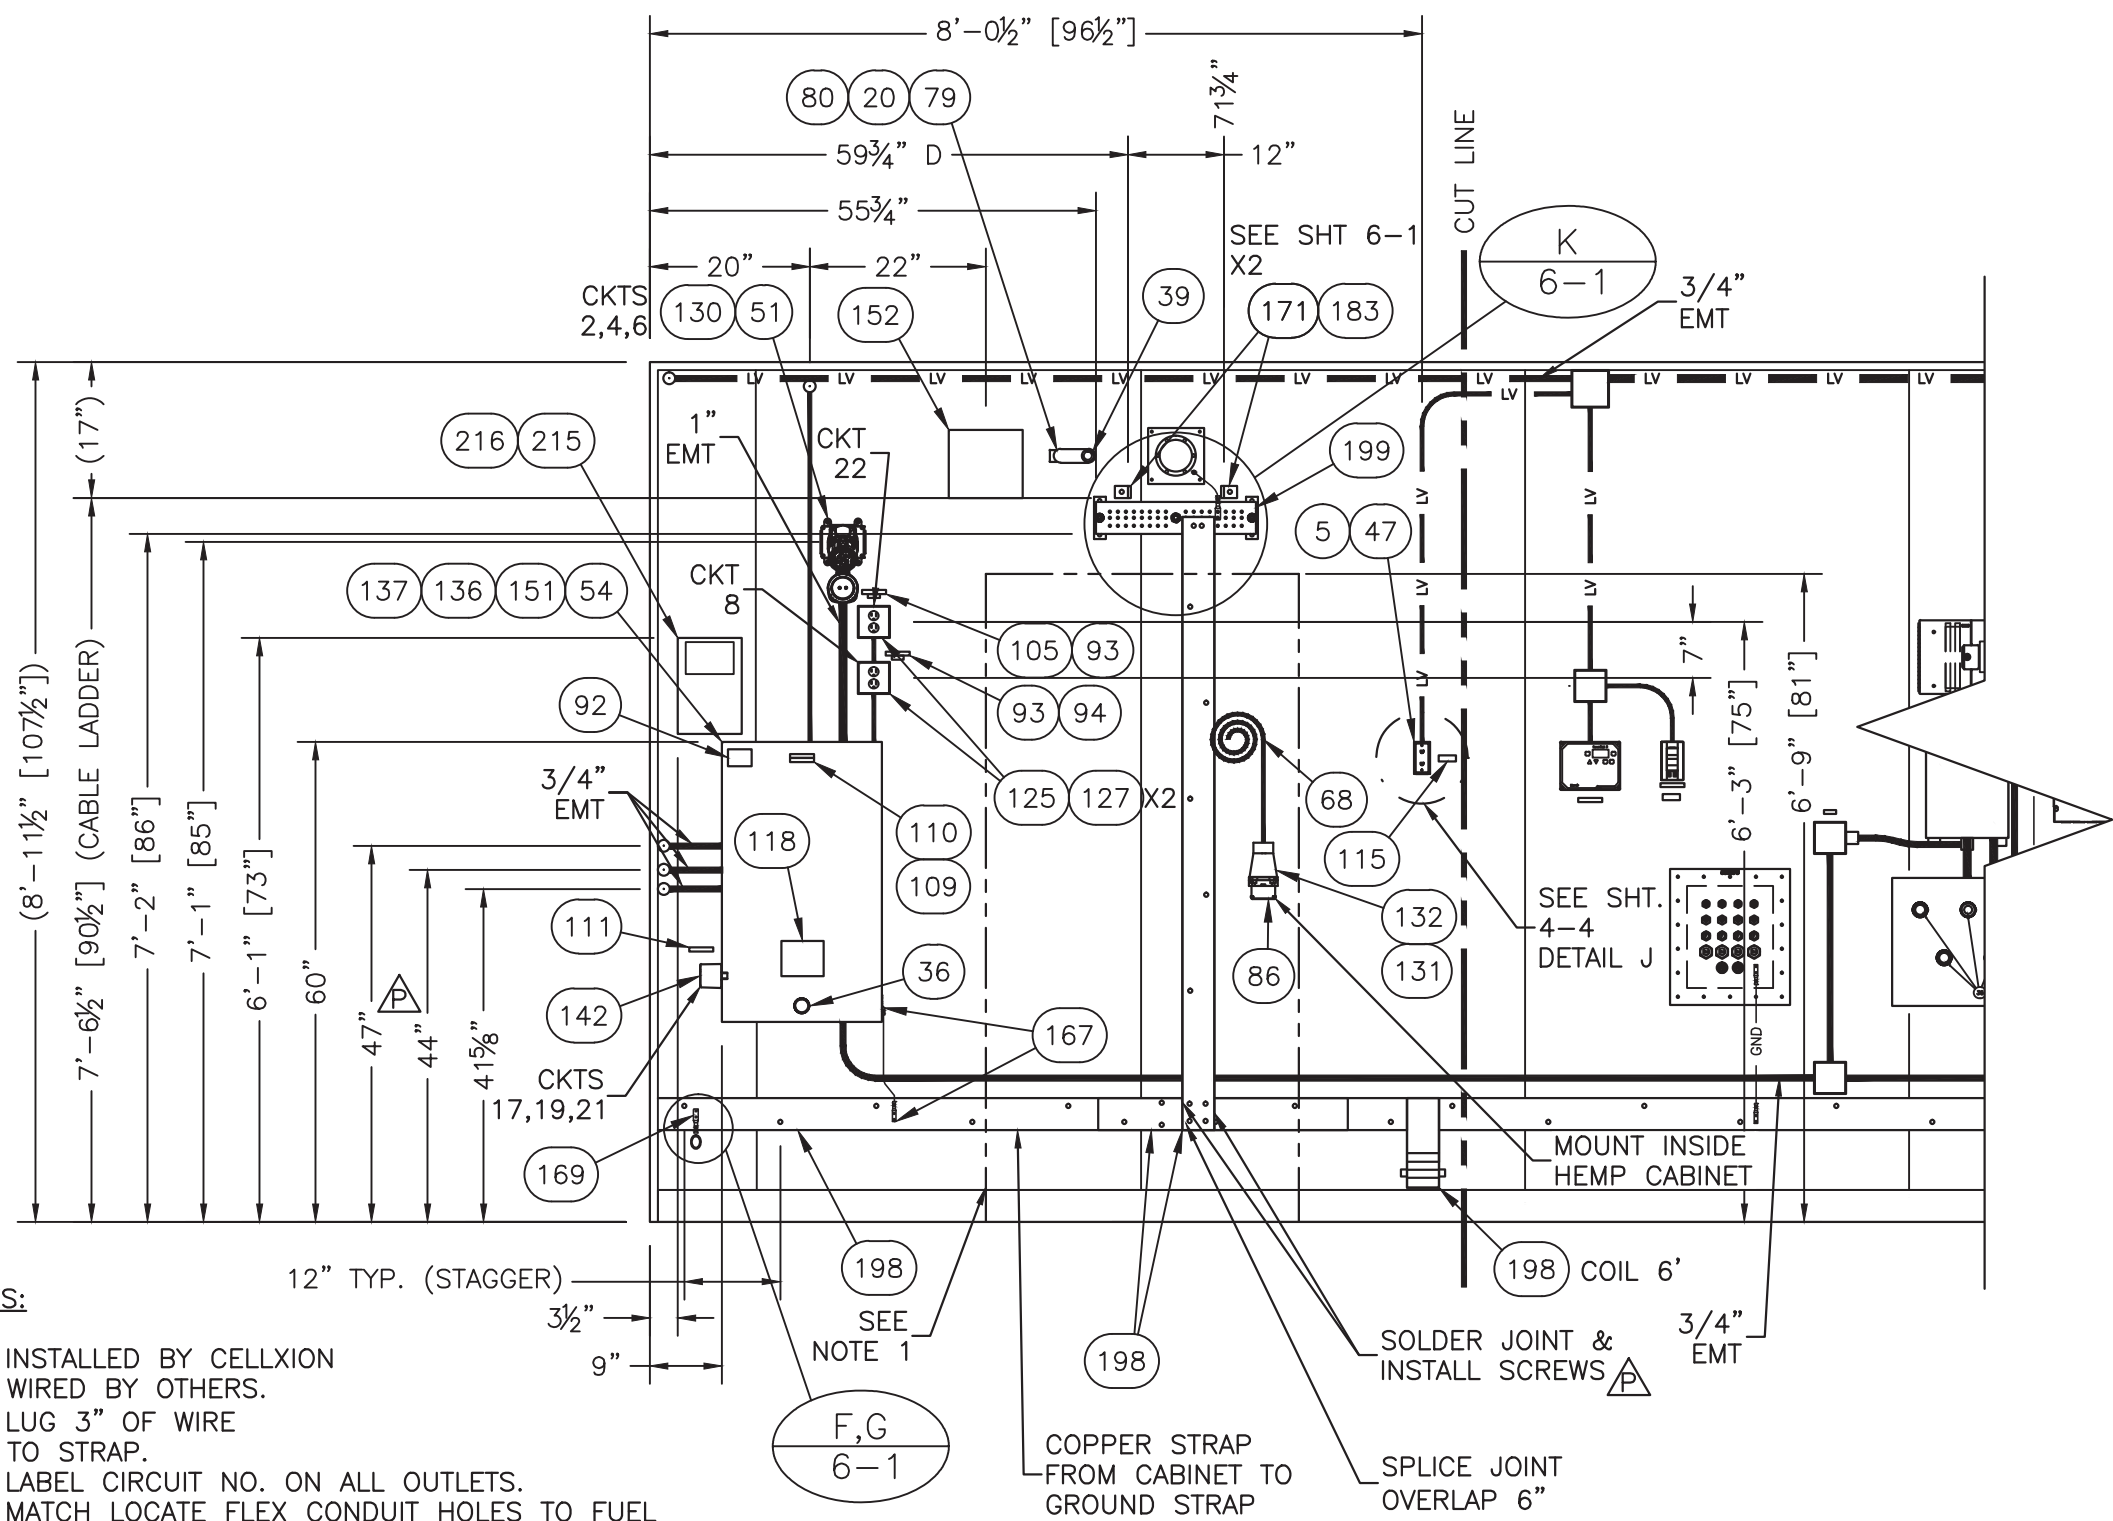

**NOTES:**



1. INSTALLED BY CELLXION WIRED BY OTHERS.
2. LUG 3" OF WIRE TO STRAP.
3. LABEL CIRCUIT NO. ON ALL OUTLETS.
4. MATCH LOCATE FLEX CONDUIT HOLES TO FUEL MONITOR AND NIPPLES THROUGH WALL (ITEM 30)(SEE SHT 4-1B)
5. SEE SHT 4-4 FOR POSITIONS
6. FUEL SYSTEM CONTROLLER FURNISHED BY OTHERS & INSTALLED BY CELLXION

INTERIOR ELEVATION "C"  
 ("A" SIDE)

REV	BY	DATE	DESCRIPTION	APP. BY	DATE
P	RRG	10/31/12	CHANGED CONDUIT HEIGHT & ADDED CORD GRIP CONNECTOR, MODIFIED NOTE	LJL	10/31/12
N	JWR	6/29/12	ADDED BOTTOM TRIM TO VIEW	LJL	6/29/12
N	RRG	6/13/12	ADJUSTED COPPER STRAPS	LJL	6/13/12
M	JJ	11/09/11	ADDED LABEL, NOTES, GROUND WIRE & CONDUIT SIZE	LJL	11/09/11
L	RRG	04/21/11	ADDED LABEL & NOTES	LJL	04/21/11



SUB-PARTS LIST			
ITEM	P/N	DESCRIPTION	CUT
68	400072	WIRE, #6/5, TYPE W MULTICONDUCTOR CAB	144"
166	400073	WIRE, #4 THHN, STRAND, GRN	54"
198	540009	GROUND STRAP FLAT COPPER 4"W X 100'L	516"

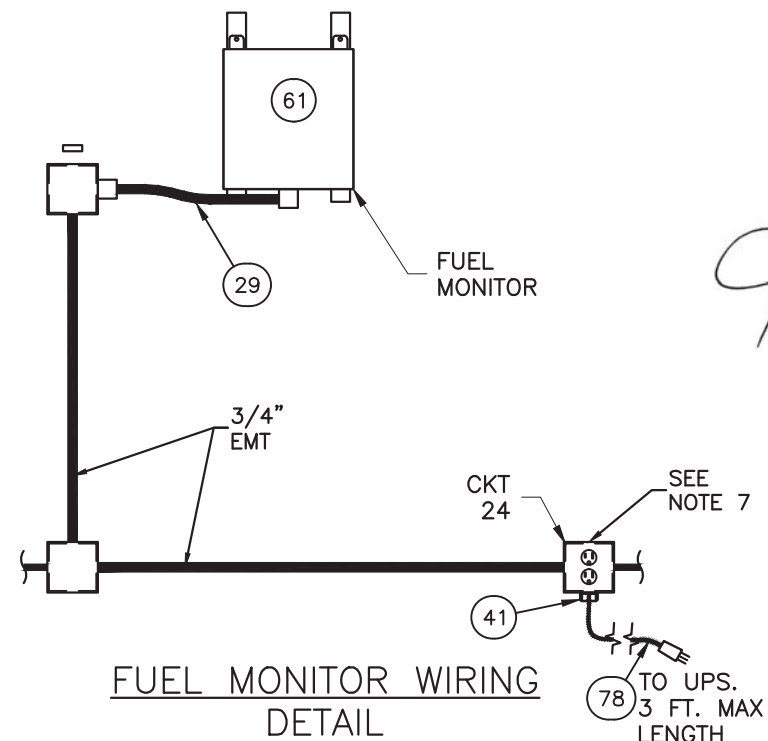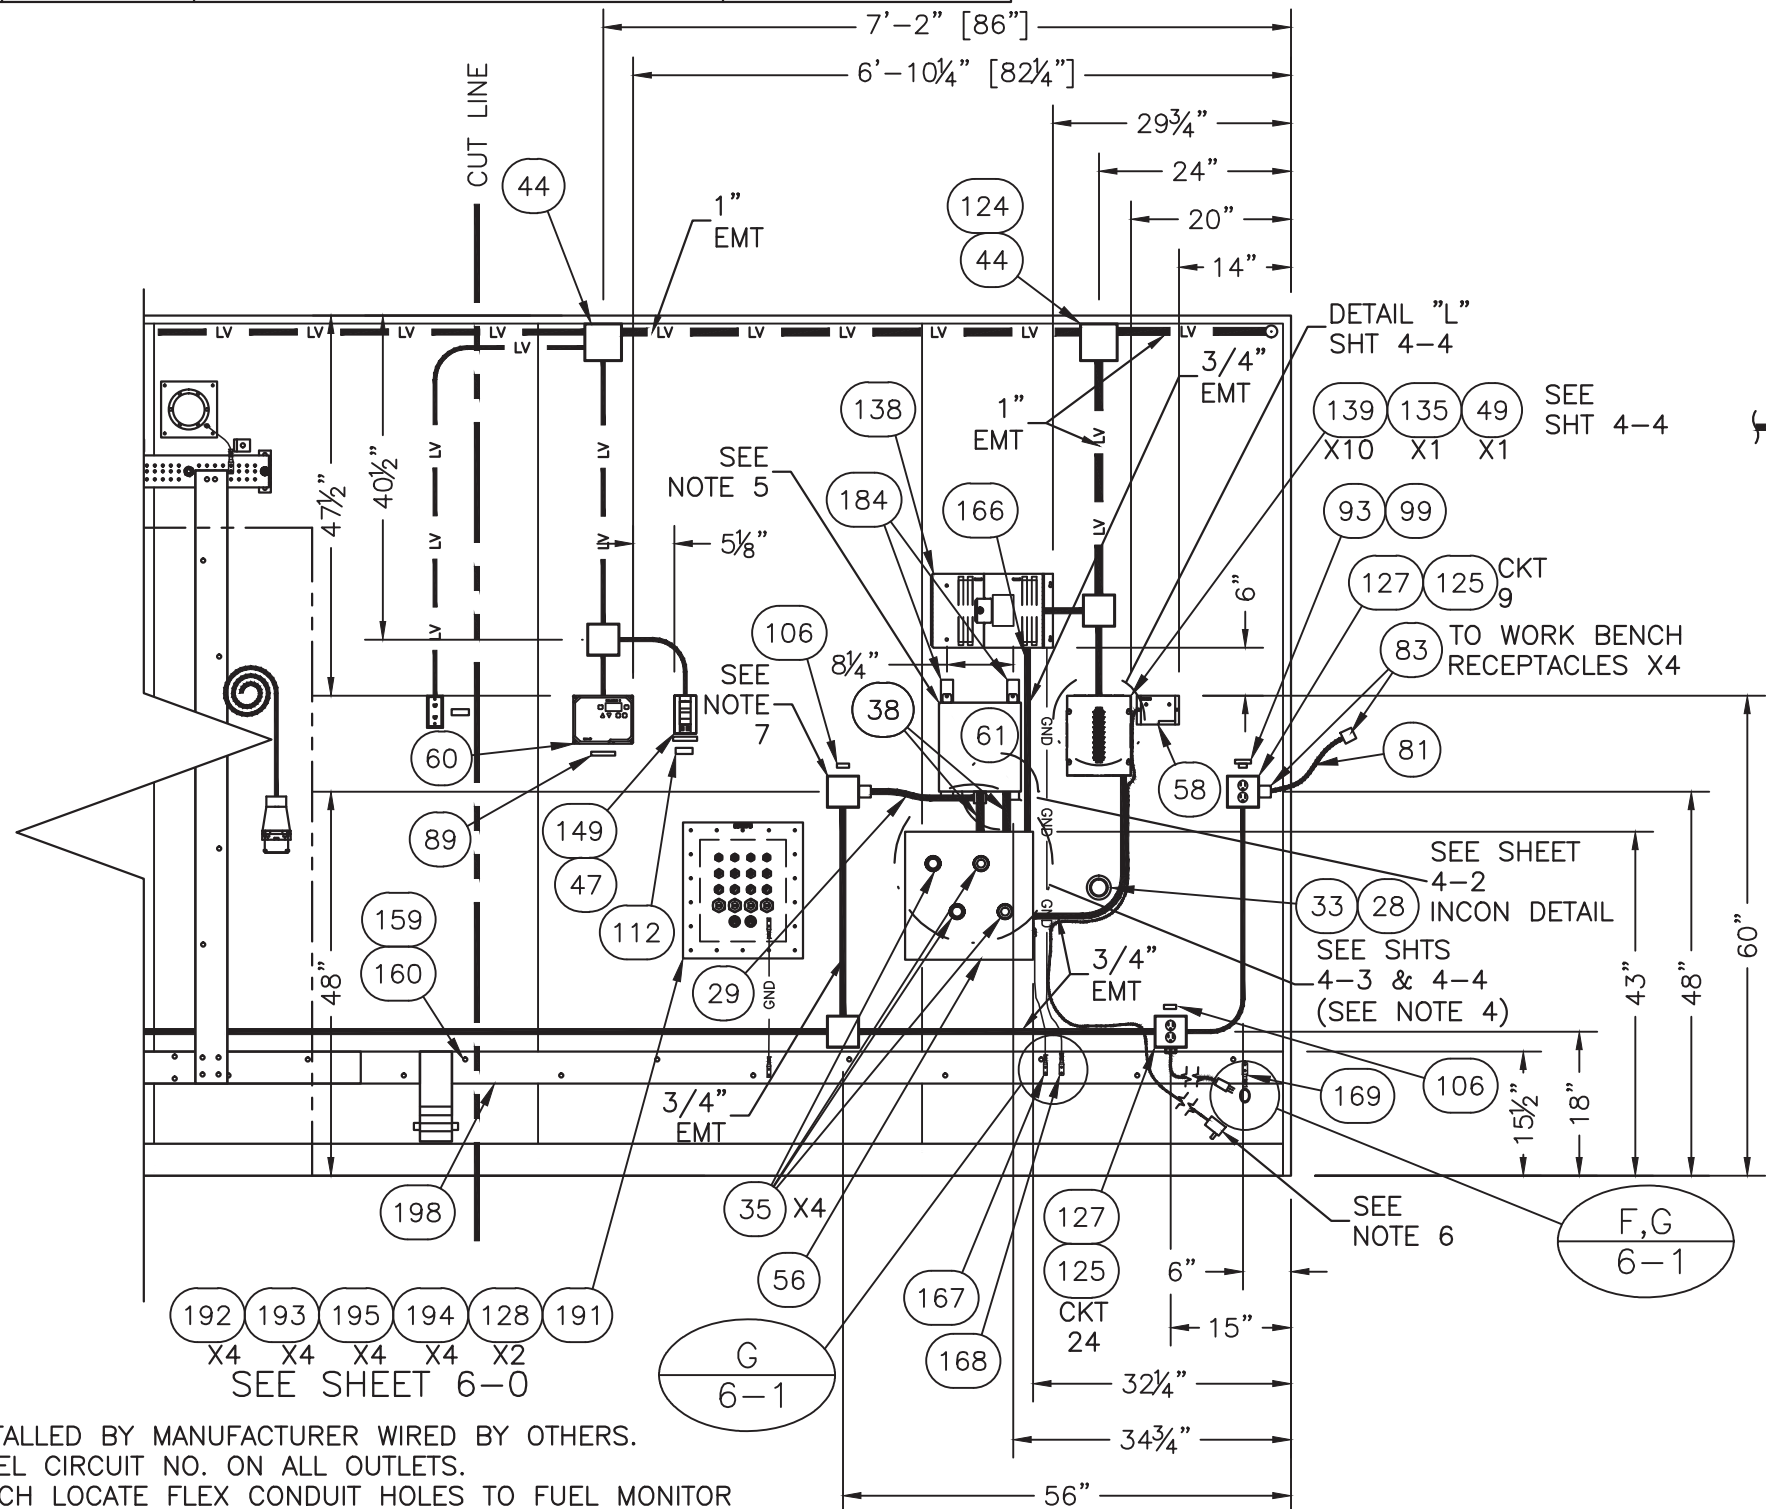


FUEL MONITOR WIRING  
DETAIL

- NOTE:**
- PULL #12 BLK/WHT/GRN THHN WIRE FROM FUEL MONITOR THROUGH CONDUIT PATH TO RECEPTACLE J-BOX.
  - WIRE #12 WIRE AT FUEL MONITOR TO POWER CONNECTIONS.
  - ATTACH FLEXIBLE POWER CORD (410519) TO RECEPTACLE J-BOX & WIRE TO #12 THHN WIRE PULLED TO FUEL MONITOR.

- NOTES:**
- INSTALLED BY MANUFACTURER WIRED BY OTHERS.
  - LABEL CIRCUIT NO. ON ALL OUTLETS.
  - MATCH LOCATE FLEX CONDUIT HOLES TO FUEL MONITOR AND NIPPLES THROUGH WALL (ITEM 30)
  - SEE SHT 4-4 FOR POSITIONS
  - FUEL SYSTEM CONTROLLER FURNISHED BY OTHERS & INSTALLED BY CELLXION.
  - PLUG RECEPTACLE CORDS INTO UPS (440114) & SECURE THEM TO ADJACENT CONDUIT WITH TIE WRAPS.
  - CONNECT 120VAC WIRE & GROUND TO FLEXIBLE POWER CORD (400893) IN JB WITH OUTLET FOR UPS (440114)

INTERIOR ELEVATION "C"  
("B" SIDE)

REV	BY	DATE	DESCRIPTION	APP. BY	DATE
N	RRG	6/13/12	REROUTED CONDUIT/ADDED SO CORD & DETAIL	LJL	6/13/12
N	RRG	6/13/12	REROUTED CONDUIT/ADDED SO CORD & DETAIL	LJL	6/13/12
M	JJ	11/09/11	ADDED LABEL, NOTES, GROUND WIRE & CONDUIT SIZE	LJL	11/09/11
L	RRG	04/21/11	ADDED LABEL & NOTES	LJL	04/21/11

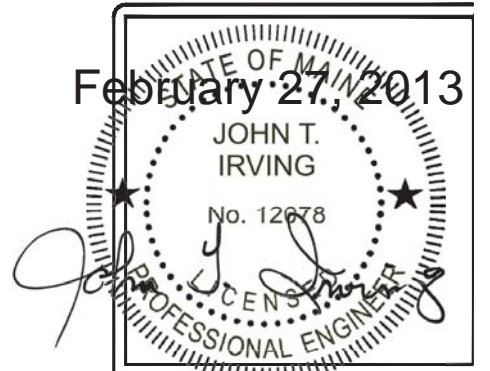

THIS DRAWING IS THE CONFIDENTIAL PROPERTY AND CONTAINS TRADE SECRETS OF CELLXION, LLC. ANY USE OF THESE DRAWINGS OR THE INFORMATION CONTAINED HEREIN FOR ANY REASON OTHER THAN AS EXPRESSLY AUTHORIZED BY SABRE INDUSTRIES, INC. IS STRICTLY PROHIBITED. THIS DRAWING HAS BEEN DISTRIBUTED WITH THE UNDERSTANDING THAT ANYONE RECEIVING OR OTHERWISE OBTAINING POSSESSION OF IT WILL BE EXPRESSLY NOTIFIED OF ITS CONFIDENTIAL NATURE.

**Cellxion**  
5031 Hazel Jones Road  
Bossier City, Louisiana 71111  
voice: (318) 213-2900  
fax: (318) 213-2919  
www.cellxion.com


**CUSTOMER:**  
KELLOGG  
BROWN & ROOT  
FEMA (PEP)  
EXPANSION PROGRAM

**PROJECT:**  
10'-0" X 18'-0"  
CONCRETE SHELTER  
INTERIOR ELEVATION "C"  
("B" SIDE)


FILENAME: KBR/SKBRO2	
SCALE: 1/2"=1'-0"	TOLERANCE:
DRWN. BY: M. FOWLER	DATE: 03/24/2010
CHK. BY: V. HASSELL	DATE: 03/24/2010
ENG. BY:	DATE:
APP. BY: A. DUMAS	DATE: 03/24/2010
SHEET NO. 4-1B	
DRAWING NO.:	REV.:
SKBR02	P



SUB-PARTS LIST			
ITEM	P/N	DESCRIPTION	CUT
196	540009	GROUND STRAP FLAT COPPER 4"WX100'L	108"

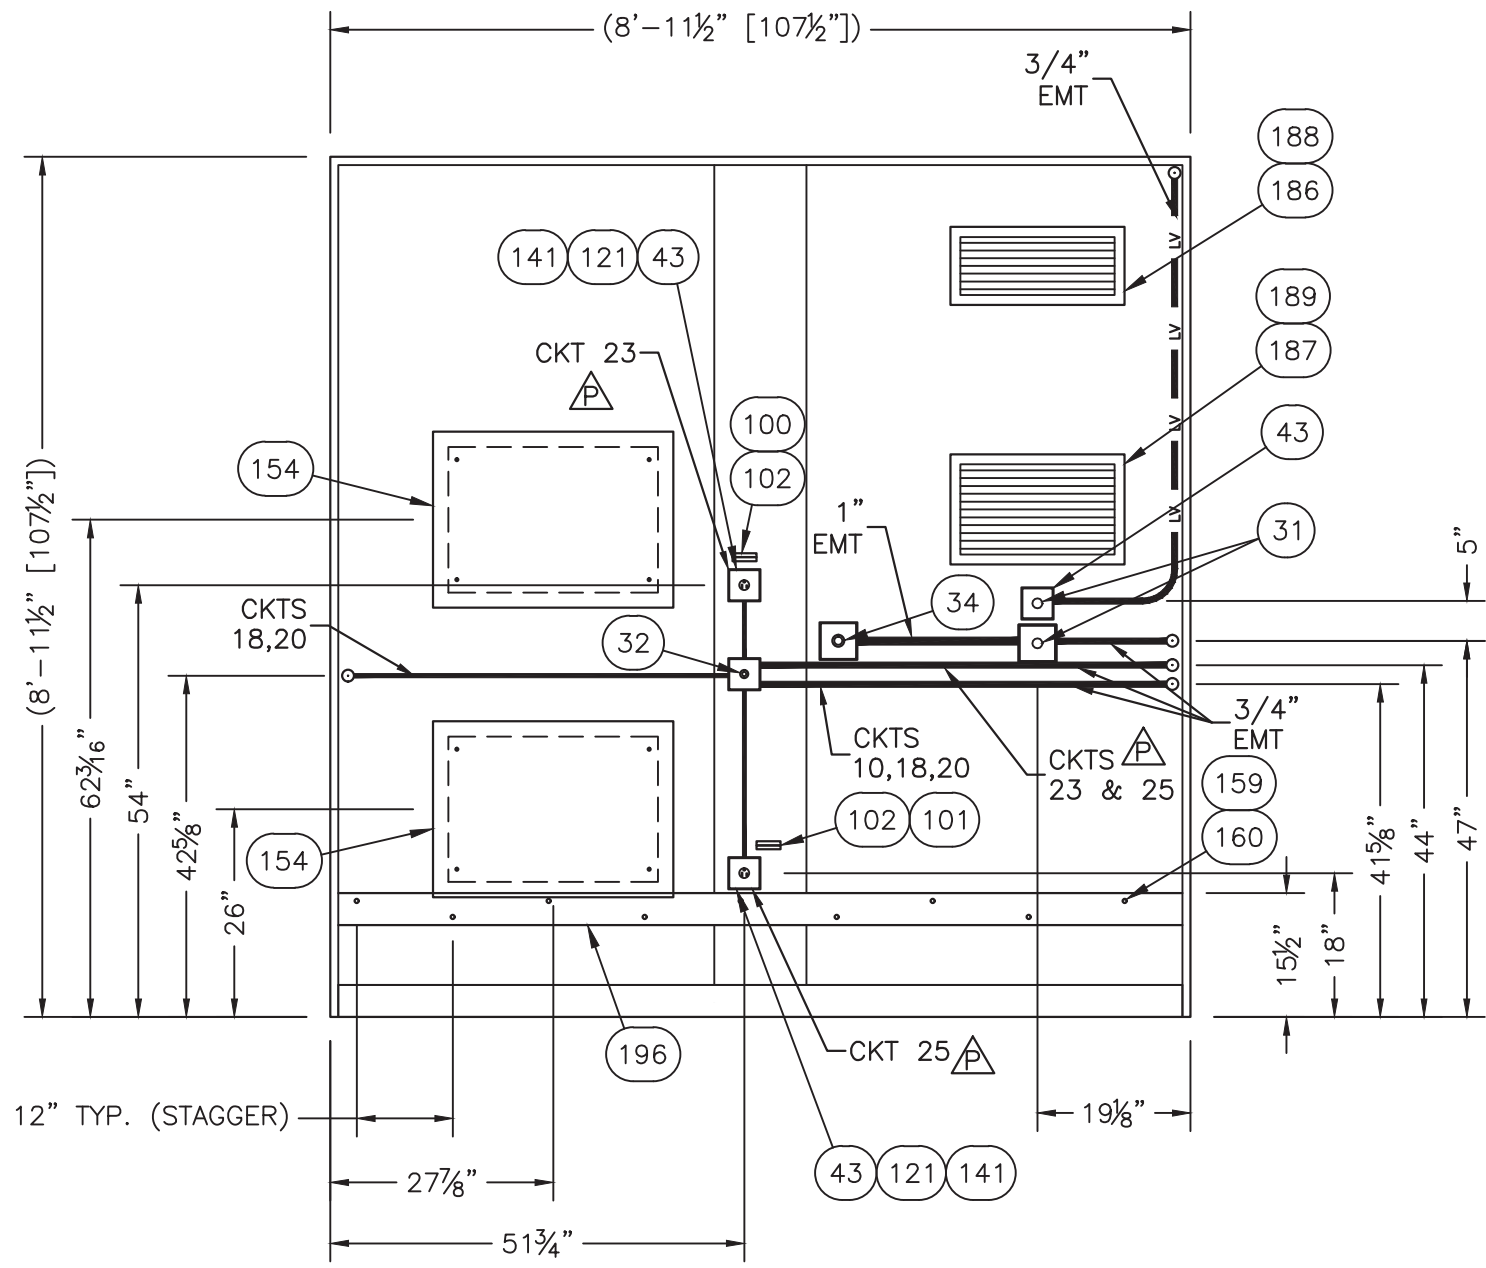


INTERIOR ELEVATION "B"  
(SHOWN IN NORMAL STORAGE ASSEMBLY)

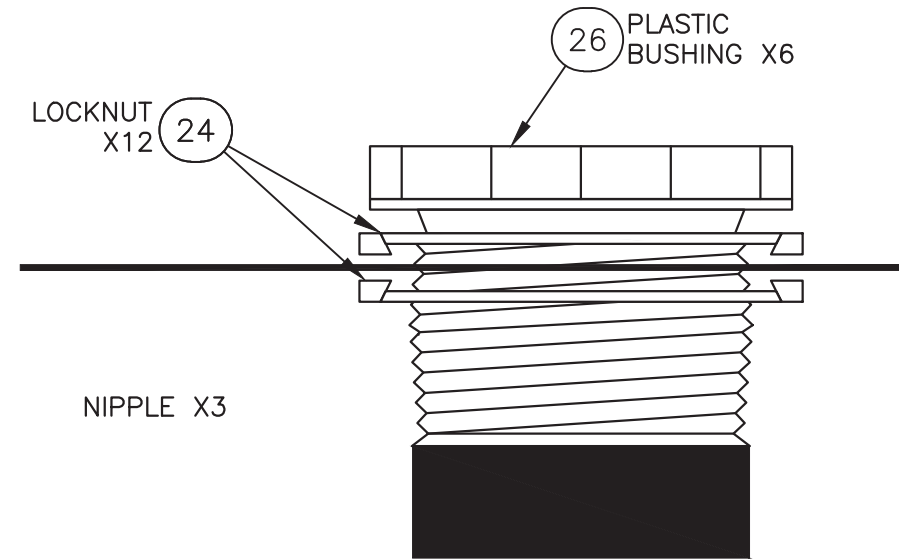

DETAIL CONNECTION  
INCON BOX  
SEE SHT 4-1

- NOTE:
- LUG 3" OF WIRE TO STRAP.
  - LABEL CIRCUIT NO. ON ALL OUTLETS.  $\Delta$

REV	BY	DATE	DESCRIPTION	APP. BY	DATE
P	RRG	10/31/12	ADDED HVAC PLATE ASSEMBLY & UPDATED DETAIL	LJL	10/31/12
N	RRG	6/13/12	CHANGED CONDUIT SIZE/ADDED CIRCUIT CALLOUTS/ CORRECTED NOTES	LJL	6/13/12
M	JJ	11/09/11	ADDED DETAIL	LJL	11/09/11

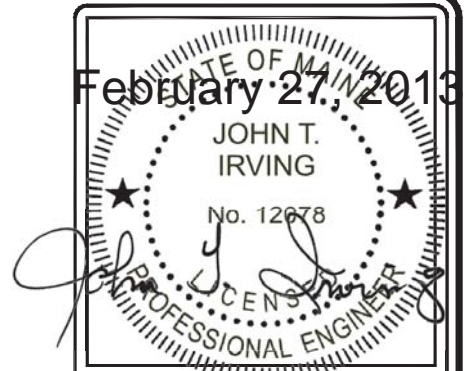

THIS DRAWING IS THE CONFIDENTIAL PROPERTY AND CONTAINS TRADE SECRETS OF CELLXION, LLC. ANY USE OF THESE DRAWINGS OR THE INFORMATION CONTAINED HEREIN FOR ANY REASON OTHER THAN AS EXPRESSLY AUTHORIZED BY SABRE INDUSTRIES, INC. IS STRICTLY PROHIBITED. THIS DRAWING HAS BEEN DISTRIBUTED WITH THE UNDERSTANDING THAT ANYONE RECEIVING OR OTHERWISE OBTAINING POSSESSION OF IT WILL BE EXPRESSLY NOTIFIED OF ITS CONFIDENTIAL NATURE.

**cellxion**


5031 Hazel Jones Road  
Bossier City, Louisiana 71111  
voice: (318) 213-2900  
fax: (318) 213-2919  
www.cellxion.com

CUSTOMER:  
KELLOGG  
BROWN & ROOT  
FEMA (PEP)  
EXPANSION PROGRAM

PROJECT:  
10'-0" X 18'-0"  
CONCRETE SHELTER  
INTERIOR ELEVATION  
"B" PRE-HEMP

FILENAME: KBR/SKBRO2	
SCALE: 1/2"=1'-0"	TOLERANCE:
DRWN. BY: M. FOWLER	DATE: 03/24/2010
CHK. BY: V. HASSELL	DATE: 03/24/2010
ENG. BY:	DATE:
APP. BY: A. DUMAS	DATE: 03/24/2010
SHEET NO. 4-2	
DRAWING NO.:	REV.:
SKBR02	P

SUB-PARTS LIST			
ITEM	P/N	DESCRIPTION	CUT
196	540009	GROUND STRAP FLAT COPPER 4"WX100'L	108"

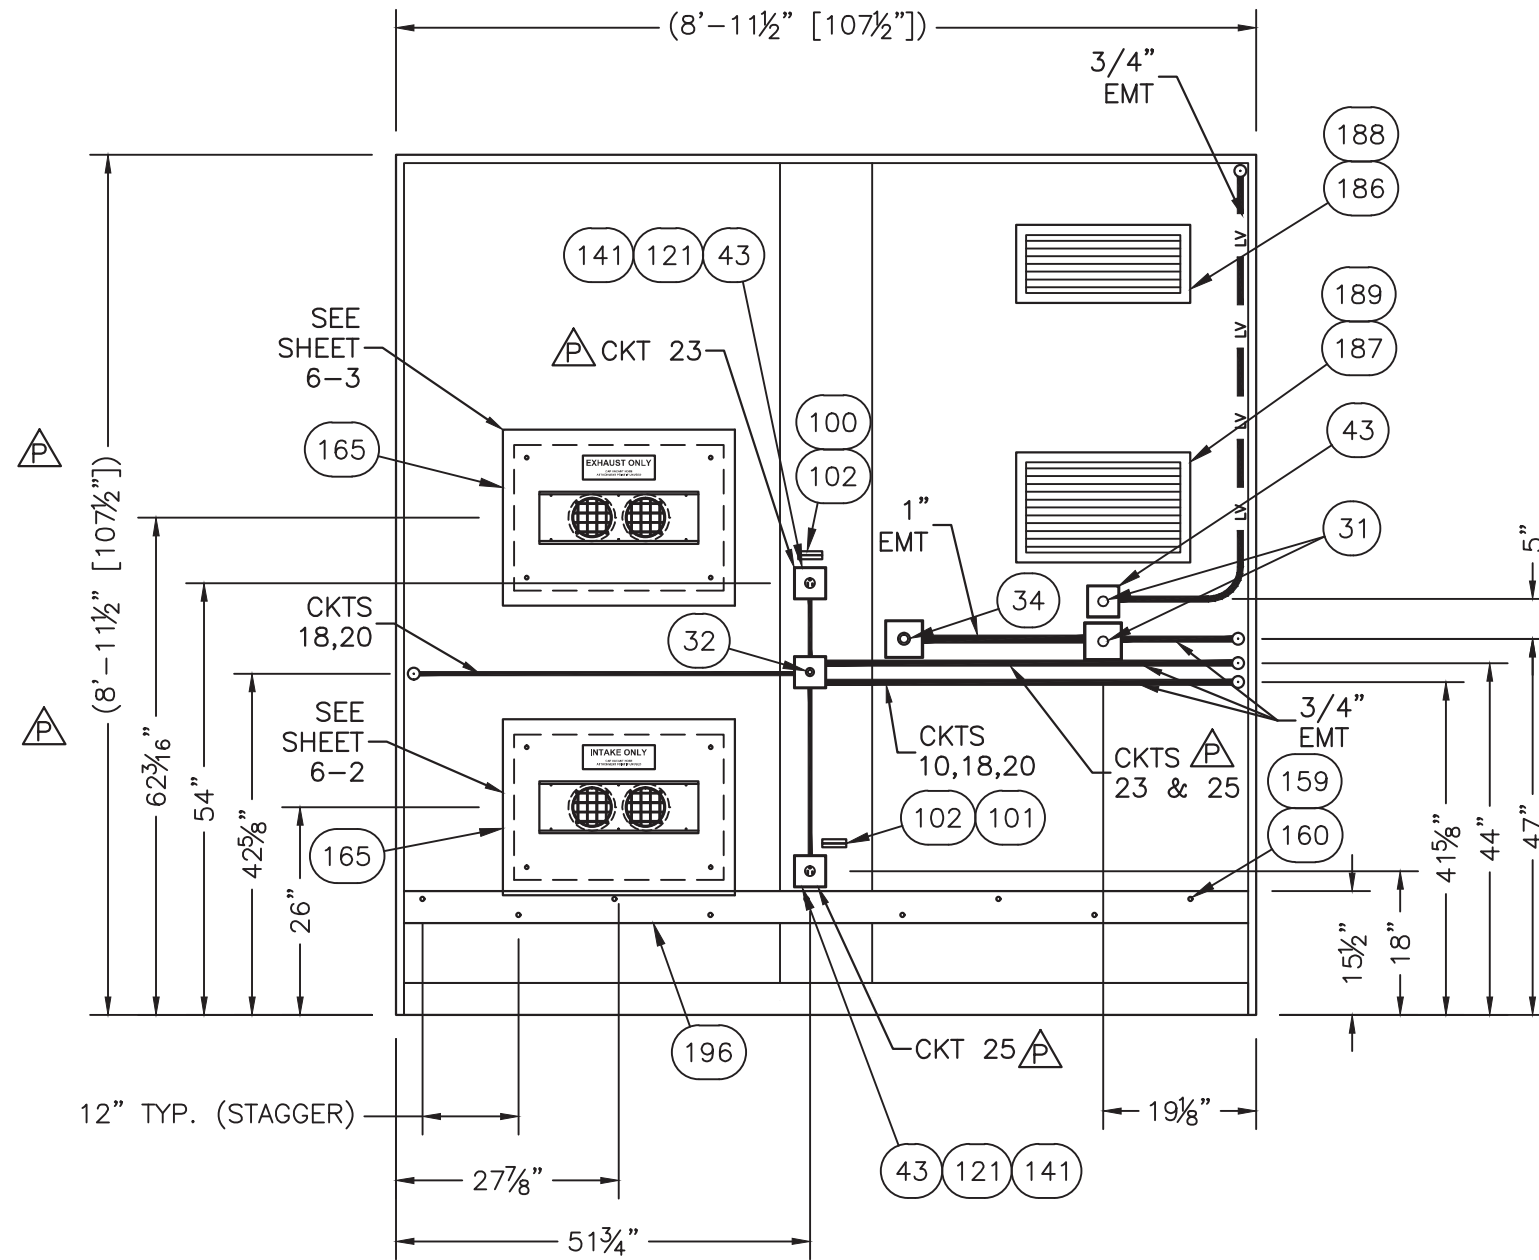


INTERIOR ELEVATION "B"  
(SHOWN IN POST-HEMP ASSEMBLY)

NOTE:

- LUG 3" OF WIRE TO STRAP.
- LABEL CIRCUIT NO. ON ALL OUTLETS.

REV	BY	DATE	DESCRIPTION	APP. BY	DATE
P	RRG	10/31/12	ADDED SHEET, CHANGED HVAC RECEPTACLE	LJL	10/31/12

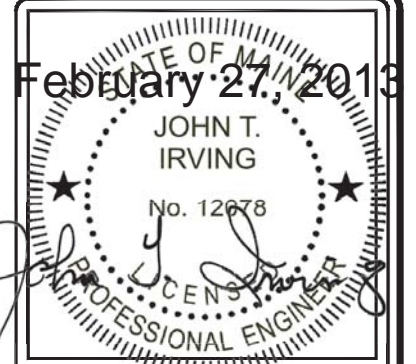

THIS DRAWING IS THE CONFIDENTIAL PROPERTY AND CONTAINS TRADE SECRETS OF CELLXION, LLC. ANY USE OF THESE DRAWINGS OR THE INFORMATION CONTAINED HEREIN FOR ANY REASON OTHER THAN AS EXPRESSLY AUTHORIZED BY SABRE INDUSTRIES, INC. IS STRICTLY PROHIBITED. THIS DRAWING HAS BEEN DISTRIBUTED WITH THE UNDERSTANDING THAT ANYONE RECEIVING OR OTHERWISE OBTAINING POSSESSION OF IT WILL BE EXPRESSLY NOTIFIED OF ITS CONFIDENTIAL NATURE.


**cellxion**  
 5031 Hazel Jones Road  
 Bossier City, Louisiana 71111  
 voice: (318) 213-2900  
 fax: (318) 213-2919  
 www.cellxion.com

CUSTOMER:  
**KELLOGG  
 BROWN & ROOT  
 FEMA (PEP)  
 EXPANSION PROGRAM**

PROJECT:  
**10'-0" X 18'-0"  
 CONCRETE SHELTER  
 INTERIOR ELEVATION  
 "B" POST-HEMP**

FILENAME: KBR/SKBR02	
SCALE: 1/2"=1'-0"	TOLERANCE:
DRWN. BY: M. FOWLER	DATE: 03/24/2010
CHK. BY: V. HASSELL	DATE: 03/24/2010
ENG. BY:	DATE:
APP. BY: A. DUMAS	DATE: 03/24/2010
SHEET NO. 4-2A	
DRAWING NO.: SKBR02	REV.: P


SUB-PARTS LIST			
ITEM	P/N	DESCRIPTION	CUT
196	540009	GROUND STRAP FLAT COPPER 4"WX100'L	108"

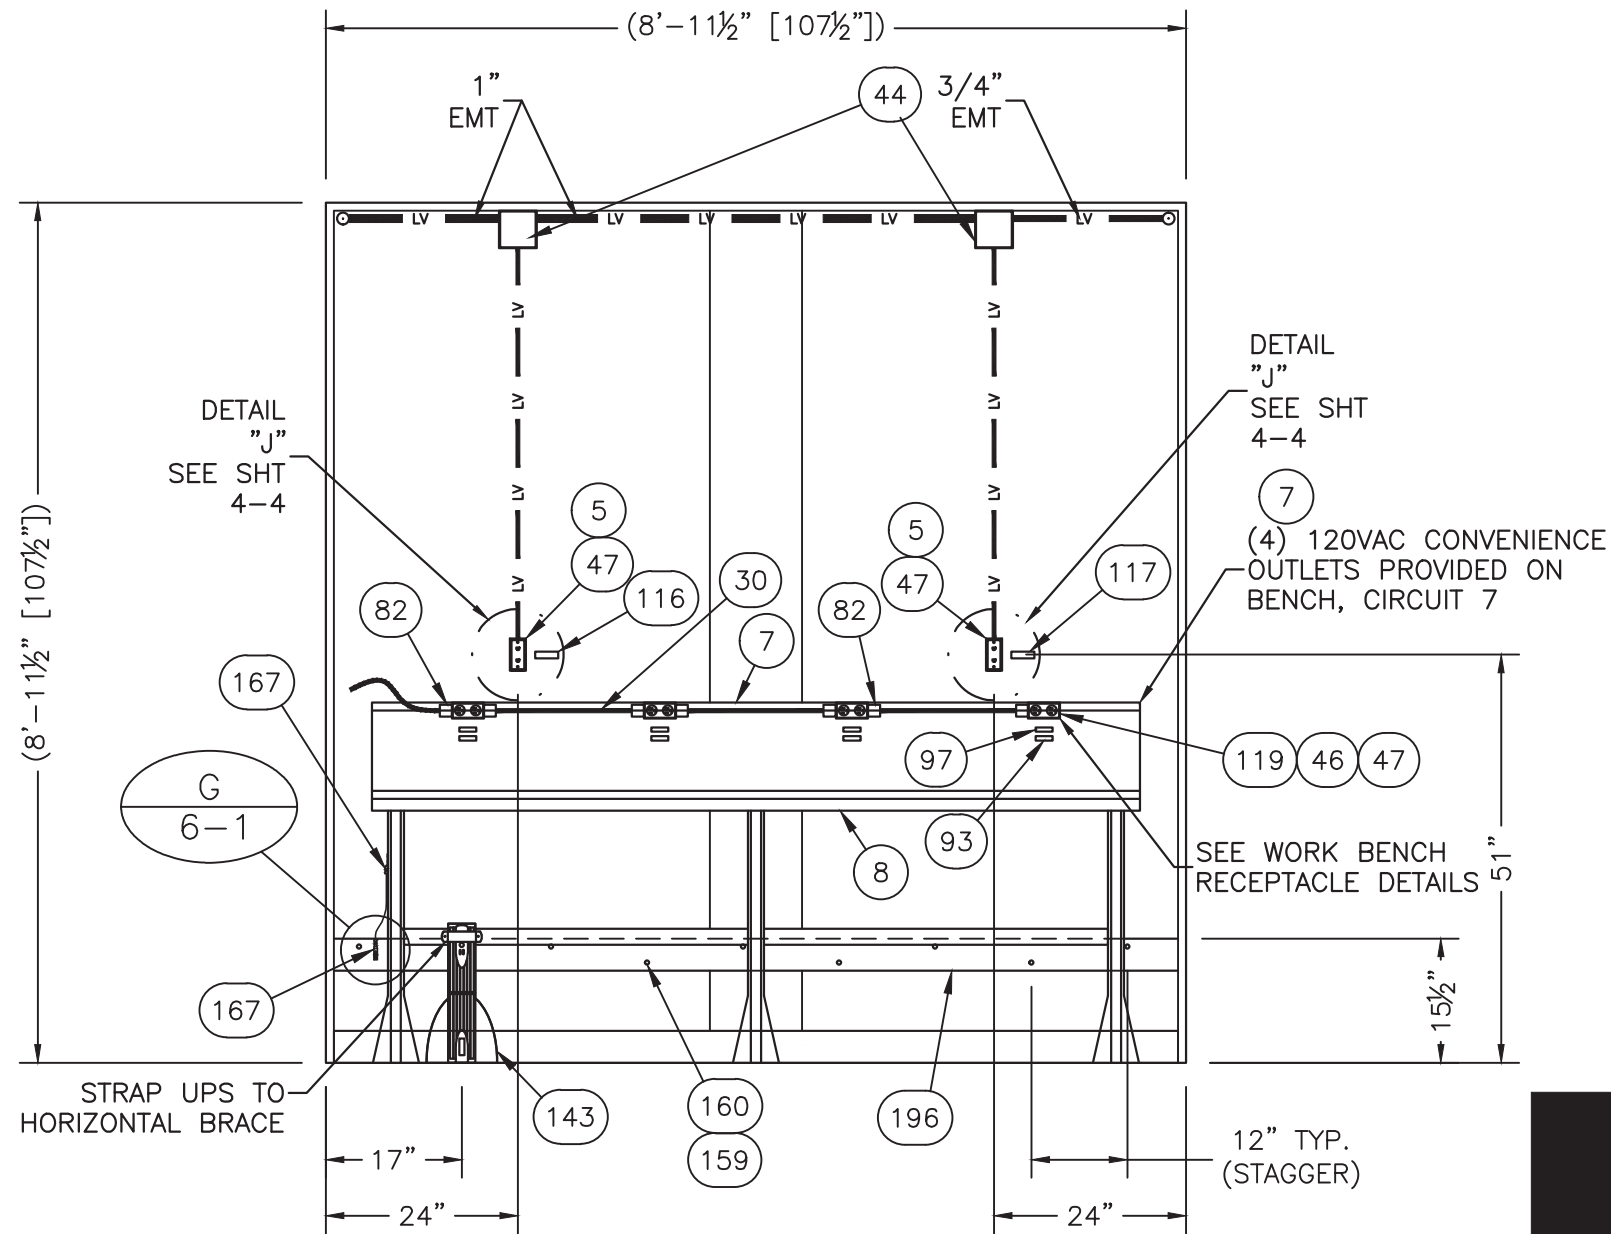


INTERIOR ELEVATION "D"

NOTE:

- LUG 3" OF WIRE TO STRAP.
- LABEL CIRCUIT NO. ON ALL OUTLETS.
- ALL COMPUTER/PHONE LINES CROSS CONNECT WIRING WILL BE COMPLETED AT THE STATION TELEPHONE BACKBOARD. 16 PAIRS MINIMUM TO BE CARRIED OVER TO STATION BACKBOARD (BY OTHERS).
- CONNECT EACH RJ11/RJ45 DATA/PHONE JACK WITH TWO CAT5 CABLES AND RUN BACK TO CIRCA ALARM BLOCK (SEE SHEET 5-4).

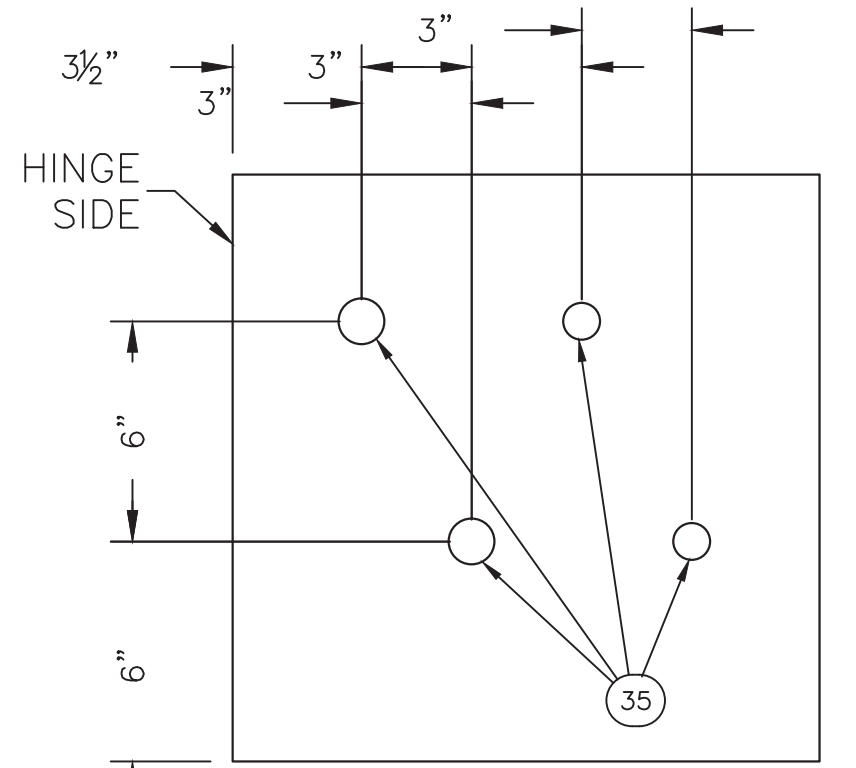


BOX PENETRATIONS DETAILS  
SEE SHEET 4-1B  
N.T.S.

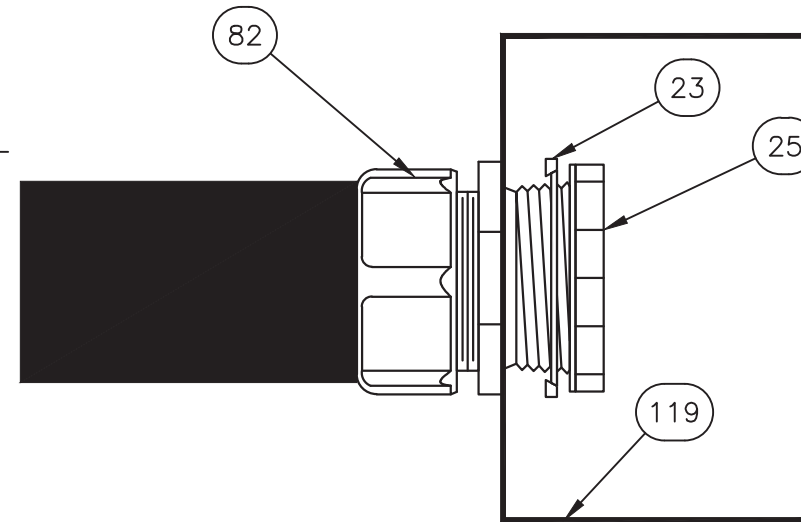

WORK BENCH RECEPTACLE DETAILS  
N.T.S.

REV	BY	DATE	DESCRIPTION	APP. BY	DATE
N	RRG	6/13/12	ADDED UPS/CORRECTED NOTES	LJL	6/13/12
M	JJ	11/09/11	ADDED DETAILS TO SHEET	LJL	11/09/11
J	AMM	02/10/11	UPDATED DETAILS AND DESCRIPTION	LJL	02/10/11

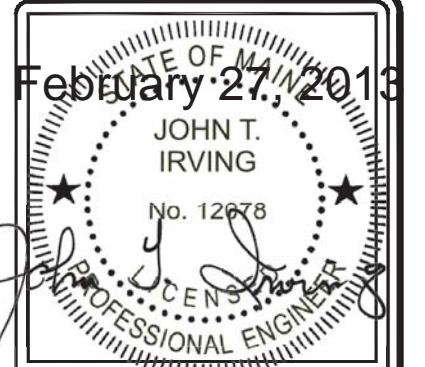


THIS DRAWING IS THE CONFIDENTIAL PROPERTY AND CONTAINS TRADE SECRETS OF CELLIXION, LLC. ANY USE OF THESE DRAWINGS OR THE INFORMATION CONTAINED HEREIN FOR ANY REASON OTHER THAN AS EXPRESSLY AUTHORIZED BY SABRE INDUSTRIES, INC. IS STRICTLY PROHIBITED. THIS DRAWING HAS BEEN DISTRIBUTED WITH THE UNDERSTANDING THAT ANYONE RECEIVING OR OTHERWISE OBTAINING POSSESSION OF IT WILL BE EXPRESSLY NOTIFIED OF ITS CONFIDENTIAL NATURE.

**Cellixion**  
5031 Hazel Jones Road  
Bossier City, Louisiana 71111  
voice: (318) 213-2900  
fax: (318) 213-2919  
www.cellixion.com

CUSTOMER:  
**KELLOGG  
BROWN & ROOT  
FEMA (PEP)  
EXPANSION PROGRAM**


PROJECT:  
**10'-0" X 18'-0"  
CONCRETE SHELTER  
INTERIOR ELEVATION  
"D"**

FILENAME: KBR/SKBR02	
SCALE: 1/2"=1'-0"	TOLERANCE:
DRWN. BY: M. FOWLER	DATE: 03/24/2010
CHK. BY: V. HASSELL	DATE: 03/24/2010
ENG. BY:	DATE:
APP. BY: A. DUMAS	DATE: 03/24/2010
SHEET NO. 4-3	
DRAWING NO.:	REV.:
SKBR02	P

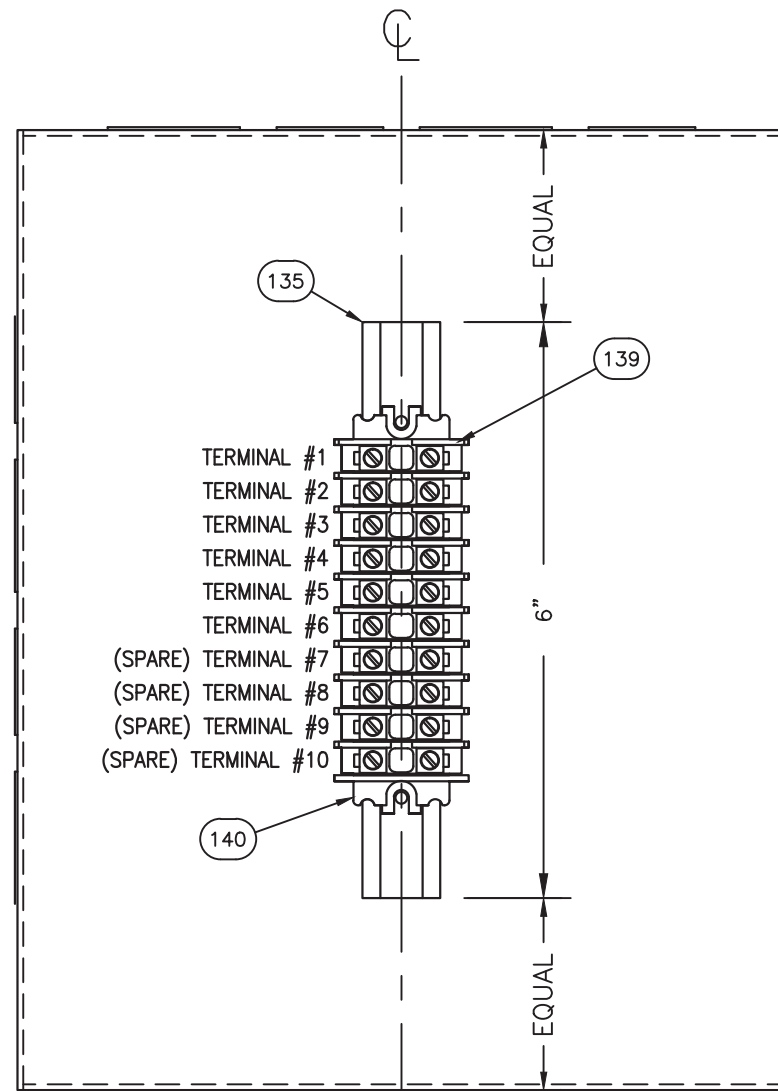


DETAIL "L"

NOTE: SEE SHEET 5-1 FOR ALARM TERMINATION  
"BACKPLATE SHOWN FOR TERMINAL STRIP MOUNTING."

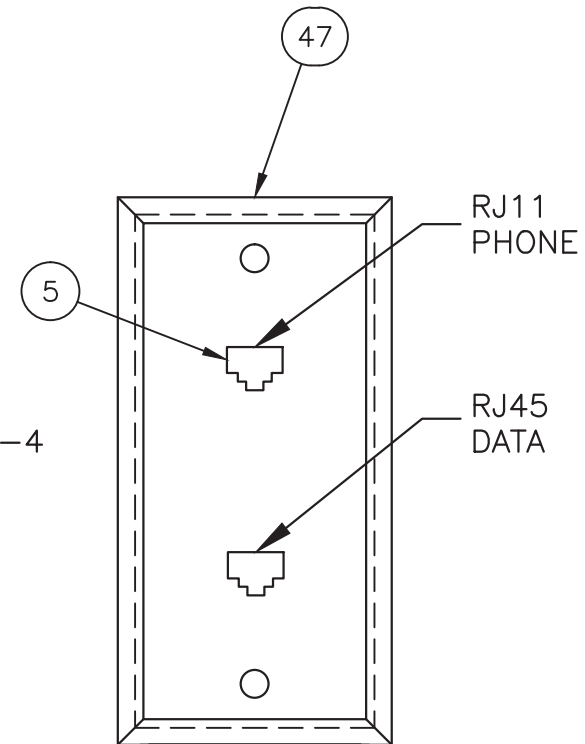


DETAIL "J"

NOTE:  
SEE SHEET 5-4

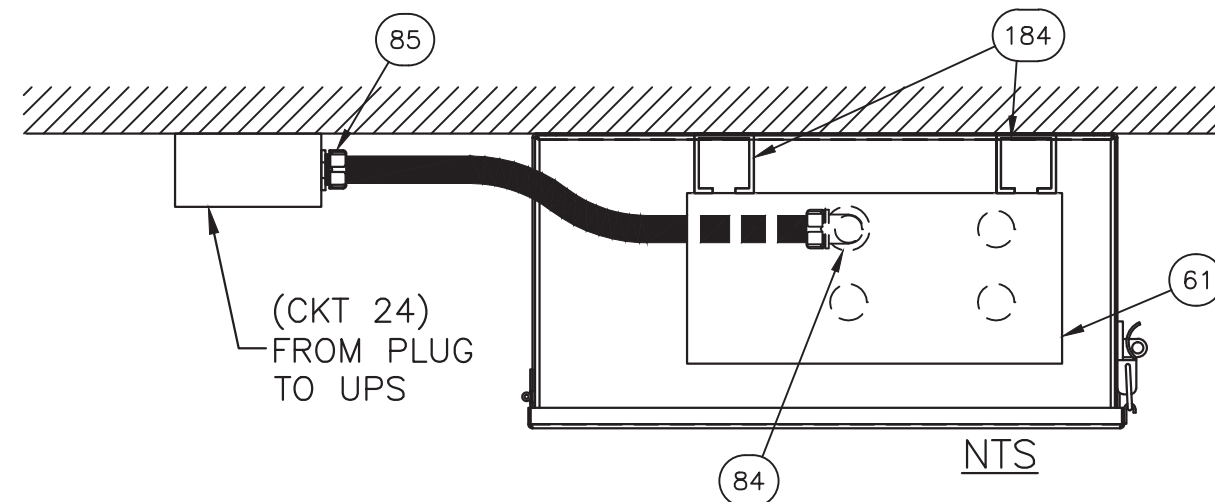

SECTION H-H

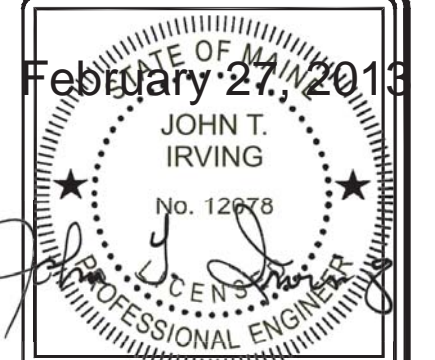

THIS DRAWING IS THE CONFIDENTIAL PROPERTY AND CONTAINS TRADE SECRETS OF CELLXION, LLC. ANY USE OF THESE DRAWINGS OR THE INFORMATION CONTAINED HEREIN FOR ANY REASON OTHER THAN AS EXPRESSLY AUTHORIZED BY SABRE INDUSTRIES, INC. IS STRICTLY PROHIBITED. THIS DRAWING HAS BEEN DISTRIBUTED WITH THE UNDERSTANDING THAT ANYONE RECEIVING OR OTHERWISE OBTAINING POSSESSION OF IT WILL BE EXPRESSLY NOTIFIED OF ITS CONFIDENTIAL NATURE.

**cellxion**  
5031 Hazel Jones Road  
Bossier City, Louisiana 71111  
voice: (318) 213-2900  
fax: (318) 213-2919  
www.cellxion.com

CUSTOMER:  
**KELLOGG  
BROWN & ROOT  
FEMA (PEP)  
EXPANSION PROGRAM**

PROJECT:  
**10'-0" X 18'-0"  
CONCRETE SHELTER  
TERMINATION  
DETAIL**

FILENAME: KBR/SKBRO2	
SCALE: N.T.S.	TOLERANCE:
DRWN. BY: M. FOWLER	DATE: 03/24/2010
CHK. BY: V. HASSELL	DATE: 03/24/2010
ENG. BY:	DATE:
APP. BY: A. DUMAS	DATE: 03/24/2010


SHEET NO.  
4-4

DRAWING NO.:  
SKBR02

REV.:  
P

REV	BY	DATE	DESCRIPTION	APP. BY	DATE
N	JWR	6/29/12	CORRECTED DETAIL "B"	LJL	6/29/12
N	RRG	6/13/12	CORRECTED NOTES AND DETAILS	LJL	6/13/12
M	JJ	11/09/11	SHEET WAS ADDED	LJL	11/09/11



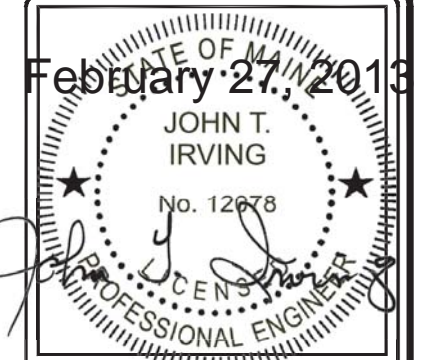

THIS DRAWING IS THE CONFIDENTIAL PROPERTY AND CONTAINS TRADE SECRETS OF CELLXION, LLC. ANY USE OF THESE DRAWINGS OR THE INFORMATION CONTAINED HEREIN FOR ANY REASON OTHER THAN AS EXPRESSLY AUTHORIZED BY SABRE INDUSTRIES, INC. IS STRICTLY PROHIBITED. THIS DRAWING HAS BEEN DISTRIBUTED WITH THE UNDERSTANDING THAT ANYONE RECEIVING OR OTHERWISE OBTAINING POSSESSION OF IT WILL BE EXPRESSLY NOTIFIED OF ITS CONFIDENTIAL NATURE.

**cellxion**  
 5031 Hazel Jones Road  
 Bossier City, Louisiana 71111  
 voice: (318) 213-2900  
 fax: (318) 213-2919  
 www.cellxion.com

CUSTOMER:  
**KELLOGG  
 BROWN & ROOT  
 FEMA (PEP)  
 EXPANSION PROGRAM**

PROJECT:  
**10'-0" X 18'-0"  
 CONCRETE SHELTER  
 ELECTRICAL SCHEMATIC**


FILENAME: KBR/SKBR02	
SCALE: N.T.S.	TOLERANCE:
DRWN. BY: M. FOWLER	DATE: 03/24/2010
CHK. BY: V. HASSELL	DATE: 03/24/2010
ENG. BY:	DATE:
APP. BY: A. DUMAS	DATE: 03/24/2010
SHEET NO. 5-0	
DRAWING NO.:	REV.:
SKBR02	P

**CONDUIT NOTE:**  
 1. DO NOT USE REDUCING WASHERS AT ANY BOX CONNECTION.

**WIRING NOTE:**  
 1. "ALL" WIRES TO BE LABELED WITH SOURCE AND DESTINATION USING PANDUIT LABELS.  
 2. IDENTIFY HOT & NEUTRAL CONDUCTORS WITH CIRCUIT NUMBERS.


**NOTE:**

1. LABEL EACH END OF WIRING "L1", "L2", "L3" OR "N" AS APPROPRIATE.
2. EACH CIRCUIT SHALL HAVE A DEDICATED NEUTRAL AS REQUIRED BY NEC.
3. INCOMING POWER ON L1, L2, L3, MUST CONNECT THROUGH MASTER CIRCUIT BREAKER-CATS 1, 3, 5
4. INSTALL PLASTIC BUSHINGS ON EACH END OF EVERY NIPPLE.
5. INSTALLED BY CELLXION FIELD SERVICES
6. MARK BREAKER RED & PRINT IN RED INK ON PANEL SCHEDULE

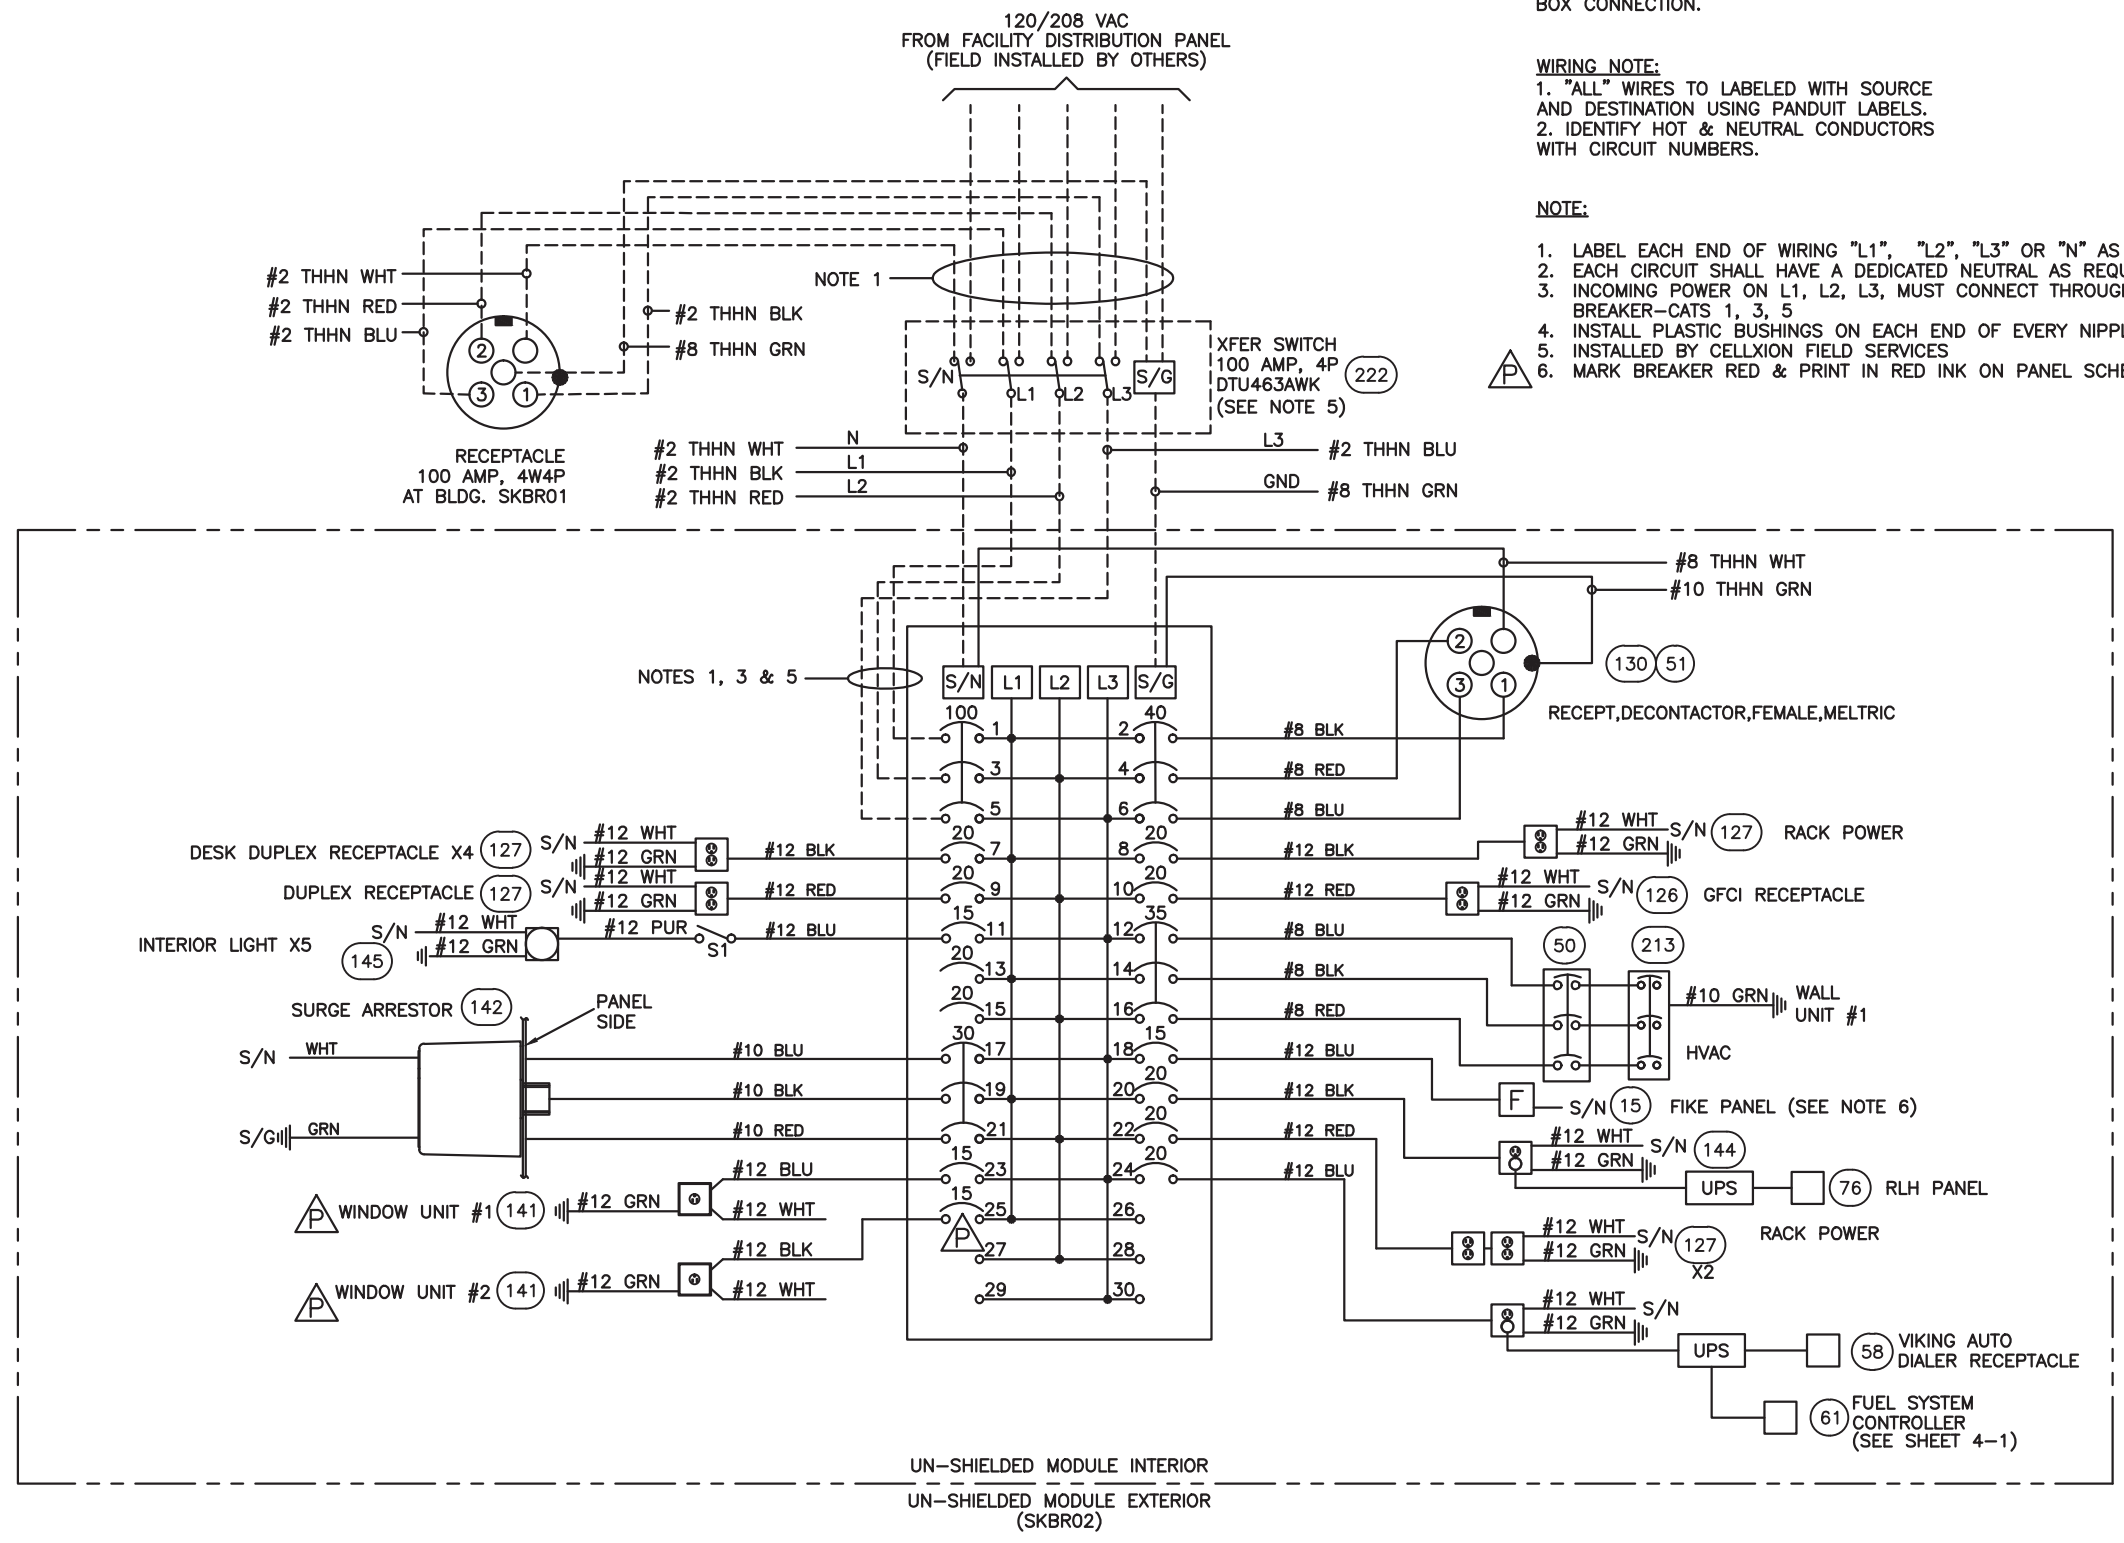

REV	BY	DATE	DESCRIPTION	APP. BY	DATE
P	RRG	10/31/12	REMOVED WIRE FROM WINDOW UNIT CIRCUIT/CHANGED BREAKERS & POSITION, ADDED NOTE 6	LJL	10/31/12
N	RRG	6/13/12	ADDED UPS/CHANGED BREAKER/ADDED NOTE GENERATOR RECEPTACLE WIRING NOW BY OTHERS	LJL	6/13/12
M	LJL	1/3/12	ADDED NOTE 5	LJL	1/3/12
L	RRG	04/21/11	ADDED BUBBLES & NOTES	LJL	04/21/11


# SKBR01 ALARMS TO TX CONTACTS FOR REFERENCE

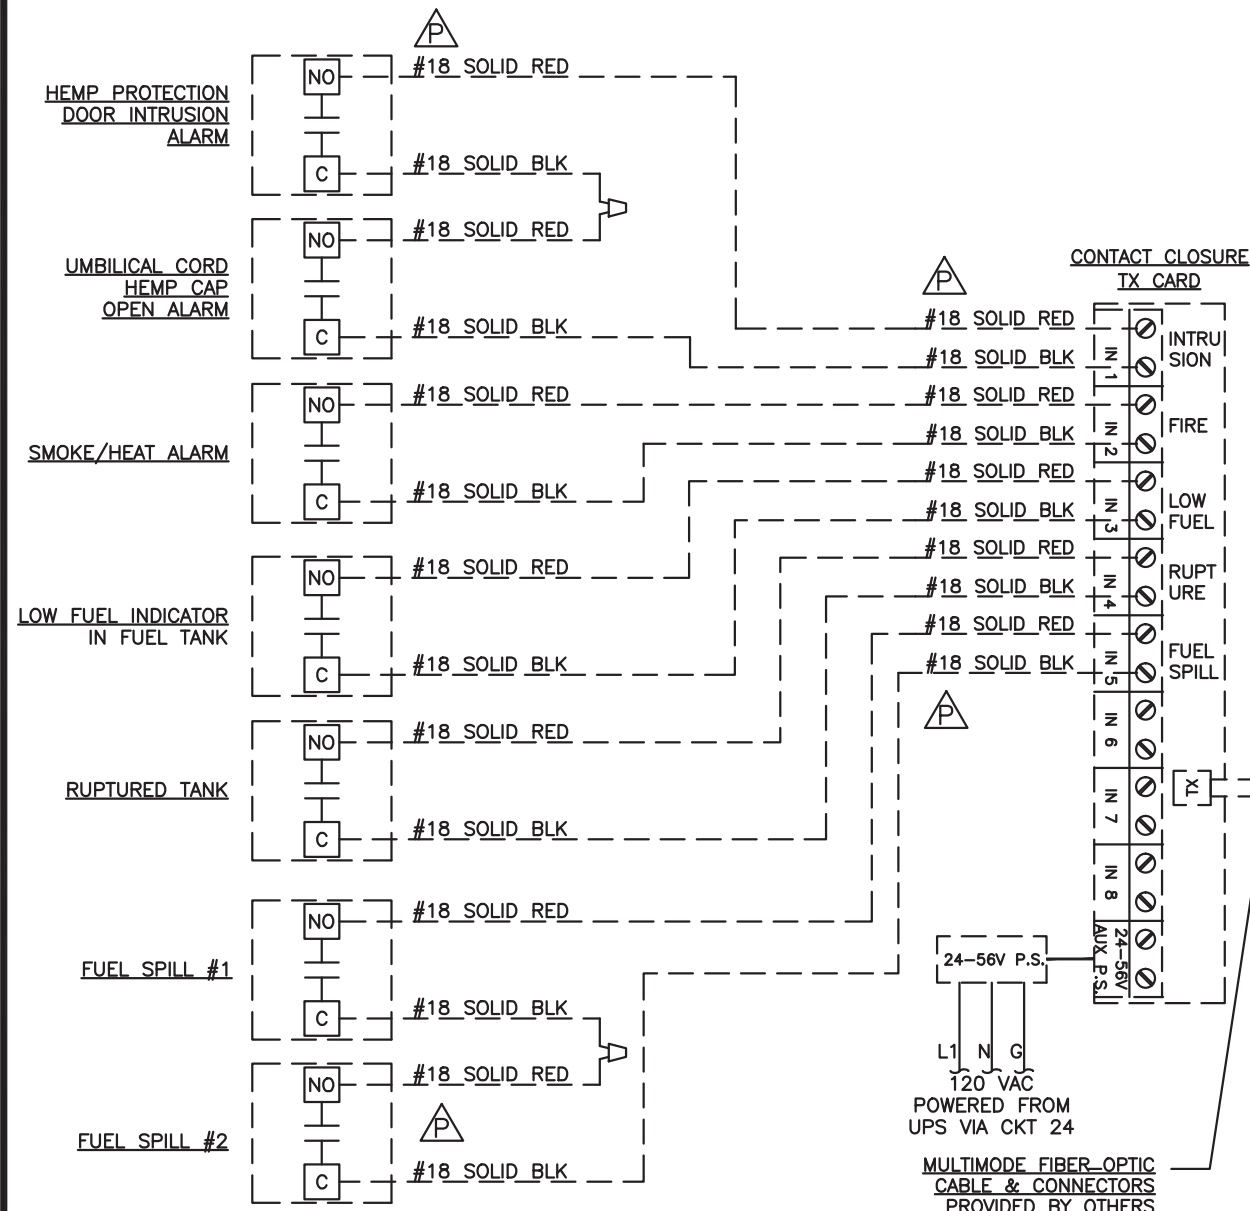

### SHELTER ALARM NOTES:

1. WIRE TO BE 22 AWG, 2 CONDUCTOR, SHIELDED ALARM WIRE, P/N 400011.
2. CONTACTS SHOULD BE OPEN IN FAIL SAFE POSITION (SHELF POSITION) WHEN NO POWER IS APPLIED.
3. ALL WIRING SHALL BE TERMINATED TO THE NORMALLY OPEN CONTACT. DURING NORMAL OPERATION THE CONTACT WILL CHANGE STATE TO NC- ALARM CONDITIONS:
  - 1)UPSET CONDITION-DOOR OR CAP OPEN,HEAT ABOVE SET POINT,SMOKE,LOW FUEL,TANK RAPTURE, FUEL SPILL.
  - 2)LOSS OF POWER-TRIPPED OCPD,UTILITY POWER OFF.
  - 3)CUT OR DISCONNECTED WIRE.
4. ALL WIRES SHOULD BE LABELED AT EACH END WITH SOURCE AND DESTINATION (TERMINATION # & ITEM #)
5. MOVE 4.3K RESISTOR FROM FIKE ALARM INPUT BOARD TO TERMINALS IN CONTACT CLOSURE CARD AS SHOWN.

# SKBR02

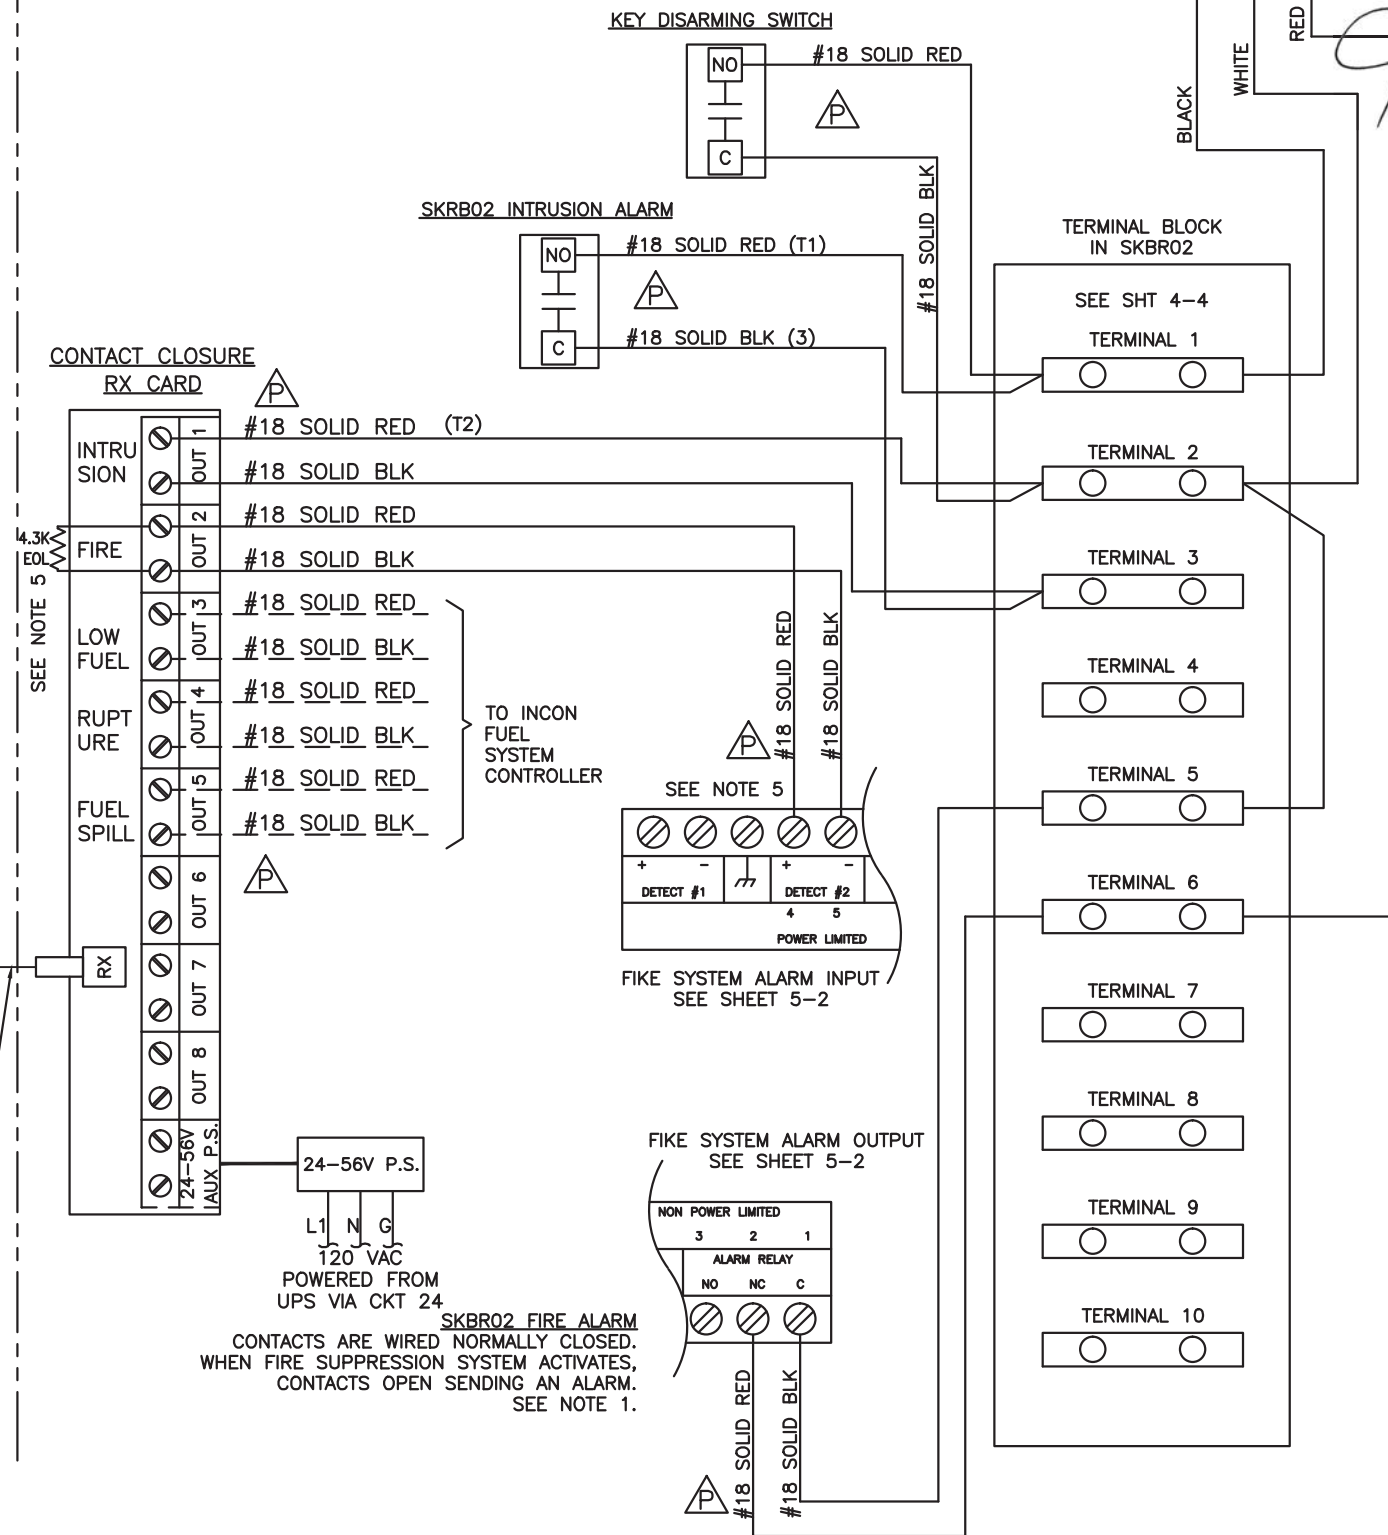

REV	BY	DATE	DESCRIPTION	APP. BY	DATE
P	RRG	10/31/12	CHANGED ALL #22 WIRE TO #18	LJL	10/31/12
N	RRG	6/13/12	ADDED NOTES/CORRECTED WIRE COLOR	LJL	6/13/12
M	JJ	11/09/11	ADDED NOTE TO TERMINAL BLOCK	LJL	11/09/11

58

CONTACTS AT  
VIKING PANEL  
(SEE SHEET 5-3)

February 27, 2013

JOHN T. IRVING  
No. 12678  
PROFESSIONAL ENGINEER

THIS DRAWING IS THE CONFIDENTIAL PROPERTY AND CONTAINS TRADE SECRETS OF CELLXION, LLC. ANY USE OF THESE DRAWINGS OR THE INFORMATION CONTAINED HEREIN FOR ANY REASON OTHER THAN AS EXPRESSLY AUTHORIZED BY SABRE INDUSTRIES, INC. IS STRICTLY PROHIBITED. THIS DRAWING HAS BEEN DISTRIBUTED WITH THE UNDERSTANDING THAT ANYONE RECEIVING OR OTHERWISE OBTAINING POSSESSION OF IT WILL BE EXPRESSLY NOTIFIED OF ITS CONFIDENTIAL NATURE.

**cellxion**


5031 Hazel Jones Road  
Bossier City, Louisiana 71111  
voice: (318) 213-2900  
fax: (318) 213-2919  
www.cellxion.com

CUSTOMER:  
**KELLOGG  
BROWN & ROOT  
FEMA (PEP)  
EXPANSION PROGRAM**

PROJECT:  
**10'-0" X 18'-0"  
CONCRETE SHELTER  
LOW VOLTAGE  
SCHEMATIC**

FILENAME: KBR/SKBR02	
SCALE: N.T.S.	TOLERANCE:
DRWN. BY: M. FOWLER	DATE: 03/24/2010
CHK. BY: V. HASSELL	DATE: 03/24/2010
ENG. BY:	DATE:
APP. BY: A. DUMAS	DATE: 03/24/2010
SHEET NO. 5-1	
DRAWING NO.:	REV.:
SKBR02	P

February 27, 2013

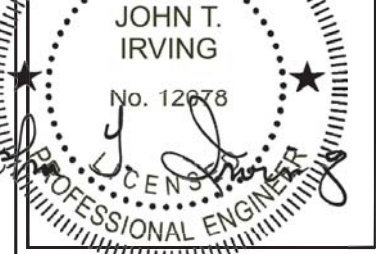


THIS DRAWING IS THE CONFIDENTIAL PROPERTY AND CONTAINS TRADE SECRETS OF CELLXION, LLC. ANY USE OF THESE DRAWINGS OR THE INFORMATION CONTAINED HEREIN FOR ANY REASON OTHER THAN AS EXPRESSLY AUTHORIZED BY SABRE INDUSTRIES, INC. IS STRICTLY PROHIBITED. THIS DRAWING HAS BEEN DISTRIBUTED WITH THE UNDERSTANDING THAT ANYONE RECEIVING OR OTHERWISE OBTAINING POSSESSION OF IT WILL BE EXPRESSLY NOTIFIED OF ITS CONFIDENTIAL NATURE.

**Cellxion**  
 5031 Hazel Jones Road  
 Bossier City, Louisiana 71111  
 voice: (318) 213-2900  
 fax: (318) 213-2919  
 www.cellxion.com

CUSTOMER:  
**KELLOGG  
 BROWN & ROOT  
 FEMA (PEP)  
 EXPANSION PROGRAM**


PROJECT:  
**10'-0" X 18'-0"  
 CONCRETE SHELTER  
 HVAC/FIKE SYSTEM  
 SCHEMATIC**

FILENAME: KBR/SKBRO2	
SCALE: N.T.S.	TOLERANCE:
DRWN. BY: M. FOWLER	DATE: 03/24/2010
CHK. BY: V. HASSELL	DATE: 03/24/2010
ENG. BY:	DATE:
APP. BY: A. DUMAS	DATE: 03/24/2010
SHEET NO. 5-2	
DRAWING NO.:	REV.:
SKBR02	P

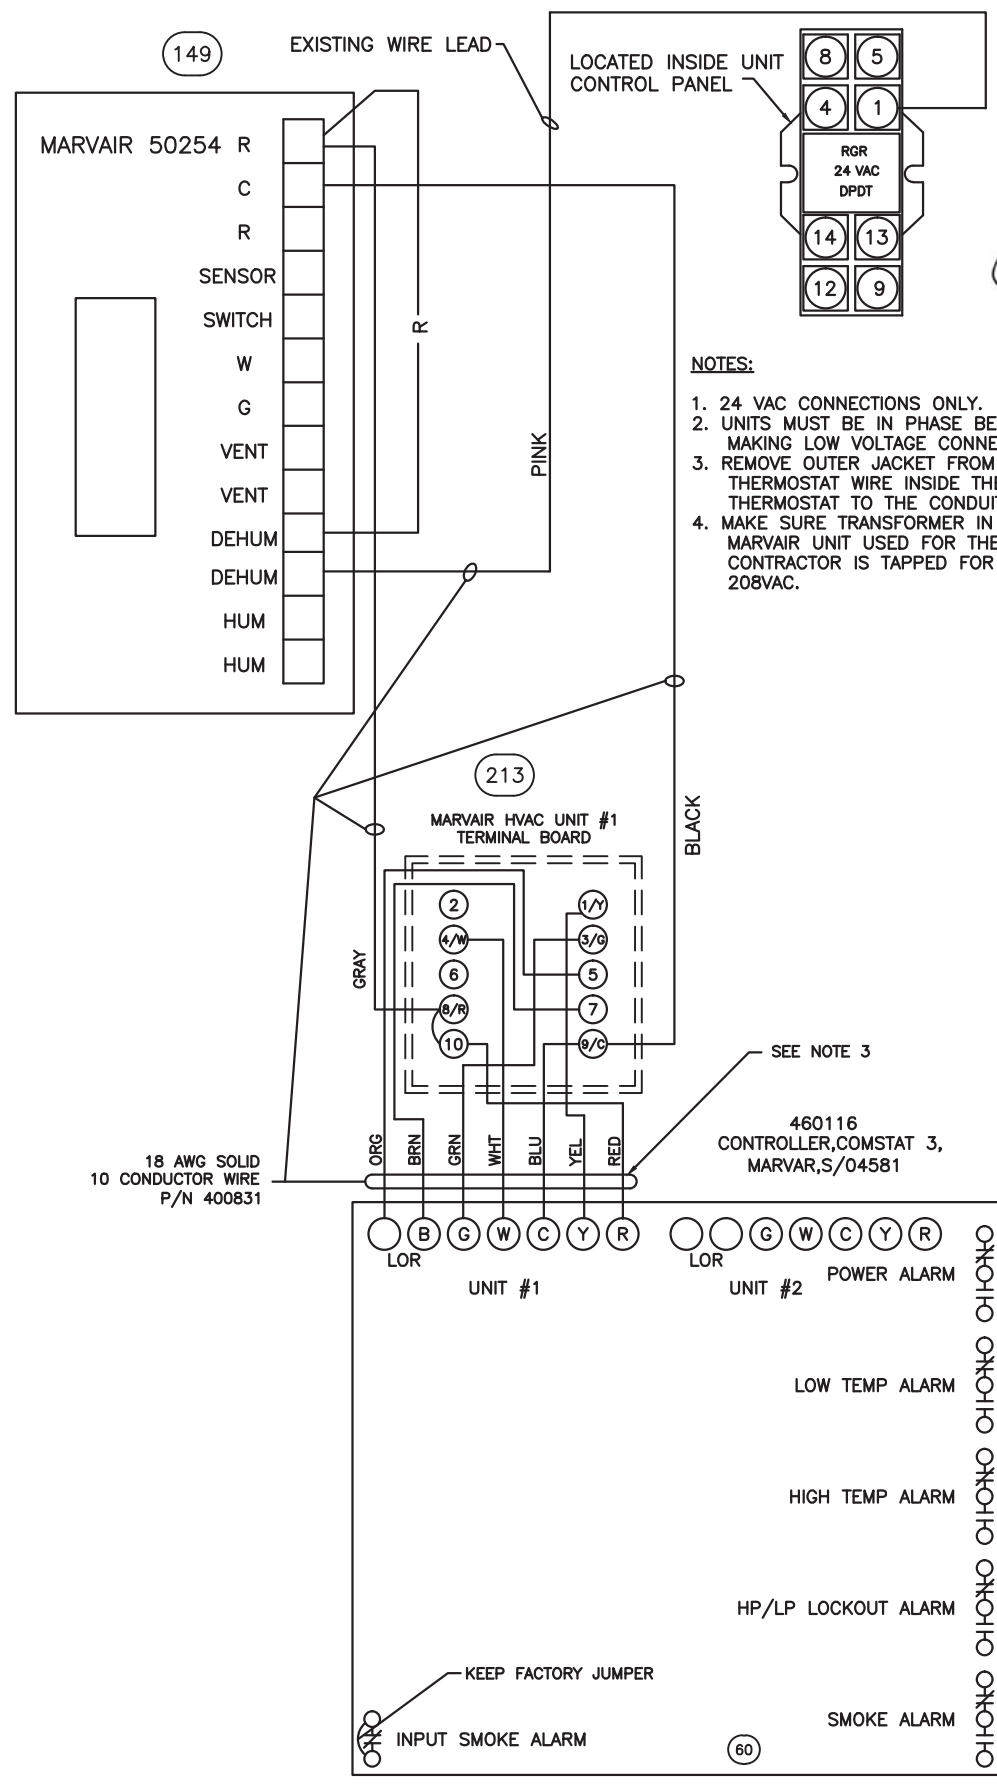


- NOTES:
- 24 VAC CONNECTIONS ONLY.
  - UNITS MUST BE IN PHASE BEFORE MAKING LOW VOLTAGE CONNECTIONS.
  - REMOVE OUTER JACKET FROM THERMOSTAT WIRE INSIDE THE THERMOSTAT TO THE CONDUIT.
  - MAKE SURE TRANSFORMER IN MARVAIR UNIT USED FOR THE CONTRACTOR IS TAPPED FOR 208VAC.

SEE DETAIL-1 BELOW

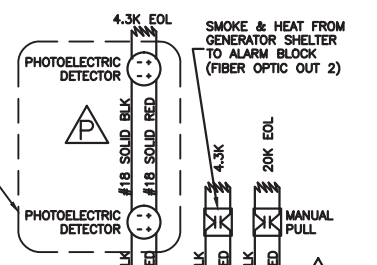


SEE SHEET 5-5 FOR DETAIL VIEW OF THIS BOARD

SEE ALSO SHEET 5-1 FOR RX CARD CONNECTIONS

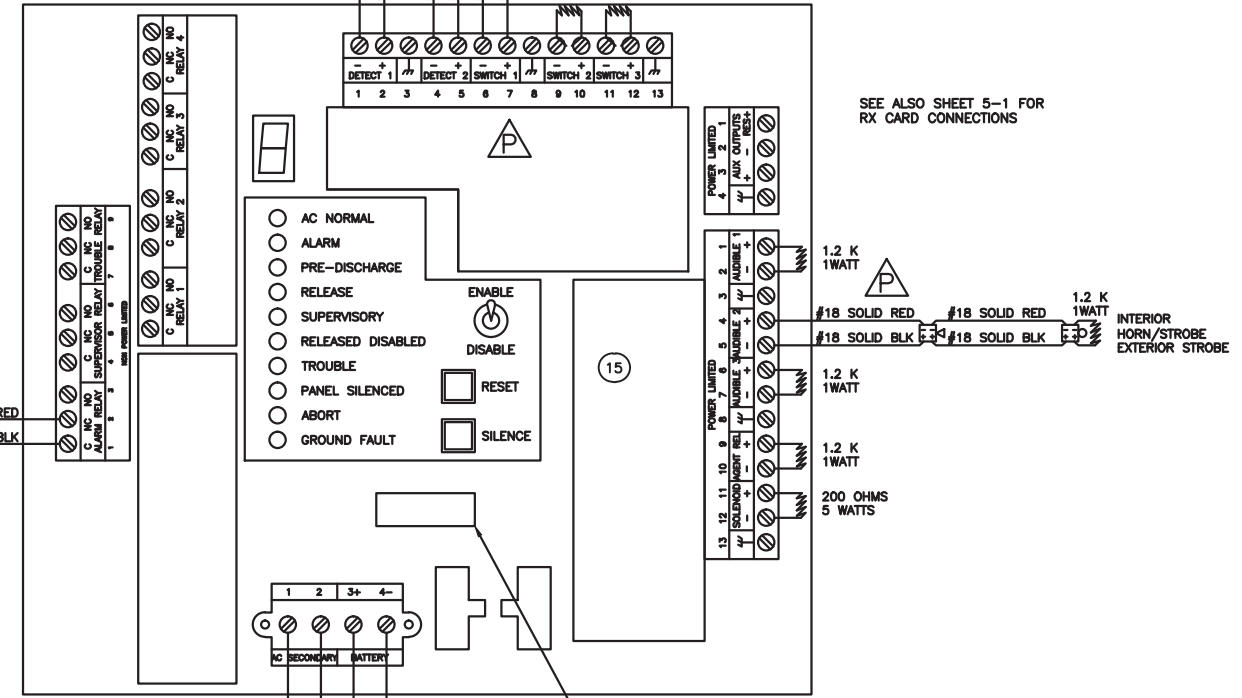

ALL DIP SWITCH SETTINGS TO "OFF" POSITION EXCEPT FOR SWITCHES 4 & 5 WHICH SHOULD BE SET TO "ON"


#12 WHT FROM AC PANEL  
 #12 BLK FROM AC PANEL  
 #12 GRN FROM AC PANEL  
 CHASSIS GROUND (EARTH) CONNECTION SHALL BE MADE DIRECTLY TO STANDOFF IN ENCLOSURE

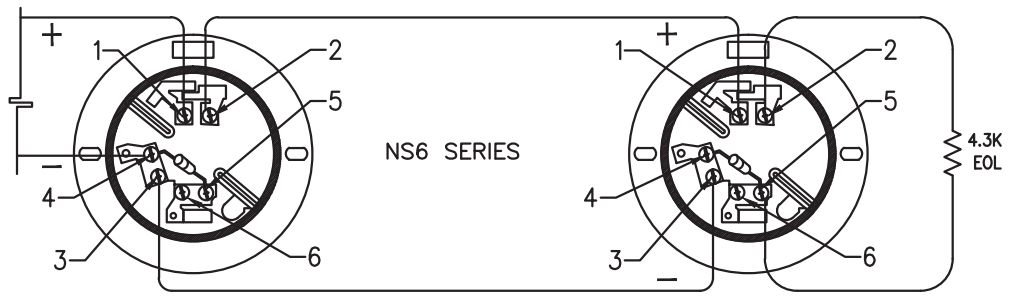

REV	BY	DATE	DESCRIPTION	APP. BY	DATE
P	RRG	10/31/12	CHANGED ALL #22 WIRE TO #18	LJL	10/31/12
N	RRG	6/13/12	CORRECTED FIKE PANEL TERMINALS/REMOVED SPLICE/CHANGED WIRE COLOR	LJL	6/13/12




AUTO DIALER  
P/N 440079

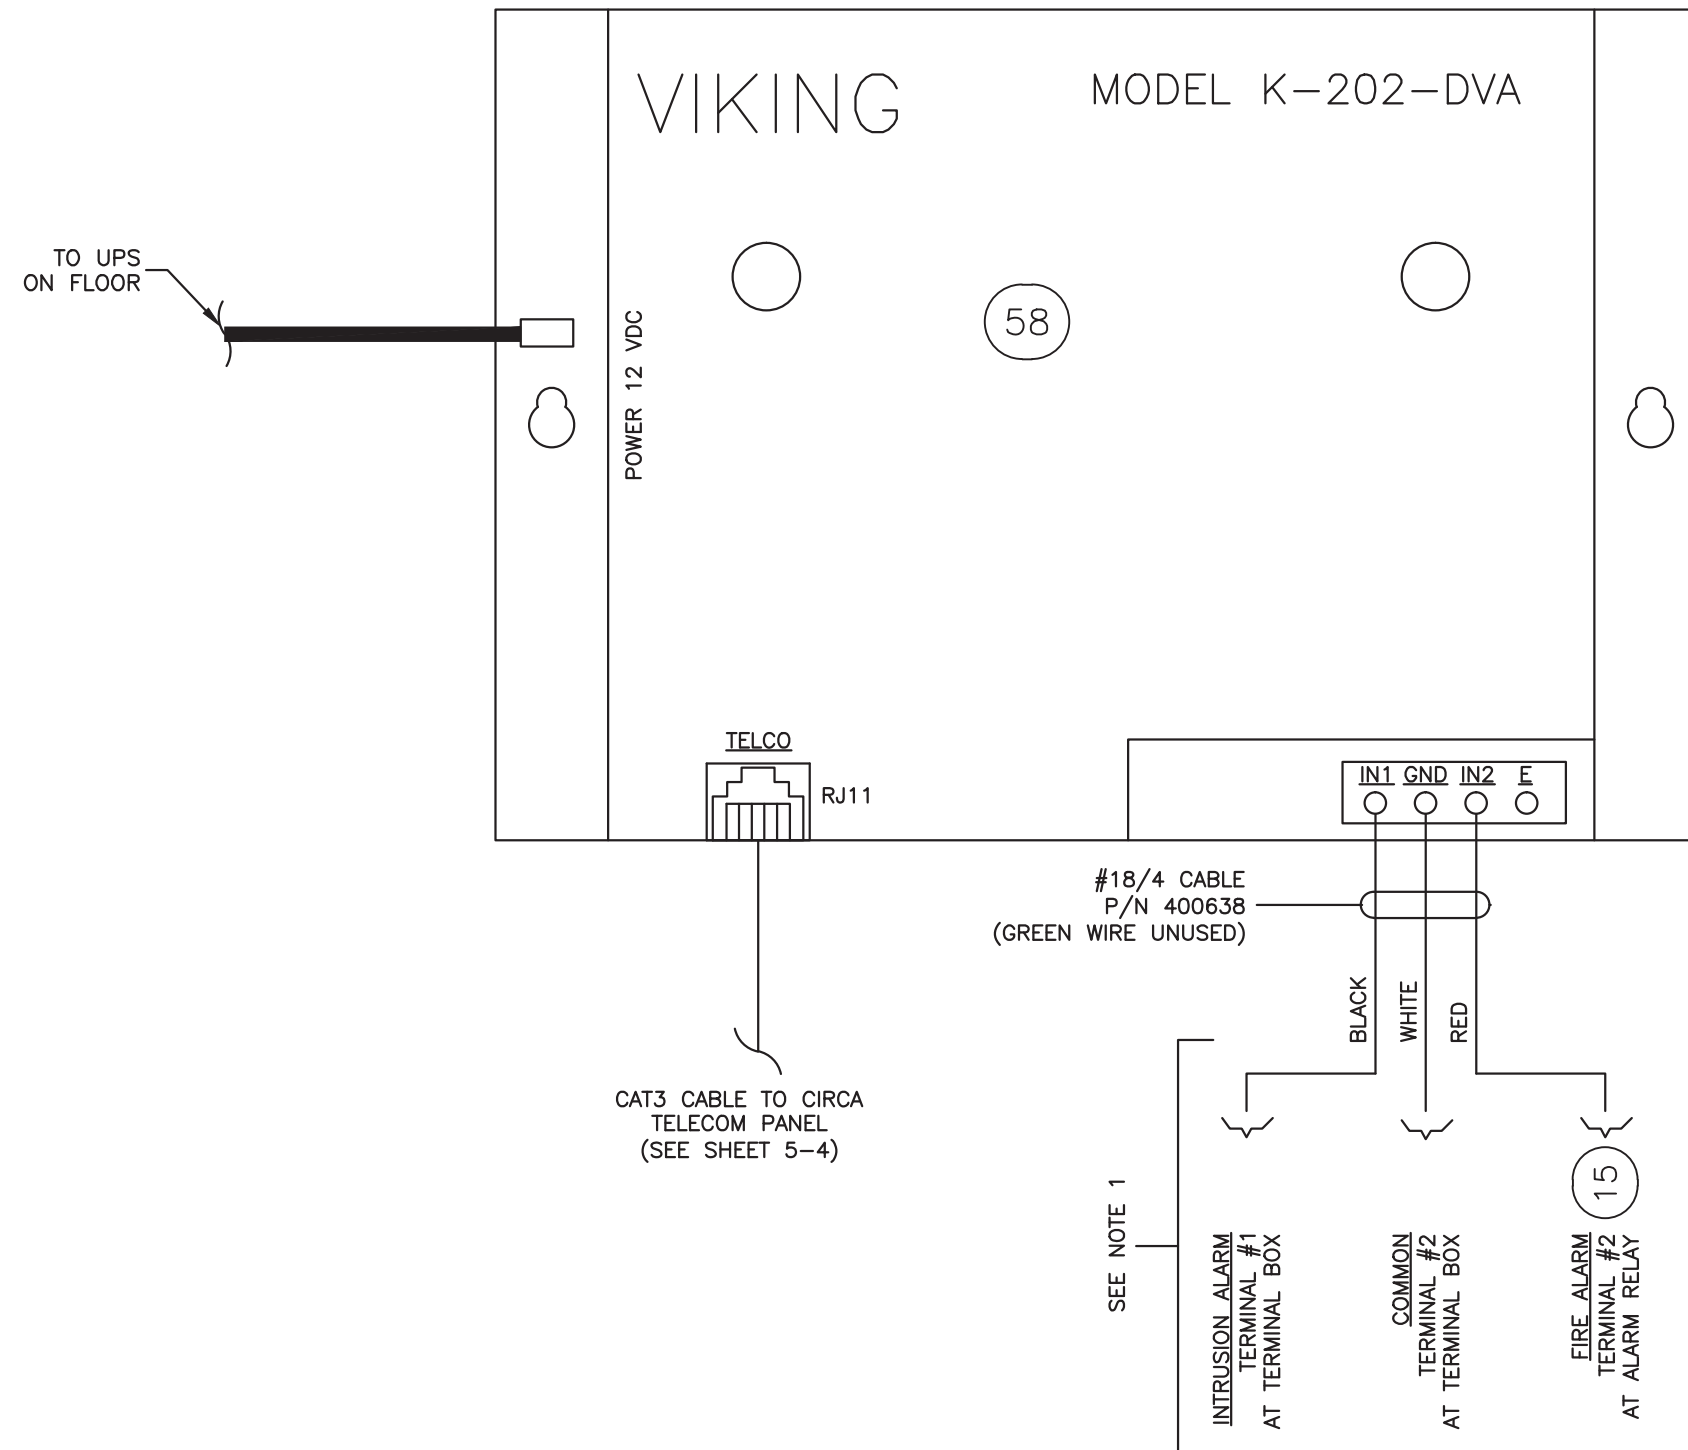

NOTE:

1. PULL ALARMS FROM TERMINAL BLOCK TO AUTO DIALER. THIS WIRING WILL TERMINATE REFERENCED ITEM DUE TO "COMMON" WIRE REQUIRED FROM BOTH SYSTEMS. SEE SHEET 5-1 FOR REFERENCED TERMINAL.
2. PROGRAMMING REQUIREMENT (SETUP) TO BE COMPLETED AT SITE.

REV	BY	DATE	DESCRIPTION	APP. BY	DATE
N	RRG	6/13/12	UPDATED DETAIL AND WIRE COLOR	LJL	6/13/12
M	LJL	1/3/12	ADDED CABLE TYPE FOR INPUTS	LJL	1/3/12
K	JJ	4/7/11	PER CUSTOMER MARKUPS	LJL	4/7/11
H	MST	01/21/11	PER CUSTOMER MARKUPS	WAR	01/21/11
F	MST	12/16/10	REVISED PER CUSTOMER MARKUPS	WAR	12/16/10
C	DJC	04/30/10	UPDATED AUTODIALER SCHEMATIC	GAB	04/30/10

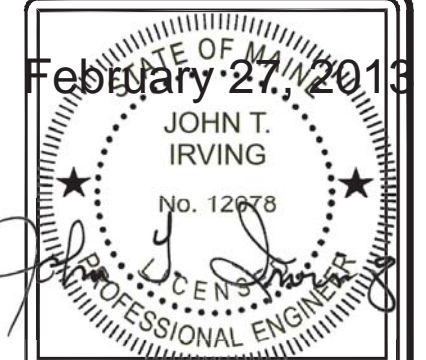

THIS DRAWING IS THE CONFIDENTIAL PROPERTY AND CONTAINS TRADE SECRETS OF CELLXION, LLC. ANY USE OF THESE DRAWINGS OR THE INFORMATION CONTAINED HEREIN FOR ANY REASON OTHER THAN AS EXPRESSLY AUTHORIZED BY SABRE INDUSTRIES, INC. IS STRICTLY PROHIBITED. THIS DRAWING HAS BEEN DISTRIBUTED WITH THE UNDERSTANDING THAT ANYONE RECEIVING OR OTHERWISE OBTAINING POSSESSION OF IT WILL BE EXPRESSLY NOTIFIED OF ITS CONFIDENTIAL NATURE.

**Cellxion**  
5031 Hazel Jones Road  
Bossier City, Louisiana 71111  
voice: (318) 213-2900  
fax: (318) 213-2919  
www.cellxion.com

CUSTOMER:  
**KELLOGG  
BROWN & ROOT  
FEMA (PEP)  
EXPANSION PROGRAM**


PROJECT:  
**10'-0" X 18'-0"  
CONCRETE SHELTER  
AUTODIALER  
SCHEMATIC**

FILENAME: KBR/SKBRO2	
SCALE: N.T.S.	TOLERANCE:
DRWN. BY: M. FOWLER	DATE: 03/24/2010
CHK. BY: V. HASSELL	DATE: 03/24/2010
ENG. BY:	DATE:
APP. BY: A. DUMAS	DATE: 03/24/2010
SHEET NO. 5-3	
DRAWING NO.:	REV.:
SKBR02	P



CIRCA TELECOM 1880ECA1-25


138

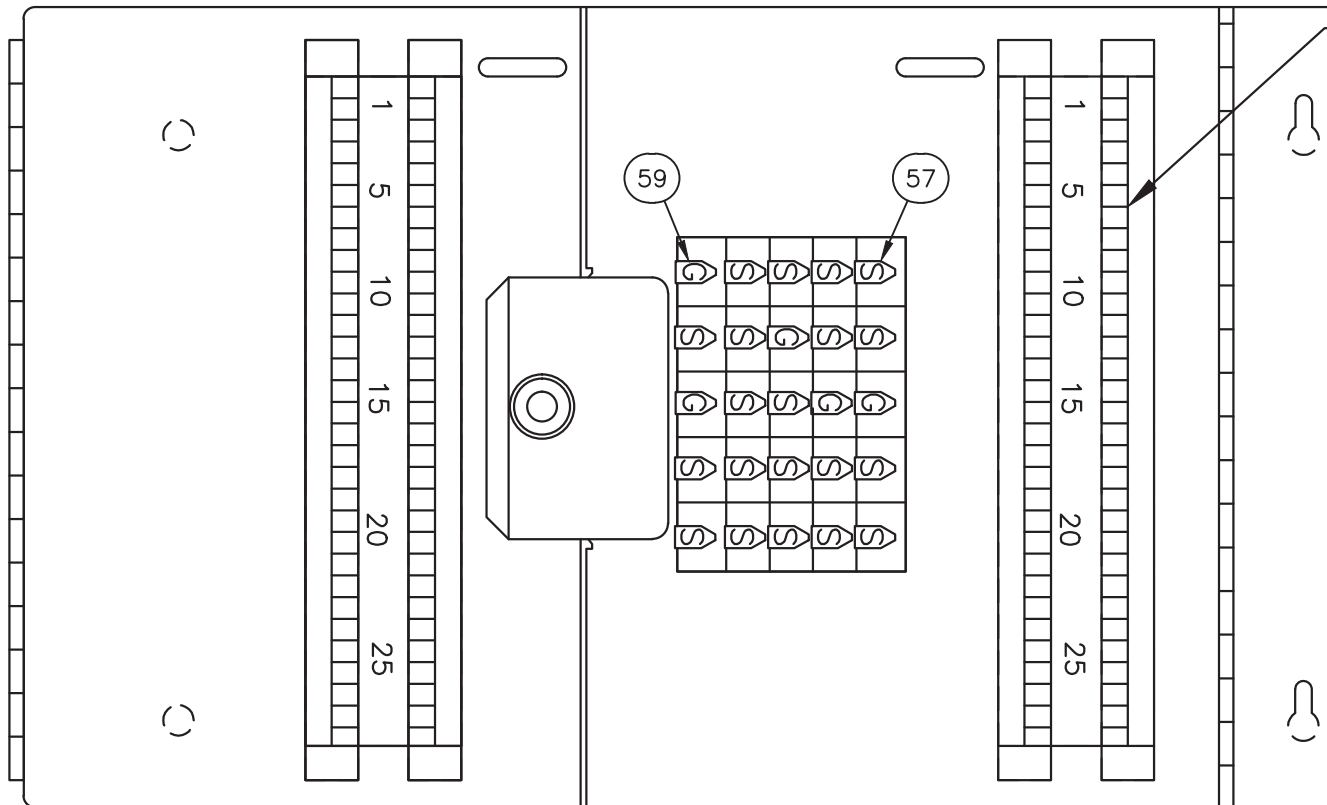

CONNECTIONS TO CIRCA PANEL

PAIR#


1. INDEC (FEMA PHONE JACK #3, CAT 5 CABLE #1) BLU, WHT/BLU
- 2.
- 3.
- 4.
- 5.
- 6&7. DATA (DATA JACK #3, CAT 5 CABLE #1) WHT/BRN, GRN, WHT/GRN, BRN  $\Delta$
8. PHONE (PHONE JACK #2, CAT 5 CABLE #2) BLU, WHT/BLU
- 9&10. DATA (DATA JACK #2, CAT 5 CABLE #2) WHT/BRN, GRN, WHT/GRN, BRN
11. PHONE (PHONE JACK #1, CAT 5 CABLE #3) BLU, WHT/BLU  $\Delta$
- 12&13. DATA (DATA JACK #1, CAT 5 CABLE #3) WHT/BRN, GRN, WHT/GRN, BRN
14. VIKING (CAT 3 CABLE #4, (77) BLU, WHT/BLU (CABLE TO VIKING DIALER MADE TO LENGTH)  $\Delta$
15. INCON FUEL MONITOR (CAT 3 CABLE #5, (77) BLU, WHT/BLU (CABLE TO INCON MADE TO LENGTH)  $\Delta$

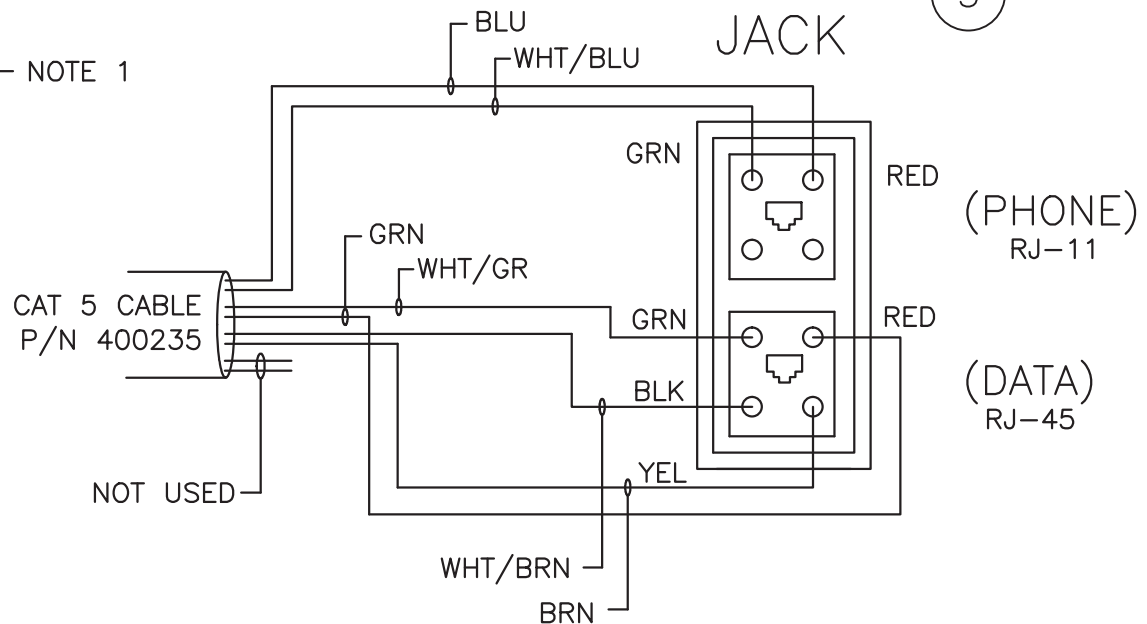

TYPICAL FEMA PHONE/DATA JACK WIRING SCHEMATIC

NOTES:

1. CONNECT CABLES TO RIGHT SIDE OF CIRCA PANEL
2. LEAVE NO EXCESS CABLE OUTSIDE OF BOX

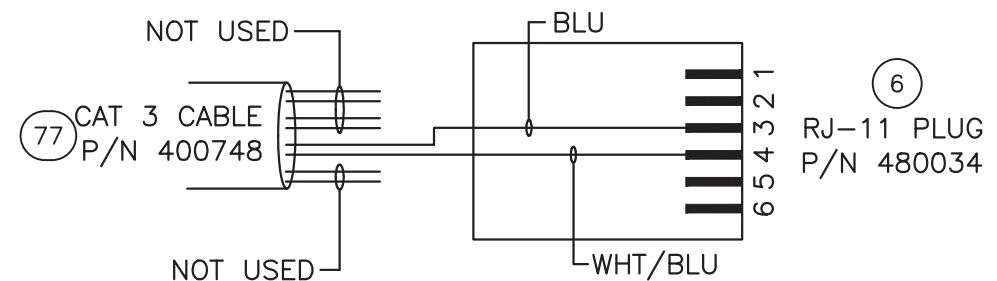


CAT 3/RJ-11 CONNECTOR WIRING

NOTE:

1. RJ-11 PLUG IS SHOWN WITH "HOOK CLIP" ON THE UNDERSIDE.

P	LJL	12/11/12	MODIFIED NOTES 6,7,11,14&15	LJL	6/13/12
N	RRG	6/13/12	CORRECTED NOTES/ADDED DETAIL	LJL	6/13/12
M	LJL	1/3/12	UPDATED WIRING CALLOUTS & P/N'S	LJL	1/3/12
K	JJ	4/7/11	SHEET ADDED	LJL	4/7/11
REV	BY	DATE	DESCRIPTION	APP. BY	DATE

February 27, 2013

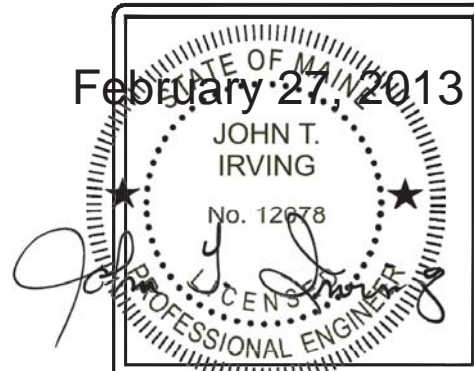

THIS DRAWING IS THE CONFIDENTIAL PROPERTY AND CONTAINS TRADE SECRETS OF CELLXION, LLC. ANY USE OF THESE DRAWINGS OR THE INFORMATION CONTAINED HEREIN FOR ANY REASON OTHER THAN AS EXPRESSLY AUTHORIZED BY SABRE INDUSTRIES, INC. IS STRICTLY PROHIBITED. THIS DRAWING HAS BEEN DISTRIBUTED WITH THE UNDERSTANDING THAT ANYONE RECEIVING OR OTHERWISE OBTAINING POSSESSION OF IT WILL BE EXPRESSLY NOTIFIED OF ITS CONFIDENTIAL NATURE.


**Cellxion**  
 5031 Hazel Jones Road  
 Bossier City, Louisiana 71111  
 voice: (318) 213-2900  
 fax: (318) 213-2919  
 www.cellxion.com

CUSTOMER:  
**KELLOGG BROWN & ROOT**  
 FEMA (PEP)  
 EXPANSION PROGRAM

PROJECT:  
 10'-0" X 18'-0"  
 CONCRETE SHELTER  
 PHONE/DATA WIRING

FILENAME: KBR/SKBR02	
SCALE: N.T.S.	TOLERANCE:
DRWN. BY: M. FOWLER	DATE: 03/24/2010
CHK. BY: V. HASSELL	DATE: 03/24/2010
ENG. BY:	DATE:
APP. BY: A. DUMAS	DATE: 03/24/2010
SHEET NO. 5-4	
DRAWING NO.: SKBR02	REV.: P

February 27, 2013

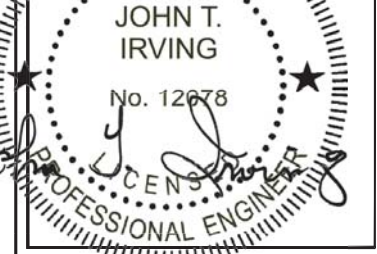


THIS DRAWING IS THE CONFIDENTIAL PROPERTY AND CONTAINS TRADE SECRETS OF CELLXION, LLC. ANY USE OF THESE DRAWINGS OR THE INFORMATION CONTAINED HEREIN FOR ANY REASON OTHER THAN AS EXPRESSLY AUTHORIZED BY SABRE INDUSTRIES, INC. IS STRICTLY PROHIBITED. THIS DRAWING HAS BEEN DISTRIBUTED WITH THE UNDERSTANDING THAT ANYONE RECEIVING OR OTHERWISE OBTAINING POSSESSION OF IT WILL BE EXPRESSLY NOTIFIED OF ITS CONFIDENTIAL NATURE.

**cellxion**  
 5031 Hazel Jones Road  
 Bossier City, Louisiana 71111  
 voice: (318) 213-2900  
 fax: (318) 213-2919  
 www.cellxion.com

CUSTOMER:  
**KELLOGG  
 BROWN & ROOT  
 FEMA (PEP)  
 EXPANSION PROGRAM**

PROJECT:  
**10'-0" X 18'-0"  
 CONCRETE SHELTER  
 HVAC/FIKE SYSTEM  
 SCHEMATIC DETAIL**


FILENAME: KBR/SKBRO2	
SCALE: N.T.S.	TOLERANCE:
DRWN. BY: M. FOWLER	DATE: 03/24/2010
CHK. BY: V. HASSELL	DATE: 03/24/2010
ENG. BY:	DATE:
APP. BY: A. DUMAS	DATE: 03/24/2010
SHEET NO. 5-5	
DRAWING NO.:	REV.:
SKBR02	P

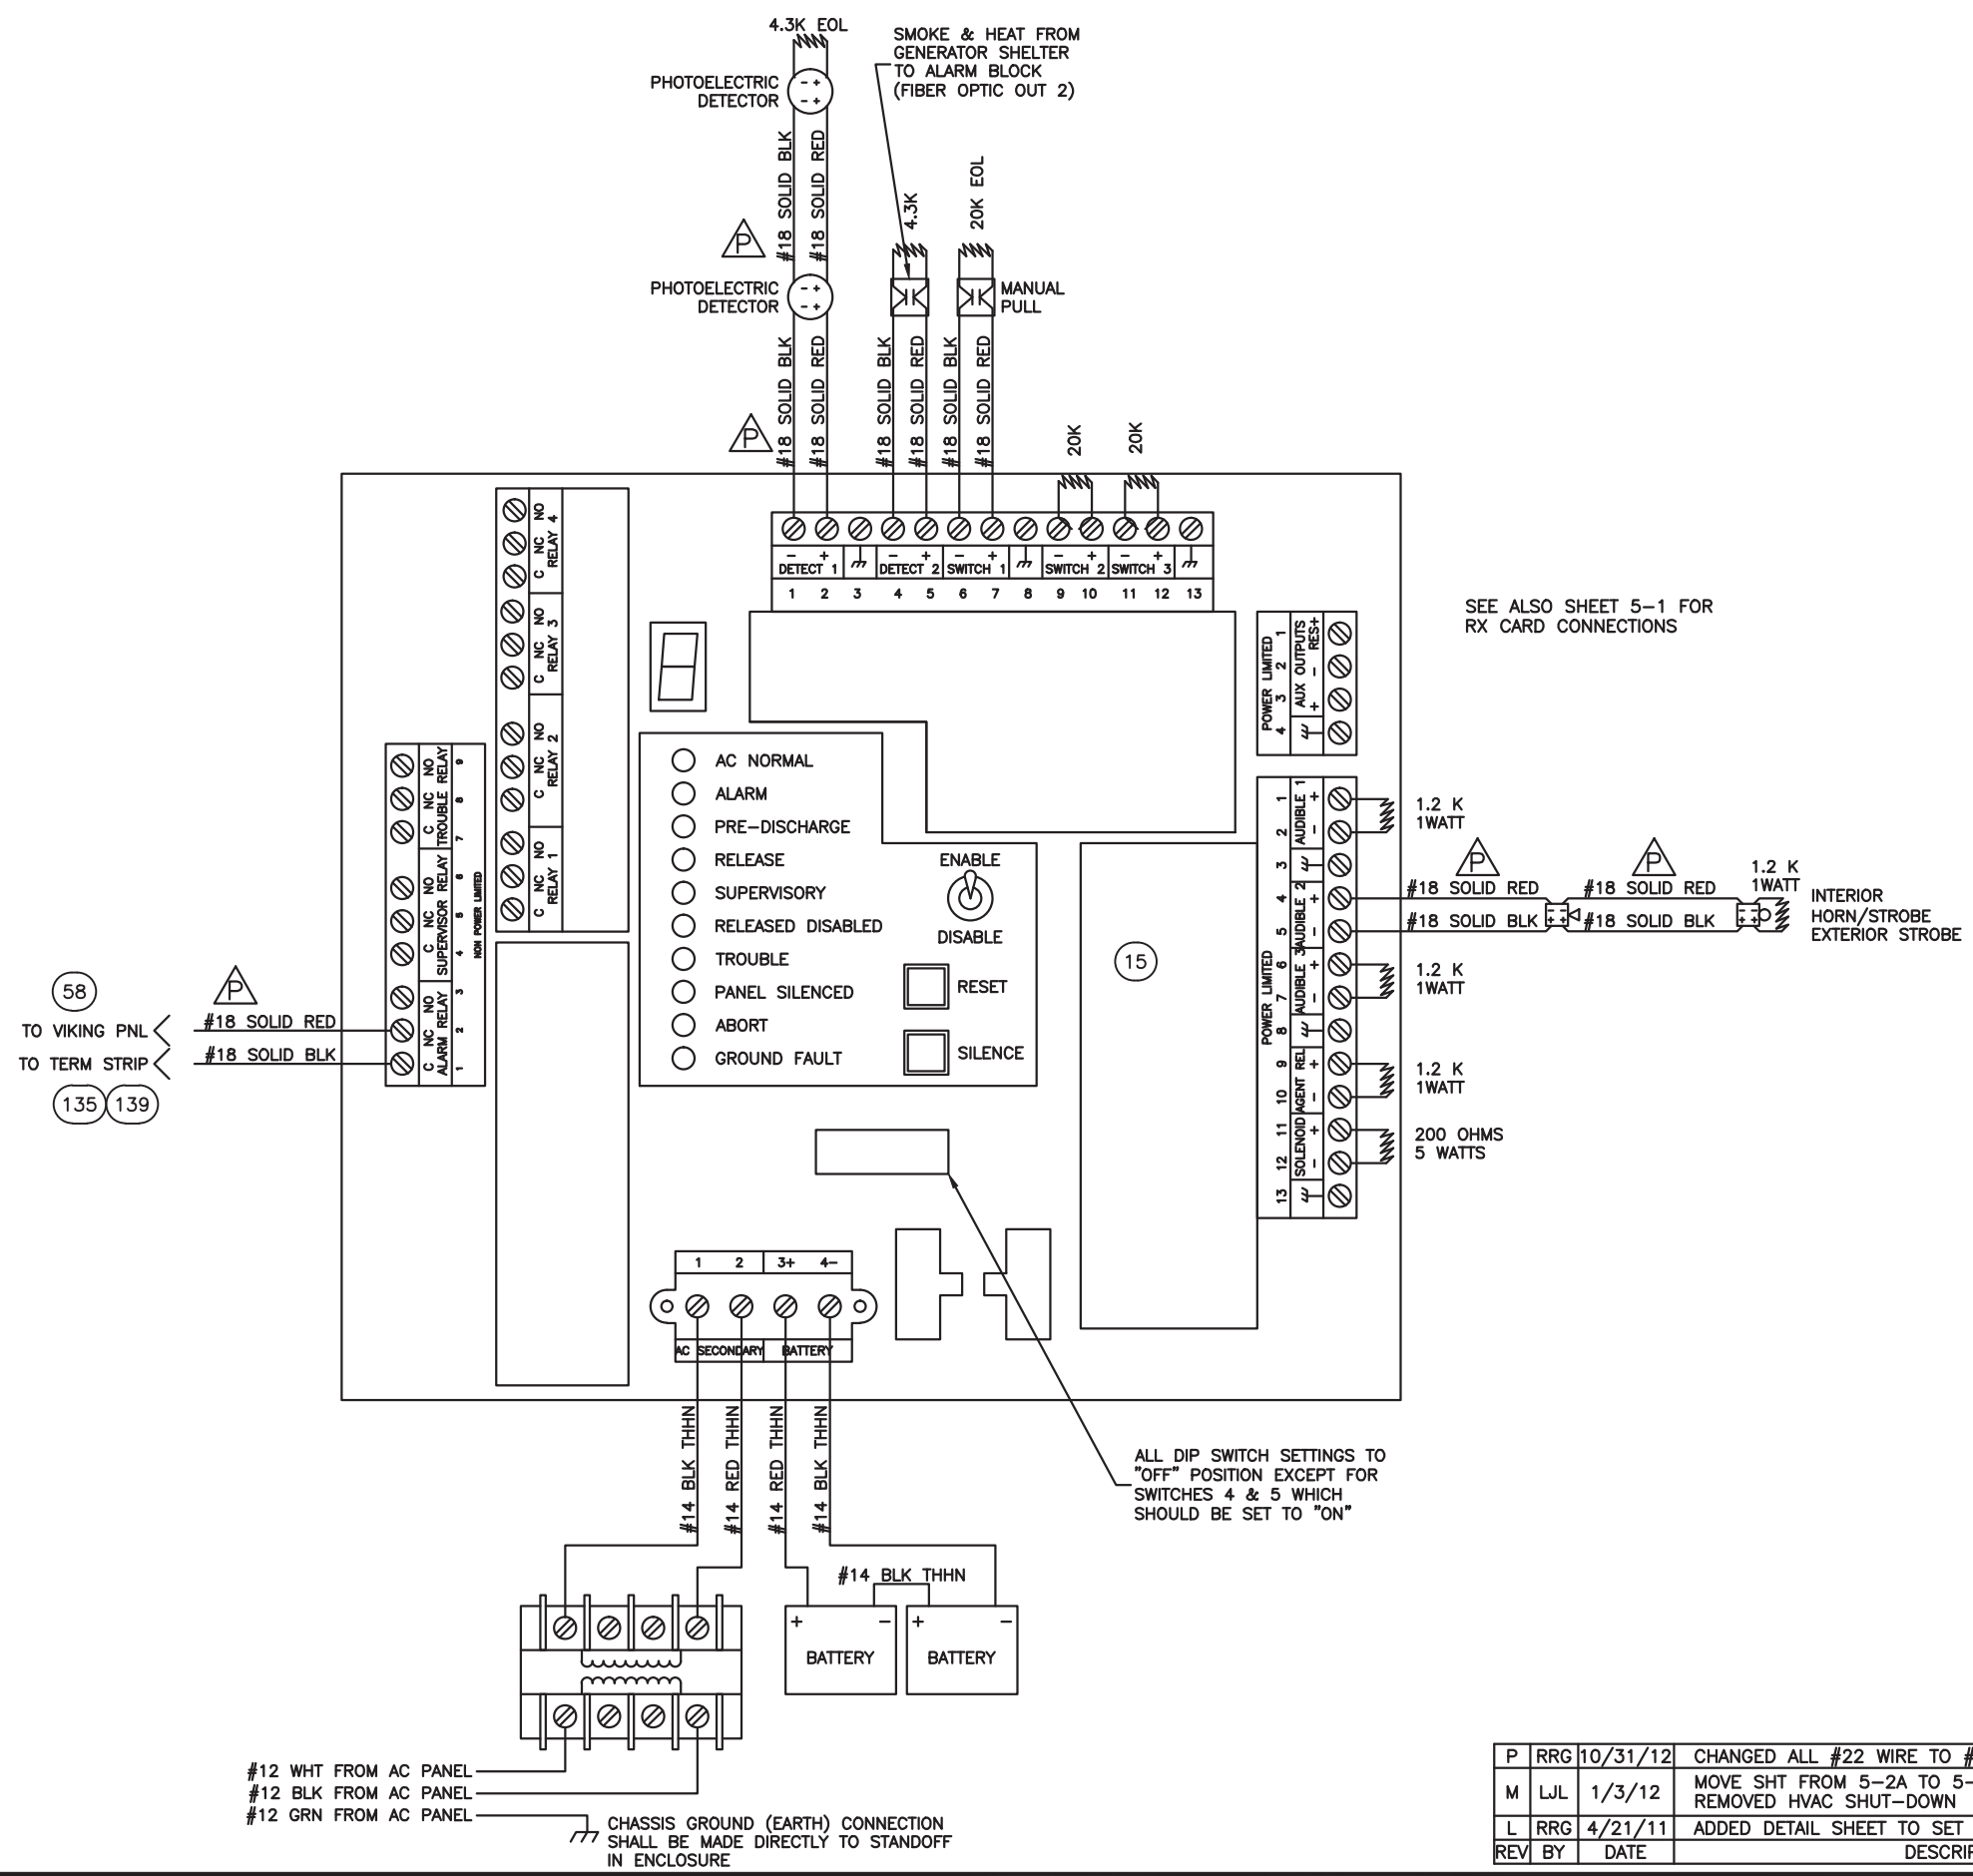

REV	BY	DATE	DESCRIPTION	APP. BY	DATE
P	RRG	10/31/12	CHANGED ALL #22 WIRE TO #18	LJL	10/31/12
M	LJL	1/3/12	MOVE SHT FROM 5-2A TO 5-5/ADDED MARVAIR TERMICAL REMOVED HVAC SHUT-DOWN	LJL	1/3/12
L	RRG	4/21/11	ADDED DETAIL SHEET TO SET	LJL	4/21/11



PANEL NAME:		PANEL "C"																
NOTES:	PRE HEMP LOADING FED FROM PANEL "A"	VOLTAGE:		208	/	120	MAIN BREAKER:		Y									
		PHASE:		3			LUGS ONLY:											
		WIRE:		4			SURFACE:		Y									
		BUS AMPS:		100		100	:MAIN CB AMPS		FLUSH:									
		SUPPLY AMPS:		50			GROUND BUS:		Y									
		MIN. SHORT CIRCUIT RATING:		10000			ISOLATED GROUND BUS:											
		INCLUDE SPARE CAP. - Y/N:		N			NEUTRAL BUS:		Y									
		SERVES		LTG	RCPT	PWR	MOT	CB *	CKT	PH	CKT	CB *	LTG	RCPT	PWR	MOT	SERVES	
		MAIN BREAKER						100	1	A	2	40					TRANSMITTER	1,2
		MAIN BREAKER						[	3	B	4	[					TRANSMITTER	1,2
MAIN BREAKER						[	5	C	6	[					TRANSMITTER	1,2		
RECEPT (DESK)			720			20	7	A	8	20					RACK POWER	1,2		
RECEPT (W/AUTO DIALER)			600			20	9	B	10	20		180			GFCI			
TRANSMITTER RM LIGHTING		300				15	11	C	12	35			3360		HVAC			
SPARE						20	13	A	14	[			3360		HVAC			
SPARE						20	15	B	16	[			3360		HVAC			
TVSS				60		30	17	C	18	15			300		FIKE PANEL	△ 3		
TVSS				60		[	19	A	20	20					SPARE			
TVSS				60		[	21	B	22	20					RACK POWER	2		
2	PORTABLE AC	△				15	23	C	24	20			300		FUEL SYSTEM CONTROLLER			
2	PORTABLE AC					15	25	A	26									
							27	B	28									
							29	C	30									
CONNECTED VA		A:	4,140	B:	4,200	C:	4,320											
CONNECTED KVA:		D.F.		DEMAND KVA:		AMPS		KVA		DESIGN (BASED ON SUPPLY)								
LIGHTING LOAD:		0.3	1.25	0.4		35.1	12.7	CONNECTED										
RECEPT. LOAD - FIRST 10 KVA:		1.5	1.00	1.5		35.3	12.7	DEMAND										
RECEPT. LOAD - REMAINDER:		0.0	0.50	0.0		14.7	5.3	SPARE										
POWER LOAD:		10.9	1.00	10.9		AVG												
MOTOR LOAD EXCEPT LARGEST:		0.0	1.00	0.0		KVA		AMPS	KVA	CONNECTED								
LARGEST MOTOR:		0.0	1.25	0.0		4.2	35	4.1	PHASE A									
20% SPARE CAPACITY:		0.0	1.00	0.0			35	4.2	PHASE B									
TOTAL CONNECTED LOAD:		12.7	TOTAL DEMAND LOAD:		12.7		36	4.3	PHASE C									
INSTRUCTIONS:		PHASE																
* - ALL BRANCH CIRCUIT BREAKERS ARE 1P20 UNLESS OTHERWISE SHOWN		LOAD																
[- DENOTES ADDITIONAL POLES OF MULTI-POLE CIRCUIT BREAKERS		PHASE BALANCE																
		69%																
		70%																
		72%																
		98%																
		100%																
		102%																
		PHASE A																
		PHASE B																
		PHASE C																
1	Transmitter only operational when fed from generator power.																	
2	These circuits will not be connected in the "PRE-HEMP" stage and are shown for information purposes.																	
3	The circuit breaker shall have red identification and labeled as "FIRE ALARM CIRCUIT".																	

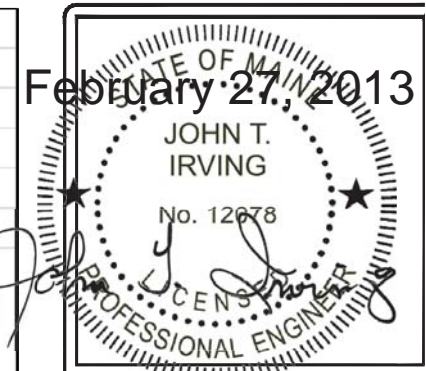

THIS DRAWING IS THE CONFIDENTIAL PROPERTY AND CONTAINS TRADE SECRETS OF CELLXION, LLC. ANY USE OF THESE DRAWINGS OR THE INFORMATION CONTAINED HEREIN FOR ANY REASON OTHER THAN AS EXPRESSLY AUTHORIZED BY SABRE INDUSTRIES, INC. IS STRICTLY PROHIBITED. THIS DRAWING HAS BEEN DISTRIBUTED WITH THE UNDERSTANDING THAT ANYONE RECEIVING OR OTHERWISE OBTAINING POSSESSION OF IT WILL BE EXPRESSLY NOTIFIED OF ITS CONFIDENTIAL NATURE.

**Cellxion**  
 5031 Hazel Jones Road  
 Bossier City, Louisiana 71111  
 voice: (318) 213-2900  
 fax: (318) 213-2919  
 www.cellxion.com


CUSTOMER:  
**KELLOGG  
 BROWN & ROOT  
 FEMA (PEP)  
 EXPANSION PROGRAM**

PROJECT:  
**10'-0" X 18'-0"  
 CONCRETE SHELTER  
 ELECTRICAL PANEL CALC  
 PRE HEMP**

FILENAME: KBR/SKBR02	
SCALE: N.T.S.	TOLERANCE:
DRWN. BY: M. FOWLER	DATE: 03/24/2010
CHK. BY: V. HASSELL	DATE: 03/24/2010
ENG. BY:	DATE:
APP. BY: A. DUMAS	DATE: 03/24/2010
SHEET NO. 5-6	
DRAWING NO.:	REV.:
SKBR02	P

P	RRG	10/31/12	UPDATED SCHEMATIC, ADDED NOTE 3	LJL	10/31/12
N	JWR	6/29/12	UPDATED SCHEMATIC	LJL	6/29/12
N	RRG	6/13/12	UPDATED SCHEMATIC	LJL	6/13/12
REV	BY	DATE	DESCRIPTION	APP. BY	DATE



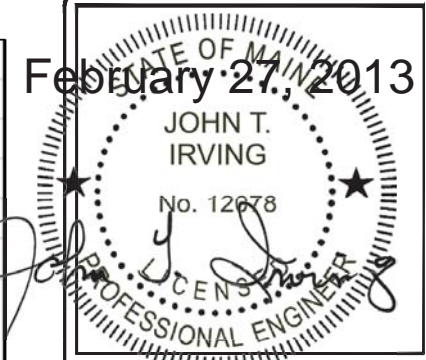

THIS DRAWING IS THE CONFIDENTIAL PROPERTY AND CONTAINS TRADE SECRETS OF CELLXION, LLC. ANY USE OF THESE DRAWINGS OR THE INFORMATION CONTAINED HEREIN FOR ANY REASON OTHER THAN AS EXPRESSLY AUTHORIZED BY SABRE INDUSTRIES, INC. IS STRICTLY PROHIBITED. THIS DRAWING HAS BEEN DISTRIBUTED WITH THE UNDERSTANDING THAT ANYONE RECEIVING OR OTHERWISE OBTAINING POSSESSION OF IT WILL BE EXPRESSLY NOTIFIED OF ITS CONFIDENTIAL NATURE.

**cellxion**  
 5031 Hazel Jones Road  
 Bossier City, Louisiana 71111  
 voice: (318) 213-2900  
 fax: (318) 213-2919  
 www.cellxion.com

CUSTOMER:  
**KELLOGG BROWN & ROOT**  
**FEMA (PEP)**  
**EXPANSION PROGRAM**



PROJECT:  
**10'-0" X 18'-0"**  
**CONCRETE SHELTER**  
**ELECTRICAL PANEL CALC**  
**POST HEMP**

FILENAME:  
**KBR/SKBR02**  
 SCALE: N.T.S. TOLERANCE:  
 DRWN. BY: M. FOWLER DATE: 03/24/2010  
 CHK. BY: V. HASSELL DATE: 03/24/2010  
 ENG. BY: DATE:  
 APP. BY: A. DUMAS DATE: 03/24/2010


SHEET NO.  
 5-7  
 DRAWING NO.: SKBR02 REV.: P

PANEL NAME:		PANEL "C"													NOTES:	
POST HEMP LOADING FED FROM PANEL "B" VIA GENERATOR	VOLTAGE:	208	/	120										MAIN BREAKER:	Y	NOTES:
	PHASE:	3										LUGS ONLY:				
	WIRE:	4										SURFACE:	Y			
	BUS AMPS:	100	100	:MAIN CB AMPS									FLUSH:			
	SUPPLY AMPS:	90										GROUND BUS:	Y			
	MIN. SHORT CIRCUIT RATING:	10000										ISOLATED GROUND BUS:				
INCLUDE SPARE CAP. - Y/N:	N										NEUTRAL BUS:	Y				
SERVES	LTG	RCPT	PWR	MOT	CB *	CKT	PH	CKT	CB *	LTG	RCPT	PWR	MOT	SERVES	NOTES:	
MAIN BREAKER					100	1	A	2	40			3842		TRANSMITTER	1,2	
MAIN BREAKER					[	3	B	4	[			3842		TRANSMITTER	1,2	
MAIN BREAKER					[	5	C	6	[			3842		TRANSMITTER	1,2	
RECEPT (DESK)		720			20	7	A	8	20		1500			RACK POWER		
RECEPT(W/AUTO DIALER)					20	9	B	10	20		180			GFCI		
TRANSMITTER RM LIGHTING	300				15	11	C	12	35					HVAC	2	
SPARE					20	13	A	14	[					HVAC	2	
SPARE					20	15	B	16	[					HVAC	2	
2 TVSS					30	17	C	18	15					FIKE PANEL	3	
2 TVSS					[	19	A	20	20					SPARE		
2 TVSS					[	21	B	22	20		1500			RACK POWER		
PORTABLE AC			1440		15	23	C	24	20					FUEL SYSTEM CONTROLLER		
PORTABLE AC			1440		15	25	A	26								
						27	B	28								
						29	C	30								
CONNECTED VA			A:	7,502	B:	5,522	C:	5,582								
CONNECTED KVA:					D.F. DEMAND KVA:					AMPS	KVA	DESIGN (BASED ON SUPPLY)				
LIGHTING LOAD:					0.3	1.25		0.4	51.6	18.6	CONNECTED					
RECEPT. LOAD - FIRST 10 KVA:					3.9	1.00		3.9	51.9	18.7	DEMAND					
RECEPT. LOAD - REMAINDER:					0.0	0.50		0.0	38.1	13.7	SPARE					
POWER LOAD:					14.4	1.00		14.4	AVG							
MOTOR LOAD EXCEPT LARGEST:					0.0	1.00		0.0	KVA		AMPS	KVA	CONNECTED			
LARGEST MOTOR:					0.0	1.25		0.0	6.2	63	7.5	PHASE A				
20% SPARE CAPACITY:					0.0	1.00		0.0	46	5.5	PHASE B					
TOTAL CONNECTED LOAD:					18.6	TOTAL DEMAND LOAD:		18.7	47	5.6	PHASE C					
<b>INSTRUCTIONS:</b>										PHASE						
* - ALL BRANCH CIRCUIT BREAKERS ARE 1P20 UNLESS OTHERWISE SHOWN										LOAD						
[- DENOTES ADDITIONAL POLES OF MULTI-POLE CIRCUIT BREAKERS										PHASE BALANCE						
										69%		121%		PHASE A		
										51%		89%		PHASE B		
										52%		90%		PHASE C		
<b>NOTES:</b>																
1	Transmitter only operational when fed from generator power.															
2	Devices are considered non-operational due to HEMP event. OCP'S must be opened before energizing panel after event or on generator power.															
3	The circuit breaker shall have red identification and labeled as "FIRE ALARM CIRCUIT".															

P	RRG	10/31/12	UPDATED SCHEMATIC, ADDED NOTE 3	LJL	10/31/12
N	RRG	6/13/12	UPDATED SCHEMATIC	LJL	6/13/12
REV	BY	DATE	DESCRIPTION	APP. BY	DATE

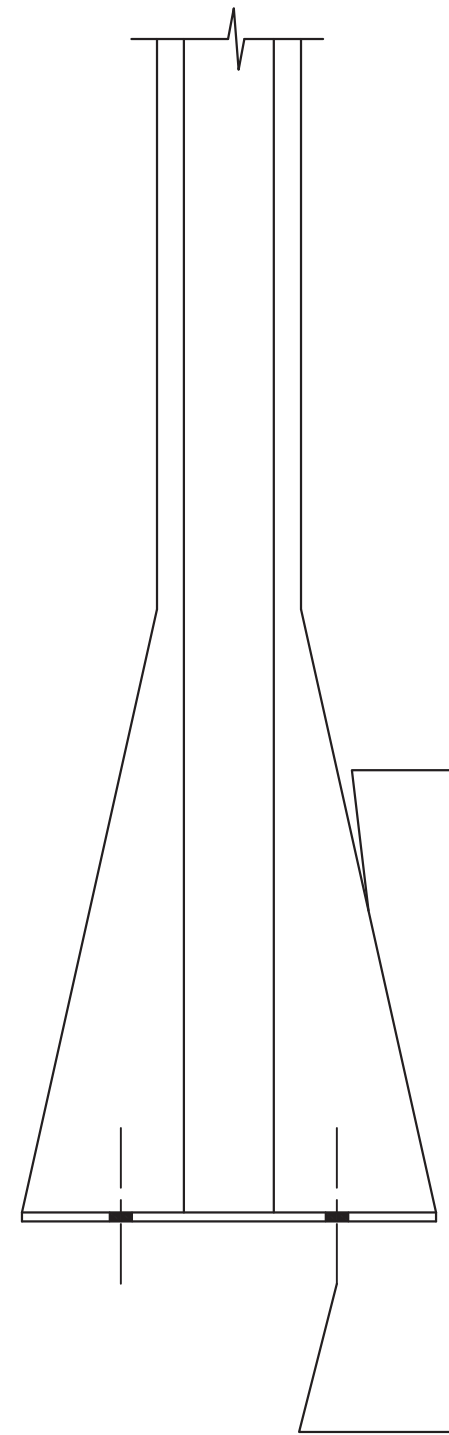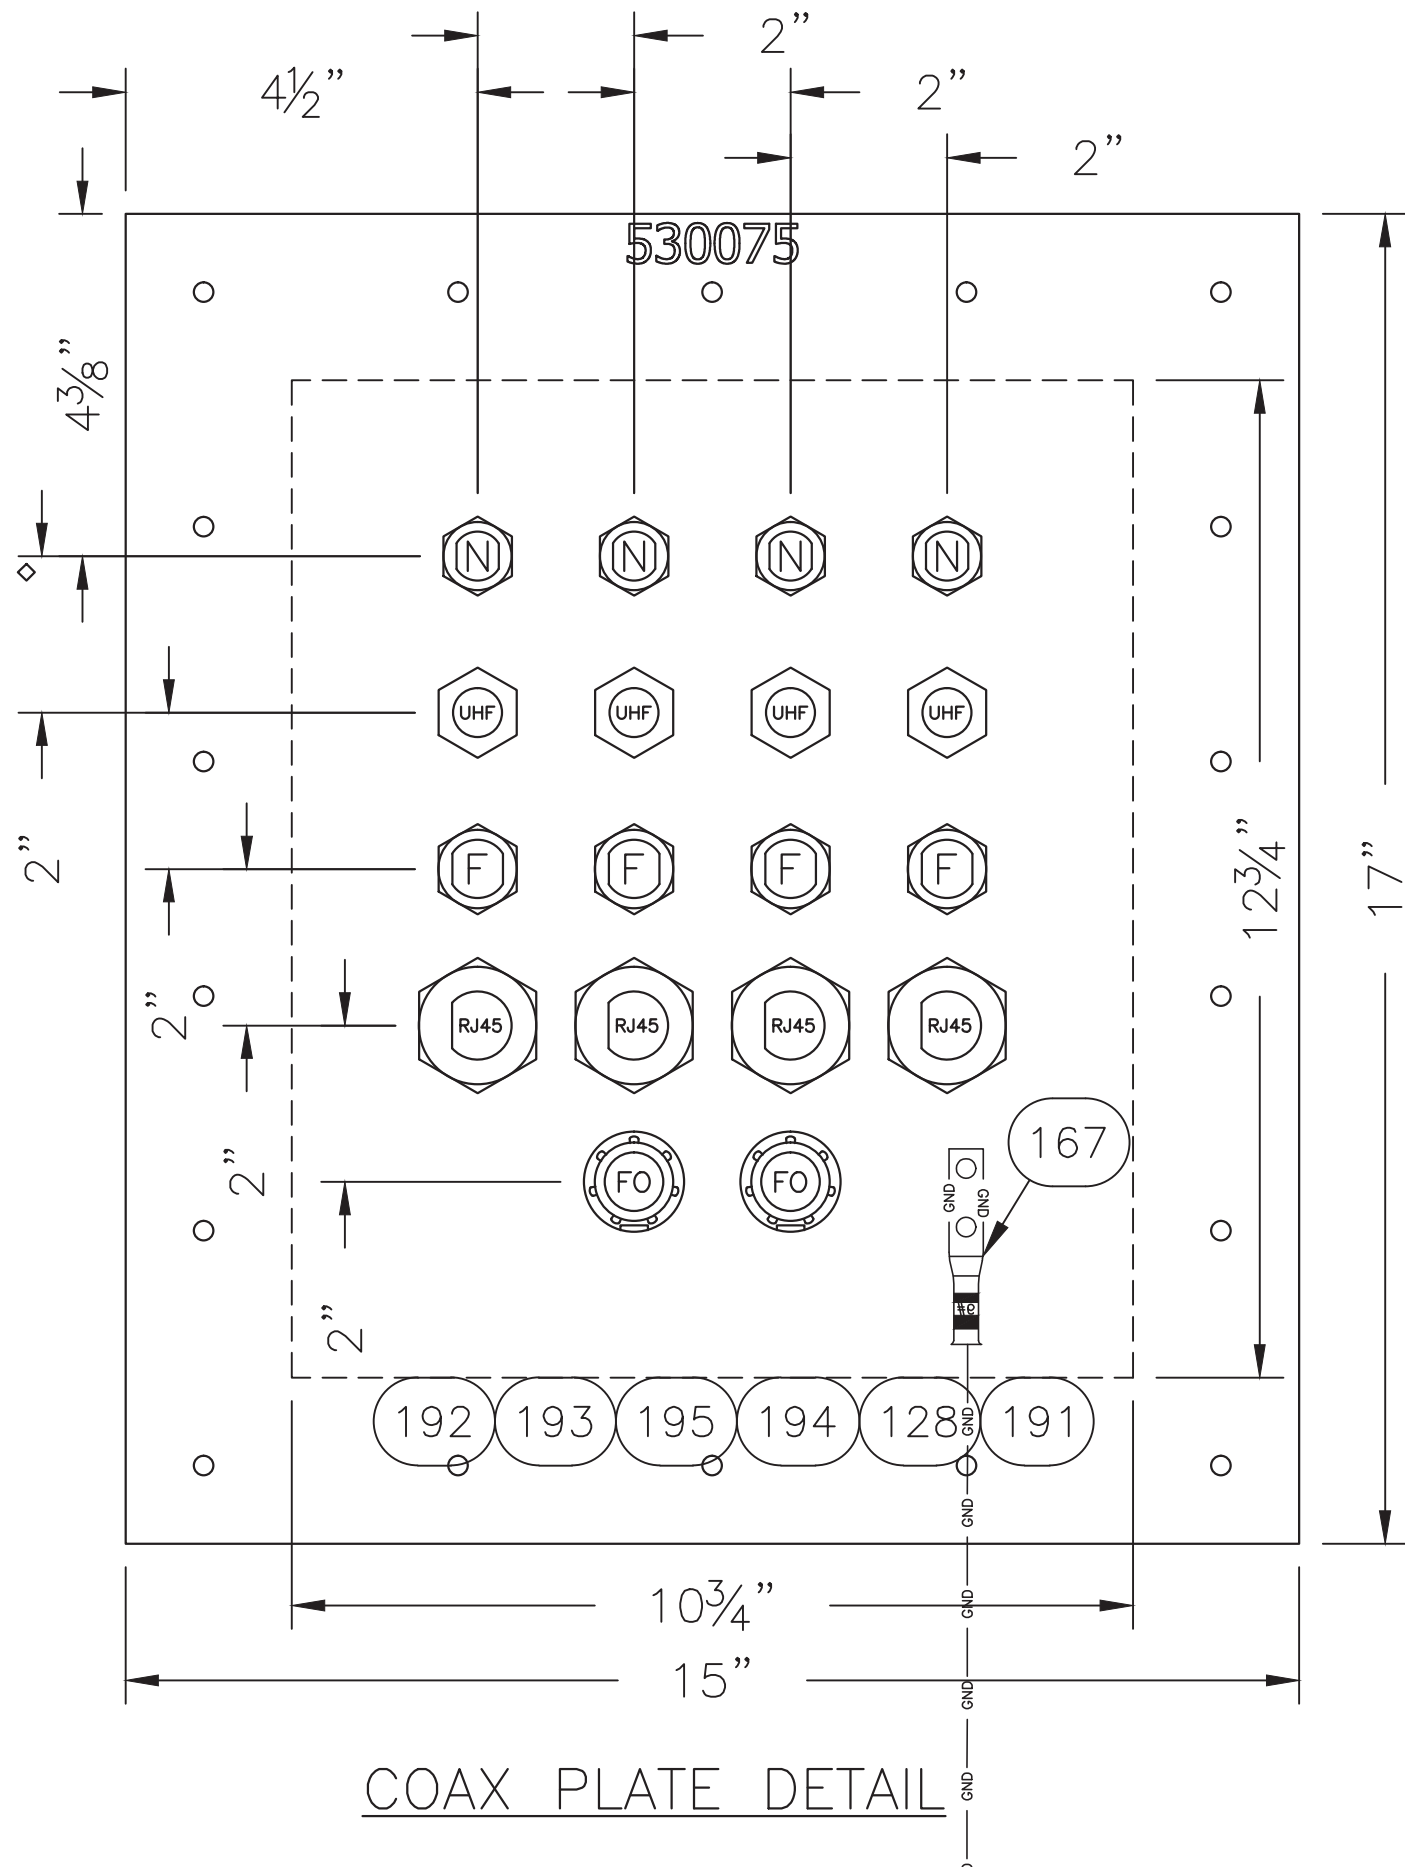

ANCHOR MOUNTING PLATE  
TO FLOOR WITH 5/16" DIA.  
S.S. SLEEVE ANCHORS  
P/N 168055 -TYP EA. LEG

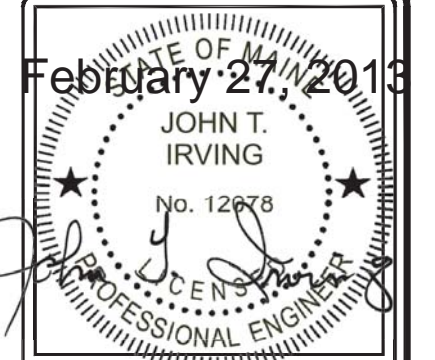

THIS DRAWING IS THE CONFIDENTIAL PROPERTY AND CONTAINS TRADE SECRETS OF CELLXION, LLC. ANY USE OF THESE DRAWINGS OR THE INFORMATION CONTAINED HEREIN FOR ANY REASON OTHER THAN AS EXPRESSLY AUTHORIZED BY SABRE INDUSTRIES, INC. IS STRICTLY PROHIBITED. THIS DRAWING HAS BEEN DISTRIBUTED WITH THE UNDERSTANDING THAT ANYONE RECEIVING OR OTHERWISE OBTAINING POSSESSION OF IT WILL BE EXPRESSLY NOTIFIED OF ITS CONFIDENTIAL NATURE.

5031 Hazel Jones Road  
Bossier City, Louisiana 71111  
voice: (318) 213-2900  
fax: (318) 213-2919  
www.cellxion.com


CUSTOMER:  
KELLOGG  
BROWN & ROOT  
FEMA (PEP)  
EXPANSION PROGRAM

PROJECT:  
10'-0" X 18'-0"  
CONCRETE SHELTER  
WORK BENCH  
MOUNTING DETAIL


FILENAME: KBR/SKBR02	
SCALE: N.T.S.	TOLERANCE:
DRWN. BY: M. FOWLER	DATE: 03/24/2010
CHK. BY: V. HASSELL	DATE: 03/24/2010
ENG. BY:	DATE:
APP. BY: A. DUMAS	DATE: 03/24/2010
SHEET NO. 6-0	
DRAWING NO.: SKBR02	REV.: P

M	JJ	11/09/11	ADD COAX PLATE DETAIL	LL	11/09/11
REV	BY	DATE	DESCRIPTION	APP. BY	DATE





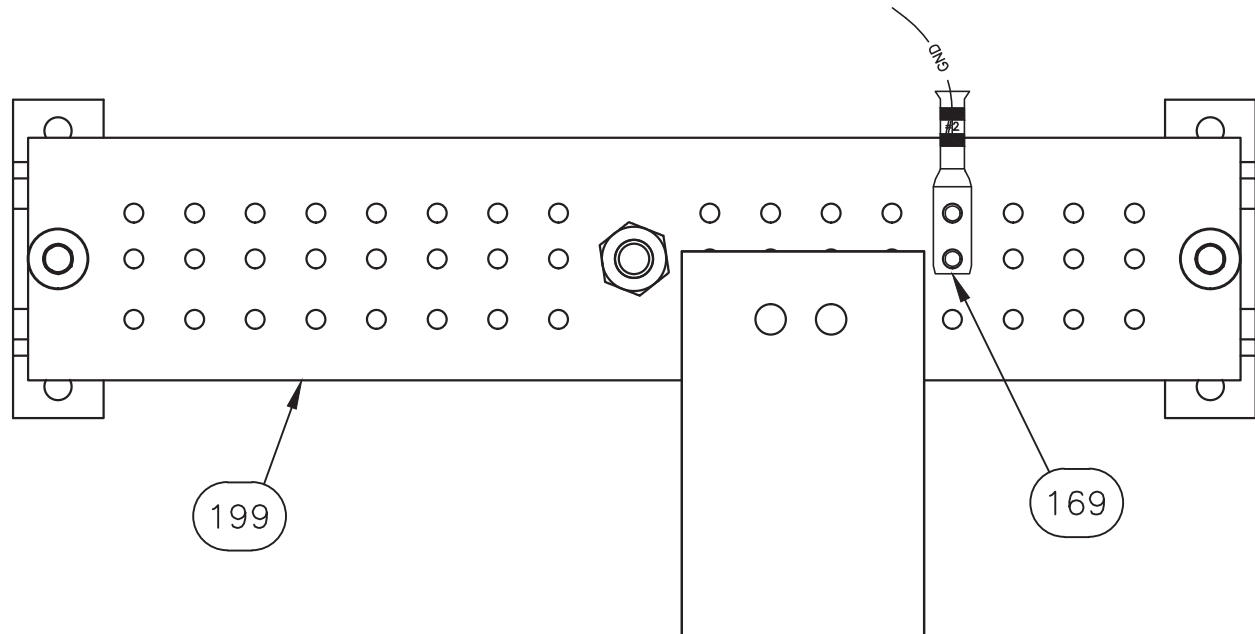


INTERIOR GROUND BAR  
DETAIL

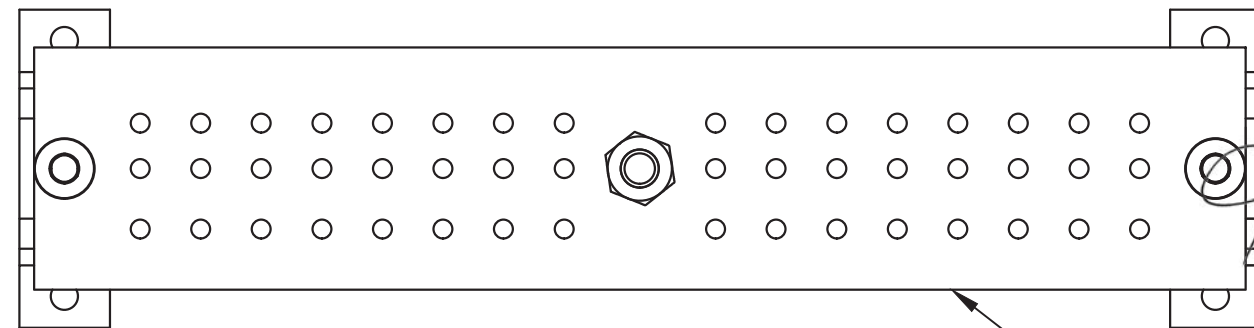

EXTERIOR GROUND BAR  
DETAIL

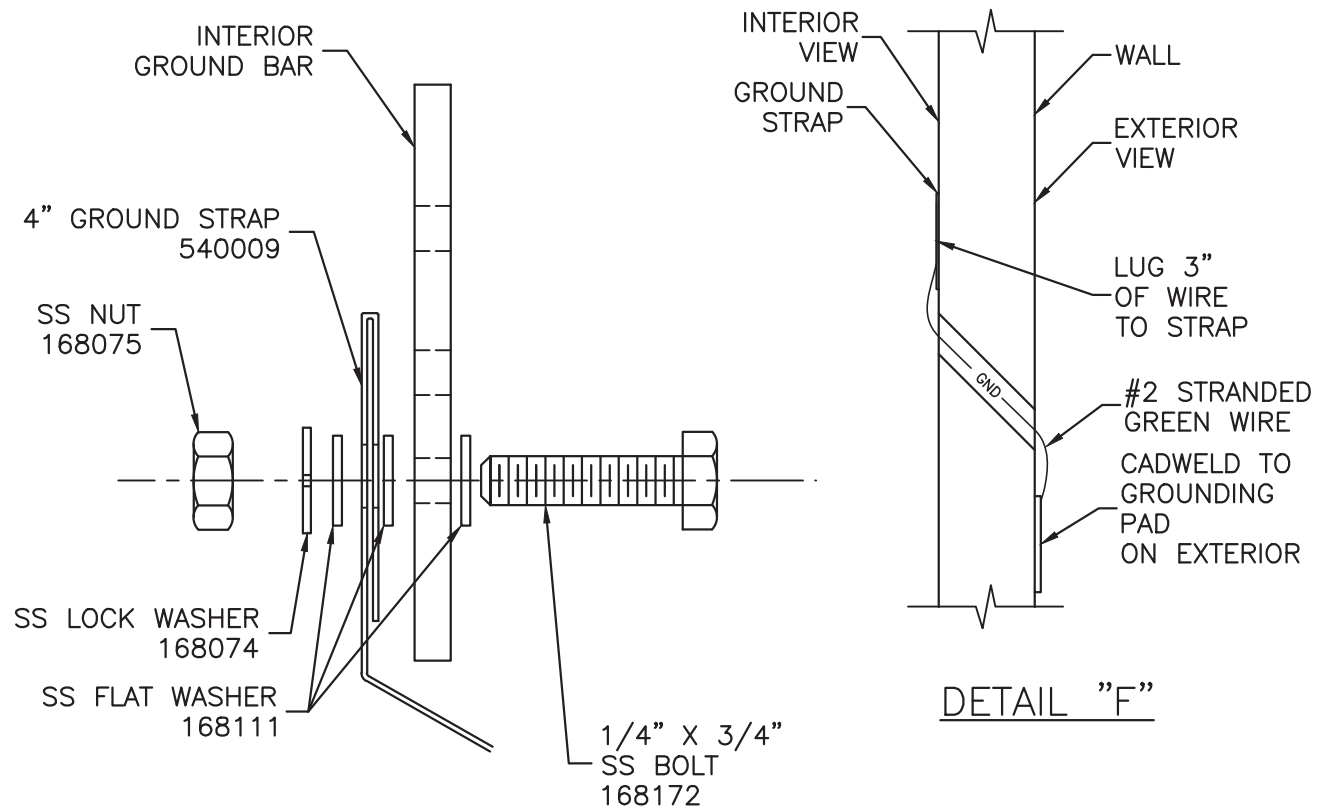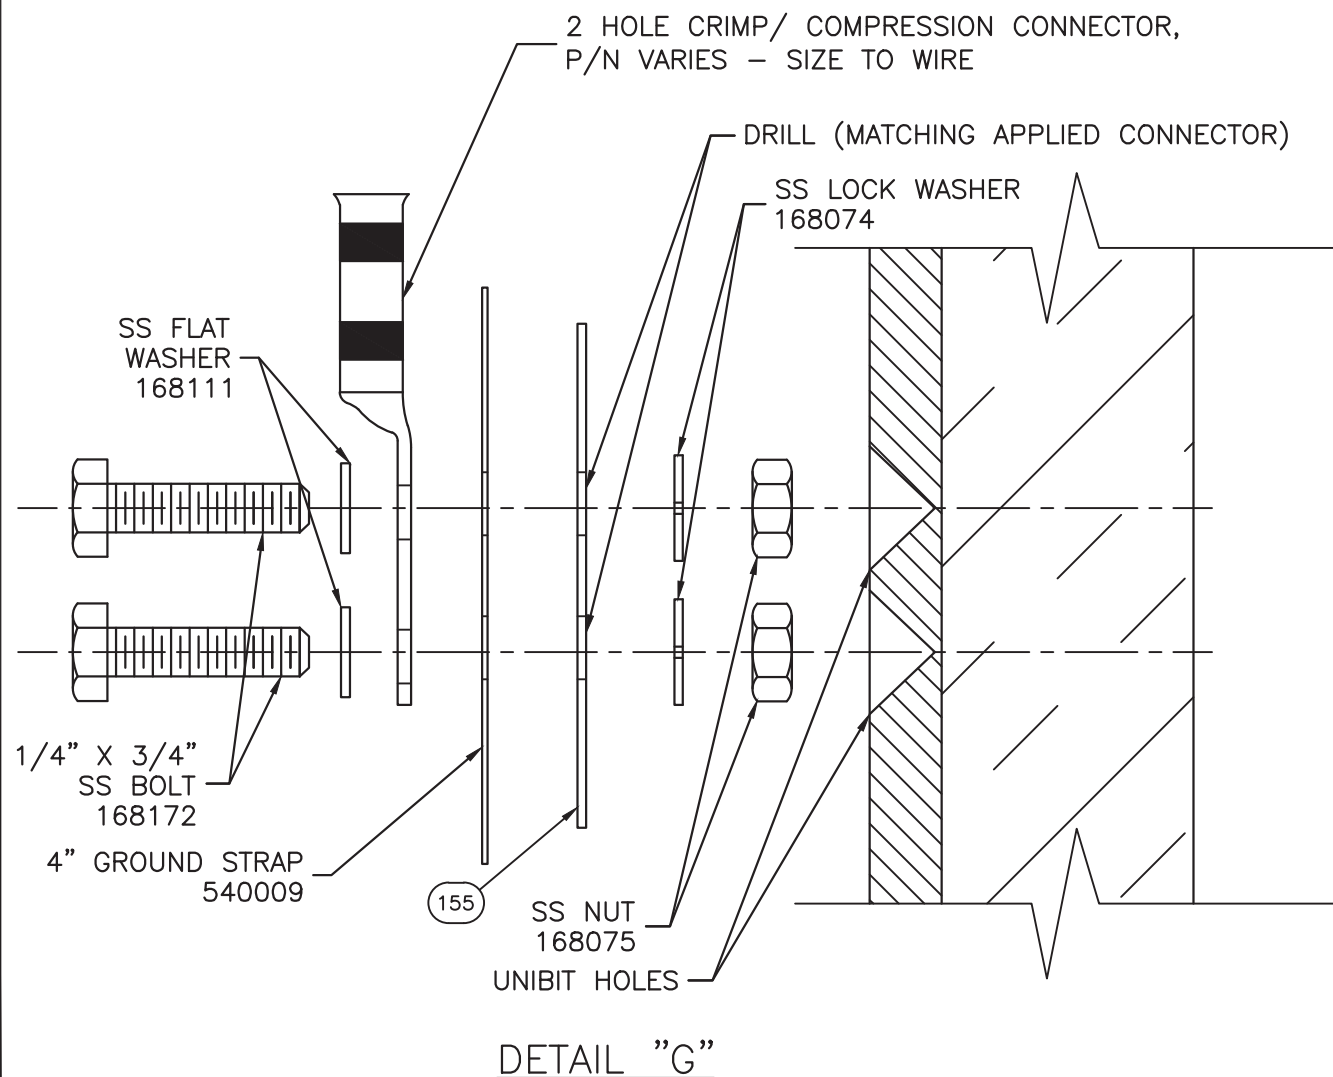

February 27, 2013

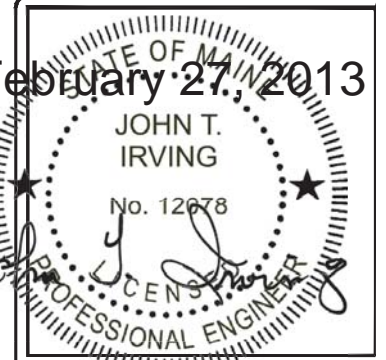

THIS DRAWING IS THE CONFIDENTIAL PROPERTY AND CONTAINS TRADE SECRETS OF CELLXION, LLC. ANY USE OF THESE DRAWINGS OR THE INFORMATION CONTAINED HEREIN FOR ANY REASON OTHER THAN AS EXPRESSLY AUTHORIZED BY SABRE INDUSTRIES, INC. IS STRICTLY PROHIBITED. THIS DRAWING HAS BEEN DISTRIBUTED WITH THE UNDERSTANDING THAT ANYONE RECEIVING OR OTHERWISE OBTAINING POSSESSION OF IT WILL BE EXPRESSLY NOTIFIED OF ITS CONFIDENTIAL NATURE.

**Cellxion**

5031 Hazel Jones Road  
Bossier City, Louisiana 71111  
voice: (318) 213-2900  
fax: (318) 213-2919  
www.cellxion.com


CUSTOMER:  
**KELLOGG  
BROWN & ROOT  
FEMA (PEP)  
EXPANSION PROGRAM**

PROJECT:  
**10'-0" X 18'-0"  
CONCRETE SHELTER  
GROUND BAR  
DETAILS**


FILENAME: KBR/SKBRO2	
SCALE: N.T.S.	TOLERANCE:
DRWN. BY: M. FOWLER	DATE: 03/24/2010
CHK. BY: V. HASSELL	DATE: 03/24/2010
ENG. BY:	DATE:
APP. BY: A. DUMAS	DATE: 03/24/2010
SHEET NO. 6-1	
DRAWING NO.:	REV.:
SKBR02	P

REV	BY	DATE	DESCRIPTION	APP. BY	DATE
N	RRG	6/13/12	CHANGED NOTE/UPDATED FOLD IN GROUND STRAP	LJL	6/13/12
M	JJ	11/09/11	UPDATED GROUND STRIP & ADDED FLAT WASHERS	LJL	11/09/11
J	AMM	2/2/11	UPDATED GROUND BAR ORIENTATION, ADDED FLAT WASHER	LJL	2/2/11

NOTES:  
 1. ELBOW NOT SHOWN IN PLAN VIEW FOR CLARITY

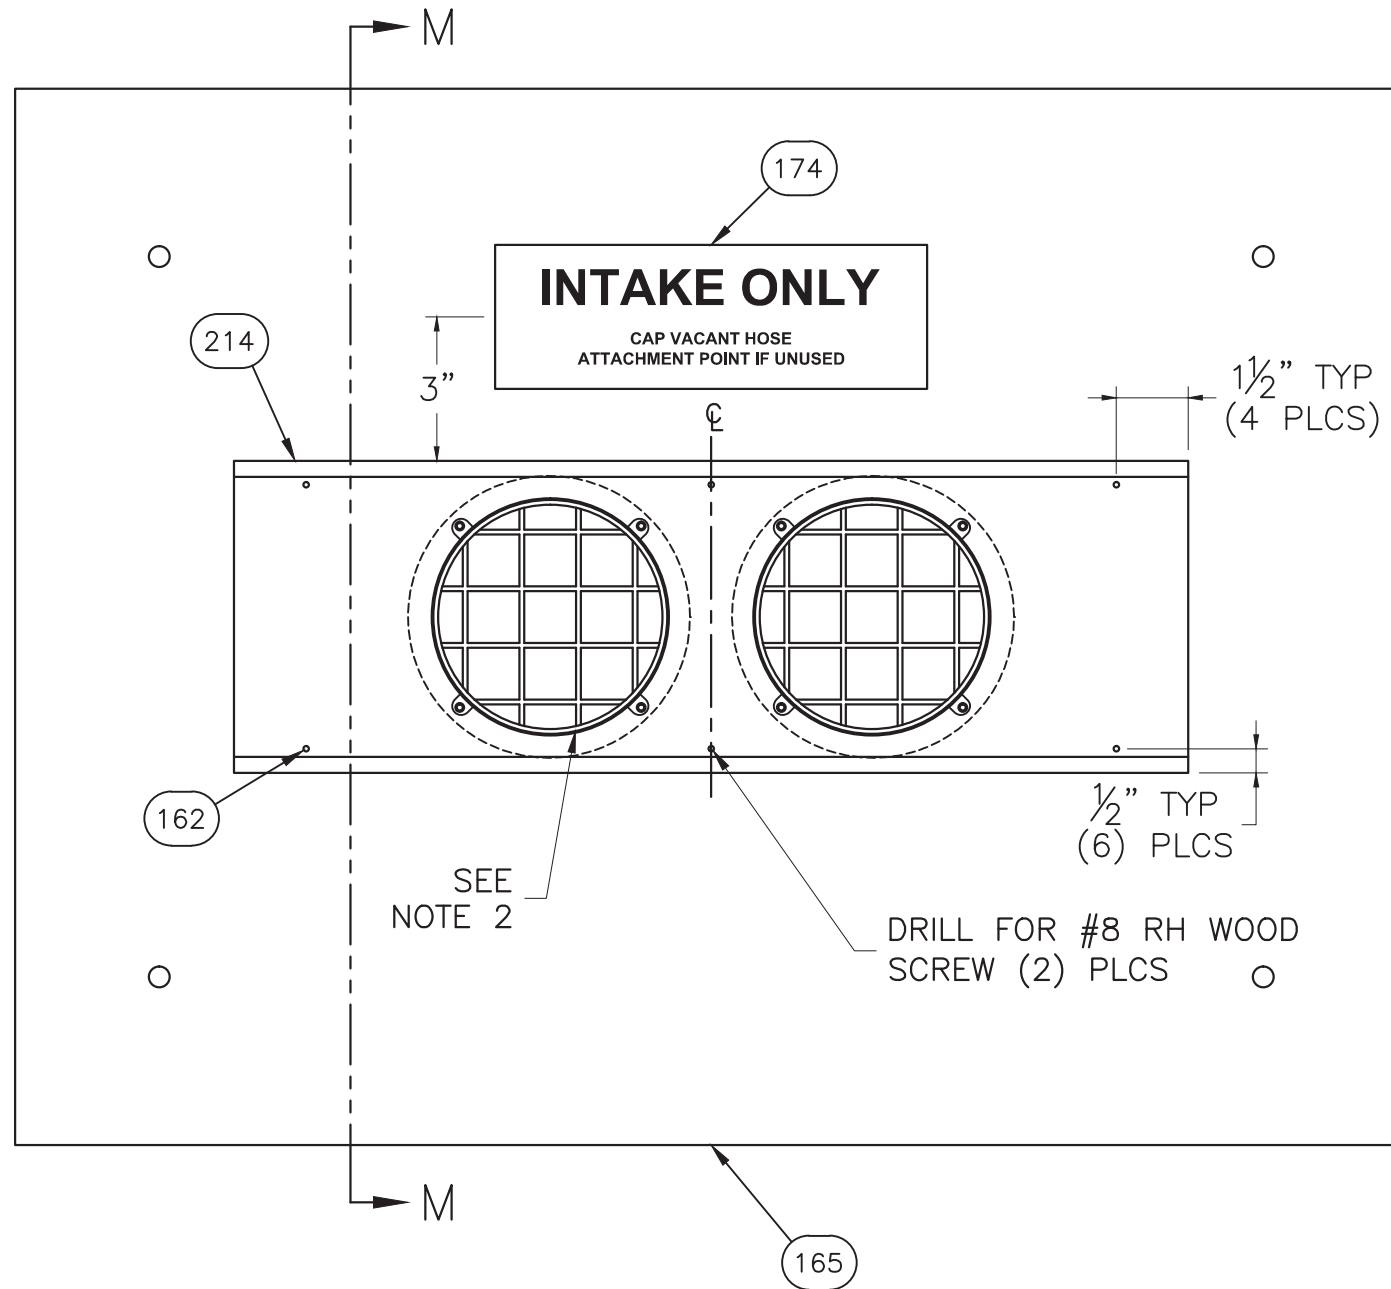

INTERIOR INTAKE PLATE  
(LOWER)

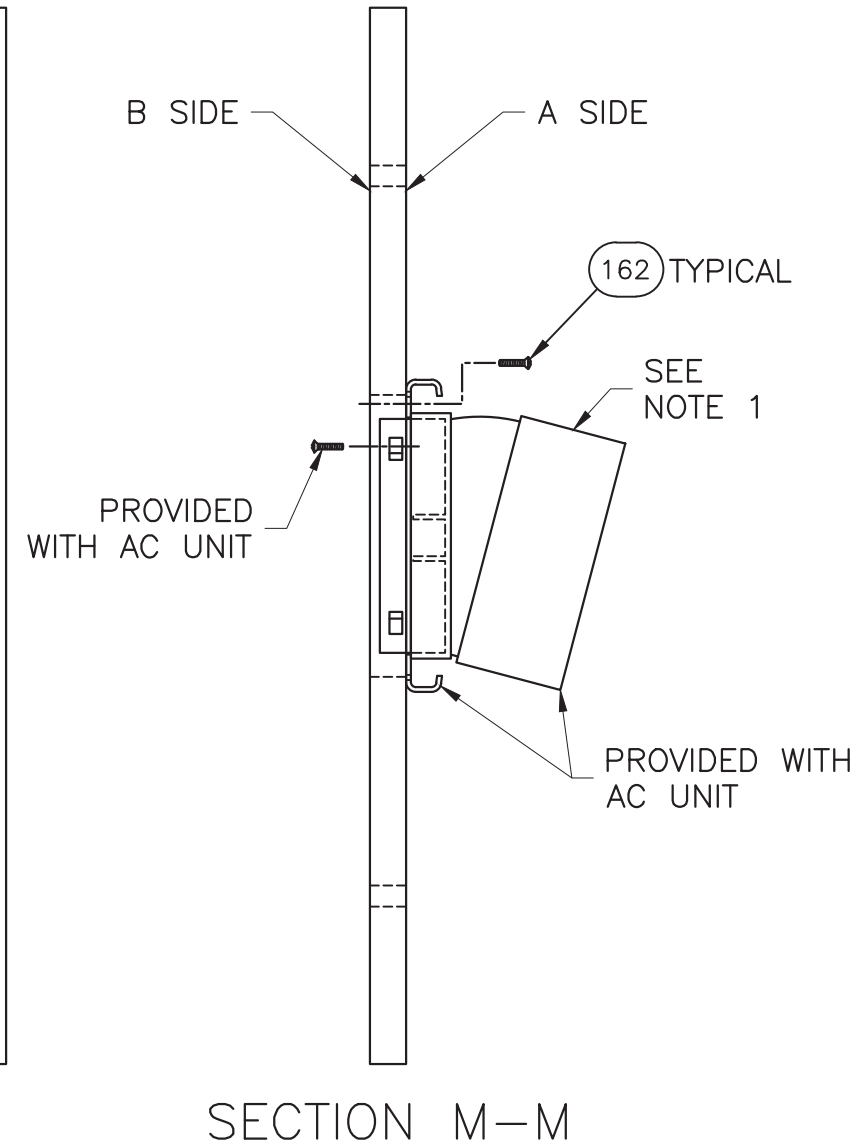

SECTION M-M

February 27, 2013

STATE OF MASSACHUSETTS  
 JOHN T. IRVING  
 No. 12678  
 PROFESSIONAL ENGINEER

THIS DRAWING IS THE CONFIDENTIAL PROPERTY AND CONTAINS TRADE SECRETS OF CELLXION, LLC. ANY USE OF THESE DRAWINGS OR THE INFORMATION CONTAINED HEREIN FOR ANY REASON OTHER THAN AS EXPRESSLY AUTHORIZED BY SABRE INDUSTRIES, INC. IS STRICTLY PROHIBITED. THIS DRAWING HAS BEEN DISTRIBUTED WITH THE UNDERSTANDING THAT ANYONE RECEIVING OR OTHERWISE OBTAINING POSSESSION OF IT WILL BE EXPRESSLY NOTIFIED OF ITS CONFIDENTIAL NATURE.

**Cellxion**  
 5031 Hazel Jones Road  
 Bossier City, Louisiana 71111  
 voice: (318) 213-2900  
 fax: (318) 213-2919  
 www.cellxion.com

CUSTOMER:  
 KELLOGG  
 BROWN & ROOT  
 FEMA (PEP)  
 EXPANSION PROGRAM


PROJECT:  
 10'-0" X 18'-0"  
 CONCRETE SHELTER  
 INT. INTAKE PLATE  
 ASSEMBLY (LOWER)

FILENAME: KBR/SKBR02	
SCALE: N.T.S.	TOLERANCE:
DRWN. BY: M. FOWLER	DATE: 03/24/2010
CHK. BY: V. HASSELL	DATE: 03/24/2010
ENG. BY:	DATE:
APP. BY: A. DUMAS	DATE: 03/24/2010
SHEET NO. 6-2	
DRAWING NO.: SKBR02	REV.: P


P	RRG	10/31/12	ADDED SHEET	LJL	10/31/12
REV	BY	DATE	DESCRIPTION	APP.BY	DATE

NOTES:

1. ELBOW NOT SHOWN IN PLAN VIEW FOR CLARITY

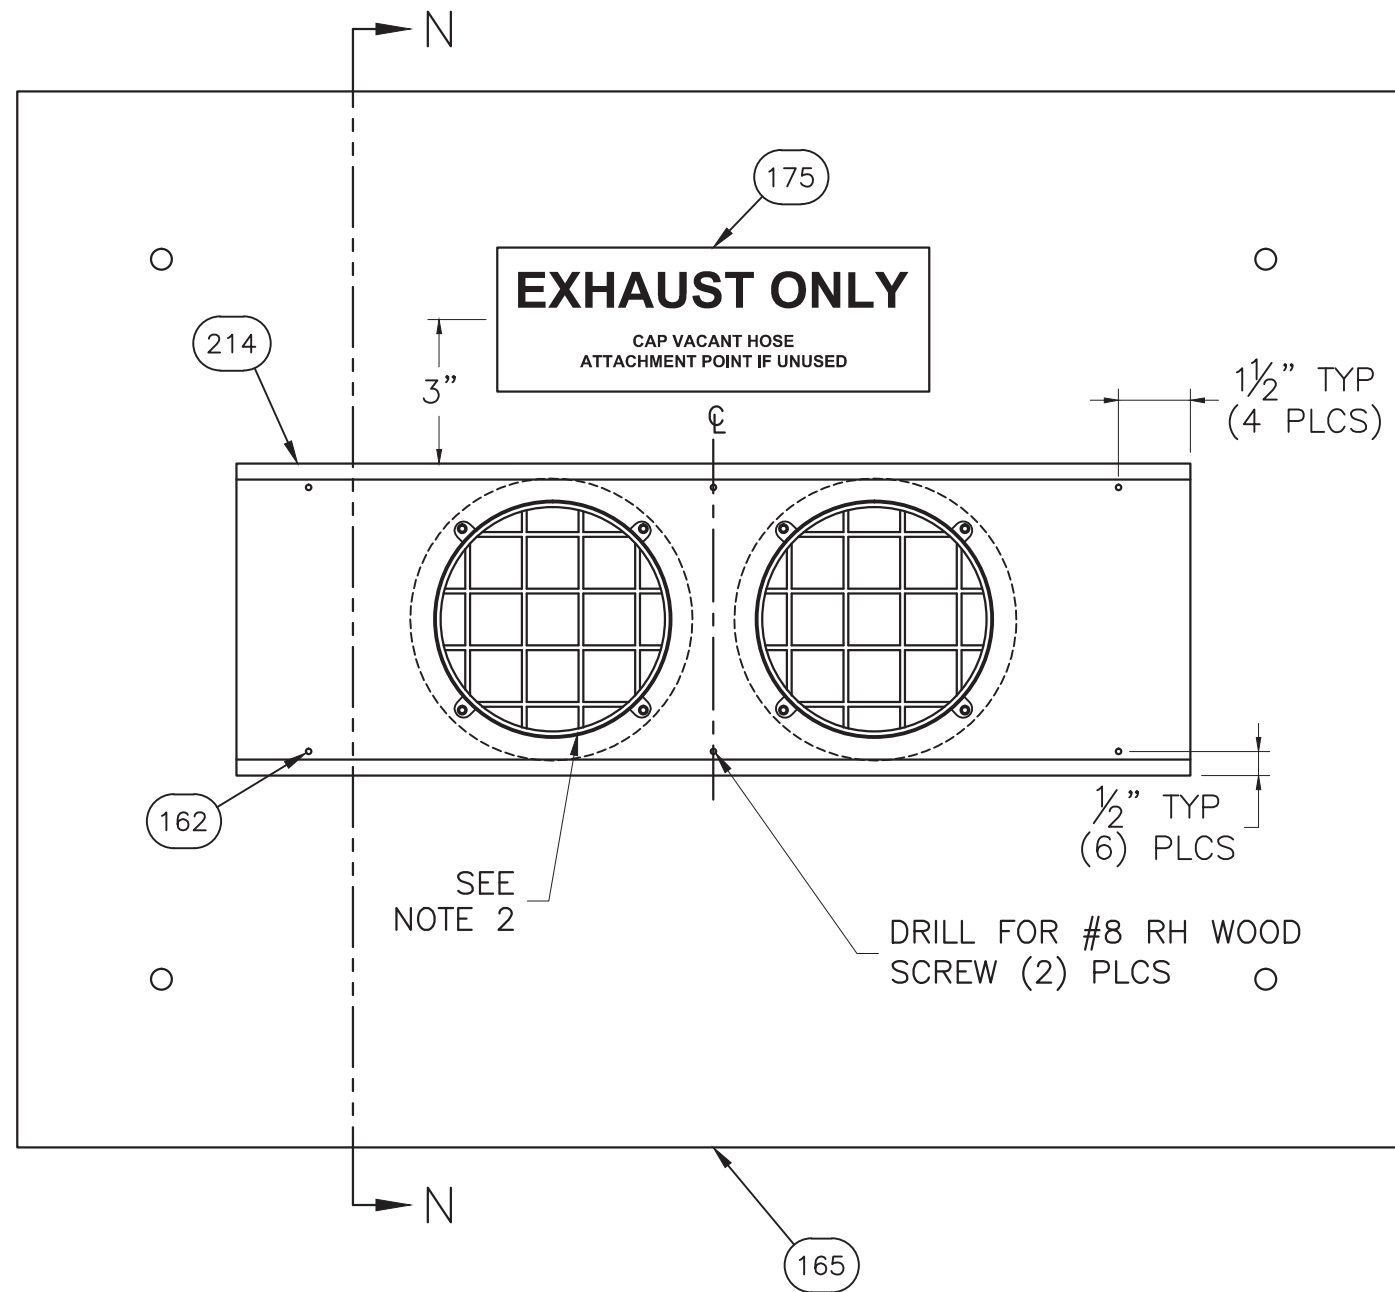

INTERIOR EXHAUST PLATE  
(UPPER)

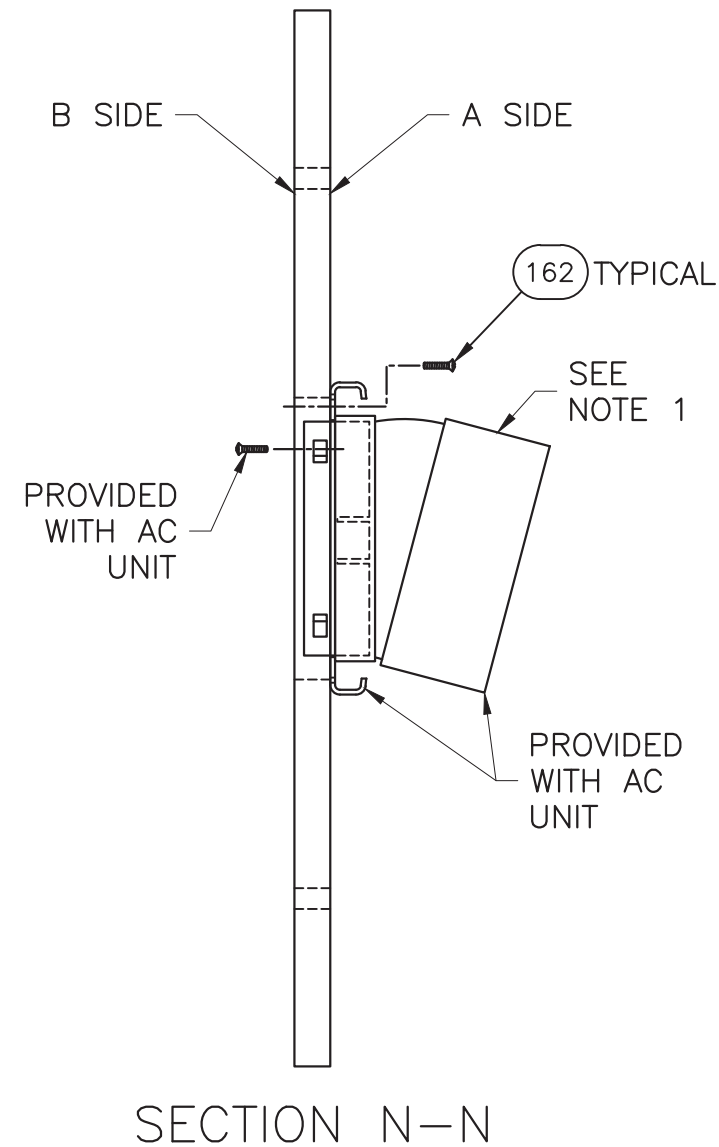

February 27, 2013



THIS DRAWING IS THE CONFIDENTIAL PROPERTY AND CONTAINS TRADE SECRETS OF CELLIXION, LLC. ANY USE OF THESE DRAWINGS OR THE INFORMATION CONTAINED HEREIN FOR ANY REASON OTHER THAN AS EXPRESSLY AUTHORIZED BY SABRE INDUSTRIES, INC. IS STRICTLY PROHIBITED. THIS DRAWING HAS BEEN DISTRIBUTED WITH THE UNDERSTANDING THAT ANYONE RECEIVING OR OTHERWISE OBTAINING POSSESSION OF IT WILL BE EXPRESSLY NOTIFIED OF ITS CONFIDENTIAL NATURE.

**cellixion**  
 5031 Hazel Jones Road  
 Bossier City, Louisiana 71111  
 voice: (318) 213-2900  
 fax: (318) 213-2919  
 www.cellixion.com

CUSTOMER:  
**KELLOGG  
 BROWN & ROOT  
 FEMA (PEP)  
 EXPANSION PROGRAM**


PROJECT:  
**10'-0" X 18'-0"  
 CONCRETE SHELTER  
 INT. EXHAUST PLATE  
 ASSEMBLY (UPPER)**

FILENAME: KBR/SKBRO2	
SCALE: N.T.S.	TOLERANCE:
DRWN. BY: M. FOWLER	DATE: 03/24/2010
CHK. BY: V. HASSELL	DATE: 03/24/2010
ENG. BY:	DATE:
APP. BY: A. DUMAS	DATE: 03/24/2010
SHEET NO. 6-3	
DRAWING NO.: SKBR02	REV.: P

P	RRG	10/31/12	ADDED SHEET	LJL	10/31/12
REV	BY	DATE	DESCRIPTION	APP. BY	DATE



February 27, 2013

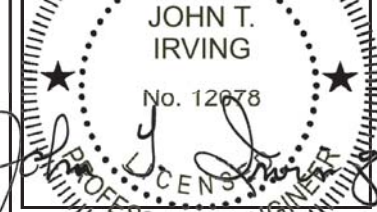


THIS DRAWING IS THE CONFIDENTIAL PROPERTY AND CONTAINS TRADE SECRETS OF CELLIXION, LLC. ANY USE OF THESE DRAWINGS OR THE INFORMATION CONTAINED HEREIN FOR ANY REASON OTHER THAN AS EXPRESSLY AUTHORIZED BY SABRE INDUSTRIES, INC. IS STRICTLY PROHIBITED. THIS DRAWING HAS BEEN DISTRIBUTED WITH THE UNDERSTANDING THAT ANYONE RECEIVING OR OTHERWISE OBTAINING POSSESSION OF IT WILL BE EXPRESSLY NOTIFIED OF ITS CONFIDENTIAL NATURE.

**Cellixion**  
 5031 Hazel Jones Road  
 Bossier City, Louisiana 71111  
 voice: (318) 213-2900  
 fax: (318) 213-2919  
 www.cellixion.com


CUSTOMER:  
**KELLOGG  
 BROWN & ROOT  
 FEMA (PEP)  
 EXPANSION PROGRAM**

PROJECT:  
**10'-0" X 18'-0"  
 CONCRETE SHELTER  
 EXT. EXHAUST PLATE  
 ASSEMBLY (UPPER)**

FILENAME: KBR/SKBRO2	
SCALE: N.T.S.	TOLERANCE:
DRWN. BY: M. FOWLER	DATE: 03/24/2010
CHK. BY: V. HASSELL	DATE: 03/24/2010
ENG. BY:	DATE:
APP. BY: A. DUMAS	DATE: 03/24/2010
SHEET NO. 6-4	
DRAWING NO.: SKBR02	REV.: P

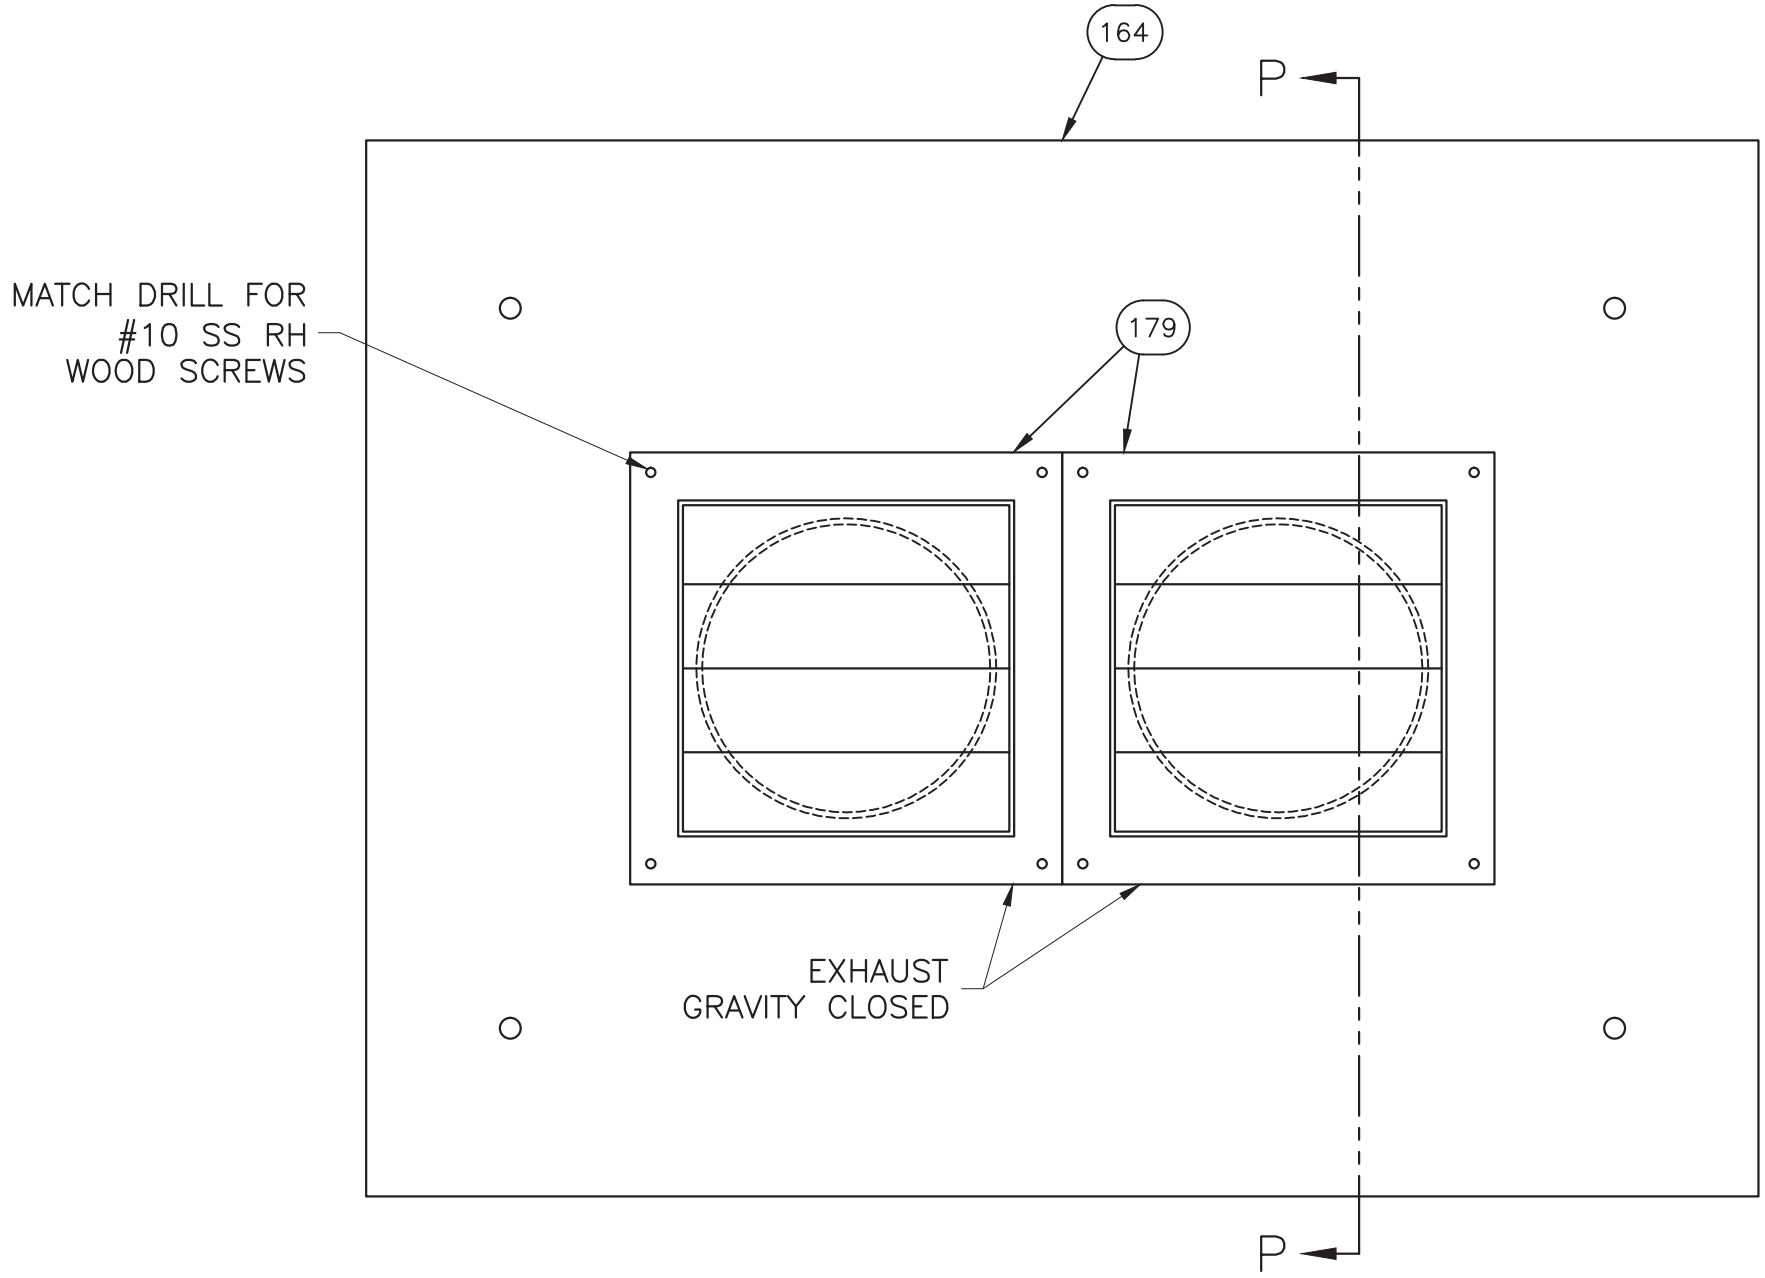

EXTERIOR EXHAUST PLATE  
 (UPPER)

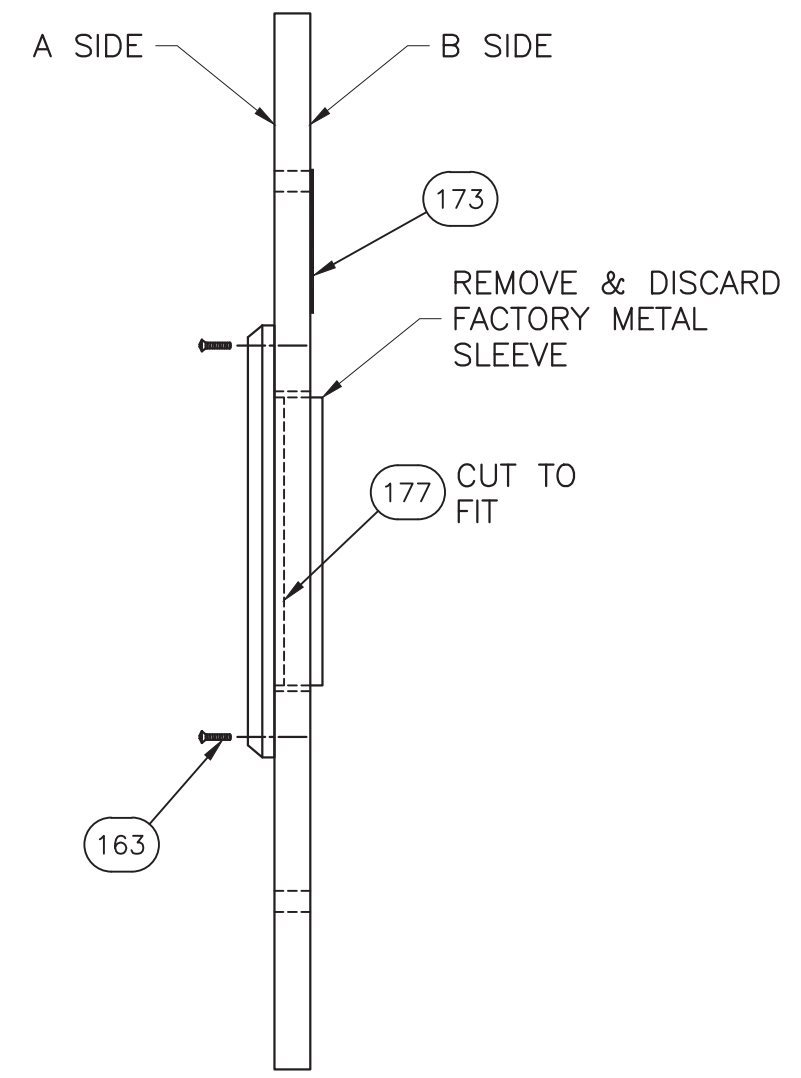

SECTION P-P

P	RRG	10/31/12	ADDED SHEET	LJL	10/31/12
REV	BY	DATE	DESCRIPTION	APP. BY	DATE

February 27, 2013

STATE OF MISSISSIPPI  
 JOHN T. IRVING  
 No. 12678  
 PROFESSIONAL ENGINEER


THIS DRAWING IS THE CONFIDENTIAL PROPERTY AND CONTAINS TRADE SECRETS OF CELLIXION, LLC. ANY USE OF THESE DRAWINGS OR THE INFORMATION CONTAINED HEREIN FOR ANY REASON OTHER THAN AS EXPRESSLY AUTHORIZED BY SABRE INDUSTRIES, INC. IS STRICTLY PROHIBITED. THIS DRAWING HAS BEEN DISTRIBUTED WITH THE UNDERSTANDING THAT ANYONE RECEIVING OR OTHERWISE OBTAINING POSSESSION OF IT WILL BE EXPRESSLY NOTIFIED OF ITS CONFIDENTIAL NATURE.

**cellixon**  
 5031 Hazel Jones Road  
 Bossier City, Louisiana 71111  
 voice: (318) 213-2900  
 fax: (318) 213-2919  
 www.cellixon.com


CUSTOMER:  
 KELLOGG  
 BROWN & ROOT  
 FEMA (PEP)  
 EXPANSION PROGRAM

PROJECT:  
 10'-0" X 18'-0"  
 CONCRETE SHELTER  
 EXT. INTAKE PLATE  
 ASSEMBLY (LOWER)

FILENAME: KBR/SKBRO2	
SCALE: N.T.S.	TOLERANCE:
DRWN. BY: M. FOWLER	DATE: 03/24/2010
CHK. BY: V. HASSELL	DATE: 03/24/2010
ENG. BY:	DATE:
APP. BY: A. DUMAS	DATE: 03/24/2010
SHEET NO. 6-5	
DRAWING NO.: SKBR02	REV.: P

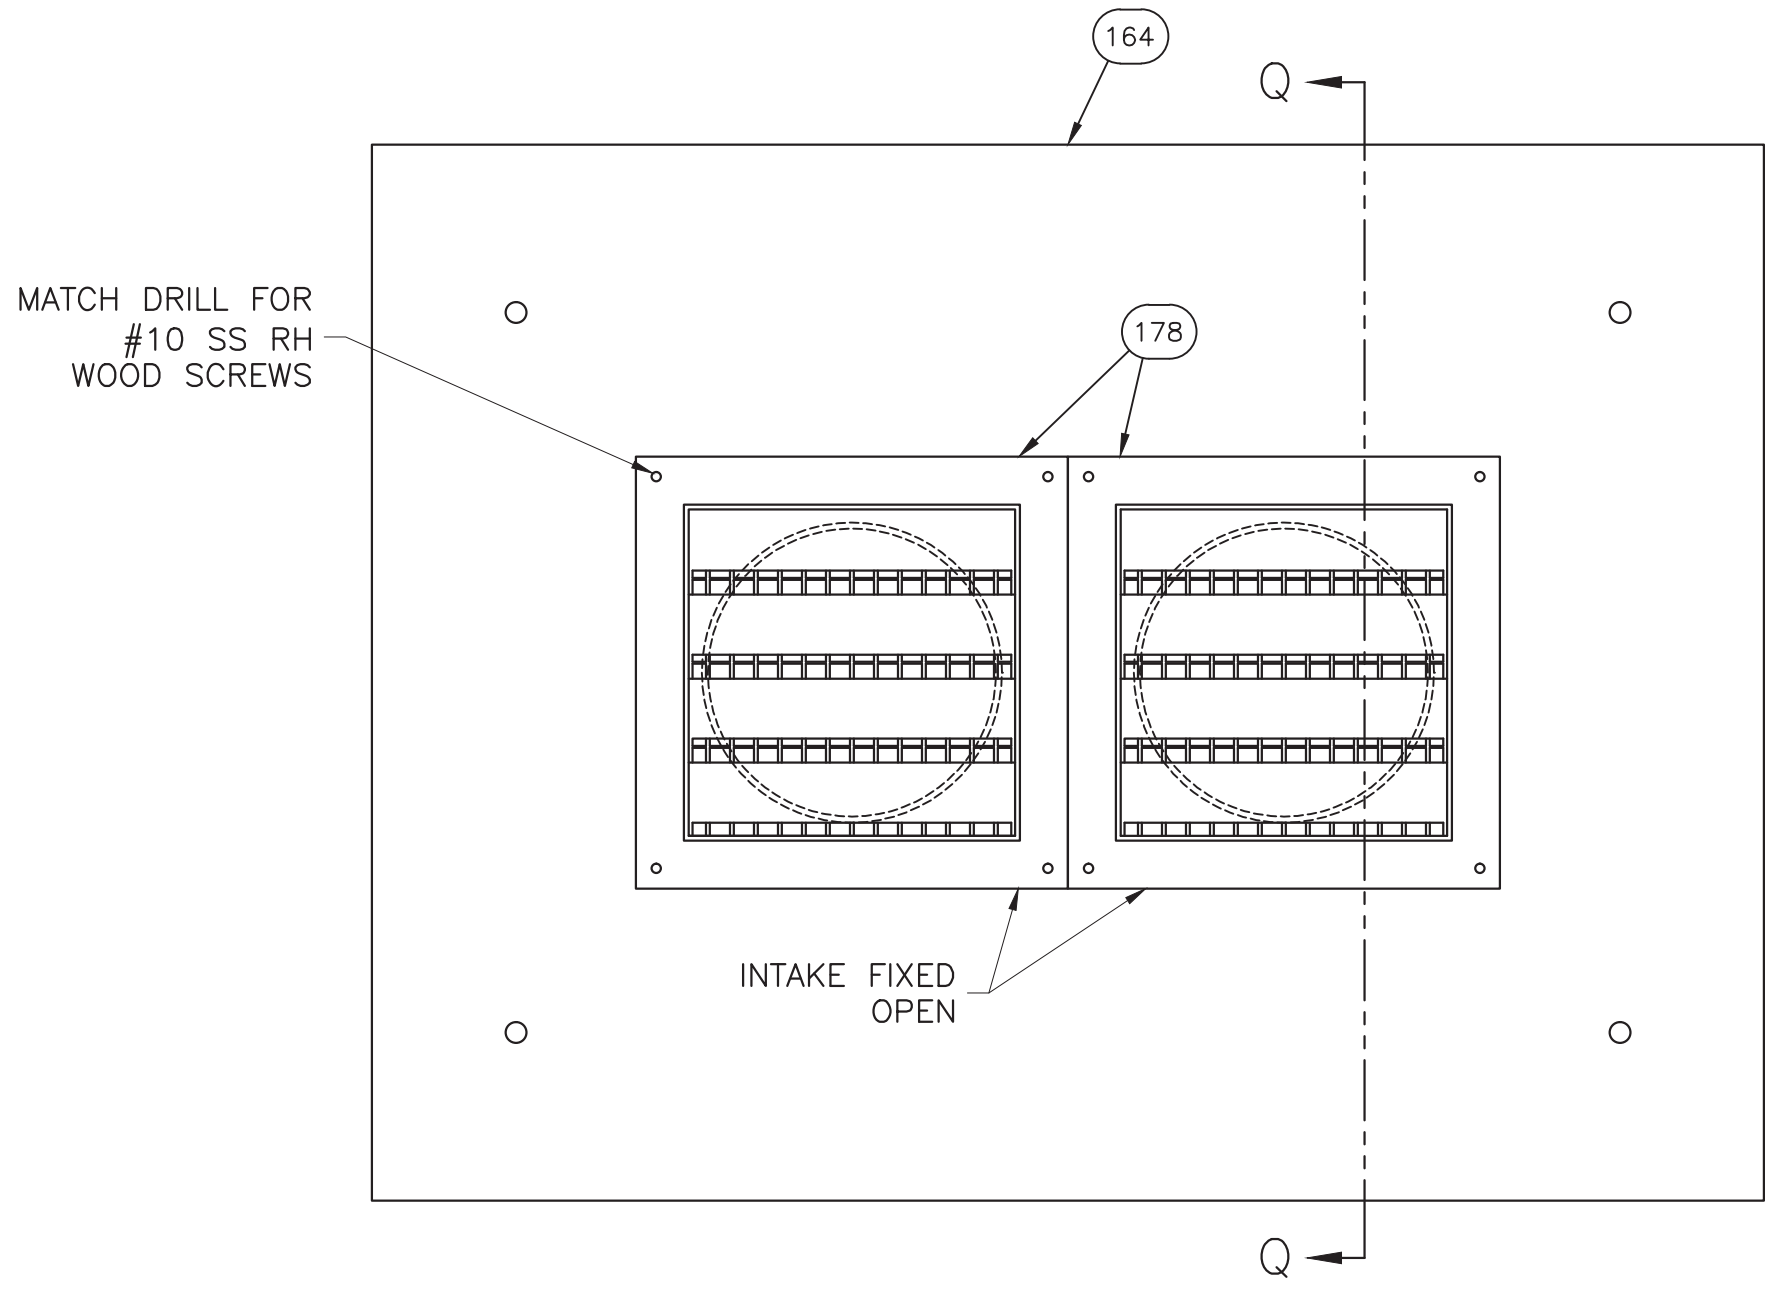

EXTERIOR INTAKE PLATE  
 (LOWER)

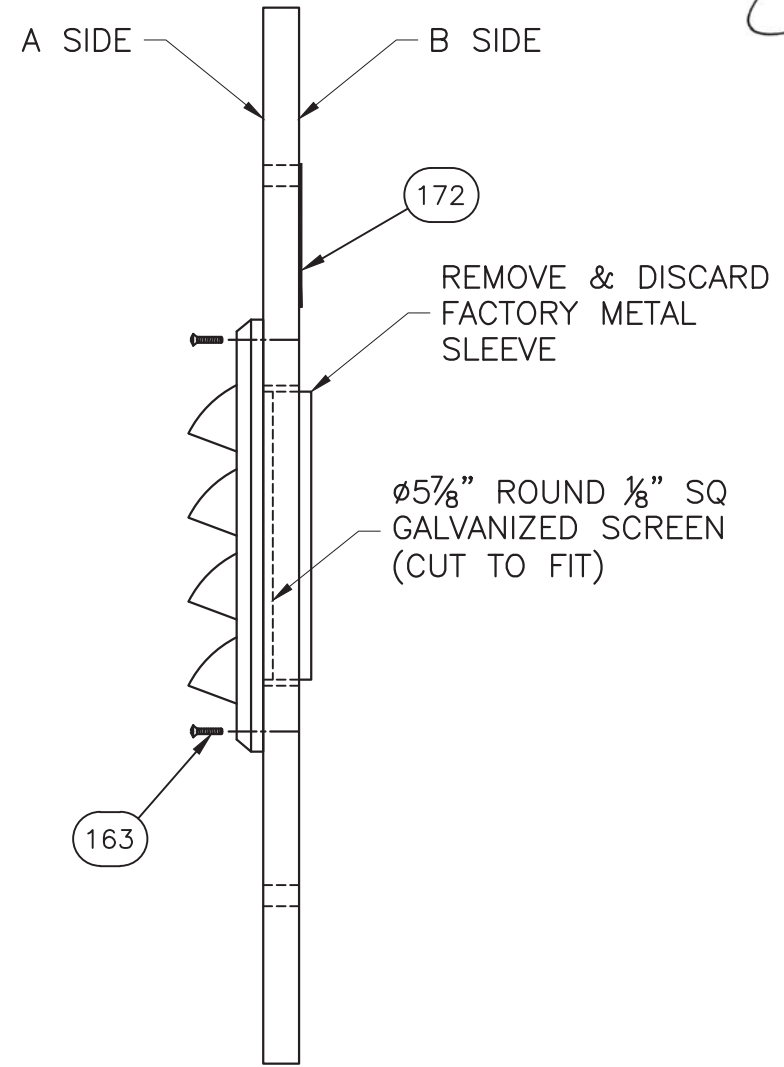


SECTION Q-Q

MATCH DRILL FOR  
 #10 SS RH  
 WOOD SCREWS

P	RRG	10/31/12	ADDED SHEET	LJL	10/31/12
REV	BY	DATE	DESCRIPTION	APP. BY	DATE

February 27, 2013

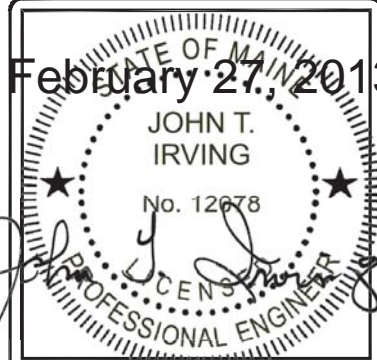


THIS DRAWING IS THE CONFIDENTIAL PROPERTY AND CONTAINS TRADE SECRETS OF CELLXION, LLC. ANY USE OF THESE DRAWINGS OR THE INFORMATION CONTAINED HEREIN FOR ANY REASON OTHER THAN AS EXPRESSLY AUTHORIZED BY SABRE INDUSTRIES, INC. IS STRICTLY PROHIBITED. THIS DRAWING HAS BEEN DISTRIBUTED WITH THE UNDERSTANDING THAT ANYONE RECEIVING OR OTHERWISE OBTAINING POSSESSION OF IT WILL BE EXPRESSLY NOTIFIED OF ITS CONFIDENTIAL NATURE.

**cellxion**  
 5031 Hazel Jones Road  
 Bossier City, Louisiana 71111  
 voice: (318) 213-2900  
 fax: (318) 213-2919  
 www.cellxion.com


CUSTOMER:  
**KELLOGG  
 BROWN & ROOT  
 FEMA (PEP)  
 EXPANSION PROGRAM**

PROJECT:  
**10'-0" X 18'-0"  
 CONCRETE SHELTER  
 INTERIOR PANELING  
 CONNECTIONS DETAILS**

FILENAME: KBR/SKBR02	
SCALE: N.T.S.	TOLERANCE:
DRWN. BY: M. FOWLER	DATE: 03/24/2010
CHK. BY: V. HASSELL	DATE: 03/24/2010
ENG. BY:	DATE:
APP. BY: A. DUMAS	DATE: 03/24/2010
SHEET NO. 7-0	
DRAWING NO.: SKBR02	REV.: P

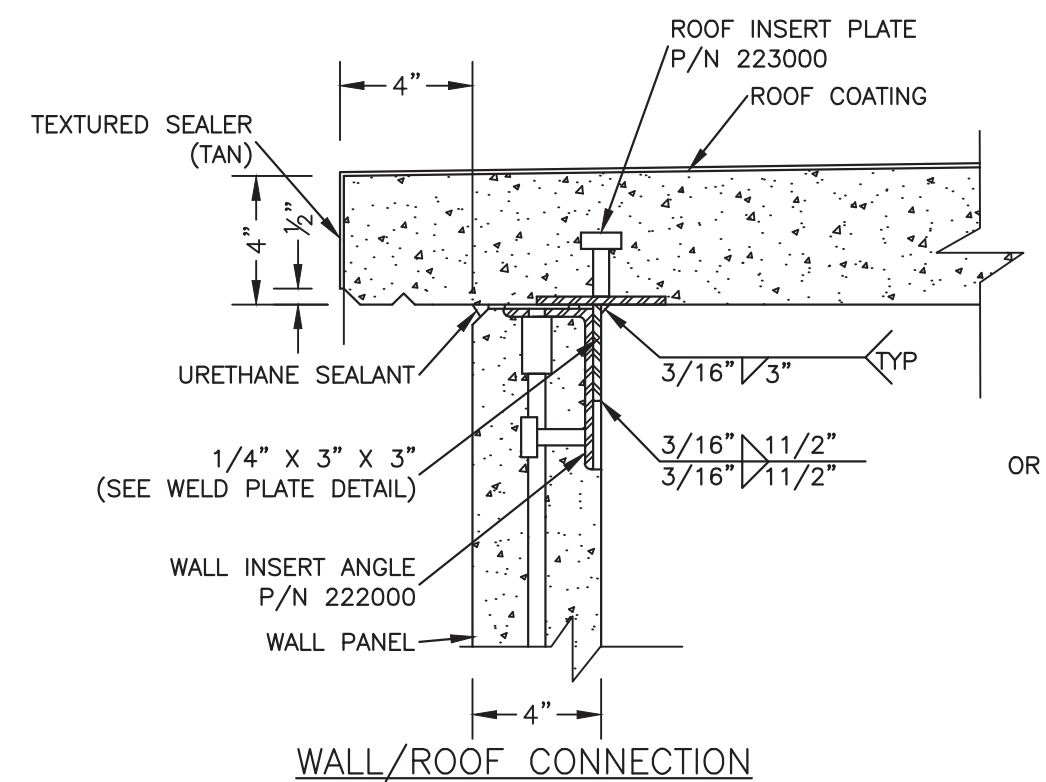


WALL/ROOF CONNECTION

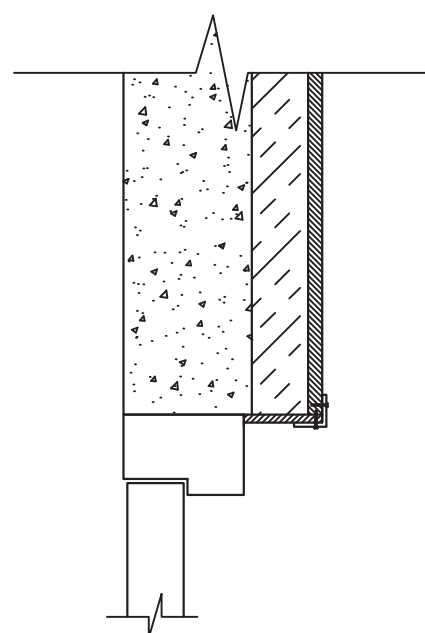


TYP DOOR SECTION TRIM DETAIL

NOTES:


1. INSTALL INTERIOR PANELS W/ CONCRETE SCREWS (LENGTH MAY VARY) 24" O.C. MAX ALONG LENGTH OF PANELS. (NO FASTENERS REQUIRED ALONG SHORT SIDE OF PANELS IF PANEL EDGE IS AT A CORNER)
2. MAX GAP BETWEEN PANELS TO BE 1/4"
3. USE COVE TRIM IN ALL CORNERS AND AROUND TOP PERIMETER. INSTALL USING 3/4" BRAD NAILS.
4. TRIM ALL EXPOSED OPENINGS W/ OUTSIDE CORNER TRIM.

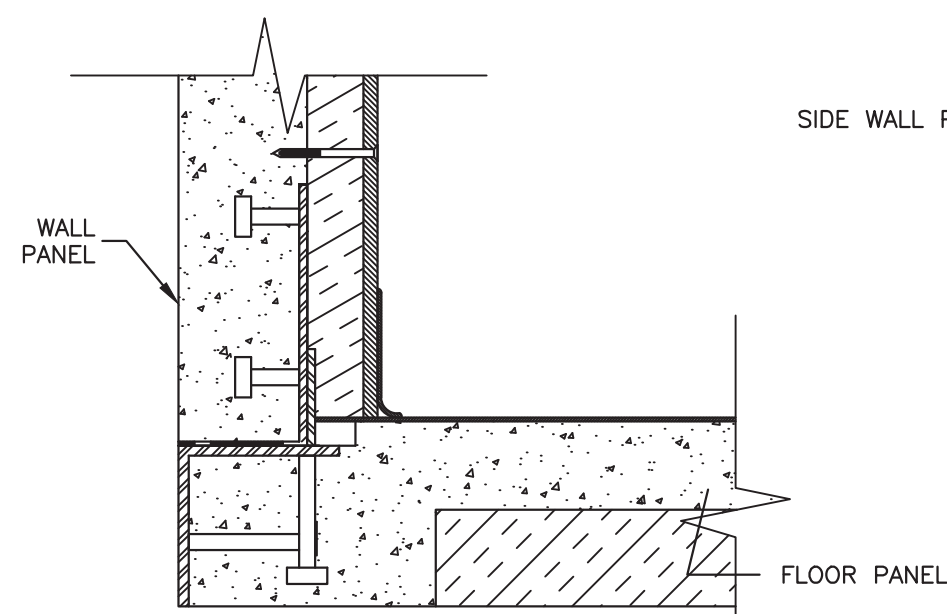

WALL/FLOOR SECTION

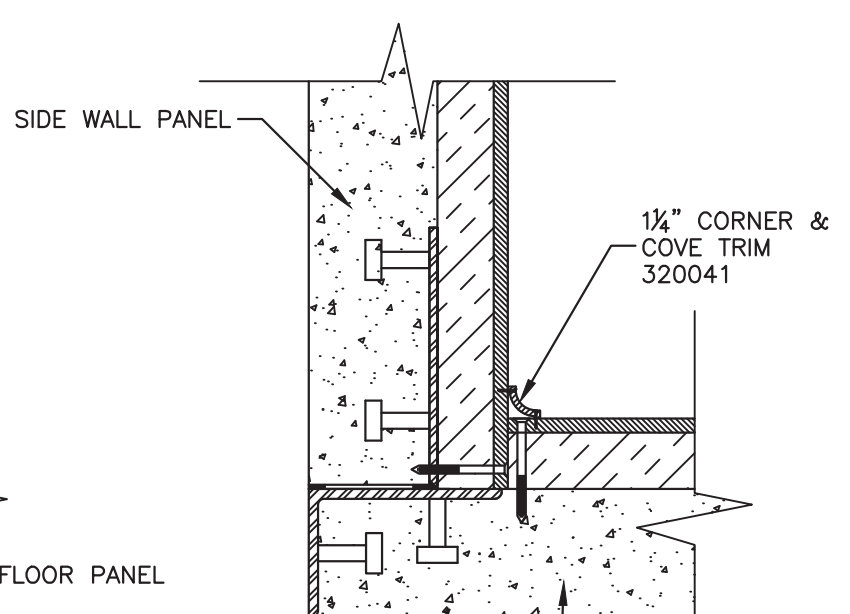


END WALL PANEL WALL/WALL SECTION

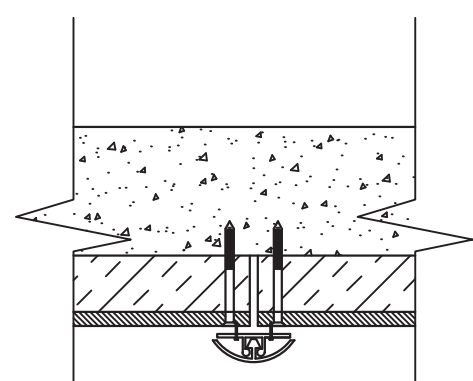

JOINT DETAIL PLAN VIEW SECTION

N	RRG	6/13/12	ADDED NOTE/CORRECTED SHEET TITLE	LJL	6/13/12
REV	BY	DATE	DESCRIPTION	APP. BY	DATE

February 27, 2013

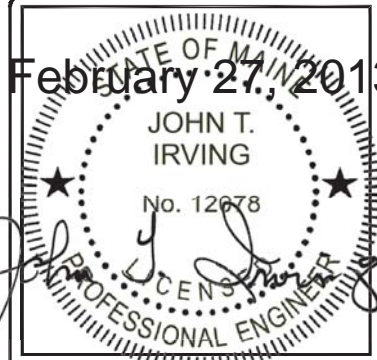


THIS DRAWING IS THE CONFIDENTIAL PROPERTY AND CONTAINS TRADE SECRETS OF CELLXION, LLC. ANY USE OF THESE DRAWINGS OR THE INFORMATION CONTAINED HEREIN FOR ANY REASON OTHER THAN AS EXPRESSLY AUTHORIZED BY SABRE INDUSTRIES, INC. IS STRICTLY PROHIBITED. THIS DRAWING HAS BEEN DISTRIBUTED WITH THE UNDERSTANDING THAT ANYONE RECEIVING OR OTHERWISE OBTAINING POSSESSION OF IT WILL BE EXPRESSLY NOTIFIED OF ITS CONFIDENTIAL NATURE.

**cellxion**  
 5031 Hazel Jones Road  
 Bossier City, Louisiana 71111  
 voice: (318) 213-2900  
 fax: (318) 213-2919  
 www.cellxion.com

CUSTOMER:  
**KELLOGG  
 BROWN & ROOT  
 FEMA (PEP)  
 EXPANSION PROGRAM**

PROJECT:  
**10'-0" X 18'-0"  
 CONCRETE SHELTER  
 INT. PANELING INSTALL  
 R/U CALCULATIONS**

FILENAME: KBR/SKBR02	
SCALE: N.T.S.	TOLERANCE:
DRWN. BY: M. FOWLER	DATE: 03/24/2010
CHK. BY: V. HASSELL	DATE: 03/24/2010
ENG. BY:	DATE:
APP. BY: A. DUMAS	DATE: 03/24/2010
SHEET NO. 7-1	
DRAWING NO.: SKBR02	REV.: P

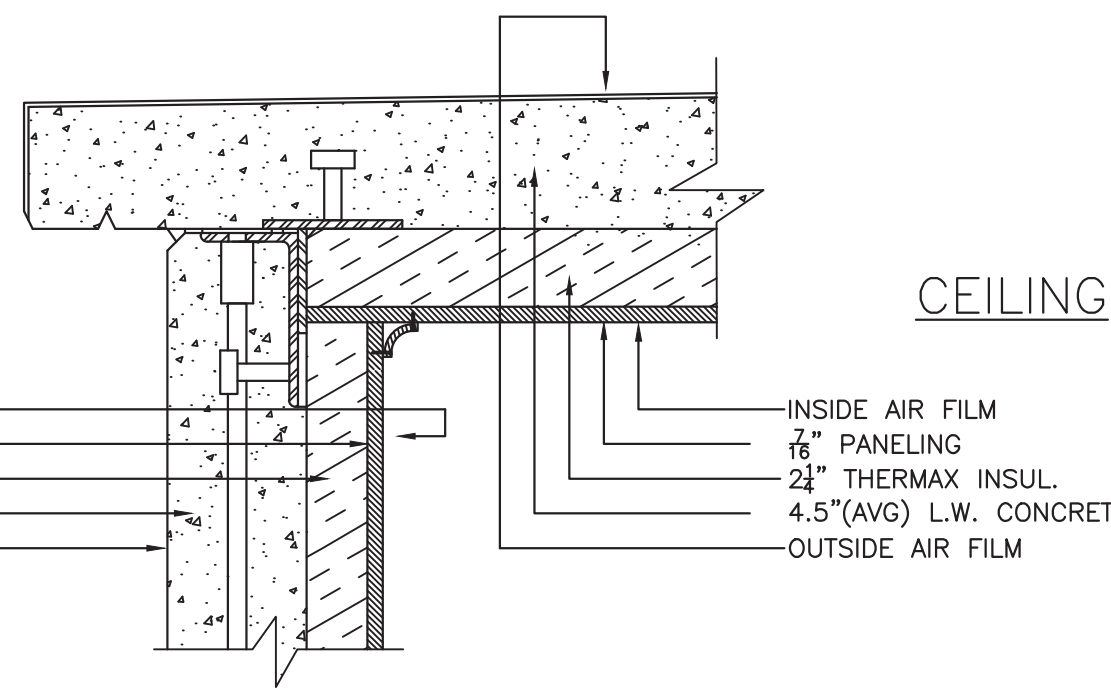

**WALL**

(HEAT CAPACITY = 8 BTU/\*F)


1.70	INSIDE AIR FILM
0.54	7/16" PANELING
11.20	1 3/4" THERMAX INSUL
1.36	4" L.W. CONCRETE
0.25	OUTSIDE AIR FILM
<hr/>	
15.05	OVERALL R-VALUE
0.066	OVERALL U-FACTOR

**CEILING**

0.61	INSIDE AIR FILM
0.54	7/16" PANELING
14.70	2 1/4" THERMAX INSUL.
1.53	4.5"(AVG) L.W. CONCRETE
0.25	OUTSIDE AIR FILM
<hr/>	
17.64	OVERALL R-VALUE
0.057	OVERALL U-FACTOR

**METAL DOOR**




4.167	OVERALL R-VALUE
0.240	OVERALL U-FACTOR

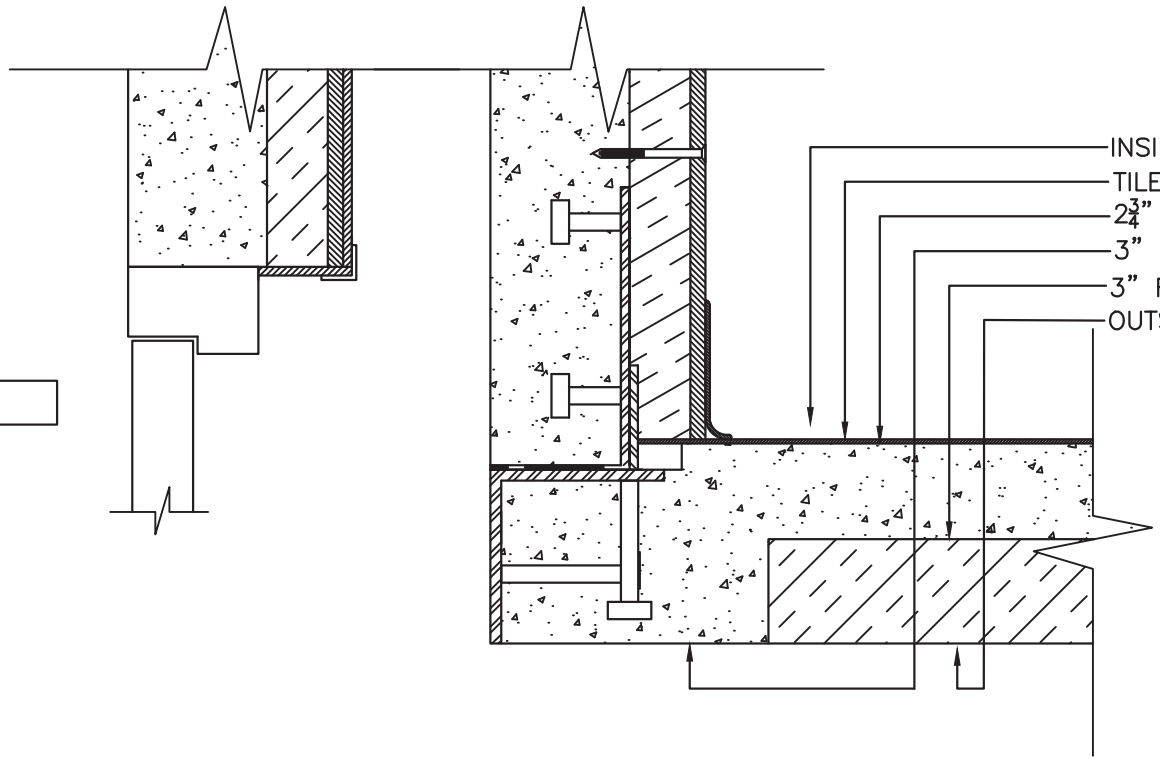


RIB	DECK
0.920	0.920
0.05	0.05
0.94	0.94
1.02	--
--	10.800
0.25	0.25
<hr/>	
2.140	12.460 TOTAL 'R'
0.467	0.080 TOTAL 'U'
0.286	0.714 SURFACE AREA RATIO
0.960	12.380 R-FACTOR PER SURFACE AREA
<hr/>	
0.191	OVERALL U-FACTOR
5.237	OVERALL R-VALUE

NOTES:

1. ALL REQUIRED TIE DOWN PLATES, SHIMS, BOLTS AND ANCHORS SHALL BE PLACED INSIDE SHELTER PRIOR TO SHIPMENT FROM MANUFACTURER
2. USE SHIMS AS REQUIRED TO ASSURE SHELTER IS BEARING AT PERIMETER. SEAL PERIMETER W/ CAULK OR GROUT AS DESIRED.

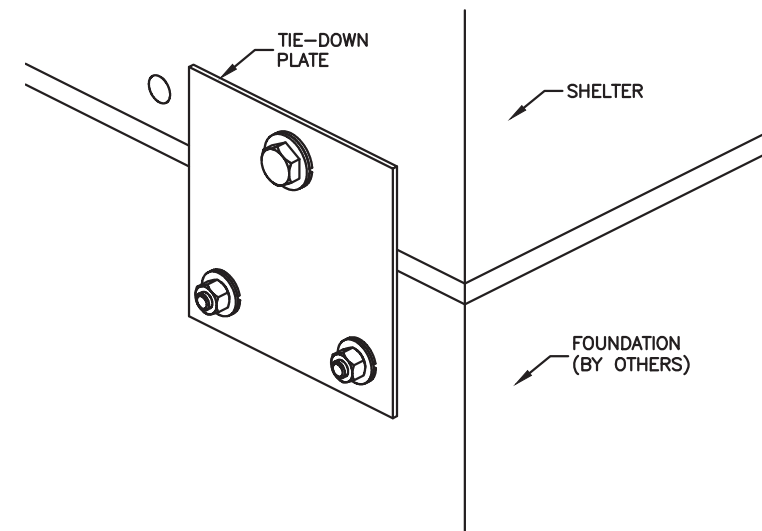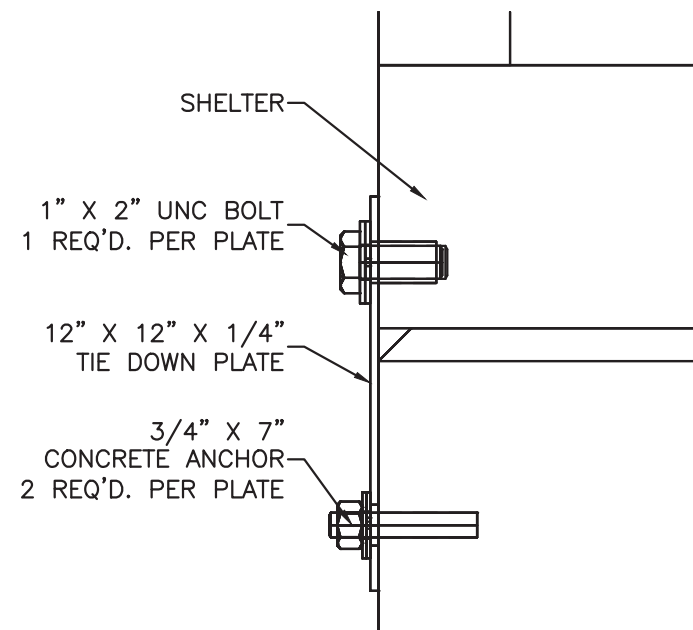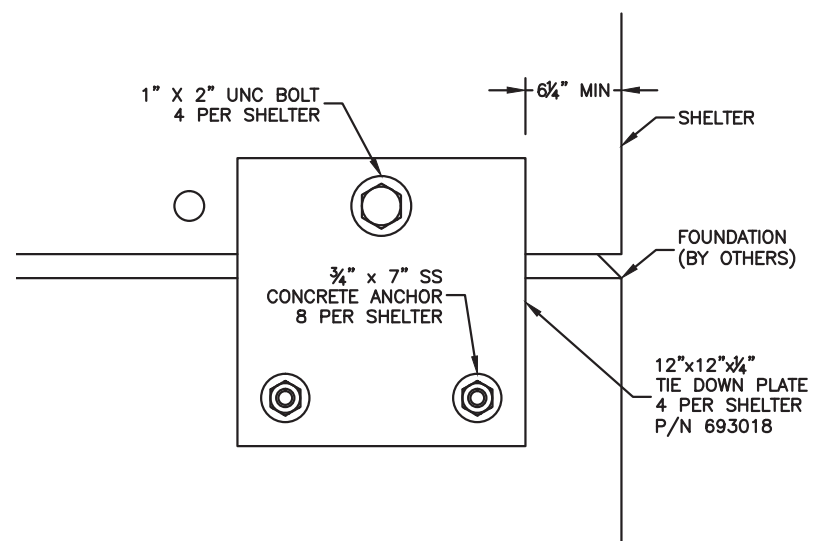

February 27, 2013

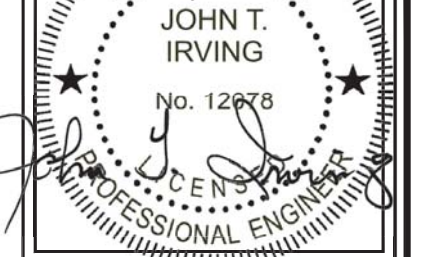

THIS DRAWING IS THE CONFIDENTIAL PROPERTY AND CONTAINS TRADE SECRETS OF CELLXION, LLC. ANY USE OF THESE DRAWINGS OR THE INFORMATION CONTAINED HEREIN FOR ANY REASON OTHER THAN AS EXPRESSLY AUTHORIZED BY SABRE INDUSTRIES, INC. IS STRICTLY PROHIBITED. THIS DRAWING HAS BEEN DISTRIBUTED WITH THE UNDERSTANDING THAT ANYONE RECEIVING OR OTHERWISE OBTAINING POSSESSION OF IT WILL BE EXPRESSLY NOTIFIED OF ITS CONFIDENTIAL NATURE.





5031 Hazel Jones Road  
Bossier City, Louisiana 71111  
voice: (318) 213-2900  
fax: (318) 213-2919  
www.cellxion.com

CUSTOMER:  
KELLOGG  
BROWN & ROOT  
FEMA (PEP)  
EXPANSION PROGRAM

PROJECT:  
10'-0" X 18'-0"  
CONCRETE SHELTER  
6" SLAB FOUNDATION  
FLAT TIEDOWN DETAILS

FILENAME: KBR/SKBR02	
SCALE: N.T.S.	TOLERANCE:
DRWN. BY: M. FOWLER	DATE: 03/24/2010
CHK. BY: V. HASSELL	DATE: 03/24/2010
ENG. BY:	DATE:
APP. BY: A. DUMAS	DATE: 03/24/2010
SHEET NO. 7-2	
DRAWING NO.: SKBR02	REV.: P



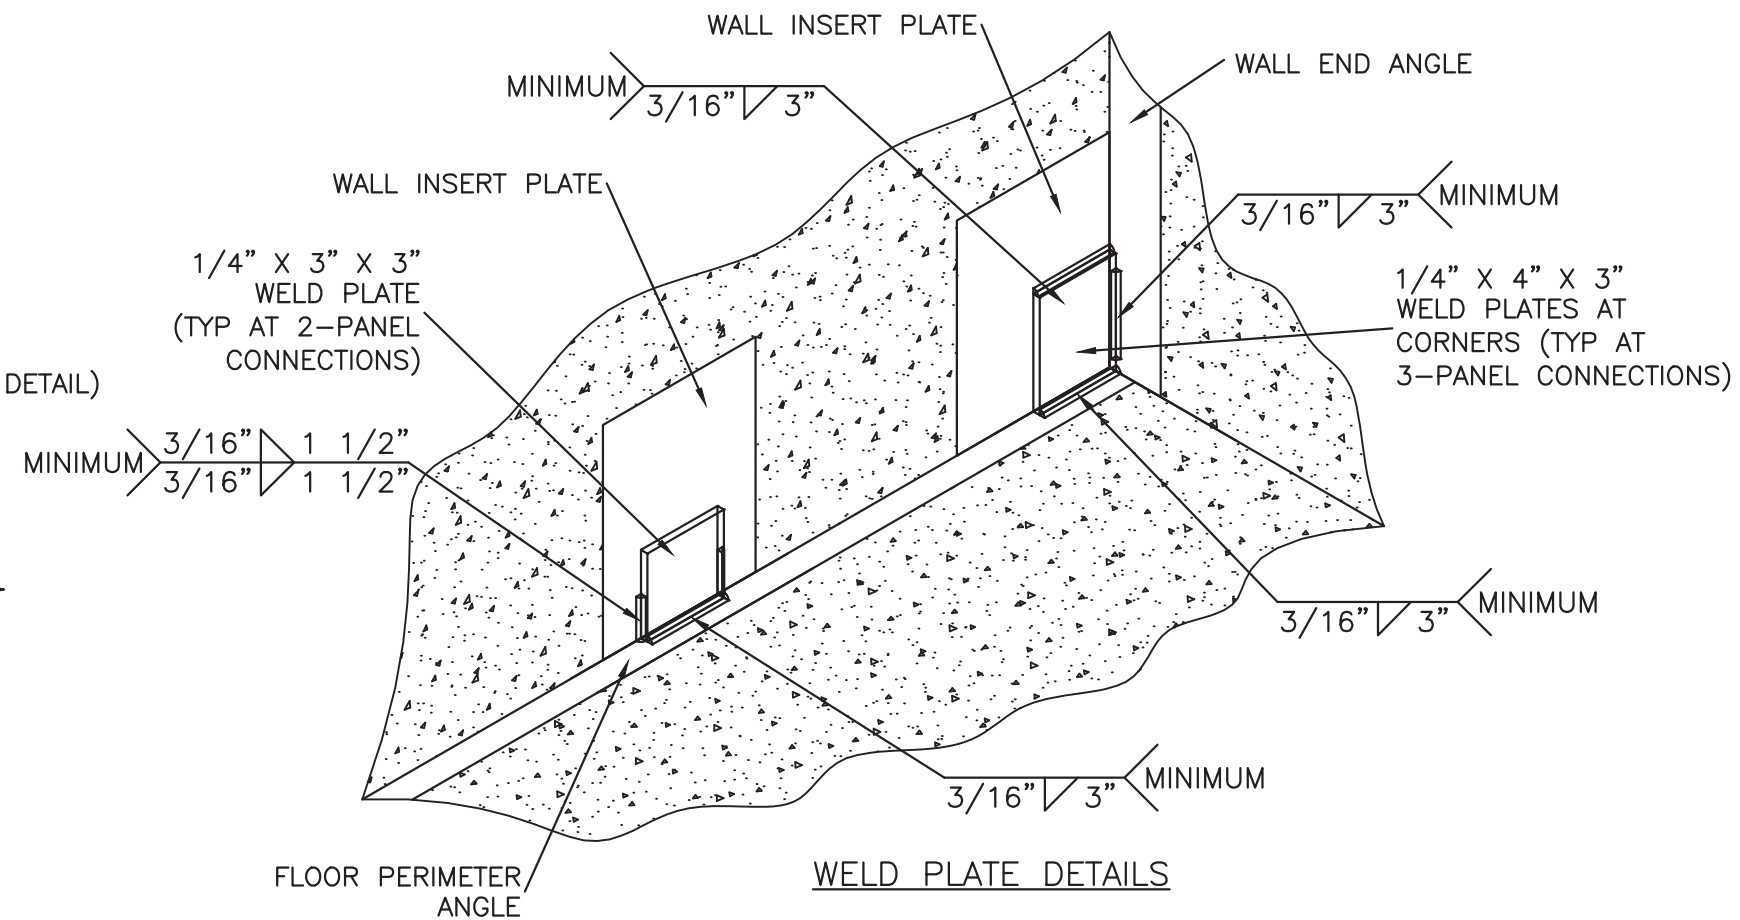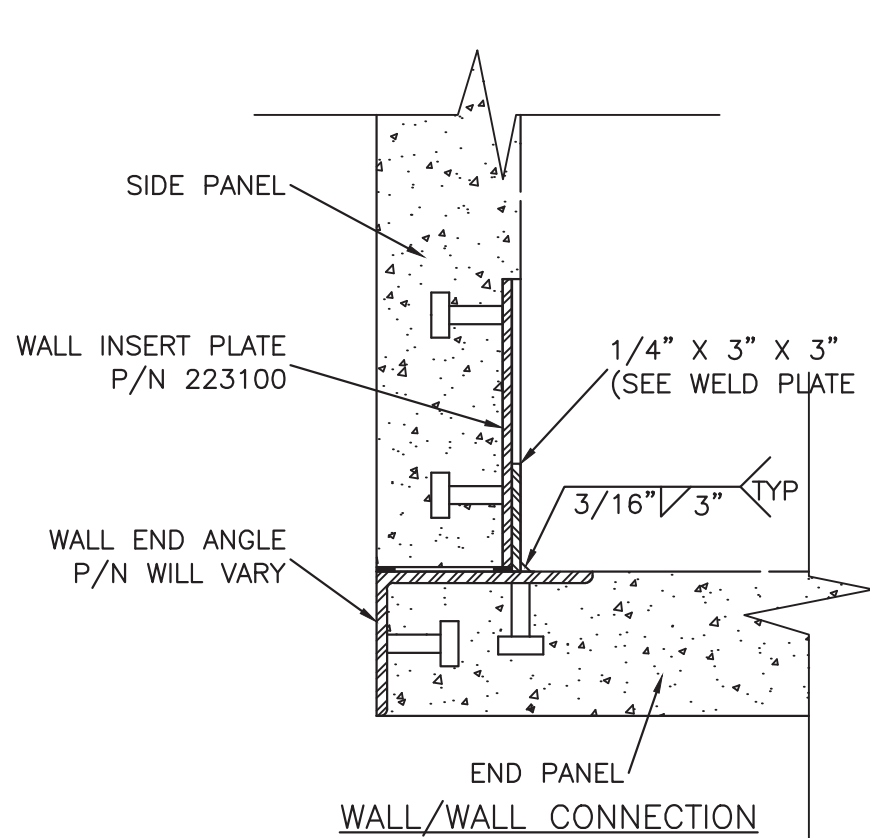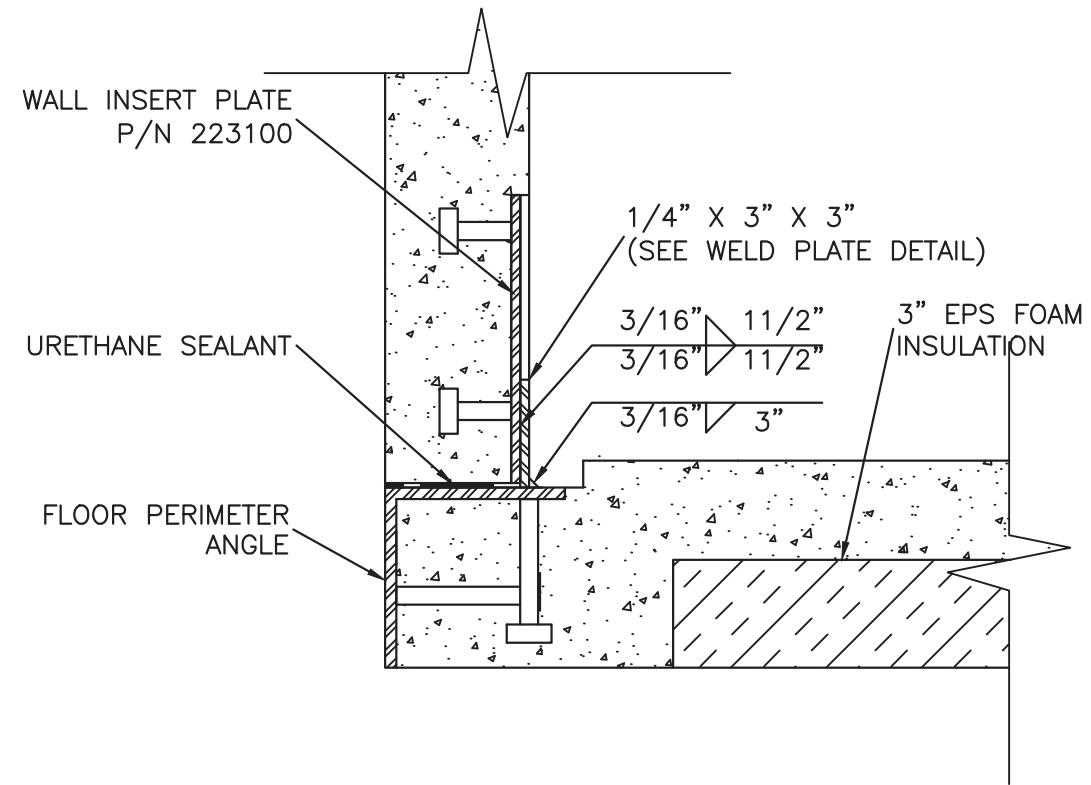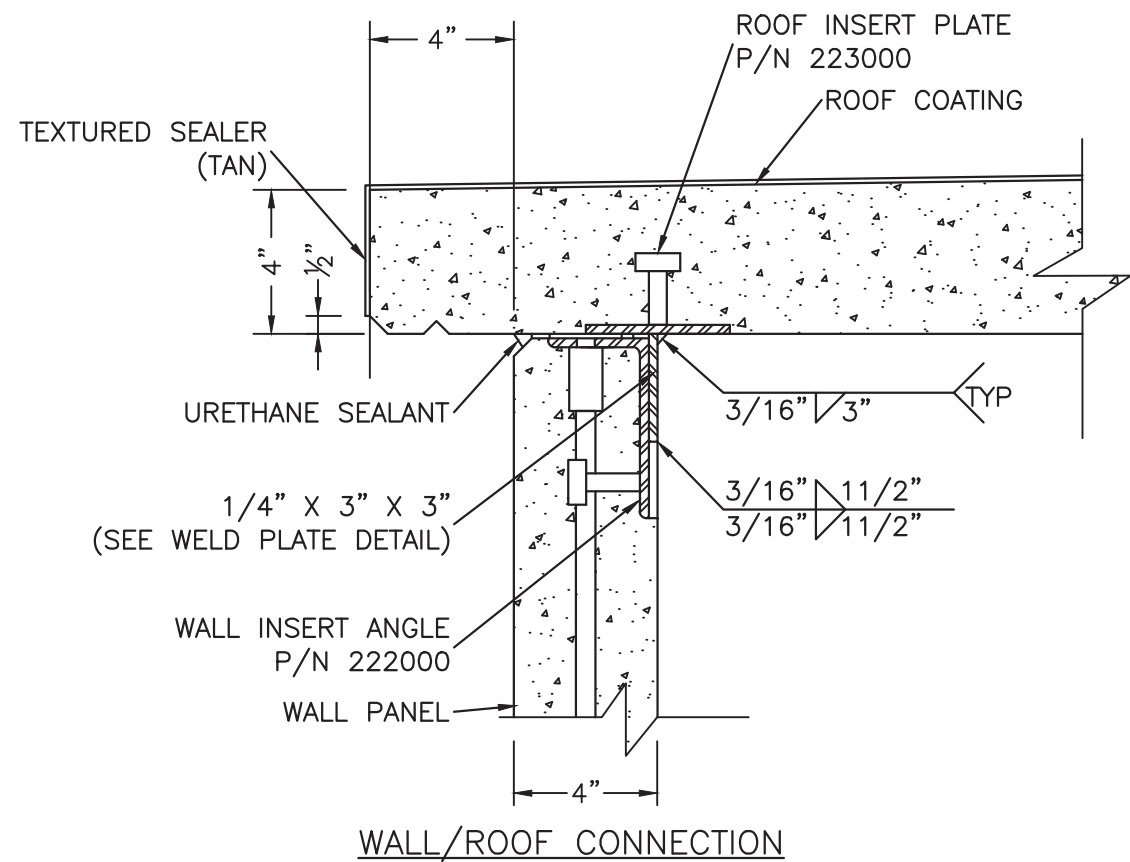

STATE OF MISSISSIPPI  
 February 27, 2013  
 JOHN T. IRVING  
 No. 12678  
 PROFESSIONAL ENGINEER

THIS DRAWING IS THE CONFIDENTIAL PROPERTY AND CONTAINS TRADE SECRETS OF CELLXION, LLC. ANY USE OF THESE DRAWINGS OR THE INFORMATION CONTAINED HEREIN FOR ANY REASON OTHER THAN AS EXPRESSLY AUTHORIZED BY SABRE INDUSTRIES, INC. IS STRICTLY PROHIBITED. THIS DRAWING HAS BEEN DISTRIBUTED WITH THE UNDERSTANDING THAT ANYONE RECEIVING OR OTHERWISE OBTAINING POSSESSION OF IT WILL BE EXPRESSLY NOTIFIED OF ITS CONFIDENTIAL NATURE.

**cellxion**  
 5031 Hazel Jones Road  
 Bossier City, Louisiana 71111  
 voice: (318) 213-2900  
 fax: (318) 213-2919  
 www.cellxion.com

CUSTOMER:  
**KELLOGG  
 BROWN & ROOT  
 FEMA (PEP)  
 EXPANSION PROGRAM**


PROJECT:  
**10'-0" X 18'-0"  
 CONCRETE SHELTER  
 PANEL CONNECTION  
 DETAILS**

FILENAME: KBR/SKBR02	
SCALE: N.T.S.	TOLERANCE:
DRWN. BY: M. FOWLER	DATE: 03/24/2010
CHK. BY: V. HASSELL	DATE: 03/24/2010
ENG. BY:	DATE:
APP. BY: A. DUMAS	DATE: 03/24/2010
SHEET NO. 7-3	
DRAWING NO.: SKBR02	REV.: P



EPOXY PLUG TO PREVENT WATER LEAKAGE (TOP & BOTTOM)

NOTE:  
1. CUT OUT BACK OF BOX TO FIX CENTERED OVER 2X4 KEYSWITCH BOX.

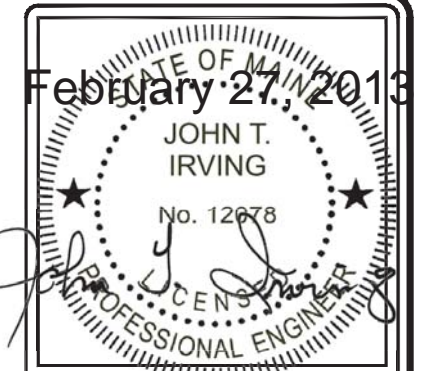


THIS DRAWING IS THE CONFIDENTIAL PROPERTY AND CONTAINS TRADE SECRETS OF CELLXION, LLC. ANY USE OF THESE DRAWINGS OR THE INFORMATION CONTAINED HEREIN FOR ANY REASON OTHER THAN AS EXPRESSLY AUTHORIZED BY SABRE INDUSTRIES, INC. IS STRICTLY PROHIBITED. THIS DRAWING HAS BEEN DISTRIBUTED WITH THE UNDERSTANDING THAT ANYONE RECEIVING OR OTHERWISE OBTAINING POSSESSION OF IT WILL BE EXPRESSLY NOTIFIED OF ITS CONFIDENTIAL NATURE.

**cellxion**  
5031 Hazel Jones Road  
Bossier City, Louisiana 71111  
voice: (318) 213-2900  
fax: (318) 213-2919  
www.cellxion.com


CUSTOMER:  
**KELLOGG  
BROWN & ROOT  
FEMA (PEP)  
EXPANSION PROGRAM**

PROJECT:  
**10'-0" X 18'-0"  
CONCRETE SHELTER  
DETAIL DRAWINGS**

FILENAME: KBR/SKBRO2	
SCALE: N.T.S.	TOLERANCE:
DRWN. BY: M. FOWLER	DATE: 03/24/2010
CHK. BY: V. HASSELL	DATE: 03/24/2010
APP. BY: A. DUMAS	DATE: 03/24/2010
SHEET NO. 7-4	
DRAWING NO.:	REV.:
SKBR02	P

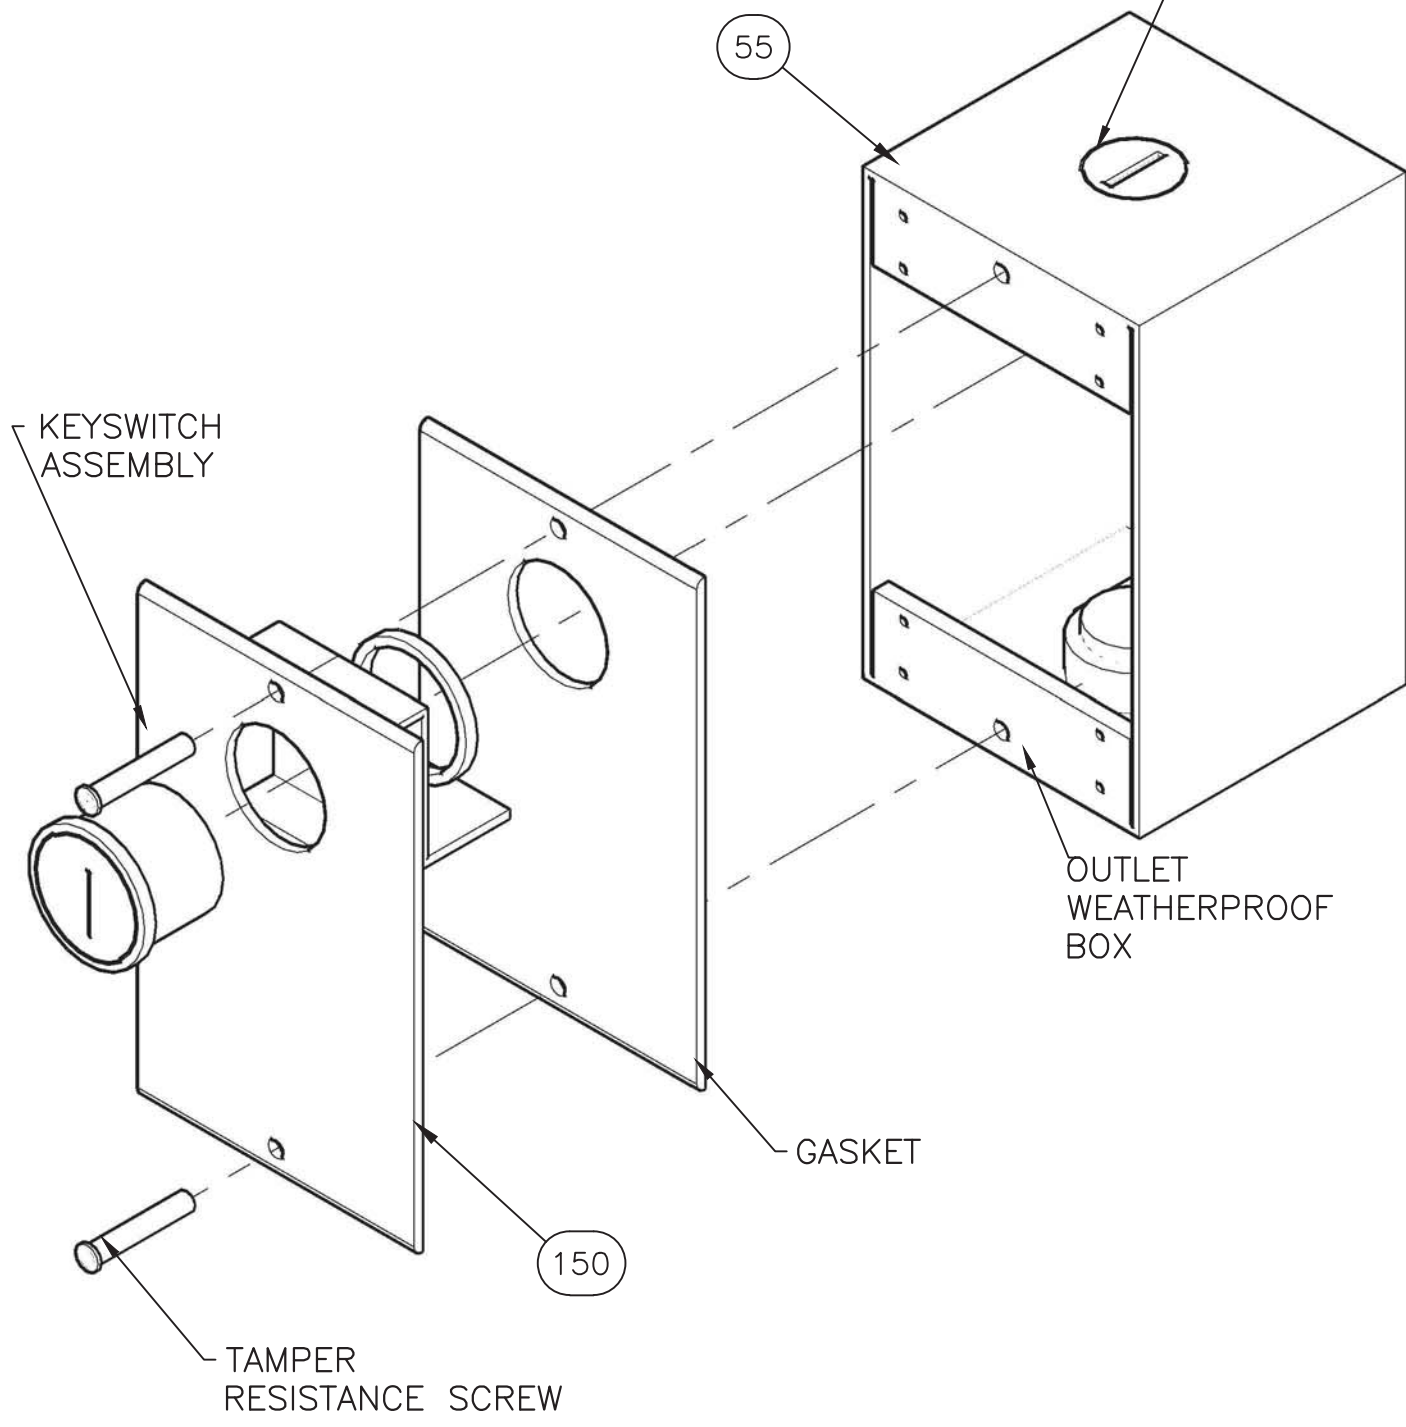

OUTLET WEATHERPROOF BOX DETAIL

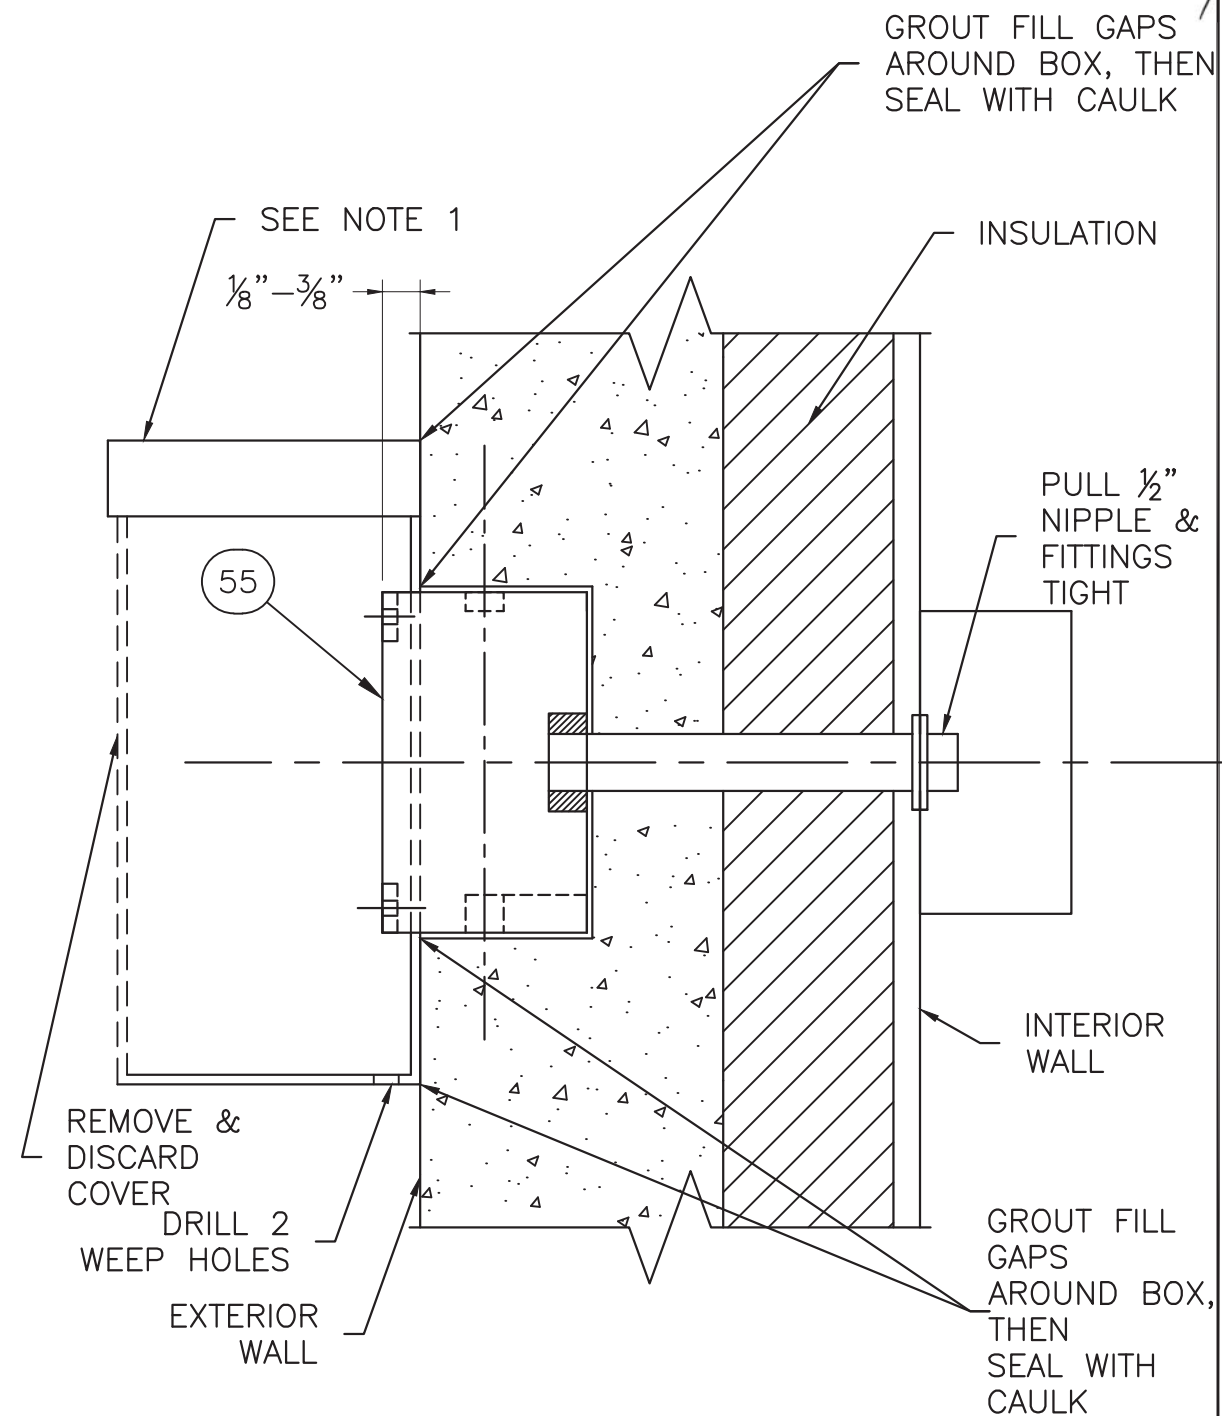

SECTION D-D DETAIL

N	RRG	6/13/12	CORRECTED DIMENSION	LJL	6/13/12
M	JJ	11/09/11	CHANGED KEYSWITCH DETAILS	LL	11/09/11
REV	BY	DATE	DESCRIPTION	APP. BY	DATE

**NOTES:**

1. CONDUCTOR COLORS ARE AS FOLLOWING:

120/240 SINGLE PHASE

PHASE "A" = BLACK

PHASE "B" = RED

NEUTRAL = WHITE

120/208 THREE PHASE

PHASE "A" = BLACK

PHASE "B" = RED

PHASE "C" = BLUE

NEUTRAL = WHITE

277/480 THREE PHASE

PHASE "A" = YELLOW

PHASE "B" = BROWN

PHASE "C" = ORANGE

NEUTRAL = GRAY

ALL ELECTRICAL GROUND = GREEN


ALL ISOLATED GROUND = GREEN/YELLOW STRIPE

ALL SWITCHED = PURPLE

2. ALL CONDUCTORS (UNLESS OTHERWISE NOTED) TO BE STRANDED THHN OR THWN COPPER WIRE.
3. ALL CONDUIT TO BE 1/2" RIGID UNLESS OTHERWISE NOTED.
4. ALL LOW VOLTAGE CONDUIT TO BE 1/2" EMT UNLESS NOTED.
5. ALL CONDUCTOR AMPACITIES ARE BASED ON TABLE 310.15(B)(16) NATIONAL ELECTRICAL CODE.
6. CONDUIT FILL BASED ON CHAPTER 9 - NATIONAL ELECTRICAL CODE.
7. PLACEMENT OF ELECTRICAL AND CONDUIT COMPONENTS OR BOXES MAY VARY TO ALIGN WITH COMPONENTS MANUFACTURE'S PRE-MADE BOX KNOCKOUTS. THIS MAY INCLUDE ALIGNMENT WITH SHELTER PENETRATIONS AND/OR INTERFERENCE WITH OTHER COMPONENTS.
8. CONDUIT, ELECTRICAL AND MECHANICAL DIMENSION TOLERANCE SHALL BE ±1/4".
9. DASHED LINES (-----) DENOTE FIELD WORK.
10. ALL CIRCUITS ON 25 AMP THROUGH 60 AMP BREAKER MUST USE #10 GROUND CONDUCTOR.
11. CONDUCTORS SMALLER THAN 4 AWG MUST HAVE CORRECT COLOR INSULATION. CONDUCTORS 4 AWG AND LARGER MAY BE RE-IDENTIFIED BY COLORED TAPE. BLACK INSULATED CONDUCTOR SHALL BE THE ONLY COLOR TO BE RE-IDENTIFIED. IF CONDUCTORS ARE RE-IDENTIFIED, IDENTIFICATION MUST BE APPLIED IN THREE INCH (3") WRAPS, MINIMUM EVERY THREE FEET (3'-0"). RE-IDENTIFICATION SHALL BE VISIBLE BY OPENING ANY ENCLOSURE. WHITE, GRAY AND GREEN CONDUCTORS SHALL NOT BE RE-IDENTIFIED.
12. ALL METALLIC ELECTRICAL BOXES (SWITCH BOXES, DUPLEX BOXES, LIGHTS, JUNCTION BOXES, ETC) SHALL BE CONNECTED TO THE PROTECTED GROUND OF THE ACG DISTRIBUTION PANEL WITH A #12 GREEN INSULATED STRANDED CONDUCTOR WHICH SHALL BE RUN INTERNAL TO THE CONDUIT.

**LEGEND**

 = CONDUIT (THICKNESS VARIES WITH SIZE OF CONDUIT)

 = GROUND WIRE

 = 4 X 4 BOX WITH DUPLEX RECEPTACLE (GROUND TERMINAL ON TOP)

 = 4 X 4 BOX WITH PENETRATION

 = 4 X 4 BOX BLANK

 = 4 X 4 BOX WITH 2 SWITCHES

 = 4 X 4 BOX WITH SINGLE SWITCH

 = 4" OCTAGON BOX WITH SMOKE DETECTOR

 = 4" OCTAGON BOX WITH HEAT DETECTOR

 = 4 X 4 BOX WITH TWIST-LOCK RECEPTACLE

 = 4 X 4 BOX WITH TIMER SWITCH


 = PHOTOCCELL SWITCH

 = SYSTEM GROUND FOR AC CIRCUITS

 = ISOLATED GROUND FOR AC CIRCUITS

 = VENT FAN

February 27, 2013

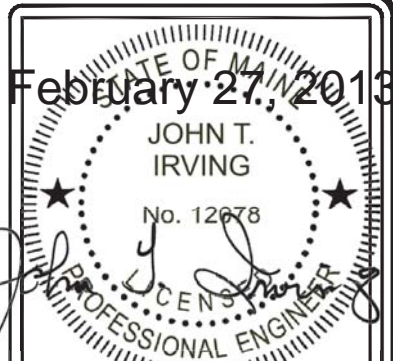

THIS DRAWING IS THE CONFIDENTIAL PROPERTY AND CONTAINS TRADE SECRETS OF CELLXION, LLC. ANY USE OF THESE DRAWINGS OR THE INFORMATION CONTAINED HEREIN FOR ANY REASON OTHER THAN AS EXPRESSLY AUTHORIZED BY SABRE INDUSTRIES, INC. IS STRICTLY PROHIBITED. THIS DRAWING HAS BEEN DISTRIBUTED WITH THE UNDERSTANDING THAT ANYONE RECEIVING OR OTHERWISE OBTAINING POSSESSION OF IT WILL BE EXPRESSLY NOTIFIED OF ITS CONFIDENTIAL NATURE.

**Cellxion**  
 5031 Hazel Jones Road  
 Bossier City, Louisiana 71111  
 voice: (318) 213-2900  
 fax: (318) 213-2919  
 www.cellxion.com

CUSTOMER:  
**KELLOGG  
 BROWN & ROOT  
 FEMA (PEP)  
 EXPANSION PROGRAM**

PROJECT:  
**10'-0" X 18'-0"  
 CONCRETE SHELTER  
 GENERAL ELECTRICAL  
 NOTES & LEGEND**



FILENAME: KBR/SKBRO2	
SCALE: N.T.S.	TOLERANCE:
DRWN. BY: M. FOWLER	DATE: 03/24/2010
CHK. BY: V. HASSELL	DATE: 03/24/2010
ENG. BY:	DATE:
APP. BY: A. DUMAS	DATE: 03/24/2010
SHEET NO. 7-5	
DRAWING NO.: SKBR02	REV.: P

N	RRG	4/17/12	CHANGES PER 12KBRO2-002-2	LJL	4/17/12
REV	BY	DATE	DESCRIPTION	APP. BY	DATE


**ABBREVIATIONS**

⊙	AT	MFG	MANUFACTURER
A	AMPS	MISC	MISCELLANEOUS
AFF	ABOVE FINISH FLOOR	NEC	NATIONAL ELECTRIC CODE
BCW	BARE COPPER WIRE	NEG	NEGATIVE
BLK	BLACK	NEMA	NATIONAL ELECTRIC MANUFACTURER'S ASSOCIATION
BLU	BLUE	NOM	NOMINAL
BRN	BROWN	NO	NORMALLY OPEN
BLDG	BUILDING	NC	NORMALLY CLOSED
BOCA	BUILDING OFFICIALS CODE ADMINISTRATION	NTS	NOT TO SCALE
C	CENTERLINE	OR	ORANGE
C/C	CENTER TO CENTER	OD	OUTSIDE DIAMETER/OUTSIDE DIMENSION
CKT	CIRCUIT	OSB	ORIENTED STRAND BOARD
CONC	CONCRETE	P	POLE
CU YD	CUBIC YARD	PDC	POWER DISTRIBUTION CABINET
DIA / ∅	DIAMETER	POS	POSITIVE
DIM	DIMENSION	LB	POUND (S)
DP	DOUBLE POLE	PSF	POUNDS PER SQUARE FOOT
DPDT	DOUBLE POLE DOUBLE THROW	PSI	POUNDS PER SQUARE INCH
DPST	DOUBLE POLE SINGLE THROW	QTY	QUANTITY
DT	DOUBLE THROW	RECT	RECTIFIER
DWG	DRAWING	REBAR	REINFORCING STEEL BAR
EA	EACH	REQ'D.	REQUIRED
EGR	EQUIPMENT GROUND RING	REV	REVISION
ELEC	ELECTRIC/ELECTRICAL	R	RIGHT
EMT	ELECTRICAL METALLIC TUBING	RH	RIGHT HAND
ENT	ELECTRICAL NONMETALLIC TUBING	SHT	SHEET
ELEV	ELEVATION	1∅	SINGLE PHASE
EQUIP	EQUIPMENT	S/G	SERVICE GROUND
EXT	EXTERIOR	S/N	SERVICE NEUTRAL
FMLC	FLEXIBLE METALLIC LIQUID TIGHT CONDUIT	SPDT	SINGLE POLE DOUBLE THROW
FNLC	FLEXIBLE NONMETALLIC LIQUID TIGHT CONDUIT	SPST	SINGLE POLE SINGLE THROW
FND	FOUNDATION	SW	SINGLE POLE SWITCH
FRP	FIBERGLASS REINFORCED POLYESTER	SQ FT	SQUARE FEET
FS	FIRE SUPPRESSION	SQ IN	SQUARE INCH
GALV	GALVANIZED	STD	STANDARD
GEN	GENERATOR	SBC	STANDARD BUILDING CODE
GRN	GREEN	SW	SWITCH
GND	GROUND	TEMP	TEMPERATURE
GFCI	GROUND FAULT CIRCUIT INTERRUPTER	TSTAT	THERMOSTAT
HVAC	HEATING, VENTILATION, AND AIR CONDITIONING	3∅	THREE PHASE
HOR	HORIZONTAL	3P	THREE POLE
IAW	IN ACCORDANCE WITH	3W	THREE WIRE
IN	INCH	TYP	TYPICAL
ID	INSIDE DIAMETER/INSIDE DIMENSION	UL	UNDERWRITERS LABORATORIES INC.
INSUL	INSULATION	UBC	UNIFORM BUILDING CODE
INT	INTERIOR	UMC	UNIFORM MECHANICAL CODE
IMC	INTERNATIONAL MECHANICAL CODE	VENT	VENTILATION
IPC	INTERNATIONAL PLUMBING CODE	V	VOLT
IG	ISOLATED GROUND	W	WATTS
JB	JUNCTION BOX	WP	WEATHER PROOF
KW	KILOWATT	WLD	WELDED
KO	KNOCKOUT	WWF	WELDED WIRE FABRIC
L	LEFT	WHT	WHITE
L/N	LOAD NEUTRAL	W/	WITH
LH	LEFT HAND	W/O	WITHOUT
LTG	LIGHT/LIGHTNING	YEL	YELLOW
LL	LIVE LOAD		
LV	LOW VOLTAGE		

**SYMBOLS**

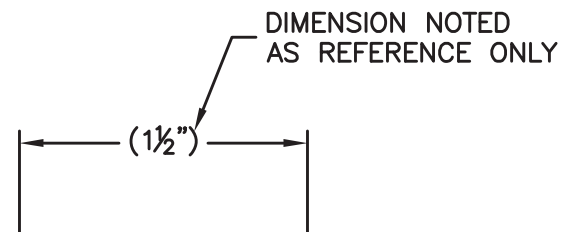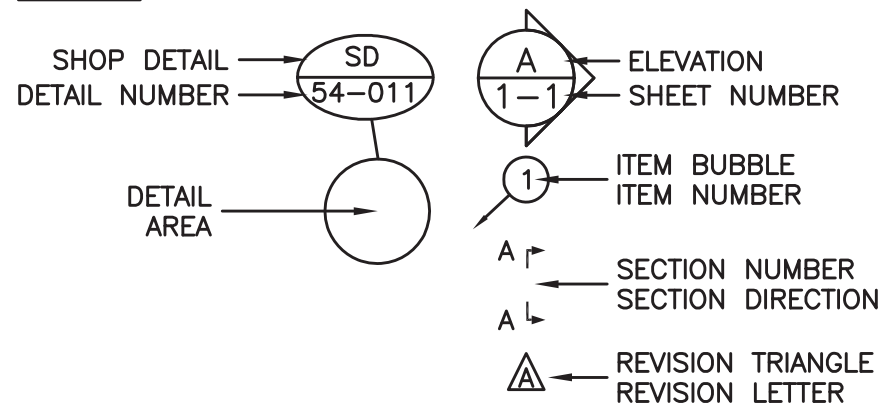

REV	BY	DATE	DESCRIPTION	APP. BY	DATE
D	LJL	6/1/09	ADDED ABBREVIATION: AFF	LJL	6/1/09
C	ACM	8/15/08	ADDED ABBREVIATIONS: S/N, S/G, & L/N	VGH	8/15/08
B	VGH	06/02/08	ADDED REFERENCE DIMENSION	VGH	06/02/08
A	CC	7/27/04	REVISED DETAIL SYMBOL	VGH	7/27/04

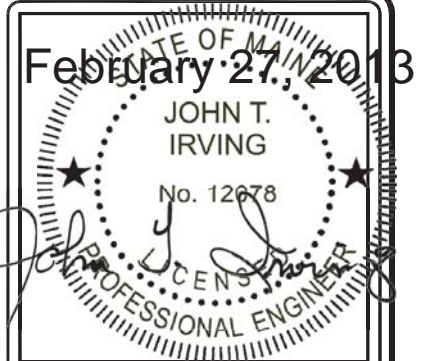

THIS DRAWING IS THE CONFIDENTIAL PROPERTY AND CONTAINS TRADE SECRETS OF CELLXION, LLC. ANY USE OF THESE DRAWINGS OR THE INFORMATION CONTAINED HEREIN FOR ANY REASON OTHER THAN AS EXPRESSLY AUTHORIZED BY CELLXION, LLC. IS STRICTLY PROHIBITED. THIS DRAWING HAS BEEN DISTRIBUTED WITH THE UNDERSTANDING THAT ANYONE RECEIVING OR OTHERWISE OBTAINING POSSESSION OF IT WILL BE EXPRESSLY NOTIFIED OF ITS CONFIDENTIAL NATURE.

**Cellxion**  
A Division of Sabre Industries, Inc.  
5031 Hazel Jones Road  
Bossier City, Louisiana 71111  
voice: (318) 213-2900  
fax: (318) 213-2919  
www.cellxion.com

CUSTOMER:  
**ENGINEERING STANDARD**

PROJECT:  
**ABBREVIATIONS AND SYMBOLS**

FILENAME: 108-007	
SCALE: 1"=1"	TOLERANCE: NA
DRWN. BY: C.CASINGER	DATE: 12/4/03
CHK. BY: K.BARNETT	DATE: 12/4/03
ENG. BY: K.BARNETT	DATE: 12/4/03
APP. BY:	DATE:

SHEET NO.  
1 OF 1  
DRAWING NO.:  
108-007

D



## GENERAL NOTES

- ALL STEEL FABRICATION AND INSTALLATION SHALL BE DONE IN ACCORDANCE WITH THE AMERICAN INSTITUTE OF STEEL CONSTRUCTION MANUAL AISC LRFD(1999) AND AWS D1.1 SPECIFICATIONS.
- ALL WELDING SHALL BE MIG TYPE WITH THE FOLLOWING OPERATING SETTINGS:
 

WIRE SIZE -----	0.35
WIRE FEED SPEED (in/min) -----	5
VOLTAGE, DC (+) -----	18.5
AMPERAGE, DC -----	140
TRAVEL SPEED (in/min) -----	10-12
SHIELDING GAS -----	75/25
- STRUCTURAL STEEL SPECIFICATIONS:  
 STRUCTURAL SHAPES ASTM A36M-97a  
 HIGH STRENGTH BOLTS, ASTM A 307-97  
 OTHER BOLTS, SAE J429 GRADE 5
- ALL CONCRETE WORK SHALL CONFORM TO AMERICAN CONCRETE INSTITUTE A.C.I. 318-99 BUILDING CODES 311 & 211, AND ASTM STANDARDS C-172-97, C-31/31M96, C-39-96, AND PROVISIONS OF C-94-98.
- ALL PRECAST STRUCTURAL SAND-LIGHTWEIGHT CONCRETE SHALL HAVE A MINIMUM COMPRESSIVE STRENGTH OF 5000 PSI AT 28 DAYS.
- ALL REINFORCING STEEL BARS SHALL BE DOMESTIC, NEW BILLET STEEL CONFORMING TO ASTM A-615m-96a SPECIFICATIONS.
- CONCRETE COVERAGE OVER ALL REINFORCING STEEL SHALL BE A MINIMUM OF 3/4".
- ALL REBAR SHALL BE TIED 100% AT THE PERIMETER, AND 50% ELSEWHERE.
- ALL REBAR WIRE TIES TO BE 16 GAUGE.
- FIBROUS REINFORCED LIGHTWEIGHT CONCRETE MAY BE USED IN THE ROOF AND FLOOR AND SHALL HAVE A MINIMUM COMPRESSIVE STRENGTH OF 5000 PSI AT 28 DAYS. FIBER REINFORCEMENT MAY BE USED IN THE FLOOR IF DESIRED IN ORDER TO MAKE BATCHING OPERATION MORE EFFICIENT.
- MAXIMUM JOINT SPACE BETWEEN PANELS SHALL BE 3/8" MEASURED BY REFUSAL OF ABILITY TO PASS A 3/8" ROD ALL THE WAY THROUGH THE JOINT AT ANY POINT ALONG THE JOINT.
- WELD PLATE CONNECTIONS SHALL BE SPACED AT 4'-8" MAXIMUM ON THE FLOOR AND ROOF PANELS. THIS DIMENSION SHALL BE MAINTAINED EXCEPT IN CASES WHERE OPENINGS PROHIBIT.
- TOLERANCES SHALL BE AS FOLLOWS:  
 PANEL THICKNESS:  $\pm 1/8"$   
 PANEL SIZE:  $\pm 1/16"$   
 PANEL SQUARENESS:  $\pm 1/8"$  AGREEMENT ON DIAGONALS  
 LOCATION OF BLOCKOUTS & PVC'S:  $\pm 1/4"$   
 BLOCKOUT DIMENSIONS:  $+1/4"$ ,  $-0"$   
 PVC SIZE: USE TRADE SIZE AS LISTED ON PROJECT DRAWINGS
- REBAR SPLICING IS ALLOWED WHERE SPACE PERMITS. MINIMUM LAP IS 18" FOR #4 REBAR AND 30" FOR #6 REBAR.
- CONCRETE SHALL HAVE AIR ENTRAINMENT OF 6%, MODERATE EXPOSURE AND A MAXIMUM AGGREGATE SIZE OF 3/8 INCH.
- CONCRETE SHALL HAVE A WATER-CEMENTITIOUS MATERIAL RATIO OF 0.50.

GENERAL: THESE REBAR SIZES AND SPACING REPRESENT THE MINIMUM AMOUNT FOR ALL CASTING PLANS. PROJECT DRAWINGS MAY REQUIRE REINFORCEMENT IN ADDITION TO CELLXION STANDARDS.

ROOF PANEL: #4 (SHORT AXIS) 12" O.C. ON SHELTER WIDTH OF 11'-6" AND LESS, 10" O.C. ON SHELTER WIDTH GREATER THAN 11'-6" AND #4 (LONG AXIS) AT 18" O.C.

WALL PANEL: #4 AT PERIMETER AND 4 X 4 X W4.5 X W4.5 MESH THROUGHOUT.

FLOOR: (2)-#6 (SHORT AXIS) EACH RIB, #6 (LONG AXIS) EACH INTERIOR RIB. DECK: 4 X 4 X W4.5 X W4.5 MESH.

## SEALANT APPLICATION


STEP 1. AT MATING SURFACES BETWEEN PANELS, APPLY URETHANE SEALANT ( $\frac{1}{2}$ " BEAD) DURING ASSEMBLY.

STEP 2. URETHANE SEALANT REQUIRED ON ALL JOINTS. APPLY TO EXTERIOR AFTER PANEL ASSEMBLY.


STEP 3. ROOF COATING:  
 APPLY SHELTER ROOF COATING PER MANUFACTURER INSTRUCTION. ROOF COATING TO CONFORM TO, ASTM D6083-97A, OBC 1507.15.2 & 2000 IBC 1507.15.2.

STEP 4. APPLY AGGREGATE SEALER TO EXTERIOR WALLS. USE 1 GALLON PER 200 SQ. FEET.

STEP 5. USE TEXTURED SEALER ON ALL SMOOTH EXPOSED SURFACES. USE CEMENTITIOUS GRAY PAINT.

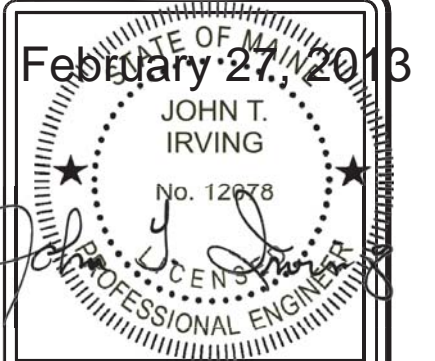

THIS DRAWING IS THE CONFIDENTIAL PROPERTY AND CONTAINS TRADE SECRETS OF CELLXION, LLC. ANY USE OF THESE DRAWINGS OR THE INFORMATION CONTAINED HEREIN FOR ANY REASON OTHER THAN AS EXPRESSLY AUTHORIZED BY CELLXION, LLC. IS STRICTLY PROHIBITED. THIS DRAWING HAS BEEN DISTRIBUTED WITH THE UNDERSTANDING THAT ANYONE RECEIVING OR OTHERWISE OBTAINING POSSESSION OF IT WILL BE EXPRESSLY NOTIFIED OF ITS CONFIDENTIAL NATURE.

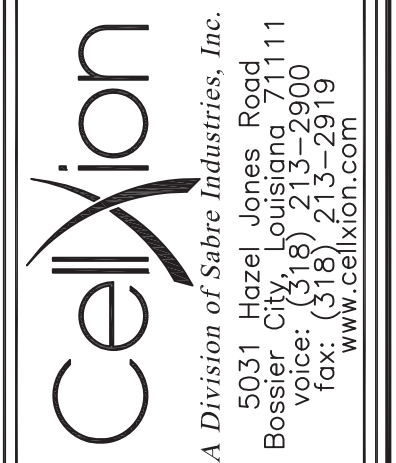

CUSTOMER:  
 ENGINEERING STANDARD

PROJECT:  
 GENERAL CASTING SPECIFICATIONS  
 2000 IBC

FILENAME: 108-016	
SCALE: 1"=1"	TOLERANCE:
DRWN. BY: C.CASINGER	DATE: 7/28/04
CHK. BY:	DATE:
ENG. BY:	DATE:
APP. BY:	DATE:
SHEET NO. 1 OF 4	
DRAWING NO.: 108-016	M

**GENERAL NOTES**


1. ALL STEEL FABRICATION AND INSTALLATION SHALL BE DONE IN ACCORDANCE WITH THE AMERICAN INSTITUTE OF STEEL CONSTRUCTION MANUAL AISC LRFD(1999) AND AWS D1.1 SPECIFICATIONS.
2. ALL WELDING SHALL BE MIG TYPE WITH THE FOLLOWING OPERATING SETTINGS:
 

WIRE SIZE -----	0.35
WIRE FEED SPEED (in/min) -----	5
VOLTAGE, DC (+) -----	18.5
AMPERAGE, DC -----	140
TRAVEL SPEED (in/min) -----	10-12
SHIELDING GAS -----	75/25
3. STRUCTURAL STEEL SPECIFICATIONS:
  - STRUCTURAL SHAPES ASTM A36/A 36M-00
  - HIGH STRENGTH BOLTS, ASTM A 307-00
  - OTHER BOLTS, SAE J429 GRADE 5
4. ALL CONCRETE WORK SHALL CONFORM TO AMERICAN CONCRETE INSTITUTE A.C.I. 318-02 BUILDING CODES 311 & 211, AND ASTM STANDARDS C-172-99, C-31/C31M98, C-39-99ae1, AND PROVISIONS OF C-94/C94M-00.
5. ALL PRECAST STRUCTURAL SAND-LIGHTWEIGHT CONCRETE SHALL HAVE A MINIMUM COMPRESSIVE STRENGTH OF 5000 PSI AT 28 DAYS.
6. ALL REINFORCING STEEL BARS SHALL BE DOMESTIC, NEW BILLET STEEL CONFORMING TO ASTM A 615M-00 SPECIFICATIONS.
7. CONCRETE COVERAGE OVER ALL REINFORCING STEEL SHALL BE A MINIMUM OF 3/4".
8. ALL REBAR SHALL BE TIED 100% AT THE PERIMETER, AND 50% ELSEWHERE.
9. ALL REBAR WIRE TIES TO BE 16 GAUGE.
10. FIBROUS REINFORCED LIGHTWEIGHT CONCRETE MAY BE USED IN THE ROOF AND FLOOR AND SHALL HAVE A MINIMUM COMPRESSIVE STRENGTH OF 5000 PSI AT 28 DAYS. FIBER REINFORCEMENT MAY BE USED IN THE FLOOR IF DESIRED IN ORDER TO MAKE BATCHING OPERATION MORE EFFICIENT.
11. MAXIMUM JOINT SPACE BETWEEN PANELS SHALL BE 3/8" MEASURED BY REFUSAL OF ABILITY TO PASS A 3/8" ROD ALL THE WAY THROUGH THE JOINT AT ANY POINT ALONG THE JOINT.
12. WELD PLATE CONNECTIONS SHALL BE SPACED AT 4'-8" MAXIMUM ON THE FLOOR AND ROOF PANELS. THIS DIMENSION SHALL BE MAINTAINED EXCEPT IN CASES WHERE OPENINGS PROHIBIT.
13. TOLERANCES SHALL BE AS FOLLOWS:
  - PANEL THICKNESS: ±1/8"
  - PANEL SIZE: ±1/16"
  - PANEL SQUARENESS: ±1/8" AGREEMENT ON DIAGONALS
  - LOCATION OF BLOCKOUTS & PVC'S: ±1/4"
  - BLOCKOUT DIMENSIONS: +1/4", -0"
  - PVC SIZE: USE TRADE SIZE AS LISTED ON PROJECT DRAWINGS
14. REBAR SPLICING IS ALLOWED WHERE SPACE PERMITS. MINIMUM LAP IS 18" FOR #4 REBAR AND 30" FOR #6 REBAR.
15. CONCRETE SHALL HAVE AIR ENTRAINMENT OF 6%, MODERATE EXPOSURE AND A MAXIMUM AGGREGATE SIZE OF 3/8 INCH.
16. CONCRETE SHALL HAVE A WATER-CEMENTITIOUS MATERIAL RATIO OF 0.50.

- GENERAL: THESE REBAR SIZES AND SPACING REPRESENT THE MINIMUM AMOUNT FOR ALL CASTING PLANS. PROJECT DRAWINGS MAY REQUIRE REINFORCEMENT IN ADDITION TO CELLXION STANDARDS.
- ROOF PANEL: #4 (SHORT AXIS) 12" O.C. ON SHELTER WIDTH OF 11'-6" AND LESS, 10" O.C. ON SHELTER WIDTH GREATER THAN 11'-6" AND #4 (LONG AXIS) AT 18" O.C.
- WALL PANEL: #4 AT PERIMETER AND 4 X 4 X W4.5 X W4.5 MESH THROUGHOUT.
- FLOOR: (2)-#6 (SHORT AXIS) EACH RIB, #6 (LONG AXIS) EACH INTERIOR RIB. DECK: 4 X 4 X W4.5 X W4.5 MESH.

**SEALANT APPLICATION**

- STEP 1. AT MATING SURFACES BETWEEN PANELS, APPLY URETHANE SEALANT (1/2" BEAD) DURING ASSEMBLY.
- STEP 2. URETHANE SEALANT REQUIRED ON ALL JOINTS. APPLY TO EXTERIOR AFTER PANEL ASSEMBLY.
- STEP 3. ROOF COATING: APPLY SHELTER ROOF COATING PER MANUFACTURER INSTRUCTION. ROOF COATING TO CONFORM TO, ASTM D6083-97A, OBC 1507.15.2 & 2003 IBC 1507.15.2.
- STEP 4. APPLY AGGREGATE SEALER TO EXTERIOR WALLS. USE 1 GALLON PER 200 SQ. FEET.
- STEP 5. USE TEXTURED SEALER ON ALL SMOOTH EXPOSED SURFACES. USE CEMENTITIOUS GRAY PAINT.

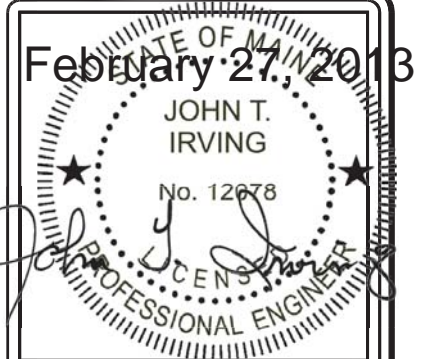

THIS DRAWING IS THE CONFIDENTIAL PROPERTY AND CONTAINS TRADE SECRETS OF CELLXION, LLC. ANY USE OF THESE DRAWINGS OR THE INFORMATION CONTAINED HEREIN FOR ANY REASON OTHER THAN AS EXPRESSLY AUTHORIZED BY CELLXION, LLC. IS STRICTLY PROHIBITED. THIS DRAWING HAS BEEN DISTRIBUTED WITH THE UNDERSTANDING THAT ANYONE RECEIVING OR OTHERWISE OBTAINING POSSESSION OF IT WILL BE EXPRESSLY NOTIFIED OF ITS CONFIDENTIAL NATURE.

**Cellxion**

A Division of Sabre Industries, Inc.  
5031 Hazel Jones Road  
Bossier City, Louisiana 70111  
voice: (318) 213-2900  
fax: (318) 213-2919  
www.cellxion.com

CUSTOMER:  
**ENGINEERING STANDARD**

PROJECT:  
**GENERAL CASTING SPECIFICATIONS 2003 IBC**

FILENAME: 108-016	
SCALE: 1"=1"	TOLERANCE:
DRWN. BY: L. DROZDZ	DATE: 9/17/07
CHK. BY:	DATE:
ENG. BY:	DATE:
APP. BY:	DATE:
SHEET NO. 2 OF 4	
DRAWING NO.: 108-016	M



## GENERAL NOTES

1. ALL STEEL FABRICATION AND INSTALLATION SHALL BE DONE IN ACCORDANCE WITH THE AMERICAN INSTITUTE OF STEEL CONSTRUCTION MANUAL AISC 360-05 AND AWS D1.1-04 SPECIFICATIONS.
2. ALL WELDING SHALL BE MIG TYPE WITH THE FOLLOWING OPERATING SETTINGS:
 

WIRE SIZE -----	0.35
WIRE FEED SPEED (in/min) -----	5
VOLTAGE, DC (+) -----	18.5
AMPERAGE, DC -----	140
TRAVEL SPEED (in/min) -----	10-12
SHIELDING GAS -----	75/25
3. STRUCTURAL STEEL SPECIFICATIONS:
  - STRUCTURAL SHAPES ASTM A36/A 36M-04a
  - HIGH STRENGTH BOLTS, ASTM A 307-03
  - OTHER BOLTS, SAE J429 GRADE 5
4. ALL CONCRETE WORK SHALL CONFORM TO AMERICAN CONCRETE INSTITUTE A.C.I. 318-05 BUILDING CODES 311 & 211, AND ASTM STANDARDS C-172-04, C-31/C31M98, C-39-05e1, AND PROVISIONS OF C-94/C94M-04.
5. ALL PRECAST STRUCTURAL SAND-LIGHTWEIGHT CONCRETE SHALL HAVE A MINIMUM COMPRESSIVE STRENGTH OF 5000 PSI AT 28 DAYS.
6. ALL REINFORCING STEEL BARS SHALL BE DOMESTIC, NEW BILLET STEEL CONFORMING TO ASTM A 615M-04a SPECIFICATIONS.
7. CONCRETE COVERAGE OVER ALL REINFORCING STEEL SHALL BE A MINIMUM OF 3/4".
8. ALL REBAR SHALL BE TIED 100% AT THE PERIMETER, AND 50% ELSEWHERE.
9. ALL REBAR WIRE TIES TO BE 16 GAUGE.
10. FIBROUS REINFORCED LIGHTWEIGHT CONCRETE MAY BE USED IN THE ROOF AND FLOOR AND SHALL HAVE A MINIMUM COMPRESSIVE STRENGTH OF 5000 PSI AT 28 DAYS. FIBER REINFORCEMENT MAY BE USED IN THE FLOOR IF DESIRED IN ORDER TO MAKE BATCHING OPERATION MORE EFFICIENT.
11. MAXIMUM JOINT SPACE BETWEEN PANELS SHALL BE 3/8" MEASURED BY REFUSAL OF ABILITY TO PASS A 3/8" ROD ALL THE WAY THROUGH THE JOINT AT ANY POINT ALONG THE JOINT.
12. WELD PLATE CONNECTIONS SHALL BE SPACED AT 4'-8" MAXIMUM ON THE FLOOR AND ROOF PANELS. THIS DIMENSION SHALL BE MAINTAINED EXCEPT IN CASES WHERE OPENINGS PROHIBIT.
13. TOLERANCES SHALL BE AS FOLLOWS:
  - PANEL THICKNESS:  $\pm 1/8"$
  - PANEL SIZE:  $\pm 1/16"$
  - PANEL SQUARENESS:  $\pm 1/8"$  AGREEMENT ON DIAGONALS
  - LOCATION OF BLOCKOUTS & PVC'S:  $\pm 1/4"$
  - BLOCKOUT DIMENSIONS:  $+1/4"$ ,  $-0"$
  - PVC SIZE: USE TRADE SIZE AS LISTED ON PROJECT DRAWINGS
14. REBAR SPLICING IS ALLOWED WHERE SPACE PERMITS. MINIMUM LAP IS 18" FOR #4 REBAR AND 30" FOR #6 REBAR.
15. CONCRETE SHALL HAVE AIR ENTRAINMENT OF 6%, MODERATE EXPOSURE AND A MAXIMUM AGGREGATE SIZE OF 3/8 INCH.
16. CONCRETE SHALL HAVE A WATER-CEMENTITIOUS MATERIAL RATIO OF 0.50.

GENERAL: THESE REBAR SIZES AND SPACING REPRESENT THE MINIMUM AMOUNT FOR ALL CASTING PLANS. PROJECT DRAWINGS MAY REQUIRE REINFORCEMENT IN ADDITION TO CELLXION STANDARDS.


ROOF PANEL: #4 (SHORT AXIS) 12" O.C. ON SHELTER WIDTH OF 11'-6" AND LESS, 10" O.C. ON SHELTER WIDTH GREATER THAN 11'-6" AND #4 (LONG AXIS) AT 18" O.C.

WALL PANEL: #4 AT PERIMETER AND 4 X 4 X W4.5 X W4.5 MESH THROUGHOUT.

FLOOR: (2)-#6 (SHORT AXIS) EACH RIB, #6 (LONG AXIS) EACH INTERIOR RIB. DECK: 4 X 4 X W4.5 X W4.5 MESH.

## SEALANT APPLICATION

- STEP 1. AT MATING SURFACES BETWEEN PANELS, APPLY URETHANE SEALANT (1/2" BEAD) DURING ASSEMBLY.
- STEP 2. URETHANE SEALANT REQUIRED ON ALL JOINTS. APPLY TO EXTERIOR AFTER PANEL ASSEMBLY.
- STEP 3. ROOF COATING:  
APPLY SHELTER ROOF COATING PER MANUFACTURER INSTRUCTION. ROOF COATING TO CONFORM TO, ASTM D6083-97A, OBC 1507.15.2 & 2006 IBC 1507.15.2.
- STEP 4. APPLY AGGREGATE SEALER TO EXTERIOR WALLS. USE 1 GALLON PER 200 SQ. FEET.
- STEP 5. USE TEXTURED SEALER ON ALL SMOOTH EXPOSED SURFACES. USE CEMENTITIOUS GRAY PAINT.

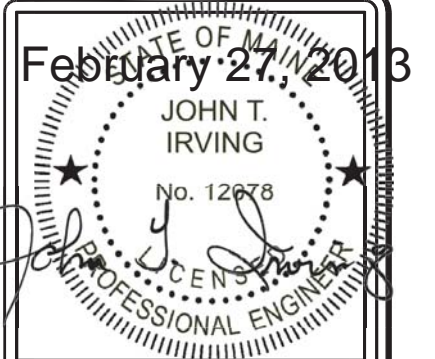

THIS DRAWING IS THE CONFIDENTIAL PROPERTY AND CONTAINS TRADE SECRETS OF CELLXION, LLC. ANY USE OF THESE DRAWINGS OR THE INFORMATION CONTAINED HEREIN FOR ANY REASON OTHER THAN AS EXPRESSLY AUTHORIZED BY CELLXION, LLC. IS STRICTLY PROHIBITED. THIS DRAWING HAS BEEN DISTRIBUTED WITH THE UNDERSTANDING THAT ANYONE RECEIVING OR OTHERWISE OBTAINING POSSESSION OF IT WILL BE EXPRESSLY NOTIFIED OF ITS CONFIDENTIAL NATURE.



CUSTOMER:  
ENGINEERING STANDARD

PROJECT:  
GENERAL CASTING  
SPECIFICATIONS  
2006 IBC

FILENAME: 108-016	
SCALE: 1"=1"	TOLERANCE:
DRWN. BY: L. DROZDZ	DATE: 10/1/07
CHK. BY:	DATE:
ENG. BY:	DATE:
APP. BY:	DATE:
SHEET NO. 3 OF 4	
DRAWING NO.: 108-016	M

## GENERAL NOTES

1. ALL STEEL FABRICATION AND INSTALLATION SHALL BE DONE IN ACCORDANCE WITH THE AMERICAN INSTITUTE OF STEEL CONSTRUCTION MANUAL AISC 360-05 AND AWS D1.1-04 SPECIFICATIONS.
2. ALL WELDING SHALL BE MIG TYPE WITH THE FOLLOWING OPERATING SETTINGS:
 

WIRE SIZE -----	0.35
WIRE FEED SPEED (in/min) -----	5
VOLTAGE, DC (+) -----	18.5
AMPERAGE, DC -----	140
TRAVEL SPEED (in/min) -----	10-12
SHIELDING GAS -----	75/25
3. STRUCTURAL STEEL SPECIFICATIONS:
  - STRUCTURAL SHAPES ASTM A36/A 36M-05
  - HIGH STRENGTH BOLTS, ASTM A 307-03
  - OTHER BOLTS, SAE J429 GRADE 5
4. ALL CONCRETE WORK SHALL CONFORM TO AMERICAN CONCRETE INSTITUTE A.C.I. 318-08 BUILDING CODES 311 & 211, AND ASTM STANDARDS C-172-04, C-31/C31-06, C-39-05e1, AND PROVISIONS OF C-94/C94M-07.
5. ALL PRECAST STRUCTURAL SAND-LIGHTWEIGHT CONCRETE SHALL HAVE A MINIMUM COMPRESSIVE STRENGTH OF 5000 PSI AT 28 DAYS.
6. ALL REINFORCING STEEL BARS SHALL BE DOMESTIC, NEW BILLET STEEL CONFORMING TO ASTM A 615M-04a SPECIFICATIONS.
7. CONCRETE COVERAGE OVER ALL REINFORCING STEEL SHALL BE A MINIMUM OF 3/4".
8. ALL REBAR SHALL BE TIED 100% AT THE PERIMETER, AND 50% ELSEWHERE.
9. ALL REBAR WIRE TIES TO BE 16 GAUGE.
10. FIBROUS REINFORCED LIGHTWEIGHT CONCRETE MAY BE USED IN THE ROOF AND FLOOR AND SHALL HAVE A MINIMUM COMPRESSIVE STRENGTH OF 5000 PSI AT 28 DAYS. FIBER REINFORCEMENT MAY BE USED IN THE FLOOR IF DESIRED IN ORDER TO MAKE BATCHING OPERATION MORE EFFICIENT.
11. MAXIMUM JOINT SPACE BETWEEN PANELS SHALL BE 3/8" MEASURED BY REFUSAL OF ABILITY TO PASS A 3/8" ROD ALL THE WAY THROUGH THE JOINT AT ANY POINT ALONG THE JOINT.
12. WELD PLATE CONNECTIONS SHALL BE SPACED AT 4'-8" MAXIMUM ON THE FLOOR AND ROOF PANELS. THIS DIMENSION SHALL BE MAINTAINED EXCEPT IN CASES WHERE OPENINGS PROHIBIT.
13. TOLERANCES SHALL BE AS FOLLOWS:
  - PANEL THICKNESS:  $\pm 1/8"$
  - PANEL SIZE:  $\pm 1/16"$
  - PANEL SQUARENESS:  $\pm 1/8"$  AGREEMENT ON DIAGONALS
  - LOCATION OF BLOCKOUTS & PVC'S:  $\pm 1/4"$
  - BLOCKOUT DIMENSIONS:  $+1/4"$ ,  $-0"$
  - PVC SIZE: USE TRADE SIZE AS LISTED ON PROJECT DRAWINGS
14. REBAR SPLICING IS ALLOWED WHERE SPACE PERMITS. MINIMUM LAP IS 18" FOR #4 REBAR AND 30" FOR #6 REBAR.
15. CONCRETE SHALL HAVE AIR ENTRAINMENT OF 6%, MODERATE EXPOSURE AND A MAXIMUM AGGREGATE SIZE OF 3/8 INCH.
16. CONCRETE SHALL HAVE A WATER-CEMENTITIOUS MATERIAL RATIO OF 0.50.

GENERAL: THESE REBAR SIZES AND SPACING REPRESENT THE MINIMUM AMOUNT FOR ALL CASTING PLANS. PROJECT DRAWINGS MAY REQUIRE REINFORCEMENT IN ADDITION TO CELLXION STANDARDS.


ROOF PANEL: #4 (SHORT AXIS) 12" O.C. ON SHELTER WIDTH OF 11'-6" AND LESS, 10" O.C. ON SHELTER WIDTH GREATER THAN 11'-6" AND #4 (LONG AXIS) AT 18" O.C.

WALL PANEL: #4 AT PERIMETER AND 4 X 4 X W4.5 X W4.5 MESH THROUGHOUT.


FLOOR: (2)-#6 (SHORT AXIS) EACH RIB, #6 (LONG AXIS) EACH INTERIOR RIB. DECK: 4 X 4 X W4.5 X W4.5 MESH.

## SEALANT APPLICATION

- STEP 1. AT MATING SURFACES BETWEEN PANELS, APPLY URETHANE SEALANT (1/2" BEAD) DURING ASSEMBLY.
- STEP 2. URETHANE SEALANT REQUIRED ON ALL JOINTS. APPLY TO EXTERIOR AFTER PANEL ASSEMBLY.
- STEP 3. ROOF COATING:  
APPLY SHELTER ROOF COATING PER MANUFACTURER INSTRUCTION. ROOF COATING TO CONFORM TO, ASTM D6083-05e01, OBC 1507.15.2 & 2009 IBC 1507.15.2.
- STEP 4. APPLY AGGREGATE SEALER TO EXTERIOR WALLS. USE 1 GALLON PER 200 SQ. FEET.
- STEP 5. USE TEXTURED SEALER ON ALL SMOOTH EXPOSED SURFACES. USE CEMENTITIOUS GRAY PAINT.

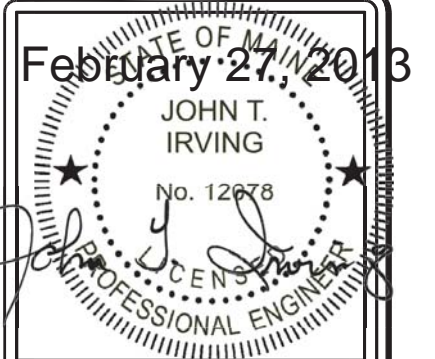


THIS DRAWING IS THE CONFIDENTIAL PROPERTY AND CONTAINS TRADE SECRETS OF CELLXION, LLC. ANY USE OF THESE DRAWINGS OR THE INFORMATION CONTAINED HEREIN FOR ANY REASON OTHER THAN AS EXPRESSLY AUTHORIZED BY CELLXION, LLC. IS STRICTLY PROHIBITED. THIS DRAWING HAS BEEN DISTRIBUTED WITH THE UNDERSTANDING THAT ANYONE RECEIVING OR OTHERWISE OBTAINING POSSESSION OF IT WILL BE EXPRESSLY NOTIFIED OF ITS CONFIDENTIAL NATURE.

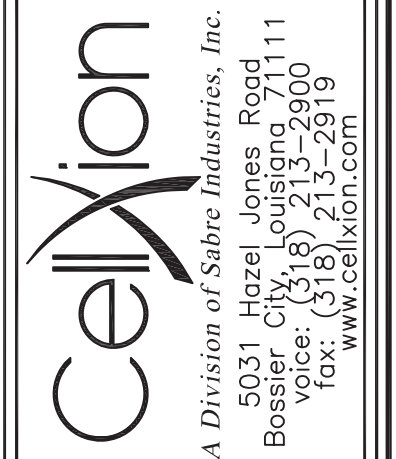


CUSTOMER:  
ENGINEERING STANDARD

PROJECT:  
GENERAL CASTING  
SPECIFICATIONS  
2009 IBC

FILENAME: 108-016	
SCALE: 1"=1"	TOLERANCE:
DRWN. BY: L. DROZDZ	DATE: 7/21/10
CHK. BY:	DATE:
ENG. BY:	DATE:
APP. BY:	DATE:
SHEET NO. 4 OF 4	
DRAWING NO.: 108-016	M

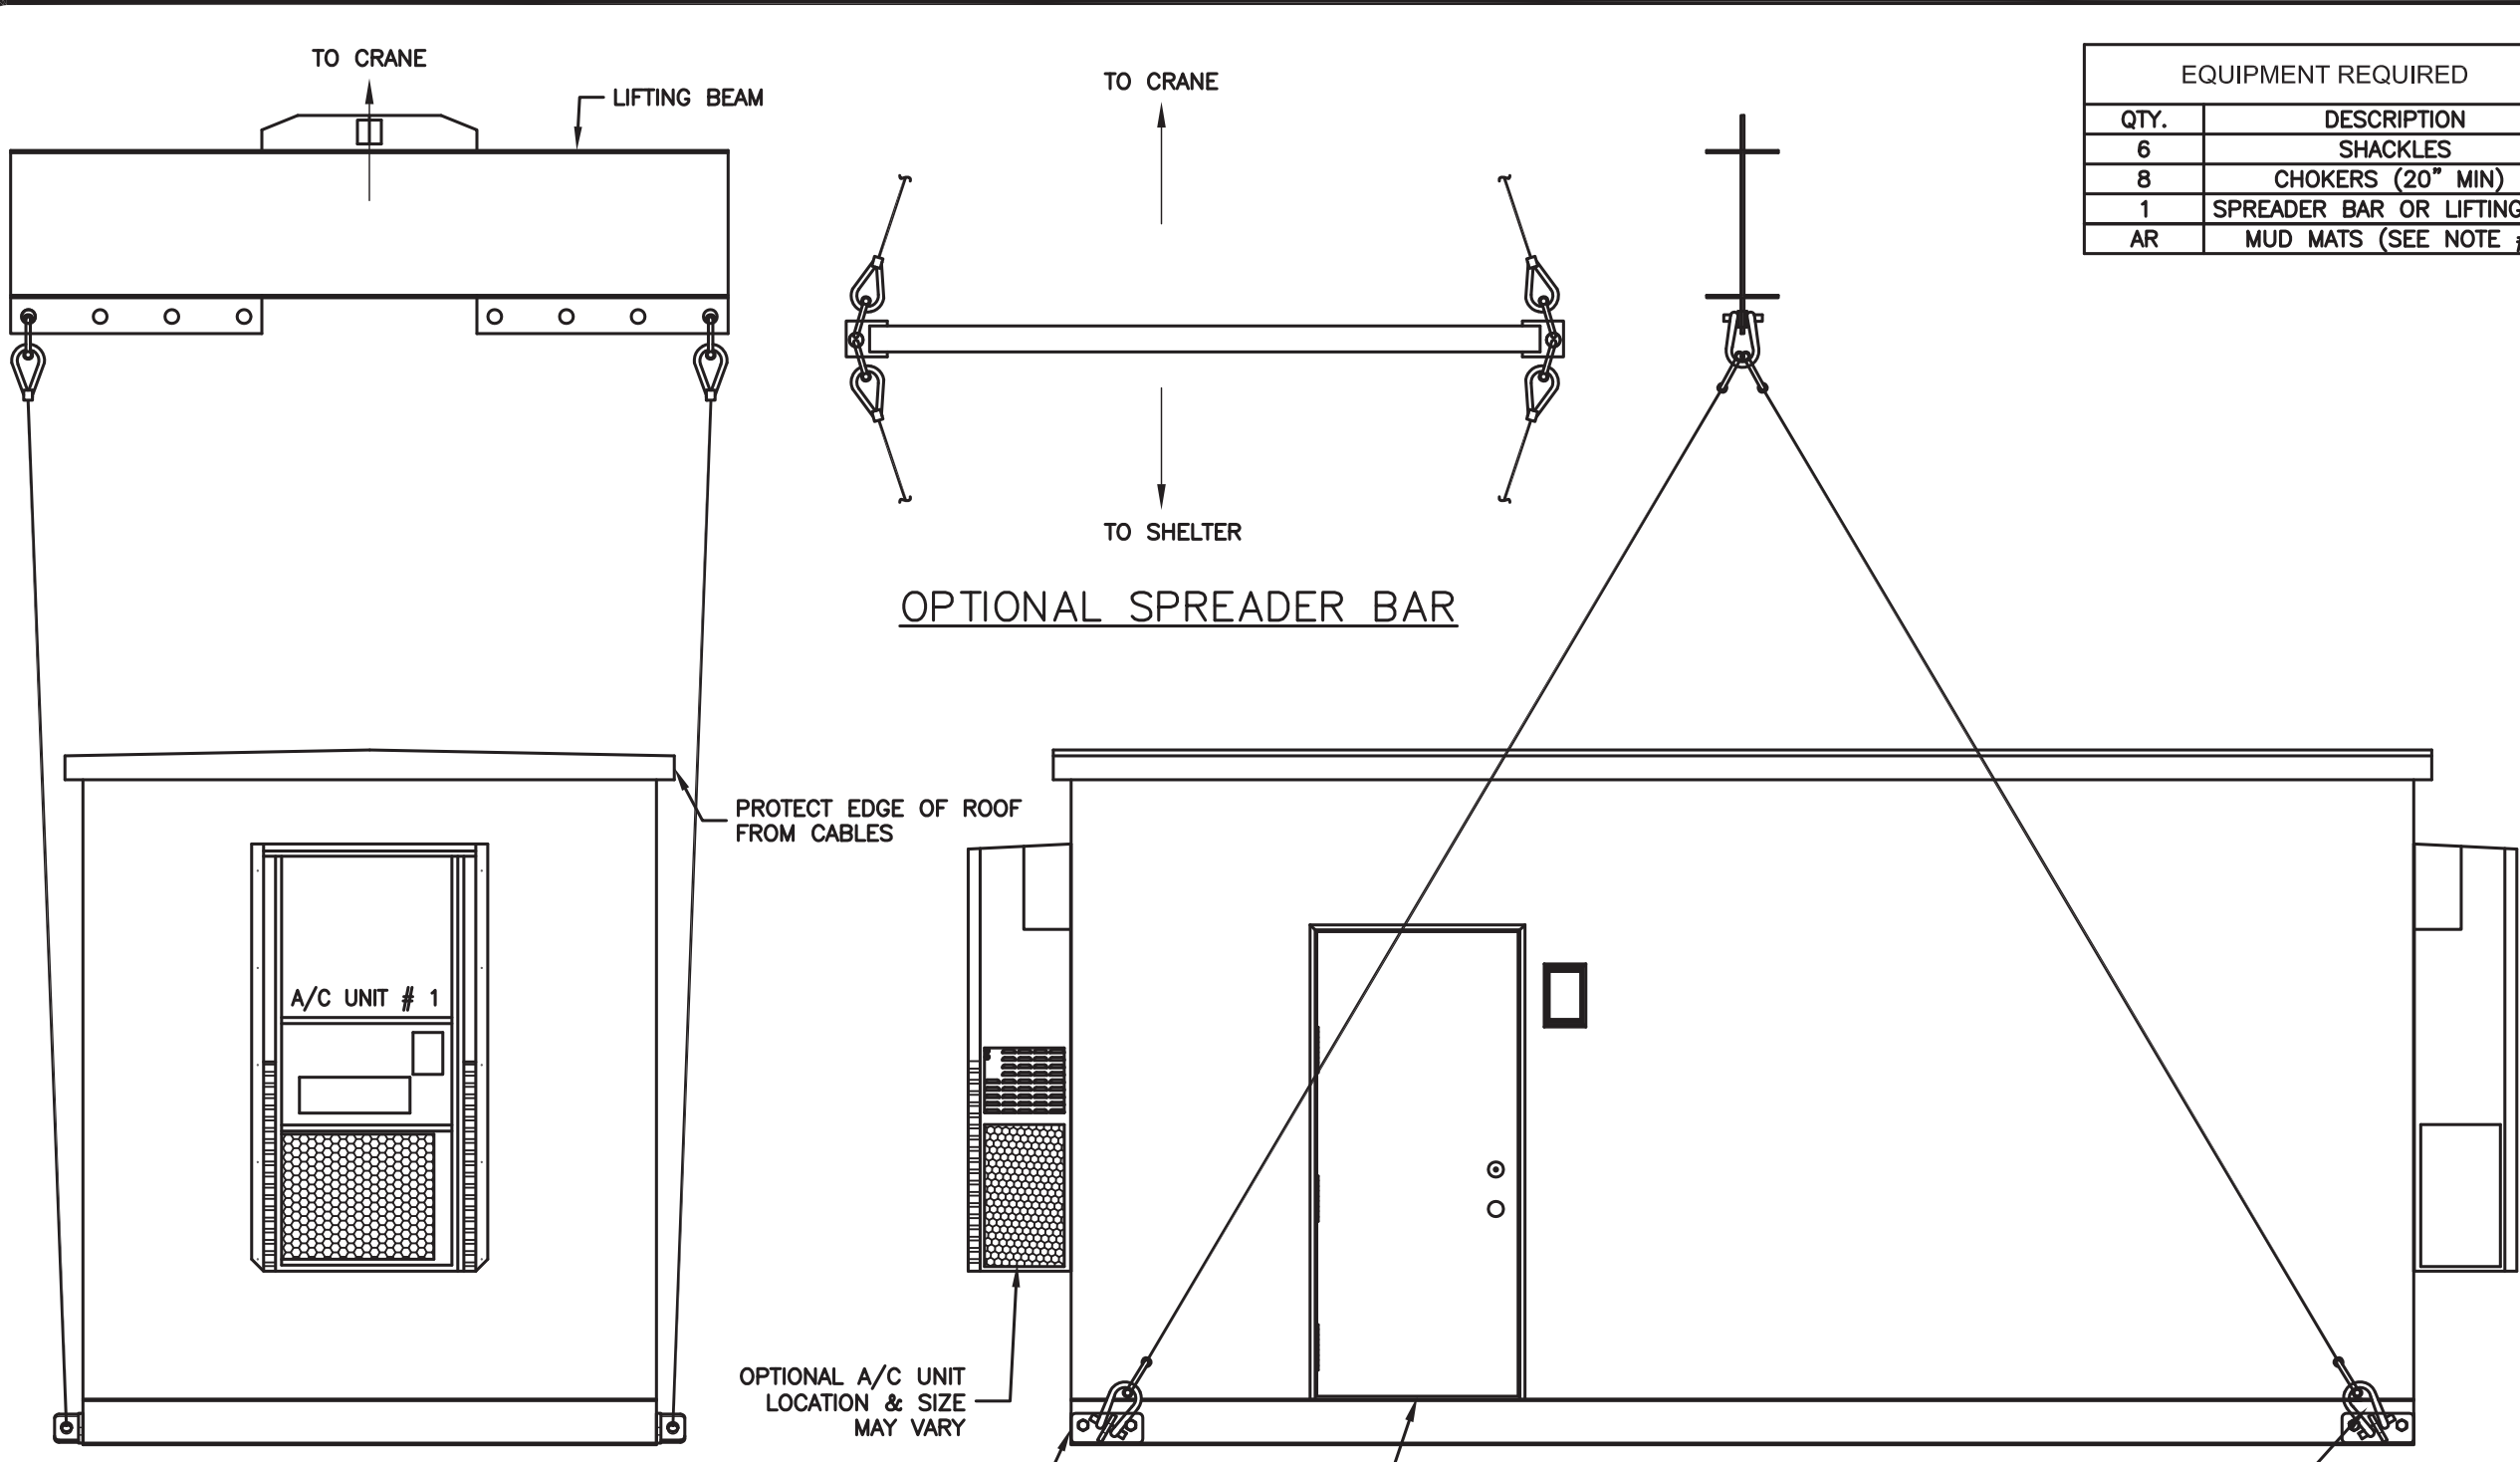

EQUIPMENT REQUIRED	
QTY.	DESCRIPTION
6	SHACKLES
8	CHOKERS (20" MIN)
1	SPREADER BAR OR LIFTING BEAM
AR	MUD MATS (SEE NOTE #2)

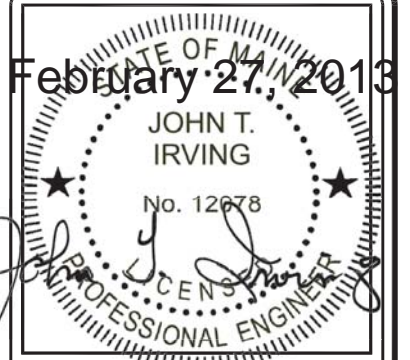

THIS DRAWING IS THE CONFIDENTIAL PROPERTY AND CONTAINS TRADE SECRETS OF CELLXION, LLC. ANY USE OF THESE DRAWINGS OR THE INFORMATION CONTAINED HEREIN FOR ANY REASON OTHER THAN AS EXPRESSLY AUTHORIZED BY CELLXION, LLC. IS STRICTLY PROHIBITED. THIS DRAWING HAS BEEN DISTRIBUTED WITH THE UNDERSTANDING THAT ANYONE RECEIVING OR OTHERWISE OBTAINING POSSESSION OF IT WILL BE EXPRESSLY NOTIFIED OF ITS CONFIDENTIAL NATURE.

**Cellxion**  
 A Division of Sabre Industries, Inc.  
 5031 Hazel Jones Road  
 Bossier City, Louisiana 71111  
 voice: (318) 213-2900  
 fax: (318) 213-2919  
 www.cellxion.com

CUSTOMER:  
 PREP TO MOVE STANDARD

PROJECT:  
 SHELTER LIFTING DETAILS  
 4 LIFTING POINTS

FILENAME: 108-088	
SCALE: N.T.S.	TOLERANCE:
DRWN. BY: J. ASHLEY	DATE: 5/13/08
CHK. BY: V. HASSELL	DATE: 5/13/08
ENG. BY:	DATE:
APP. BY:	DATE:
SHEET NO. 1 OF 3	
DRAWING NO.:	B
108-088	


**END VIEW**  
 SCALE: 1/4" = 1'-0"

**SIDE VIEW**  
 SCALE: 1/4" = 1'-0"

- NOTES:
- FOUR (4) LIFTING POINTS REQUIRED ONLY FOR SHELTER LESS THAN 24' LONG.
  - SHELTER SIZE & CONFIG. MAY VARY.
  - COMPENSATE WEIGHT DIFFERENCE WITH ADDITIONAL SHACKLES IF REQ'D.
  - MUD MATS ARE TO BE USED IF SITE CONDITIONS WARRANT.
  - REVIEW WEIGHT TICKETS AND SITE CONDITIONS TO DETERMINE PROPER SIZING OF EQUIPMENT AND RIGGING.
  - SPREADER LENGTH TO BE WIDER THAN SHELTER TO KEEP CABLES FROM RUBBING AT ROOF.

REV BY	DATE	DESCRIPTION	APP. BY	DATE
B	GAB 01/19/11	ADDED THE WORD OPTIONAL TO THE A/C	GAB	01/19/11
A	AMM 9/15/09	ADDED 8 LIFTING POINTS OPTION	LD	9/15/09



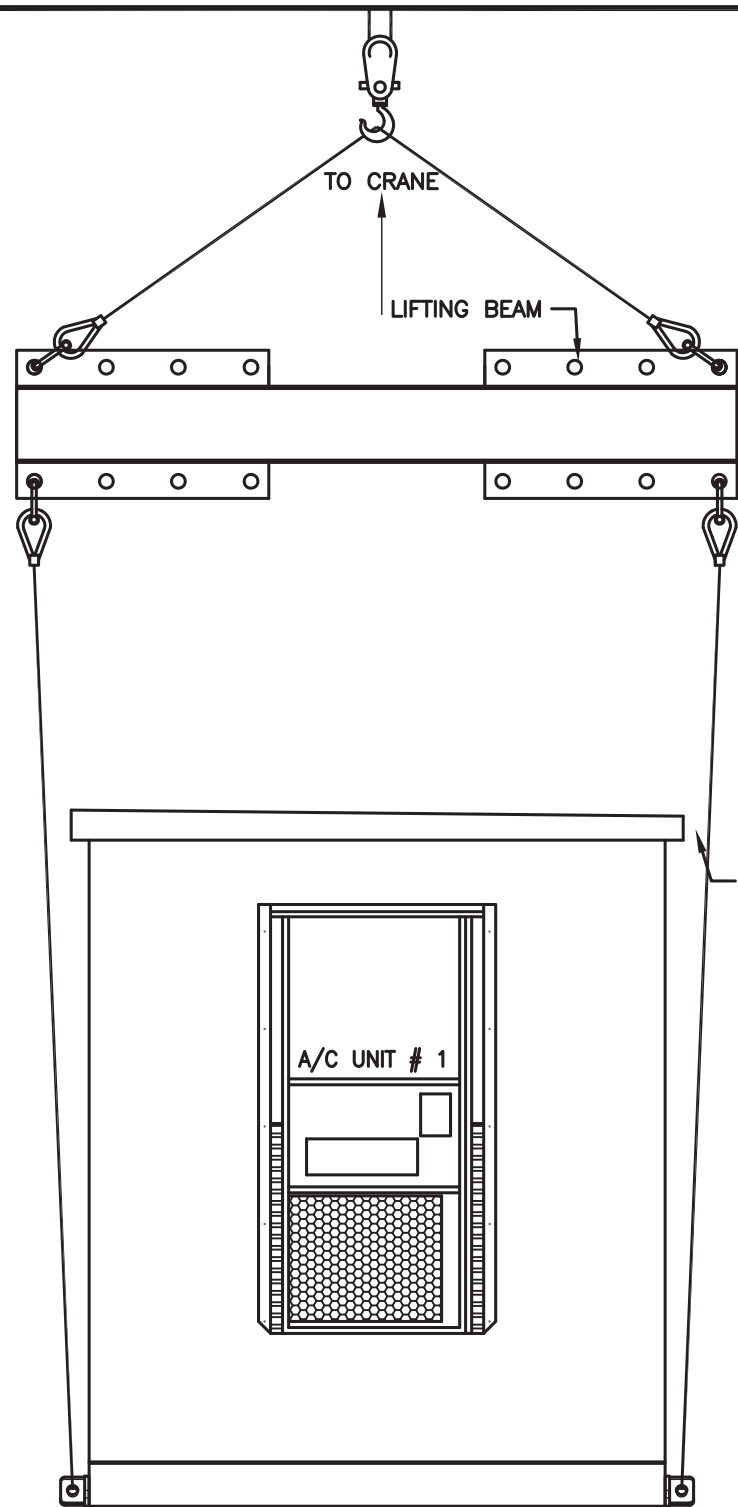

**END VIEW**  
SCALE: 1/4" = 1'-0"

**NOTES:**


1. EIGHT (8) LIFTING POINTS REQUIRED ONLY FOR SHELTER 24' AND LONGER.
2. SHELTER SIZE & CONFIG. MAY VARY.
3. COMPENSATE WEIGHT DIFFERENCE WITH ADDITIONAL SHACKLES IF REQ'D.
4. MUD MATS ARE TO BE USED IF SITE CONDITIONS WARRANT.
5. REVIEW WEIGHT TICKETS AND SITE CONDITIONS TO DETERMINE PROPER SIZING OF EQUIPMENT AND RIGGING.
6. SPREADER LENGTH TO BE WIDER THAN SHELTER TO KEEP CABLES FROM RUBBING AT ROOF.

PROTECT EDGE OF ROOF FROM CABLES

OPTIONAL A/C UNIT LOCATION & SIZE MAY VARY

LIFTING LUG PROVIDED BY CELLXION


DOOR LOCATION MAY VARY

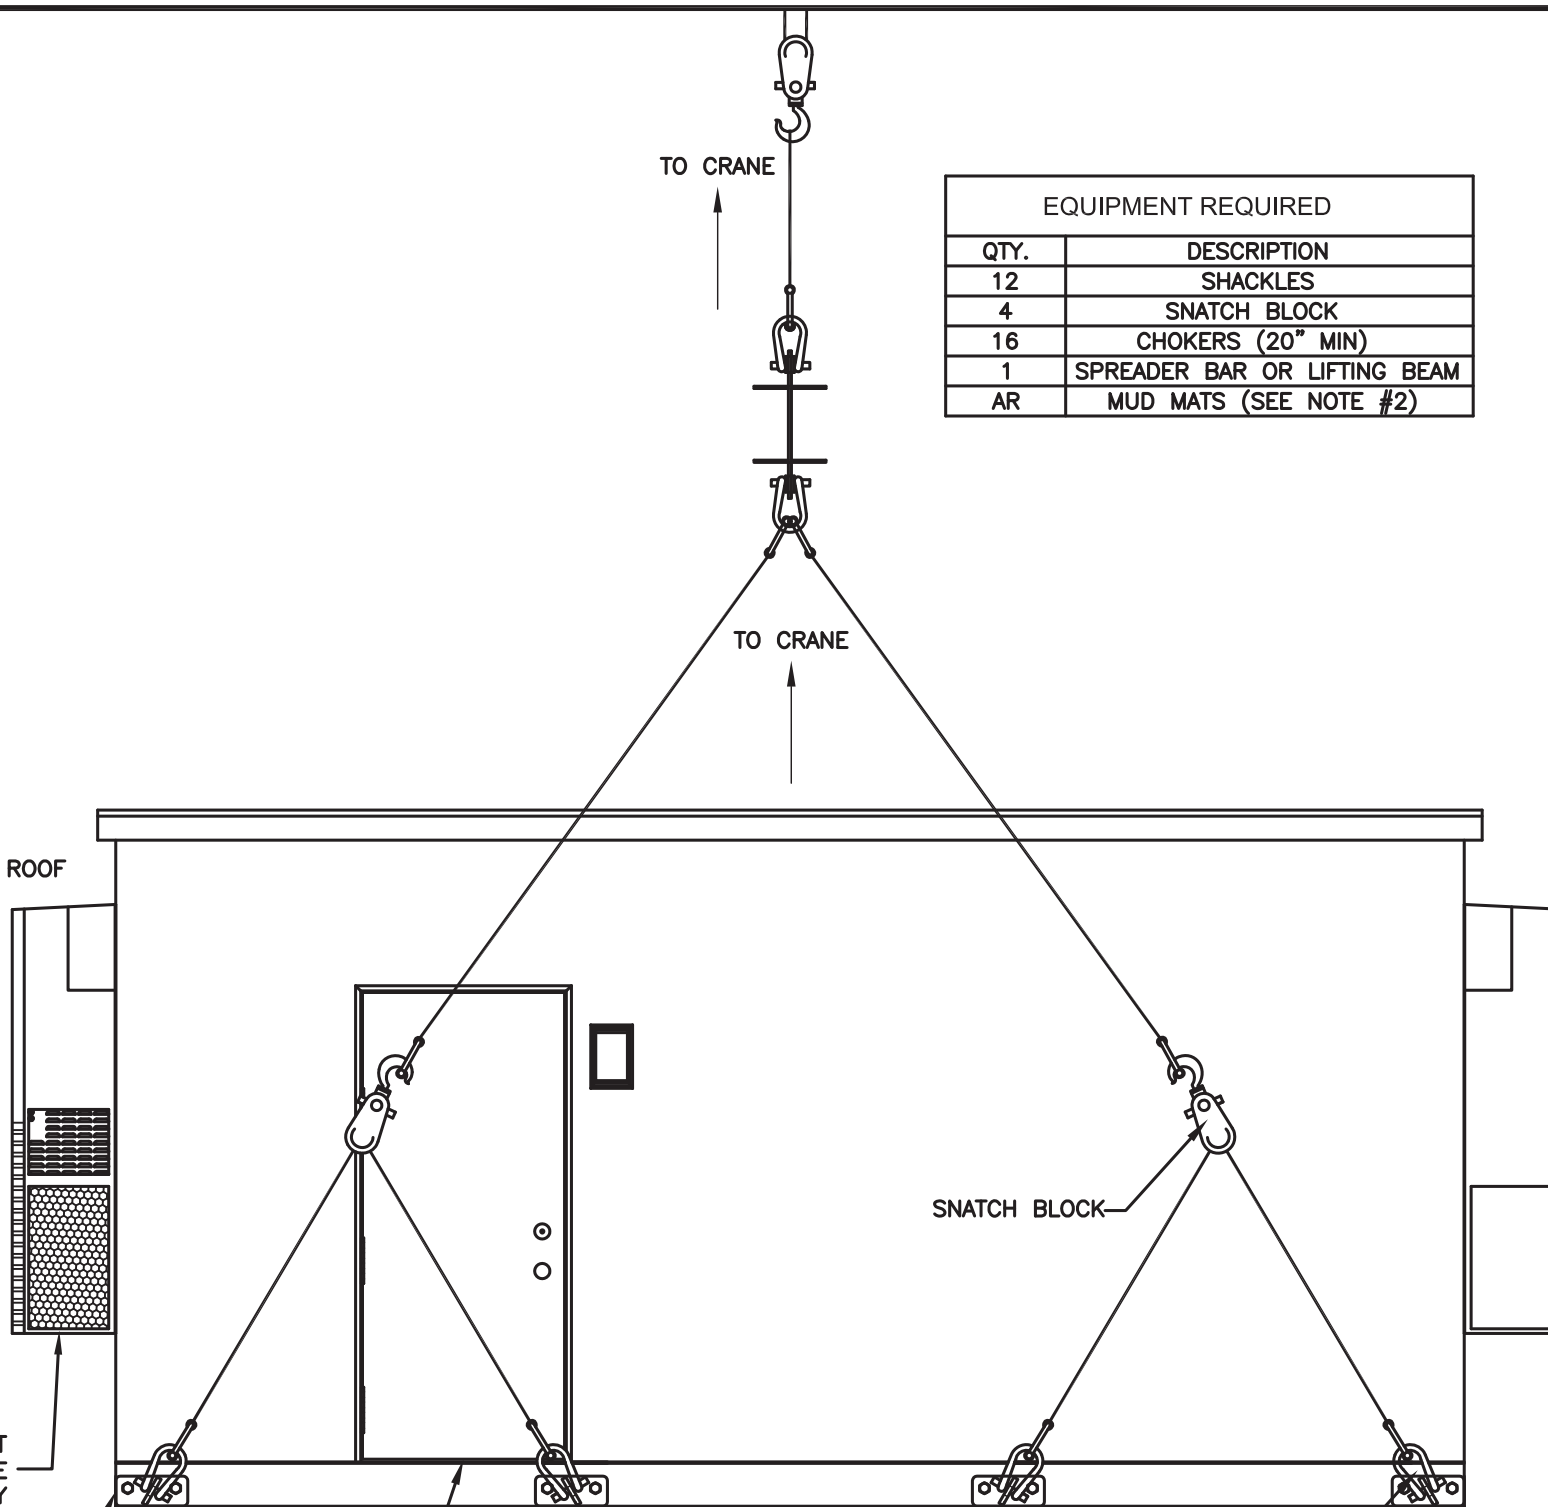

**SIDE VIEW**  
SCALE: 1/4" = 1'-0"

MAX. Ø OF SHACKLE PIN TO BE 1 1/2".

EQUIPMENT REQUIRED	
QTY.	DESCRIPTION
12	SHACKLES
4	SNATCH BLOCK
16	CHOKERS (20" MIN)
1	SPREADER BAR OR LIFTING BEAM
AR	MUD MATS (SEE NOTE #2)

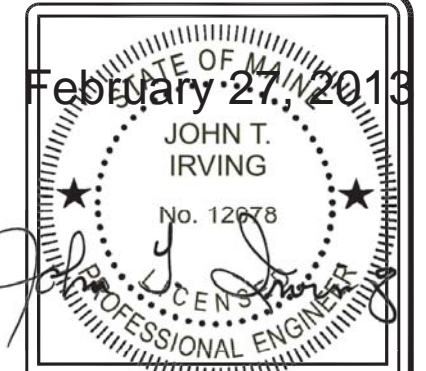

THIS DRAWING IS THE CONFIDENTIAL PROPERTY AND CONTAINS TRADE SECRETS OF CELLXION, LLC. ANY USE OF THESE DRAWINGS OR THE INFORMATION CONTAINED HEREIN FOR ANY REASON OTHER THAN AS EXPRESSLY AUTHORIZED BY CELLXION, LLC. IS STRICTLY PROHIBITED. THIS DRAWING HAS BEEN DISTRIBUTED WITH THE UNDERSTANDING THAT ANYONE RECEIVING OR OTHERWISE OBTAINING POSSESSION OF IT WILL BE EXPRESSLY NOTIFIED OF ITS CONFIDENTIAL NATURE.

**Cellxion**  
A Division of Sabre Industries, Inc.  
5031 Hazel Jones Road  
Bossier City, Louisiana 71111  
voice: (318) 213-2900  
fax: (318) 213-2919  
www.cellxion.com

CUSTOMER:  
**PREP TO MOVE STANDARD**

PROJECT:  
**SHELTER LIFTING DETAILS  
8 LIFTING POINTS  
OPTION-1**

FILENAME: 108-088	
SCALE: N.T.S.	TOLERANCE:
DRWN. BY: J. ASHLEY	DATE: 5/13/08
CHK. BY: V. HASSELL	DATE: 5/13/08
APP. BY:	DATE:
SHEET NO. 2 OF 3	
DRAWING NO.:	B
108-088	


REV BY	DATE	DESCRIPTION	APP. BY	DATE
B	GAB 01/19/11	ADDED THE WORD OPTIONAL TO THE A/C	GAB	01/19/11
A	AMM 9/15/09	ADDED 8 LIFTING POINTS OPTION	LD	9/15/09



NOTES:


1. EIGHT (8) LIFTING POINTS REQUIRED ONLY FOR SHELTER 24' AND LONGER.
2. SHELTER SIZE & CONFIG. MAY VARY.
3. COMPENSATE WEIGHT DIFFERENCE WITH ADDITIONAL SHACKLES IF REQ'D.
4. MUD MATS ARE TO BE USED IF SITE CONDITIONS WARRANT.
5. REVIEW WEIGHT TICKETS AND SITE CONDITIONS TO DETERMINE PROPER SIZING OF EQUIPMENT AND RIGGING.
6. SPREADER LENGTH TO BE WIDER THAN SHELTER TO KEEP CABLES FROM RUBBING AT ROOF.

EQUIPMENT REQUIRED	
QTY.	DESCRIPTION
22	SHACKLES
28	CHOKERS (20" MIN)
3	SPREADER BAR OR LIFTING BEAM
AR	MUD MATS (SEE NOTE #2)

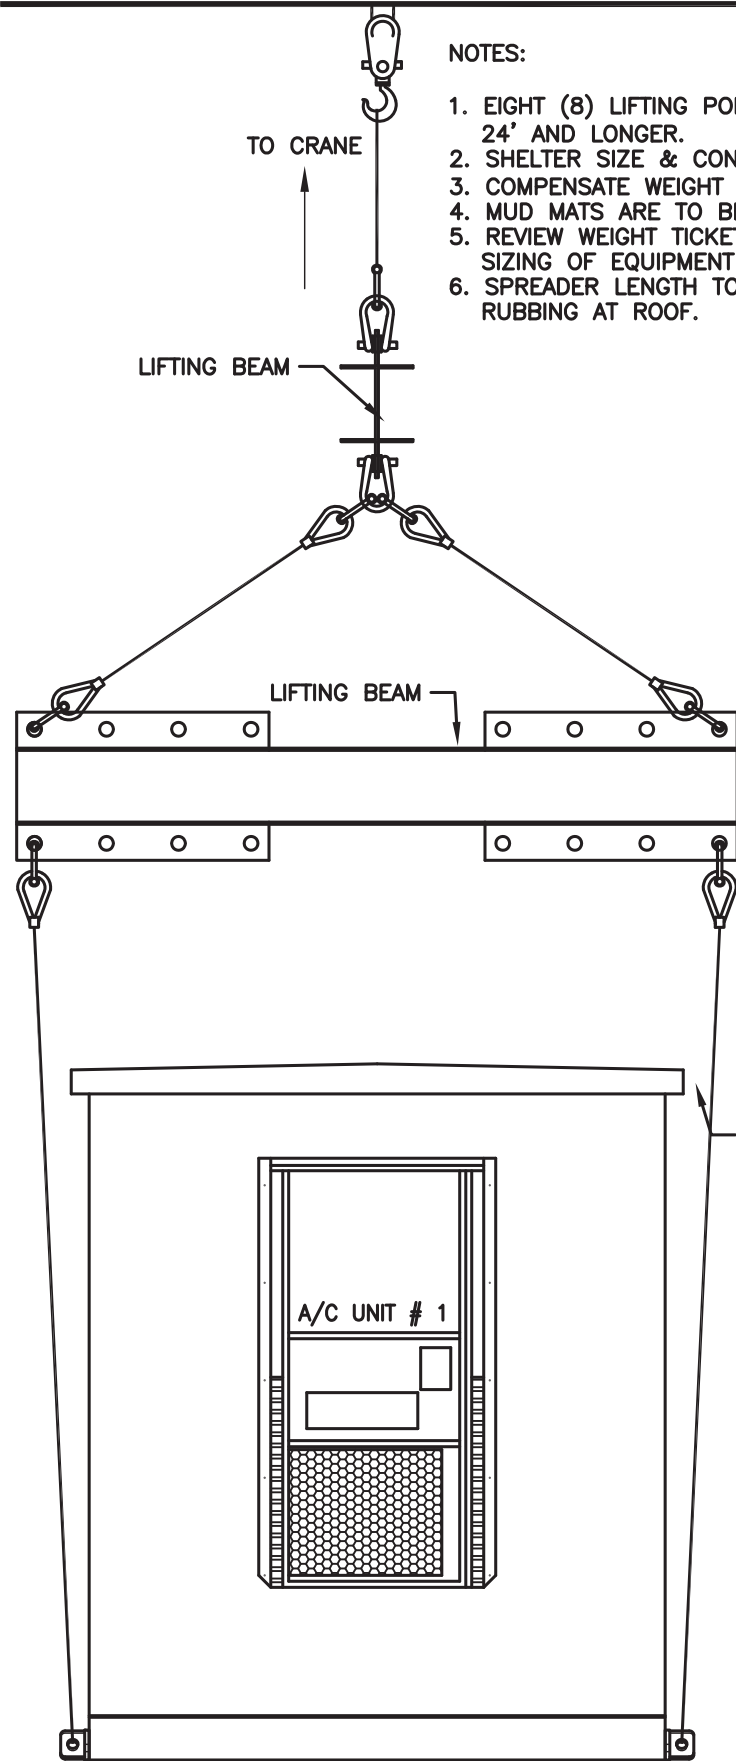


END VIEW

SCALE: 1/4" = 1'-0"

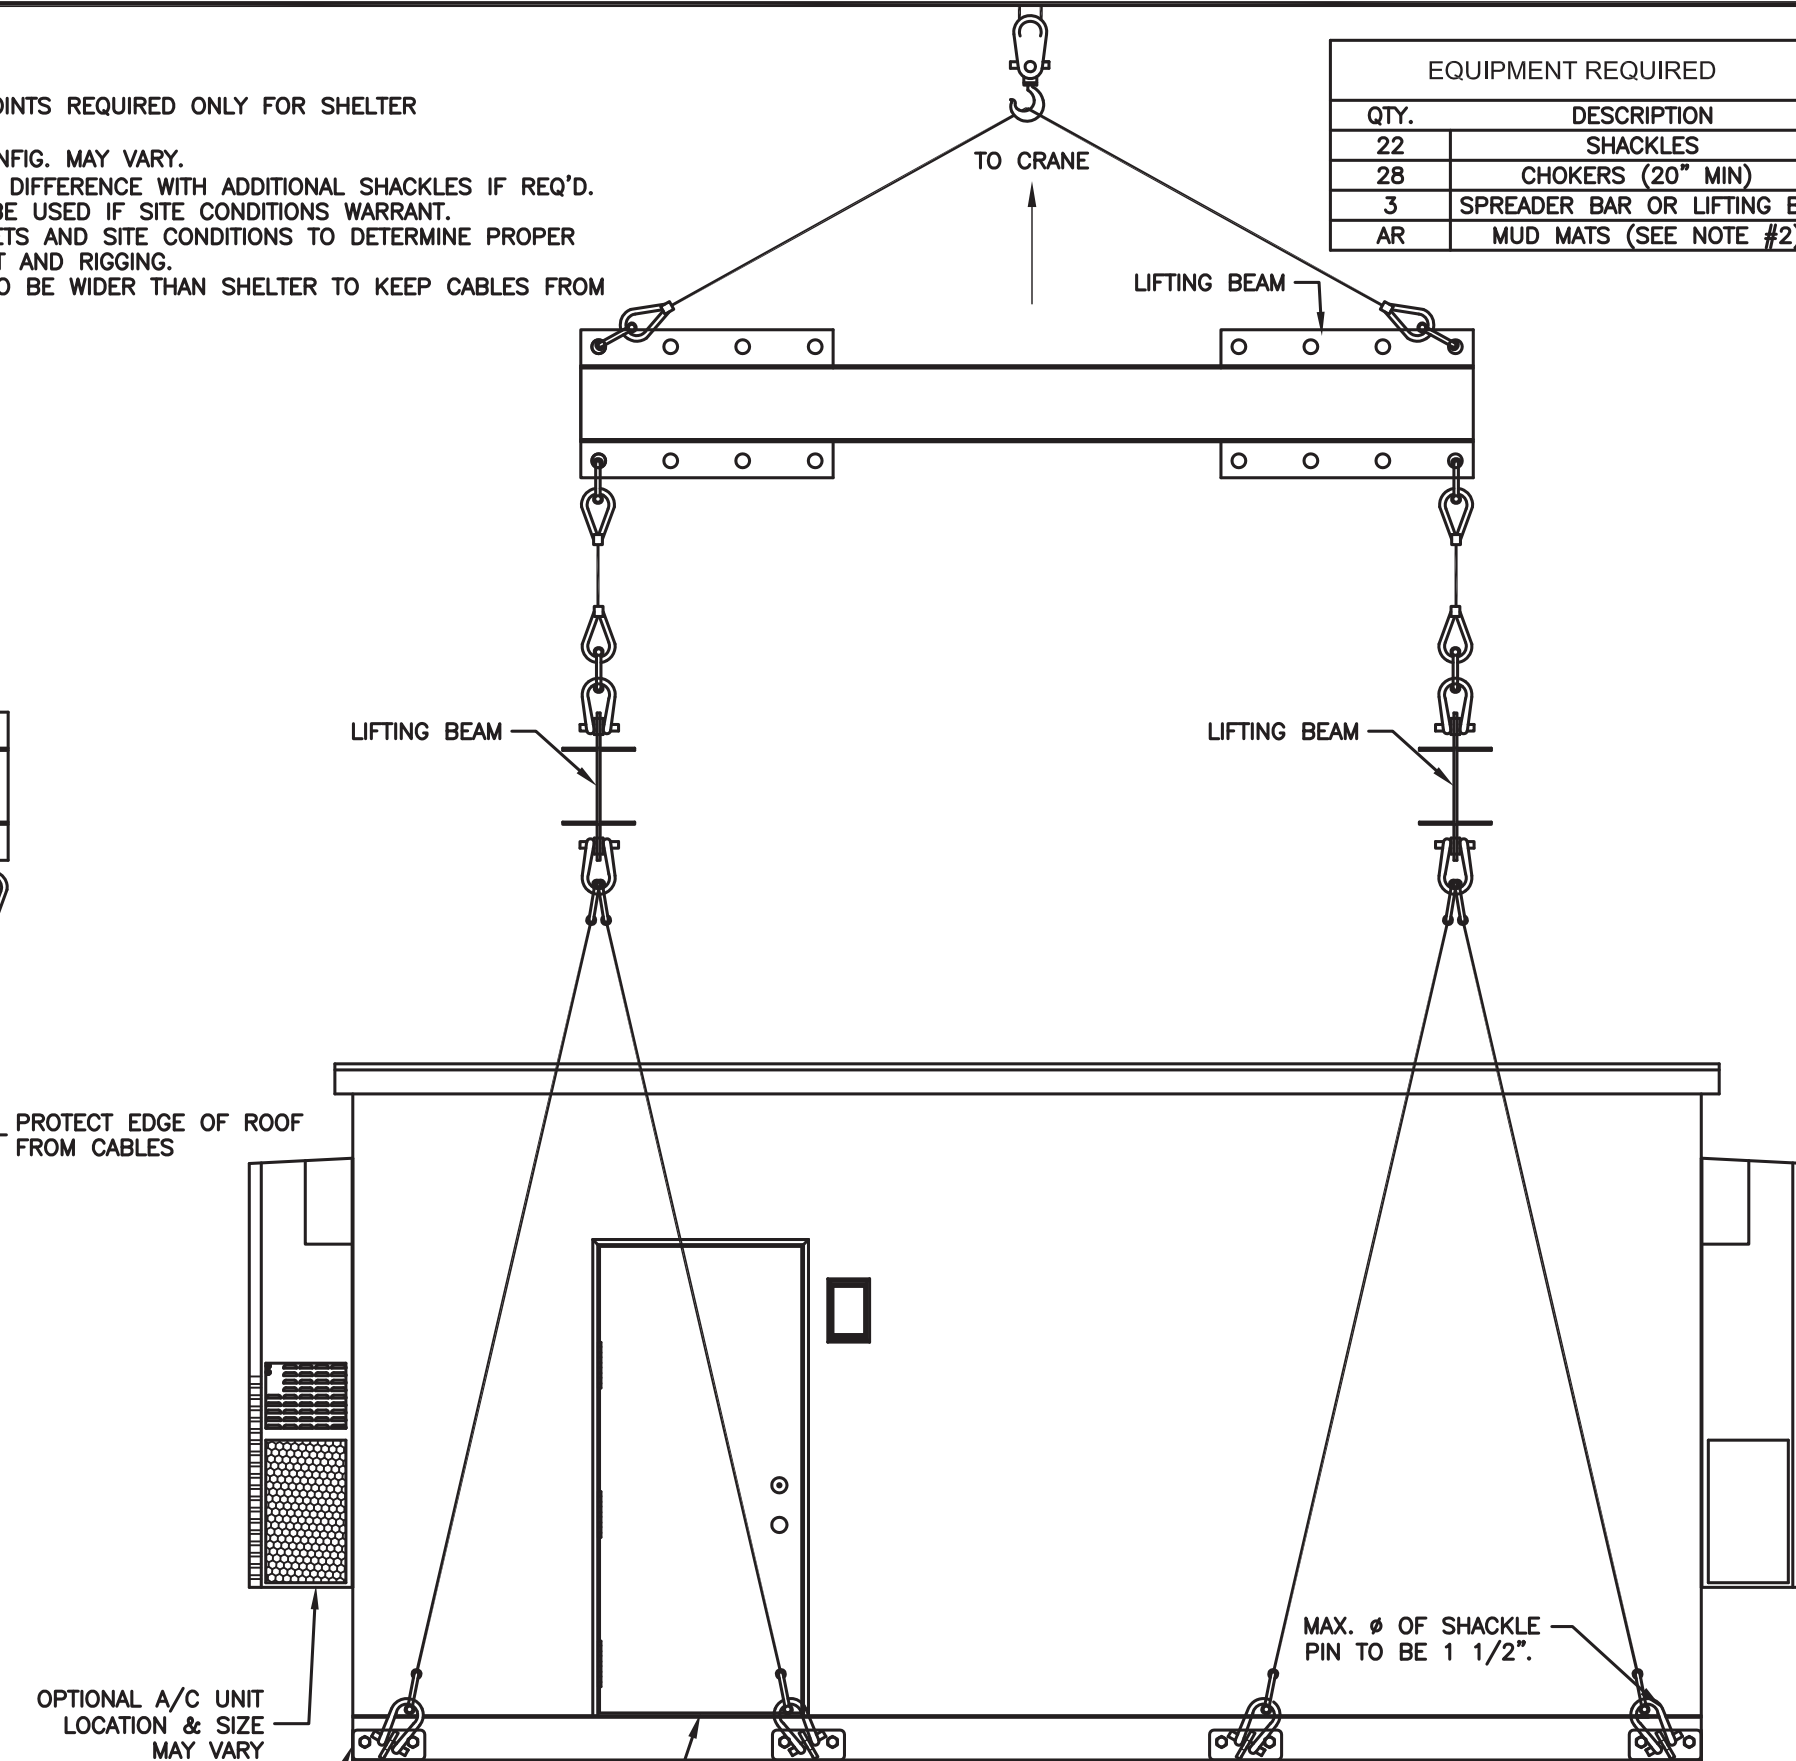

SIDE VIEW

SCALE: 1/4" = 1'-0"

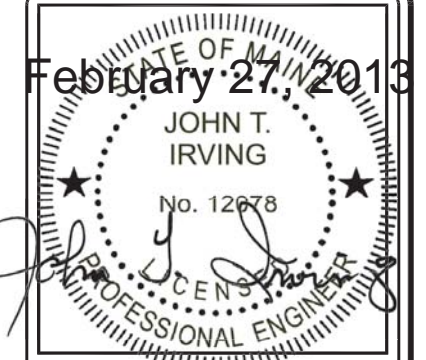

THIS DRAWING IS THE CONFIDENTIAL PROPERTY AND CONTAINS TRADE SECRETS OF CELLXION, LLC. ANY USE OF THESE DRAWINGS OR THE INFORMATION CONTAINED HEREIN FOR ANY REASON OTHER THAN AS EXPRESSLY AUTHORIZED BY CELLXION, LLC. IS STRICTLY PROHIBITED. THIS DRAWING HAS BEEN DISTRIBUTED WITH THE UNDERSTANDING THAT ANYONE RECEIVING OR OTHERWISE OBTAINING POSSESSION OF IT WILL BE EXPRESSLY NOTIFIED OF ITS CONFIDENTIAL NATURE.

**Cellxion**  
 A Division of Sabre Industries, Inc.  
 5031 Hazel Jones Road  
 Bossier City, Louisiana 71111  
 voice: (318) 213-2900  
 fax: (318) 213-2919  
 www.cellxion.com

CUSTOMER:  
 PREP TO MOVE  
 STANDARD

PROJECT:  
 SHELTER LIFTING  
 DETAILS  
 8 LIFTING POINTS  
 OPTION-2



FILENAME: 108-088	
SCALE: N.T.S.	TOLERANCE:
DRWN. BY: J. ASHLEY	DATE: 5/13/08
CHK. BY: V. HASSELL	DATE: 5/13/08
ENG. BY:	DATE:
APP. BY:	DATE:

SHEET NO.  
 3 OF 3  
 DRAWING NO.:  
 108-088


REV	BY	DATE	DESCRIPTION	APP. BY	DATE
B	GAB	01/19/11	ADDED THE WORD OPTIONAL TO THE A/C	GAB	01/19/11
A	AMM	9/15/09	ADDED 8 LIFTING POINTS OPTION	LD	9/15/09

PARTS LIST								
ITEM	QTY	U/M	P/N	DESCRIPTION	LENGTH	WIDTH	DEPTH	PCS
500	1.500	FT	170000	PIPE, PVC, SCH 40, 1"	6.000 in			3
501	4.000	FT	170000	PIPE, PVC, SCH 40, 1"	12.000 in			4
502	0.14583 ft	FT	170000	PIPE, PVC, SCH 40, 1"	1.750 in			1
503	0.666	FT	170001	PIPE, PVC, SCH 40, 1/2"	2.000 in			8
504	1.500	FT	170003	PIPE, PVC, SCH 40, 1 1/2"	6.000 in			3
505	3.000	FT	170010	PIPE, PVC, SCH 40, 2"	6.000 in			5
506	0.50000 ft	FT	170011	PIPE, PVC, SCH 40, 2 1/2"	6.000 in			1
507	0.500	FT	350228	LUMBER, #2 PINE, 1X6, RAW MATL	6.000 in			1
508	1	EA.	221-1000X1800-02	CONCRETE FLOOR ASSY KIT, 10'0"X18'0"				1
509	2	EA.	222-1000X0903-008	WALL KIT, CON, END, AC, STD				2
510	1	EA.	223-1800X0903-001	WALL KIT, CON, SIDE, DR, STD				1
511	1	EA.	223-1800X0903-002	WALL KIT, CON, SIDE, BO, STD				1
512	36	EA.	223102	INSERT, WELD PLATE 1/4"X3"X4", F/B				1
513	1	EA.	226-1000X1800X4-00	ROOF ASSY KIT, CONCRETE, 10'0"X 18'0"				1
514	5.043	FBM	360151	INSULATION, EPS, FOAM, RAW MATL B-FOOT	20.750 in	8.750 in	4.000 in	1
515	7.349	FBM	360151	INSULATION, EPS, FOAM, RAW MATL B-FOOT	20.750 in	12.750 in	4.000 in	1
516	1.111	FBM	360151	INSULATION, EPS, FOAM, RAW MATL B-FOOT	10.000 in	4.000 in	4.000 in	1
517	.694	FBM	360151	INSULATION, EPS, FOAM, RAW MATL B-FOOT	5.000 in	5.000 in	4.000 in	1
518	3.807	FBM	360151	INSULATION, EPS, FOAM, RAW MATL B-FOOT	10.750 in	12.750 in	4.000 in	1
519	.247	FBM	360151	INSULATION, EPS, FOAM, RAW MATL B-FOOT	4.750 in	3.000 in	2.500 in	1
520	26.868	FBM	360151	INSULATION, EPS, FOAM, RAW MATL B-FOOT	18.250 in	26.500 in	4.000 in	2
521	1	EA.	501001	DOOR FRM, 3670, LH, CURRIES, 16G, GALV				1
522	5	EA.	540237	GROUND STRAP ASSEMBLY, STRUCTURE, 12" SOLID				5
523	14	EA.	300032	INSULATION, 1.75" RMAX, POLY, 48"X110"				1
524	5	EA.	300033	INSULATION, 2.25" RMAX, POLY, 48"X132"				1

CUT LIST						
ITEM	P/N	DESCRIPTION	LENGTH	WIDTH	DEPTH	PCS
500	170000	PIPE, PVC, SCH 40, 1"	6.000 in			3
501	170000	PIPE, PVC, SCH 40, 1"	12.000 in			4
502	170000	PIPE, PVC, SCH 40, 1"	1.750 in			1
503	170001	PIPE, PVC, SCH 40, 1/2"	2.000 in			8
504	170003	PIPE, PVC, SCH 40, 1 1/2"	6.000 in			3
505	170010	PIPE, PVC, SCH 40, 2"	6.000 in			5
506	170011	PIPE, PVC, SCH 40, 2 1/2"	6.000 in			1
507	350228	LUMBER, #2 PINE, 1X6, RAW MATL	6.000 in			1
514	360151	INSULATION, EPS, FOAM, RAW MATL B-FOOT	20.750 in	8.750 in	4.000 in	1
515	360151	INSULATION, EPS, FOAM, RAW MATL B-FOOT	20.750 in	12.750 in	4.000 in	1
516	360151	INSULATION, EPS, FOAM, RAW MATL B-FOOT	10.000 in	4.000 in	4.000 in	1
517	360151	INSULATION, EPS, FOAM, RAW MATL B-FOOT	5.000 in	5.000 in	4.000 in	1
518	360151	INSULATION, EPS, FOAM, RAW MATL B-FOOT	10.750 in	12.750 in	4.000 in	1
519	360151	INSULATION, EPS, FOAM, RAW MATL B-FOOT	4.750 in	3.000 in	2.500 in	1
520	360151	INSULATION, EPS, FOAM, RAW MATL B-FOOT	18.250 in	26.500 in	4.000 in	2

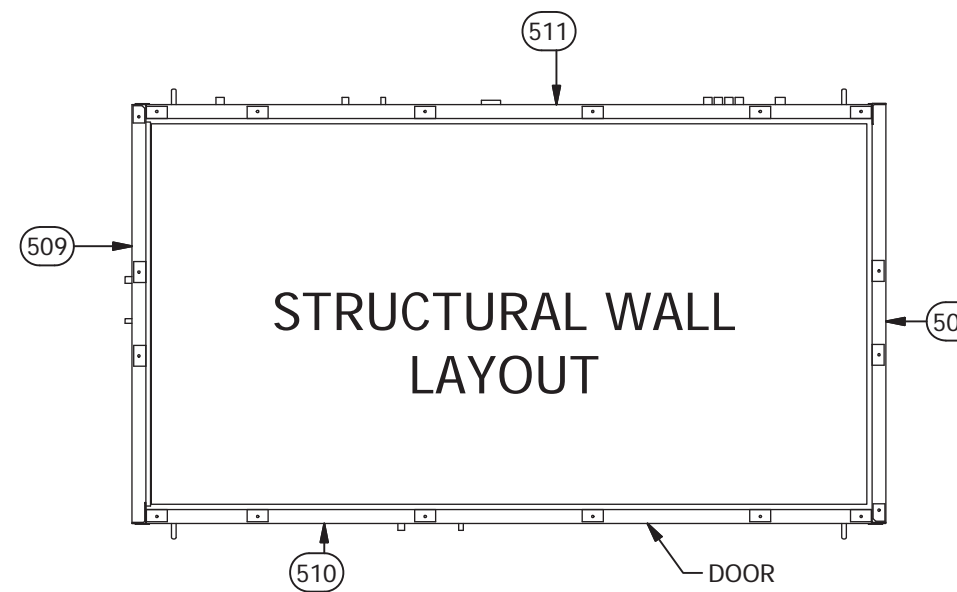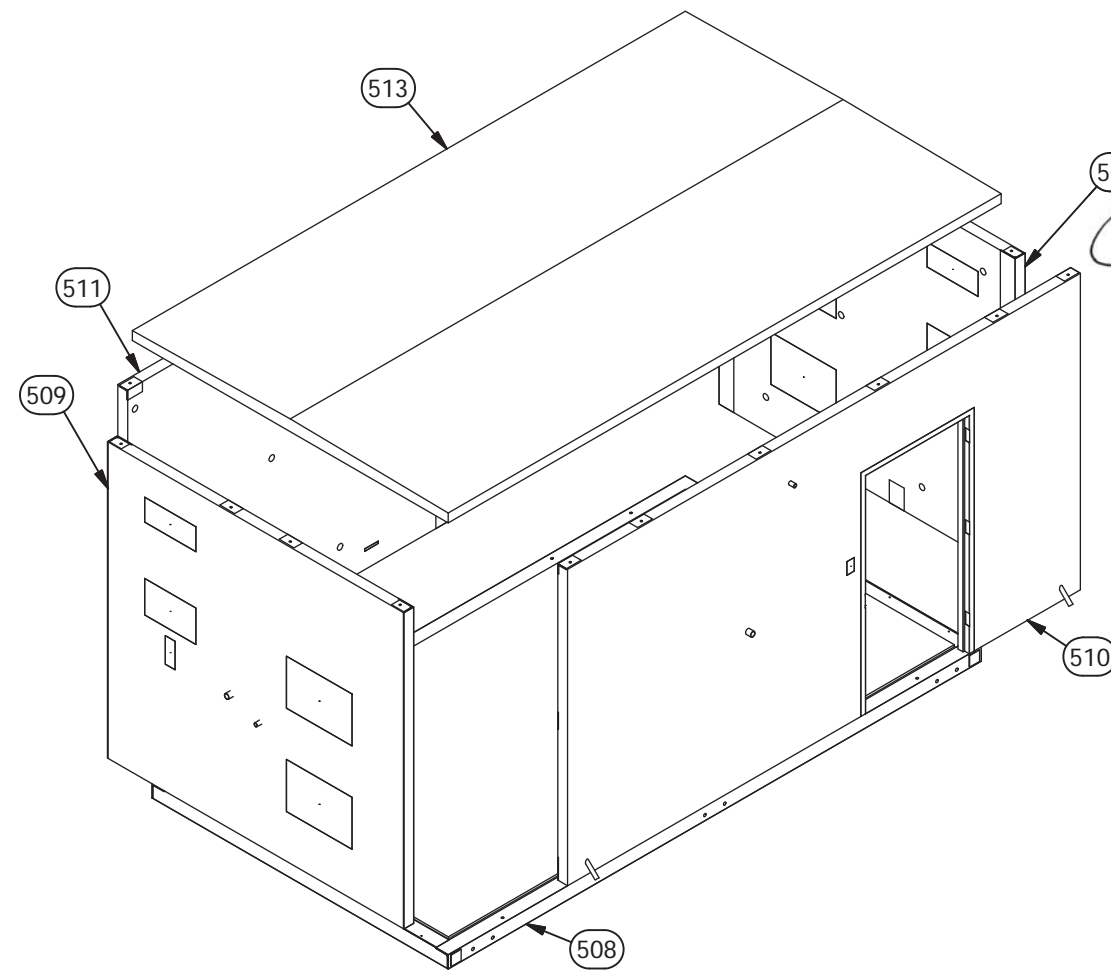

SHOP DETAILS	
DWG. NO.	DESCRIPTION
10-001	GENERAL INFORMATION SPECIFICATIONS
10-002	WALL TO ROOF CONNECTION
10-003	WALL TO FLOOR CONNECTION
10-004	WALL TO WALL CONNECTION
10-005	WELD PLATE DETAIL
10-007	CORNER BAR DETAIL
12-001	CONCRETE SHELTER FLOOR STEP JOINT
12-002	CONCRETE SHELTER FLOOR RIB SECTION
13-001	CONCRETE SHELTER ROOF RIDGE SECTION
13-002	CONCRETE SHELTER ROOF EAVE SECTION
14-001	CONCRETE SHELTER WALL BOTTOM SECTION
14-002	CONCRETE SHELTER WALL TOP SECTION
14-003	CONCRETE SHELTER END PANEL EDGE SECTION
14-004	CONCRETE SHELTER WALL BLOCKOUT SECTION
20-005	WALL/ROOF COVE INSTALLATION
20-006	CORNER COVE INSTALLATION
20-008	BATTEN TRIM INSTALLATION
20-020	1 LAYER CEILING DETAIL
20-021	1 LAYER WALL DETAIL
20-023	1 LAYER 2 PC TRIM
50-037	ALLTEL BUILDING STEEL GROUND

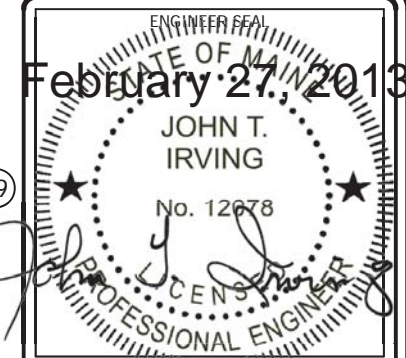

THIS DRAWING IS THE CONFIDENTIAL PROPERTY AND CONTAINS TRADE SECRETS OF CELLXION, LLC. ANY USE OF THESE DRAWINGS OR THE INFORMATION CONTAINED HEREIN FOR ANY REASON OTHER THAN AS EXPRESSLY AUTHORIZED BY CELLXION, LLC. IS STRICTLY PROHIBITED. THIS DRAWING HAS BEEN DISTRIBUTED WITH THE UNDERSTANDING THAT ANYONE RECEIVING OR OTHERWISE OBTAINING POSSESSION OF IT WILL BE EXPRESSLY NOTIFIED OF ITS CONFIDENTIAL NATURE.

**Cellxion**  
A Division of Sabre Industries, Inc.  
5031 Hazel Jones Road  
Bossier City, LA 71111  
voice: 318-213-2900  
fax: 318-213-2919  
www.cellxion.com

CUSTOMER:

PROJECT:  
10'-0" X 18'-0"  
CONCRETE SHELTER  
STRUCTURAL  
SPECIFICATIONS

FILENAME: SKBR02S.dwg	
DESIGN BY: M. TREKELL	DATE: 11/4/2010
DRAWN BY: M. TREKELL	DATE: 11/4/2010
CHECKED BY: W. RODRIGUEZ	DATE: 11/4/2010
ENGINEERED BY:	DATE:

APPROVED BY:  
S. LEGGETT

DATE:  
11/8/2010

SHEET NO.:  
1 OF 6

DRAWING NO.:  
SKBR02S


REV:  
P

N	RRG	6/13/12	CHANGES PER CHANGE ORDER 12KBR02-002-2	LJL
REV	BY	DATE	DESCRIPTION	APP BY


SUB - PARTS LIST								
ITEM	QTY	U/M	P/N	DESCRIPTION	LENGTH	WIDTH	DEPTH	PCS
500	1.500	FT	170000	PIPE, PVC, SCH 40, 1"	6.000 in			3
501	4.000	FT	170000	PIPE, PVC, SCH 40, 1"	12.000 in			4
502	0.14583 ft	FT	170000	PIPE, PVC, SCH 40, 1"	1.750 in			1
504	1.500	FT	170003	PIPE, PVC, SCH 40, 1 1/2"	6.000 in			3
510	1	EA.	223-1800X0903-001	WALL KIT, CON, SIDE, DR, STD				1
519	.247	FBM	360151	INSULATION, EPS, FOAM, RAW MATL B-FOOT	4.750 in	3.000 in	2.500 in	1
521	1	EA.	501001	DOOR FRM, 3670, LH, CURRIES, 16G, GALV				1
522	5	EA.	540237	GROUND STRAP ASSEMBLY, STRUCTURE, 12" SOLID				5

**NOTES:**


- CUT WIRE MESH AROUND ALL BLOCKOUTS.
- PUSH PVC 1/4" INTO FOAM TO SEAL, GLUE IF DESIRED. FOAM & PVC TO BE REMOVED AFTER CASTING.

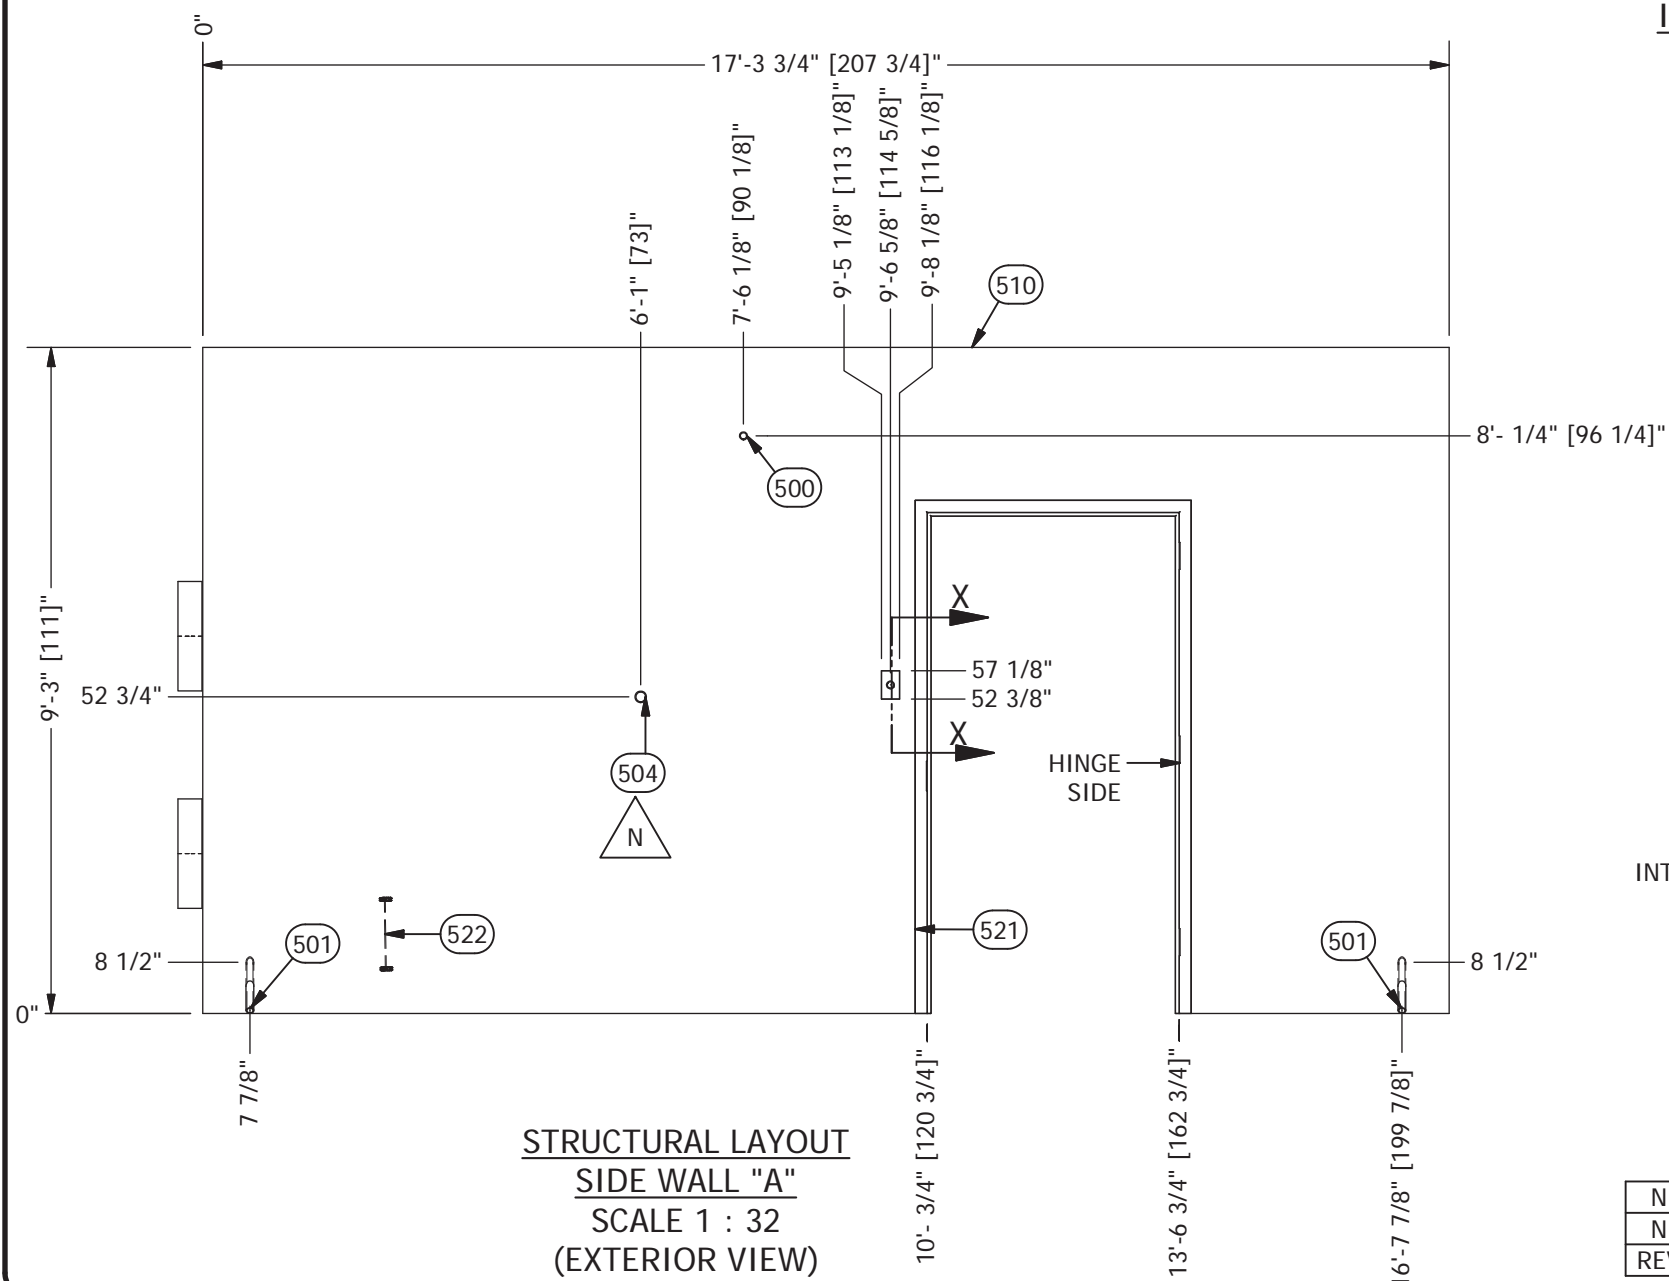


**STRUCTURAL LAYOUT  
SIDE WALL "A"  
SCALE 1 : 32  
(EXTERIOR VIEW)**

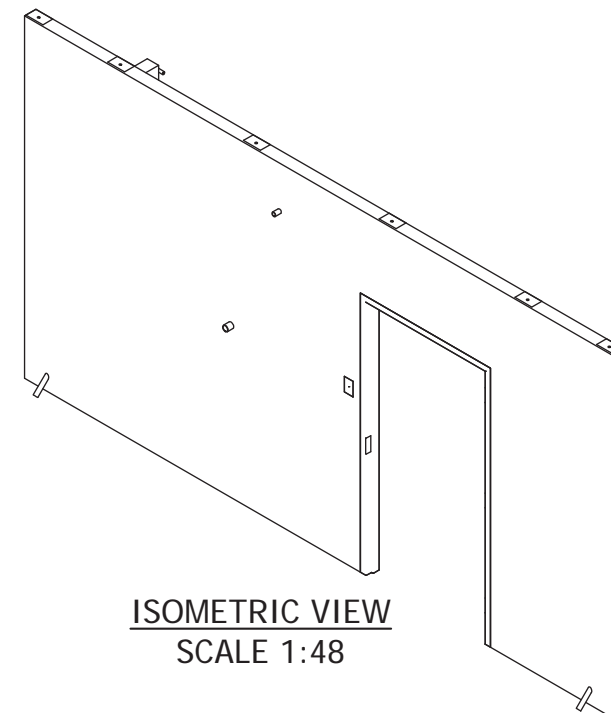


**ISOMETRIC VIEW  
SCALE 1:48**

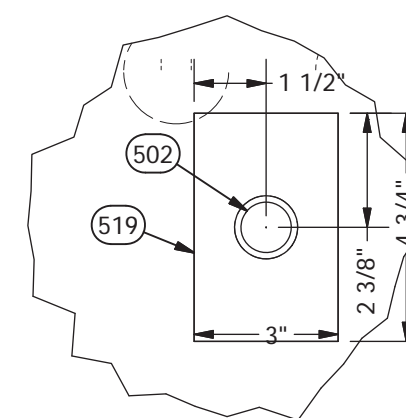

**FOAM BLOCKOUT DETAIL  
BACK VIEW  
SCALE 1:4**

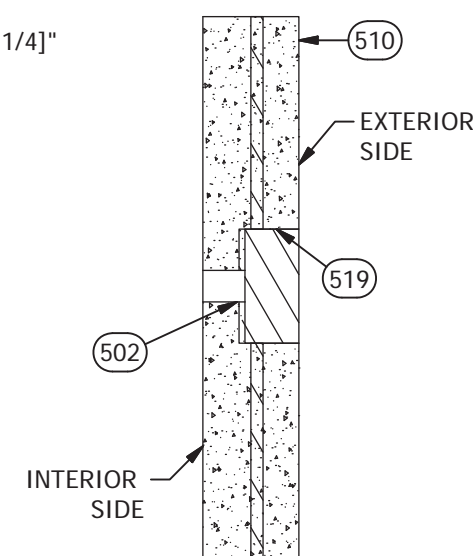


**SECTION X-X  
SCALE 1 : 8**

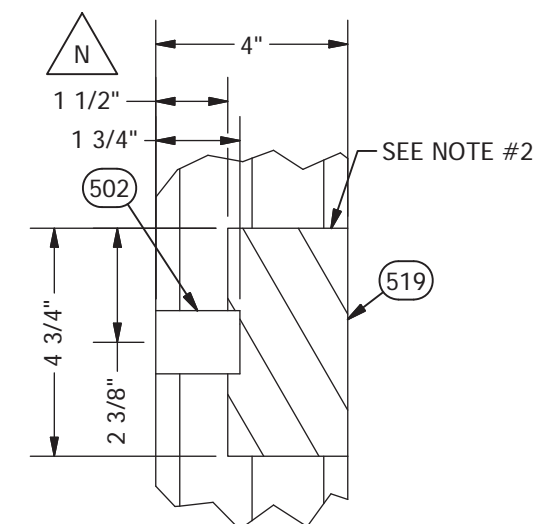

**FOAM BLOCKOUT DETAIL  
SIDE VIEW  
SCALE 1:4**

REV	BY	DATE	DESCRIPTION	APP BY
N	JWR	6/29/12	CHANGED (1) 1" PVC TO 1 1/2"	LJL
N	JCL	4/26/12	CHANGED FOAM B/O SIZE AT SECTION X-X	LJL

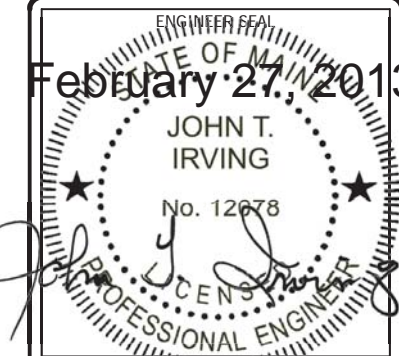

THIS DRAWING IS THE CONFIDENTIAL PROPERTY AND CONTAINS TRADE SECRETS OF CELLXION, LLC. ANY USE OF THESE DRAWINGS OR THE INFORMATION CONTAINED HEREIN FOR ANY REASON OTHER THAN AS EXPRESSLY AUTHORIZED BY CELLXION, LLC. IS STRICTLY PROHIBITED. THIS DRAWING HAS BEEN DISTRIBUTED WITH THE UNDERSTANDING THAT ANYONE RECEIVING OR OTHERWISE OBTAINING POSSESSION OF IT WILL BE EXPRESSLY NOTIFIED OF ITS CONFIDENTIAL NATURE.

**Cellxion**  
A Division of Sabre Industries, Inc.  
5031 Hazel Jones Road  
Bossier City, LA 71111  
voice: 318-213-2900  
fax: 318-213-2919  
www.cellxion.com

CUSTOMER:

PROJECT:  
10'-0" X 18'-0"  
CONCRETE SHELTER  
STRUCTURAL LAYOUT  
SIDE WALL "A"

FILENAME: SKBR02S.dwg	DATE:
DESIGN BY: M. TREKELL	11/4/2010
DRAWN BY: M. TREKELL	11/4/2010
CHECKED BY: W. RODRIGUEZ	11/4/2010
ENGINEERED BY:	DATE:


APPROVED BY:  
S. LEGGETT

DATE:  
11/8/2010



SHEET NO.:  
2 OF 6  
DRAWING NO.:  
SKBR02S  
REV:  
P

SUB - PARTS LIST								
ITEM	QTY	U/M	P/N	DESCRIPTION	LENGTH	WIDTH	DEPTH	PCS
503	0.666	FT	170001	PIPE, PVC, SCH 40, 1/2"	2.000 in			8
509	2	EA.	222-1000X0903-008	WALL KIT, CON, END, AC, STD				2
514	5.043	FBM	360151	INSULATION, EPS, FOAM, RAW MATL B-FOOT	20.750 in	8.750 in	4.000 in	1
515	7.349	FBM	360151	INSULATION, EPS, FOAM, RAW MATL B-FOOT	20.750 in	12.750 in	4.000 in	1
516	1.111	FBM	360151	INSULATION, EPS, FOAM, RAW MATL B-FOOT	10.000 in	4.000 in	4.000 in	1
520	26.868	FBM	360151	INSULATION, EPS, FOAM, RAW MATL B-FOOT	18.250 in	26.500 in	4.000 in	2

NOTES:  
1. CUT WIRE MESH AROUND ALL BLOCKOUTS.

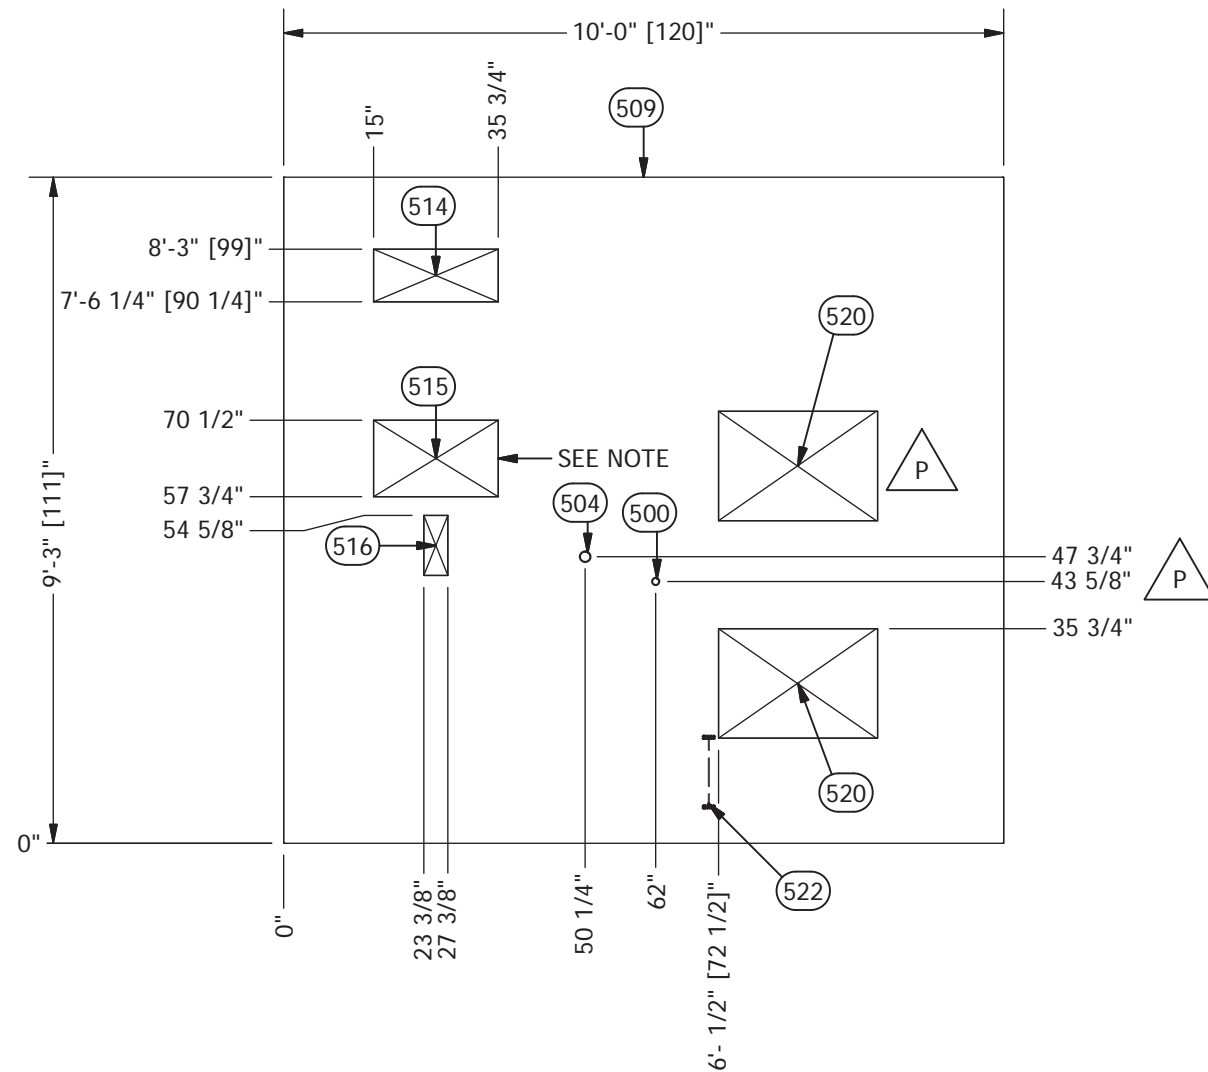

STRUCTURAL LAYOUT  
END WALL "B"  
SCALE 1 : 32  
(EXTERIOR VIEW)

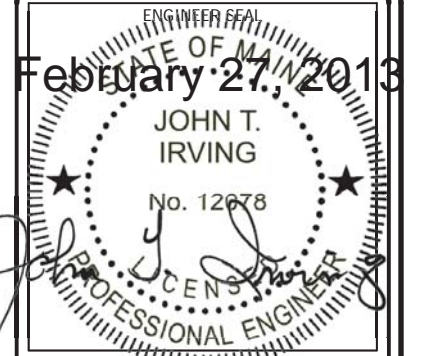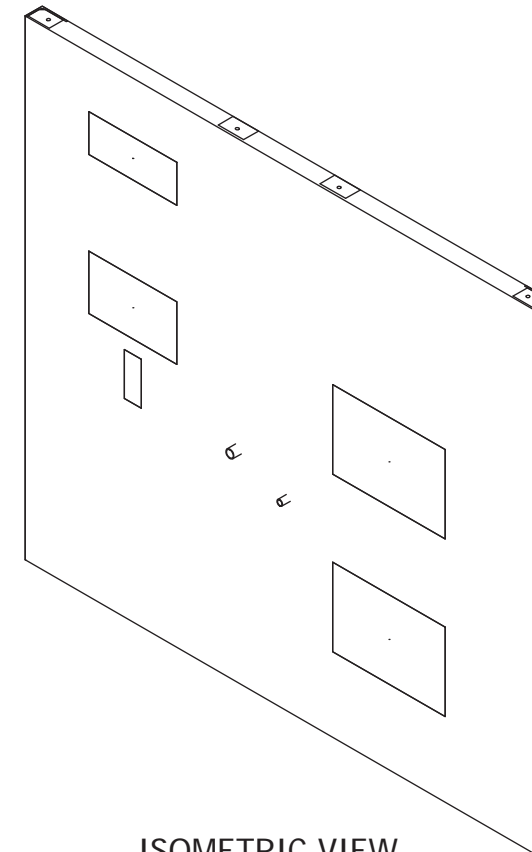

THIS DRAWING IS THE CONFIDENTIAL PROPERTY AND CONTAINS TRADE SECRETS OF CELLXION, LLC. ANY USE OF THESE DRAWINGS OR THE INFORMATION CONTAINED HEREIN FOR ANY REASON OTHER THAN AS EXPRESSLY AUTHORIZED BY CELLXION, LLC. IS STRICTLY PROHIBITED. THIS DRAWING HAS BEEN DISTRIBUTED WITH THE UNDERSTANDING THAT ANYONE RECEIVING OR OTHERWISE OBTAINING POSSESSION OF IT WILL BE EXPRESSLY NOTIFIED OF ITS CONFIDENTIAL NATURE.

**Cellxion**  
A Division of Sabre Industries, Inc.  
5031 Hazel Jones Road  
Bossier City, LA 71111  
voice: 318-213-2900  
fax: 318-213-2919  
www.cellxion.com

CUSTOMER:

PROJECT:  
10'-0" X 18'-0"  
CONCRETE SHELTER  
STRUCTURAL LAYOUT  
END WALL "B"

FILENAME:  
SKBR02S.dwg

DESIGN BY: M. TREKELL	DATE: 11/4/2010
DRAWN BY: M. TREKELL	DATE: 11/4/2010
CHECKED BY: W. RODRIGUEZ	DATE: 11/4/2010
ENGINEERED BY:	DATE:

APPROVED BY: S. LEGGETT	DATE: 11/8/2010
----------------------------	--------------------

SHEET NO.:  
3 OF 6

DRAWING NO.: SKBR02S	REV: P
-------------------------	-----------




P	LJL	11/5/12	MOVED PENETRATIONS, REMOVED AC WINDOW EMBEDS	LJL
REV	BY	DATE	DESCRIPTION	APP BY




SUB - PARTS LIST								
ITEM	QTY	U/M	P/N	DESCRIPTION	LENGTH	WIDTH	DEPTH	PCS
500	1.500	FT	170000	PIPE, PVC, SCH 40, 1"	6.000 in			3
501	4.000	FT	170000	PIPE, PVC, SCH 40, 1"	12.000 in			4
504	1.500	FT	170003	PIPE, PVC, SCH 40, 1 1/2"	6.000 in			3
505	3.000	FT	170010	PIPE, PVC, SCH 40, 2"	6.000 in			5
506	0.50000 ft	FT	170011	PIPE, PVC, SCH 40, 2 1/2"	6.000 in			1
507	0.500	FT	350228	LUMBER, #2 PINE, 1X6, RAW MATL	6.000 in			1
511	1	EA.	223-1800X0903-002	WALL KIT, CON, SIDE, BO, STD				1
517	.694	FBM	360151	INSULATION, EPS, FOAM, RAW MATL B-FOOT	5.000 in	5.000 in	4.000 in	1
518	3.807	FBM	360151	INSULATION, EPS, FOAM, RAW MATL B-FOOT	10.750 in	12.750 in	4.000 in	1
522	5	EA.	540237	GROUND STRAP ASSEMBLY, STRUCTURE, 12" SOLID				5

NOTES:

- CUT WIRE MESH AROUND ALL BLOCKOUTS.

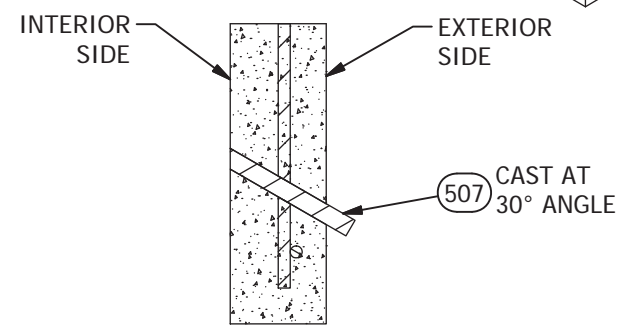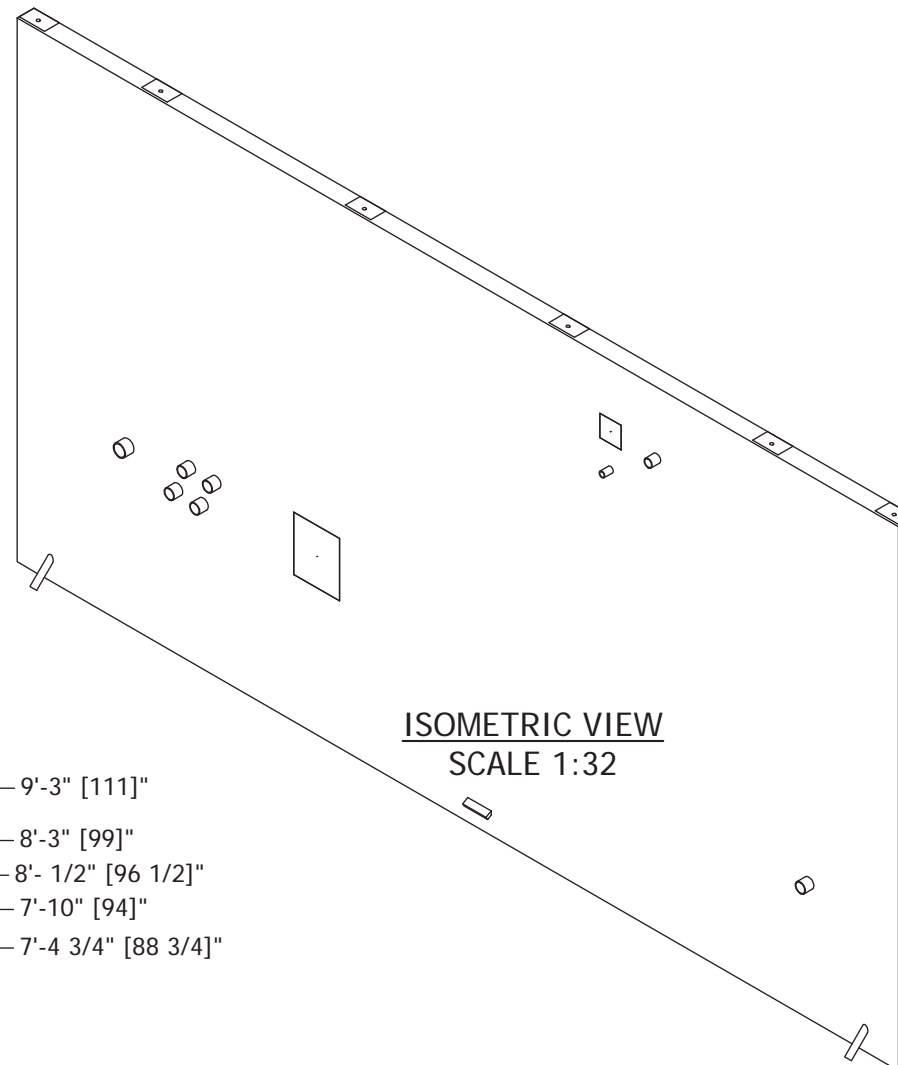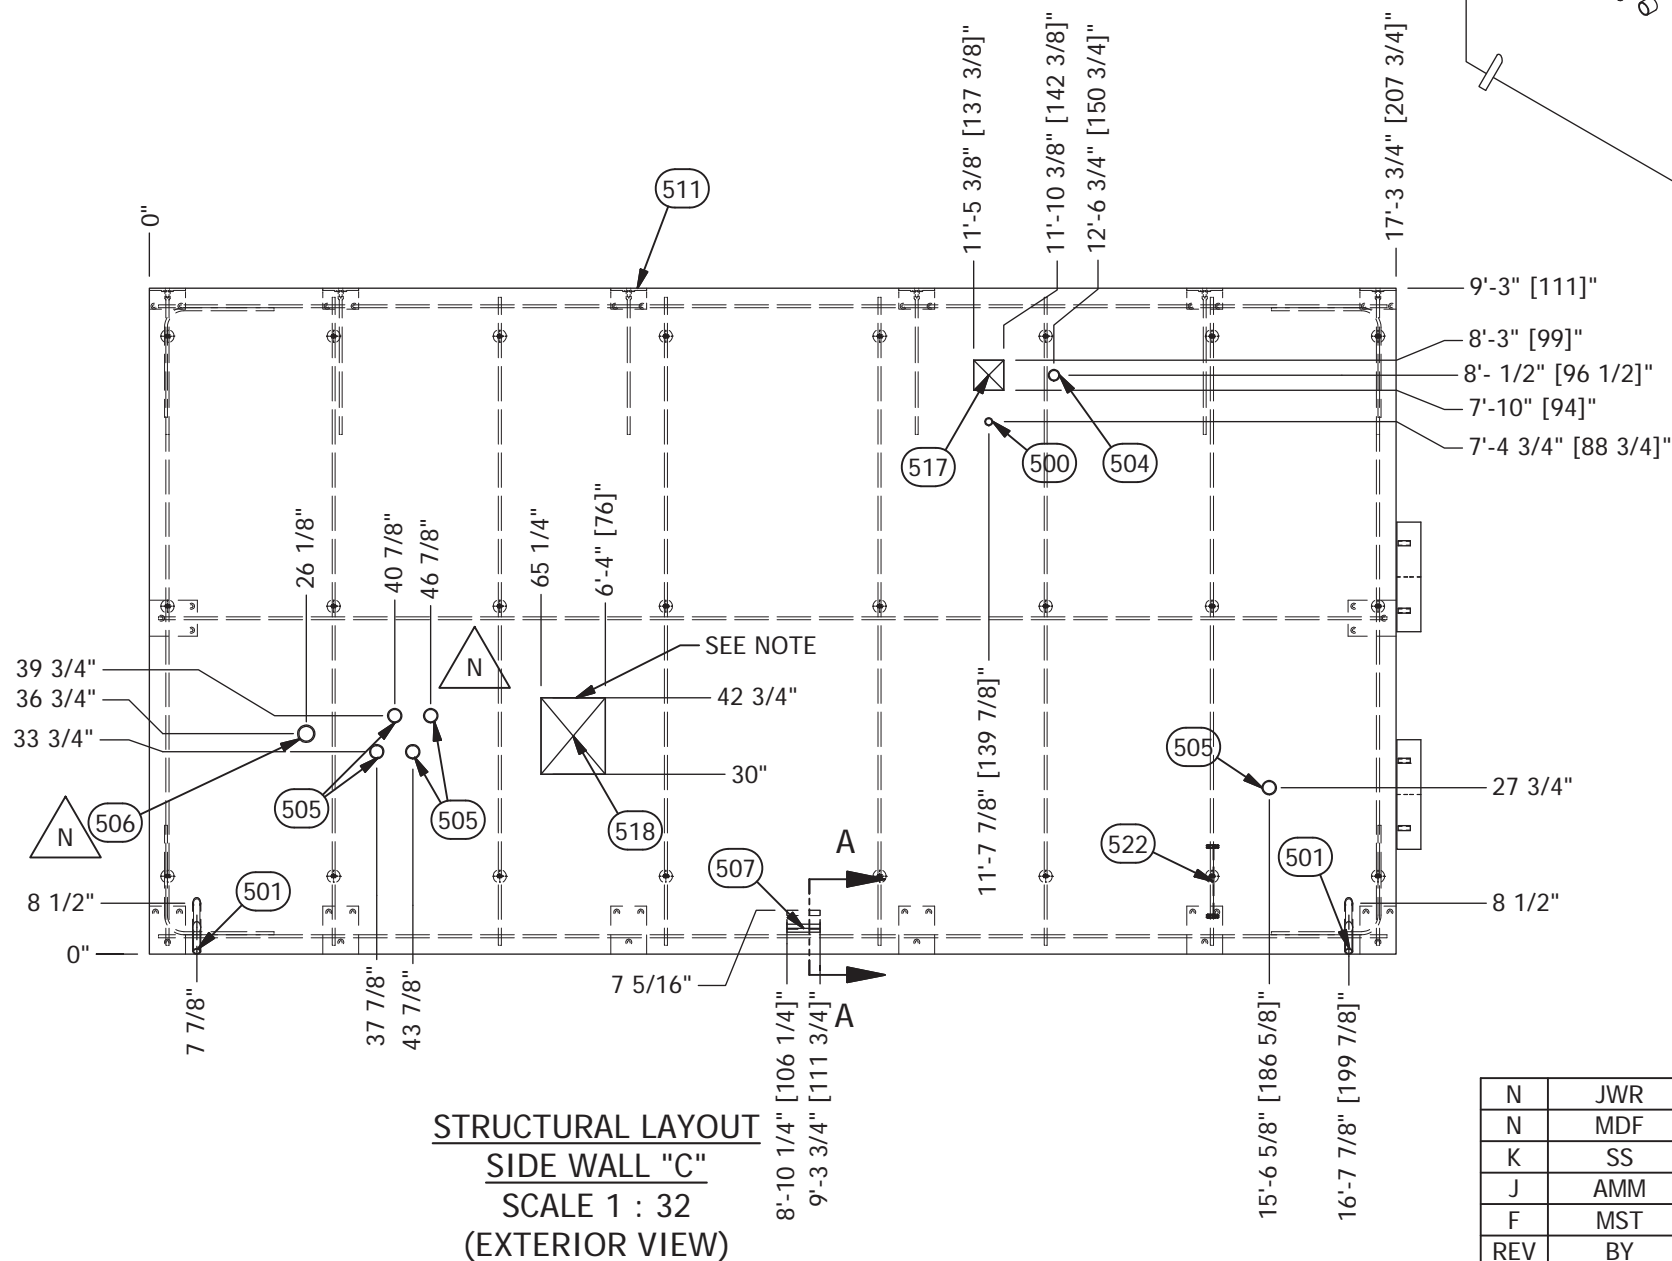

REV	BY	DATE	DESCRIPTION	APP BY
N	JWR	6/29/12	CHANGED (1) 2" PVC TO 2 1/2"	LJL
N	MDF	2/6/12	MOVED PENETRATIONS UP	JFA
K	SS	04/09/11	MOVED THE PENETRATIONS	LL
J	AMM	02/09/11	UPDATED PENETRATION, DIMENSION & BUBBLES	LJL
F	MST	12/14/10	REMOVED 4X10 BLOCKOUT	WAR
REV	BY	DATE	DESCRIPTION	APP BY

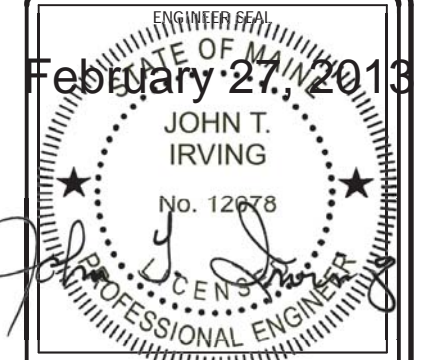

THIS DRAWING IS THE CONFIDENTIAL PROPERTY AND CONTAINS TRADE SECRETS OF CELLXION, LLC. ANY USE OF THESE DRAWINGS OR THE INFORMATION CONTAINED HEREIN FOR ANY REASON OTHER THAN AS EXPRESSLY AUTHORIZED BY CELLXION, LLC. IS STRICTLY PROHIBITED. THIS DRAWING HAS BEEN DISTRIBUTED WITH THE UNDERSTANDING THAT ANYONE RECEIVING OR OTHERWISE OBTAINING POSSESSION OF IT WILL BE EXPRESSLY NOTIFIED OF ITS CONFIDENTIAL NATURE.

**Cellxion**  
A Division of Sabre Industries, Inc.  
5031 Hazel Jones Road  
Bossier City, LA 71111  
voice: 318-213-2900  
fax: 318-213-2919  
www.cellxion.com

CUSTOMER:

PROJECT:  
10'-0" X 18'-0"  
CONCRETE SHELTER  
STRUCTURAL LAYOUT  
SIDE WALL "C"

FILENAME: SKBR02S.dwg	DATE:
DESIGN BY: M. TREKELL	11/4/2010
DRAWN BY: M. TREKELL	11/4/2010
CHECKED BY: W. RODRIGUEZ	11/4/2010
ENGINEERED BY:	DATE:

APPROVED BY:  
S. LEGGETT

DATE:  
11/8/2010


SHEET NO.:  
4 OF 6

DRAWING NO.:  
SKBR02S


REV:  
P

SUB - PARTS LIST								
ITEM	QTY	U/M	P/N	DESCRIPTION	LENGTH	WIDTH	DEPTH	PCS
509	2	EA.	222-1000X0903-008	WALL KIT, CON, END, AC, STD				2
522	5	EA.	540237	GROUND STRAP ASSEMBLY, STRUCTURE, 12" SOLID				5


NOTES:  
1. CUT WIRE MESH AROUND ALL BLOCKOUTS.

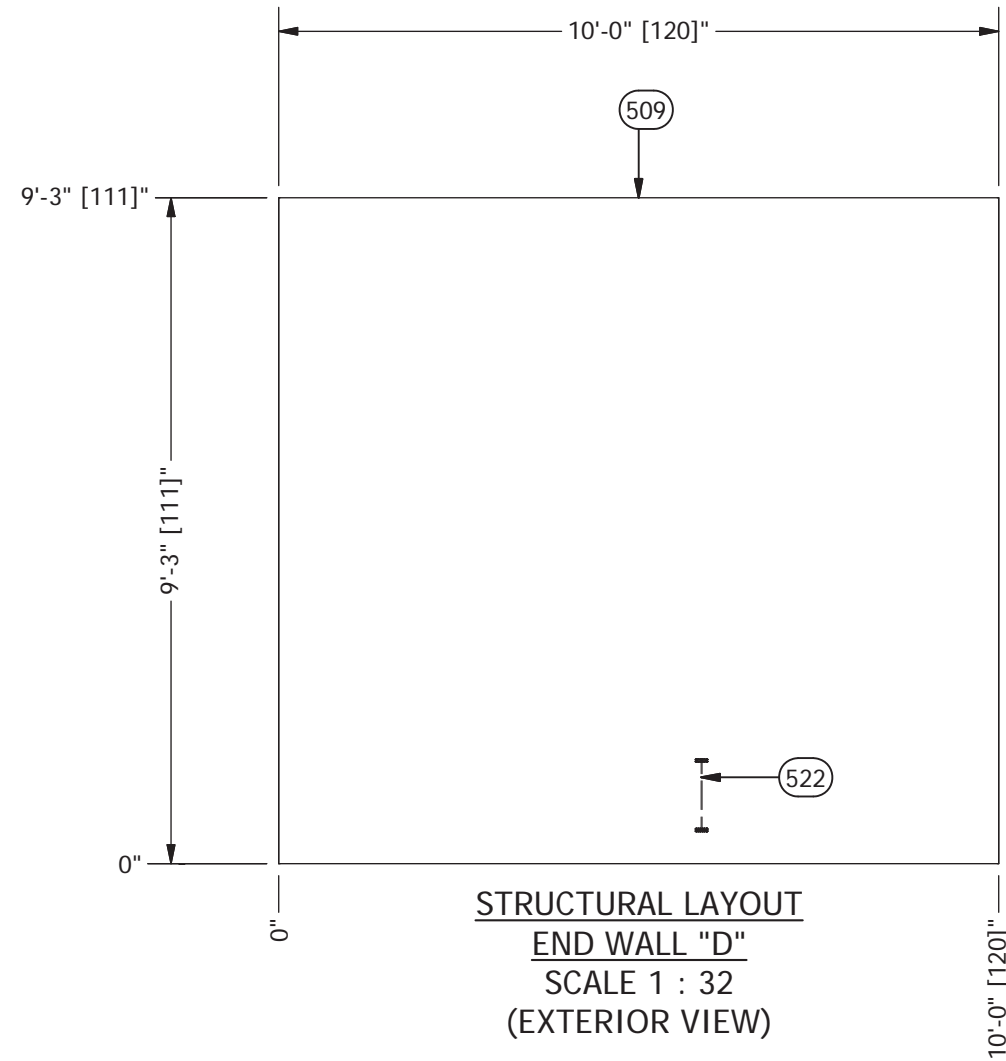

STRUCTURAL LAYOUT  
END WALL "D"  
SCALE 1 : 32  
(EXTERIOR VIEW)

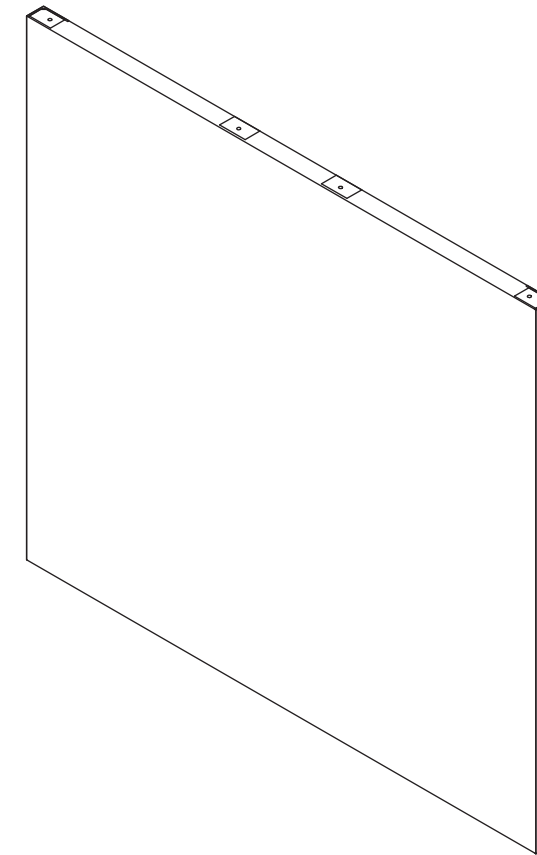

ISOMETRIC VIEW  
SCALE 1 : 32

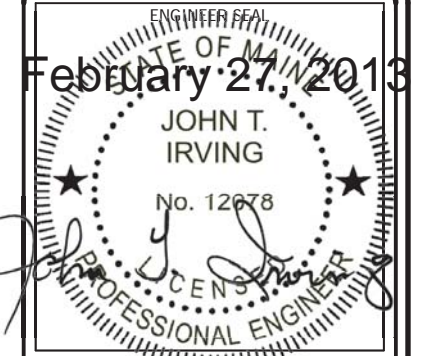

THIS DRAWING IS THE CONFIDENTIAL PROPERTY AND CONTAINS TRADE SECRETS OF CELLXION, LLC. ANY USE OF THESE DRAWINGS OR THE INFORMATION CONTAINED HEREIN FOR ANY REASON OTHER THAN AS EXPRESSLY AUTHORIZED BY CELLXION, LLC. IS STRICTLY PROHIBITED. THIS DRAWING HAS BEEN DISTRIBUTED WITH THE UNDERSTANDING THAT ANYONE RECEIVING OR OTHERWISE OBTAINING POSSESSION OF IT WILL BE EXPRESSLY NOTIFIED OF ITS CONFIDENTIAL NATURE.


**Cellxion**  
A Division of Sabre Industries, Inc.  
5031 Hazel Jones Road  
Bossier City, LA 71111  
voice: 318-213-2900  
fax: 318-213-2919  
www.cellxion.com

CUSTOMER:


PROJECT:  
10'-0" X 18'-0"  
CONCRETE SHELTER  
STRUCTURAL LAYOUT  
END WALL "D"

FILENAME: SKBR02S.dwg	
DESIGN BY: M. TREKELL	DATE: 11/4/2010
DRAWN BY: M. TREKELL	DATE: 11/4/2010
CHECKED BY: W. RODRIGUEZ	DATE: 11/4/2010
ENGINEERED BY:	DATE:
APPROVED BY: S. LEGGETT	DATE: 11/8/2010
SHEET NO.: 5 OF 6	
DRAWING NO.: SKBR02S	REV: P

SUB - PARTS LIST								
ITEM	QTY	U/M	P/N	DESCRIPTION	LENGTH	WIDTH	DEPTH	PCS
513	1	EA.	226-1000X1800X4-00	ROOF ASSY.KIT,CONCRETE,10'0"X 18'0"				1
522	5	EA.	540237	GROUND STRAP ASSEMBLY, STRUCTURE, 12" SOLID				5

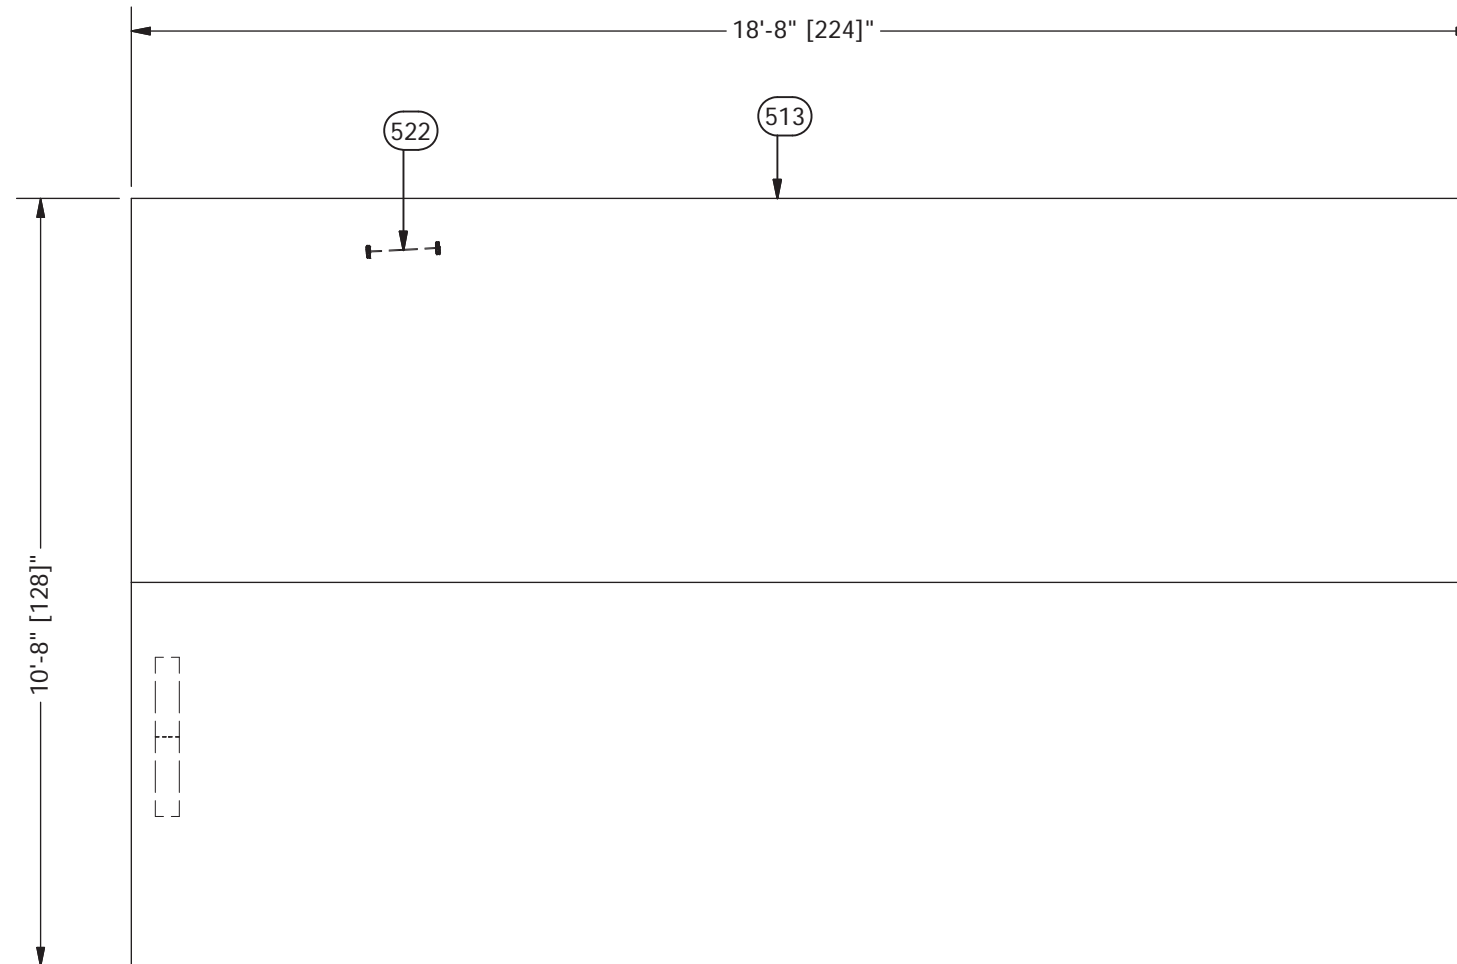

**STRUCTURAL LAYOUT**  
**ROOF**  
**SCALE 1:32**

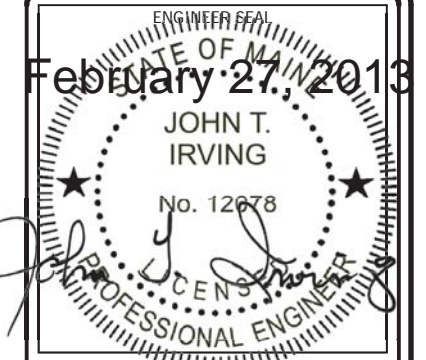

THIS DRAWING IS THE CONFIDENTIAL PROPERTY AND CONTAINS TRADE SECRETS OF CELLXION, LLC. ANY USE OF THESE DRAWINGS OR THE INFORMATION CONTAINED HEREIN FOR ANY REASON OTHER THAN AS EXPRESSLY AUTHORIZED BY CELLXION, LLC. IS STRICTLY PROHIBITED. THIS DRAWING HAS BEEN DISTRIBUTED WITH THE UNDERSTANDING THAT ANYONE RECEIVING OR OTHERWISE OBTAINING POSSESSION OF IT WILL BE EXPRESSLY NOTIFIED OF ITS CONFIDENTIAL NATURE.

**Cellxion**  
 A Division of Sabre Industries, Inc.  
 5031 Hazel Jones Road  
 Bossier City, LA 71111  
 voice: 318-213-2900  
 fax: 318-213-2919  
 www.cellxion.com

CUSTOMER:

PROJECT:  
 10'-0" X 18'-0"  
 CONCRETE SHELTER  
 STRUCTURAL LAYOUT  
 ROOF


FILENAME: SKBR02S.dwg	
DESIGN BY: M. TREKELL	DATE: 11/4/2010
DRAWN BY: M. TREKELL	DATE: 11/4/2010
CHECKED BY: W. RODRIGUEZ	DATE: 11/4/2010
ENGINEERED BY:	DATE:
APPROVED BY: S. LEGGETT	DATE: 11/8/2010

SHEET NO.:  
 6 OF 6


DRAWING NO.: SKBR02S	REV: P
-------------------------	-----------

PART LIST								
ITEM	QTY	U/M	P/N	DESCRIPTION	LENGTH	WIDTH	DEPTH	PCS
1	2.1725	CU.YD.	100052-002	CONCRETE, 1 CUBIC YARD BATCH, FLOOR	216.000 in	120.000 in		1
2	.892	EA.	110001	MESH, WIRE, 4X4, W4XW4, 8'X20'	214.000 in	96.000 in		1
3	.241	EA.	110001	MESH, WIRE, 4X4, W4XW4, 8'X20'	214.000 in	26.000 in		1
4	35.5	FT.	112502	REBAR, #4 (1/2") #13 METRIC, GRADE 60	213.000 in			2
5	17.75	FT.	112503	REBAR #6 (3/4") #19 METRIC, GRADE 60	213.000 in			1
6	136.5	FT.	112503	REBAR #6 (3/4") #19 METRIC, GRADE 60	117.000 in			14
7	28	Each	119013	REBAR CHAIR, PLASTIC, MESH WITH BASE 1"				28
8	42	Each	119016	REBAR CHAIR, PLASTIC, #6, 3/4"				42
9	1	Each	22-1000X1800-00	PMTR ANGLE FRAME ASSY H.S.10'0"X18"				1
10	83.333	FBM	360151	INSULATION, EPS, FOAM, RAW MATL B-FOOT	50.000 in	20.000 in	3.000 in	4
11	229.167	FBM	360151	INSULATION, EPS, FOAM, RAW MATL B-FOOT	50.000 in	22.000 in	3.000 in	10
12	2.00000 ft	ft	141034	FLATBAR, 1/4" X 4, GRADE 36	6.000 in			4
13	1	Each	540237	GROUND STRAP ASSEMBLY, STRUCTURE, 12" SOLID				1

SHOP DETAILS	
DWG. NO.	DESCRIPTION
12-001	CONCRETE STEP JOINT DETAIL
12-002	CONCRETE RIB SECTION DETAILS

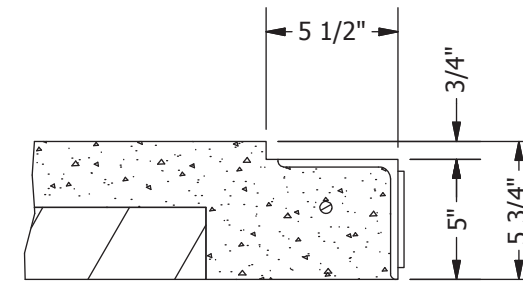

DETAIL B  
SCALE 1:8

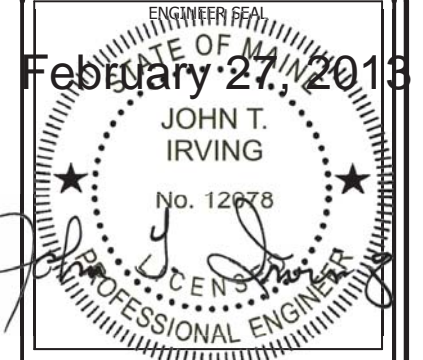

THIS DRAWING IS THE CONFIDENTIAL PROPERTY AND CONTAINS TRADE SECRETS OF CELLXION, LLC. ANY USE OF THESE DRAWINGS OR THE INFORMATION CONTAINED HEREIN FOR ANY REASON OTHER THAN AS EXPRESSLY AUTHORIZED BY CELLXION, LLC. IS STRICTLY PROHIBITED. THIS DRAWING HAS BEEN DISTRIBUTED WITH THE UNDERSTANDING THAT ANYONE RECEIVING OR OTHERWISE OBTAINING POSSESSION OF IT WILL BE EXPRESSLY NOTIFIED OF ITS CONFIDENTIAL NATURE.


**Cellxion**  
A Division of Sabre Industries, Inc.  
5031 Hazel Jones Road  
Bossier City, LA 71111  
voice: 318-213-2900  
fax: 318-213-2919  
www.cellxion.com

CUSTOMER:

PROJECT:  
**CONCRETE FLOOR ASSEMBLY KIT 10'-0"X18'-0"**

FILENAME: 221-1000X1800-02.dwg	
DESIGN BY: D. CHRISTOPHE	DATE: 5/4/2010
DRAWN BY: D. CHRISTOPHE	DATE: 5/4/2010
CHECKED BY: G. BRINKMAN	DATE: 5/4/2010
ENGINEERED BY:	DATE:
APPROVED BY:	DATE:

SHEET NO.: 1 OF 2	
DRAWING NO.: 221-1000X1800-02	REV: C

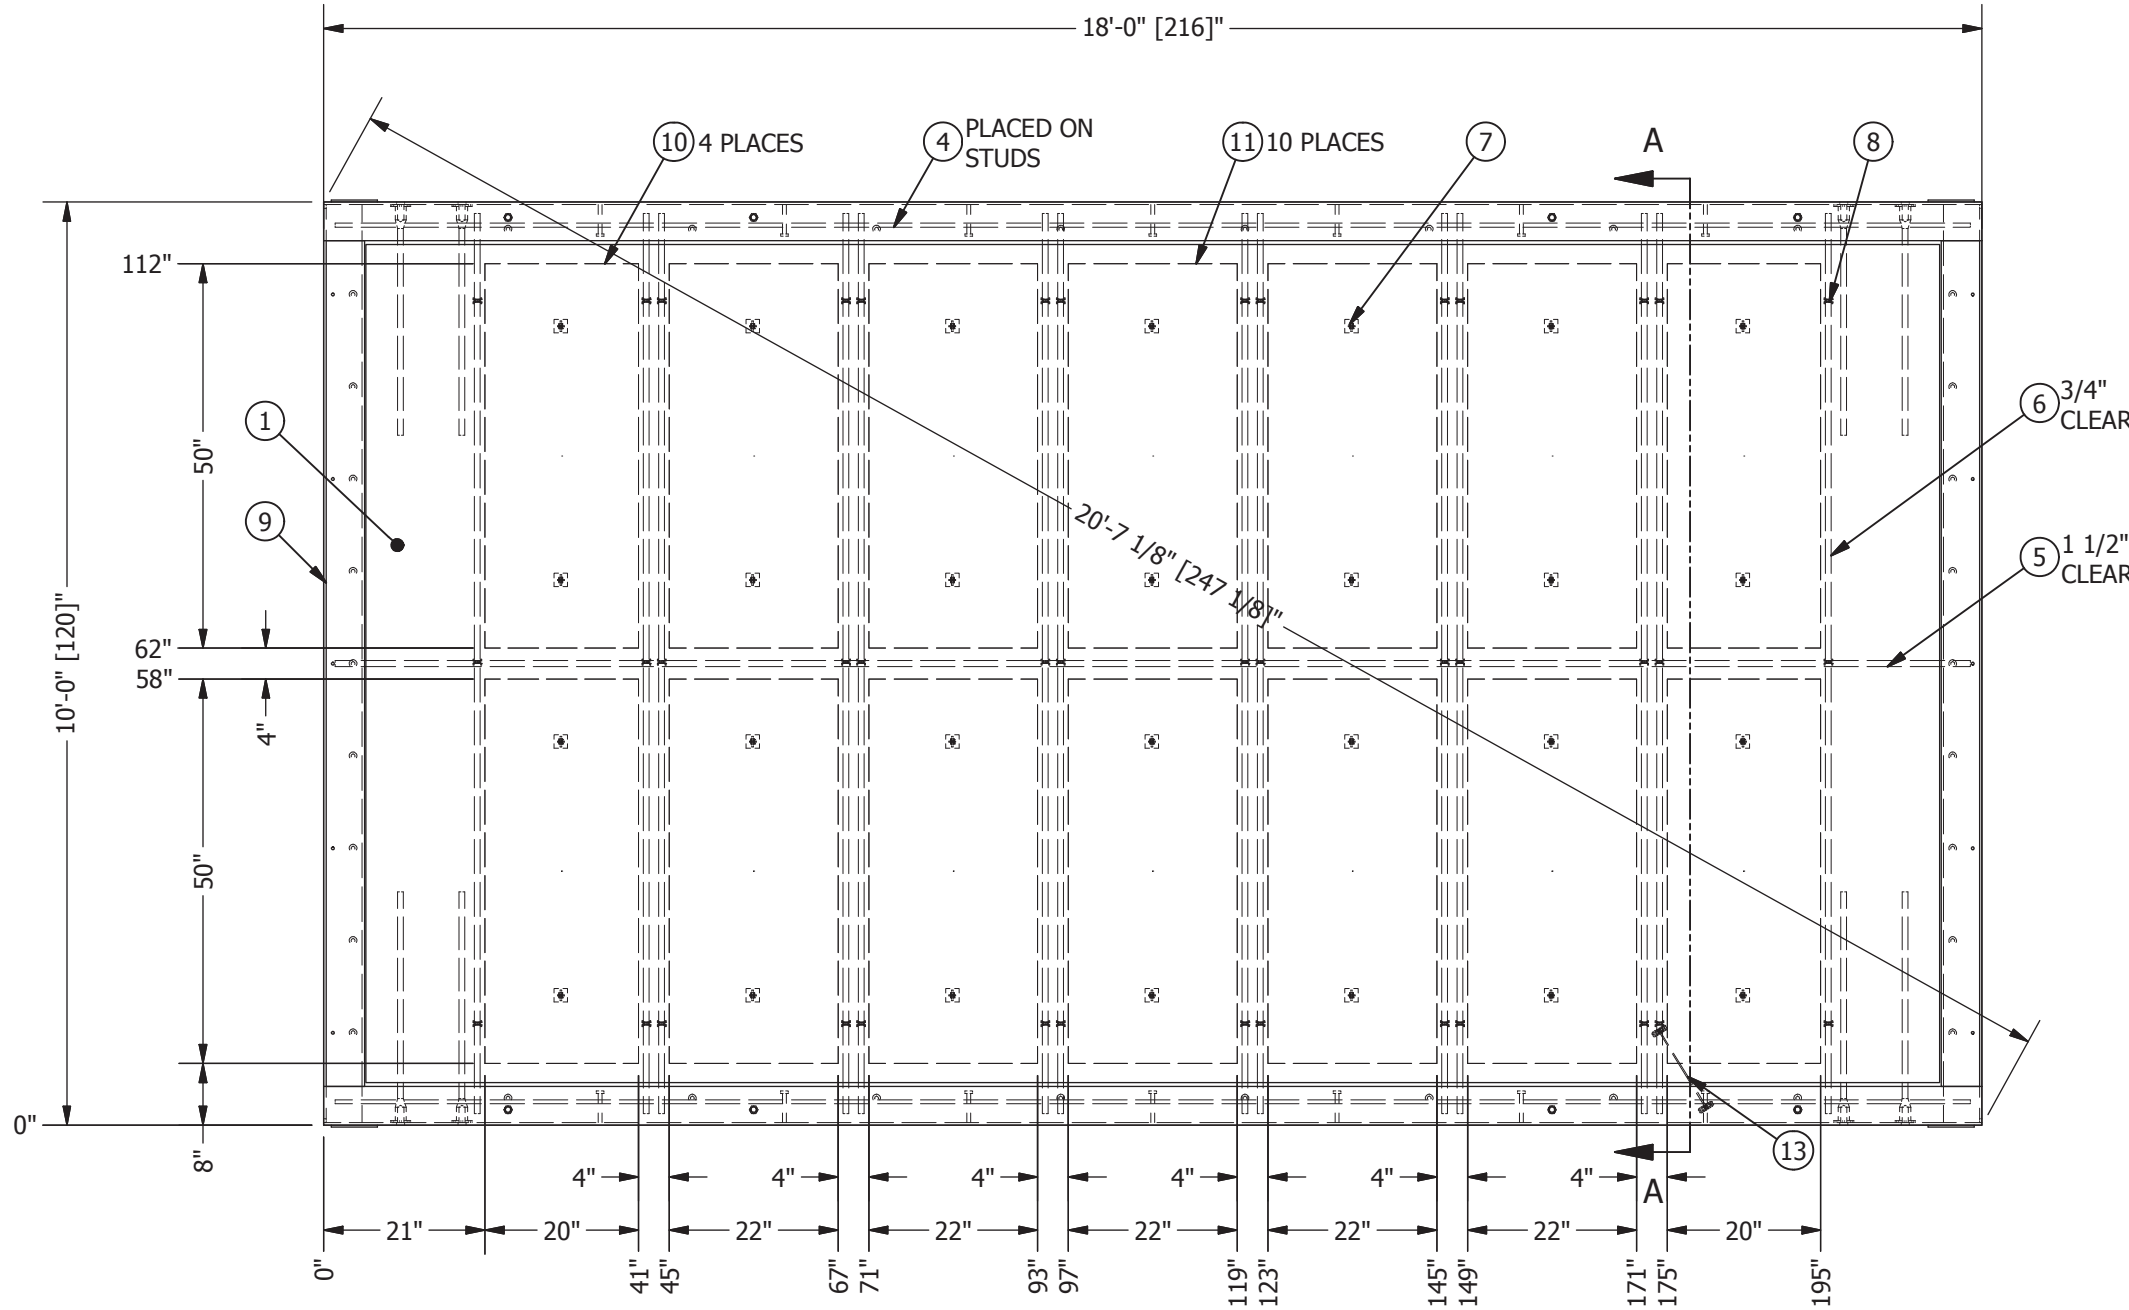


STRUCTURAL LAYOUT-FLOOR  
2.17 CU.YD.  
SCALE 1:25

SECTION A-A  
SCALE 1:25


C	JCL	02/28/12	REPLACED 4" PAD WITH 6" PAD	JA
REV	BY	DATE	DESCRIPTION	APP BY




PART LIST							
ITEM	QTY	U/M	P/N	DESCRIPTION	LENGTH	WIDTH	PCS
2	.892	EA.	110001	MESH, WIRE, 4X4, W4XW4, 8'X20'	214.000 in	96.000 in	1
3	.241	EA.	110001	MESH, WIRE, 4X4, W4XW4, 8'X20'	214.000 in	26.000 in	1
9	1	Each	22-1000X1800-00	PMTR ANGLE FRAME ASSY H.S. 10'0"X18'			1
12	2.00000	ft	141034	FLATBAR, 1/4" X 4, GRADE 36	6.000 in		4

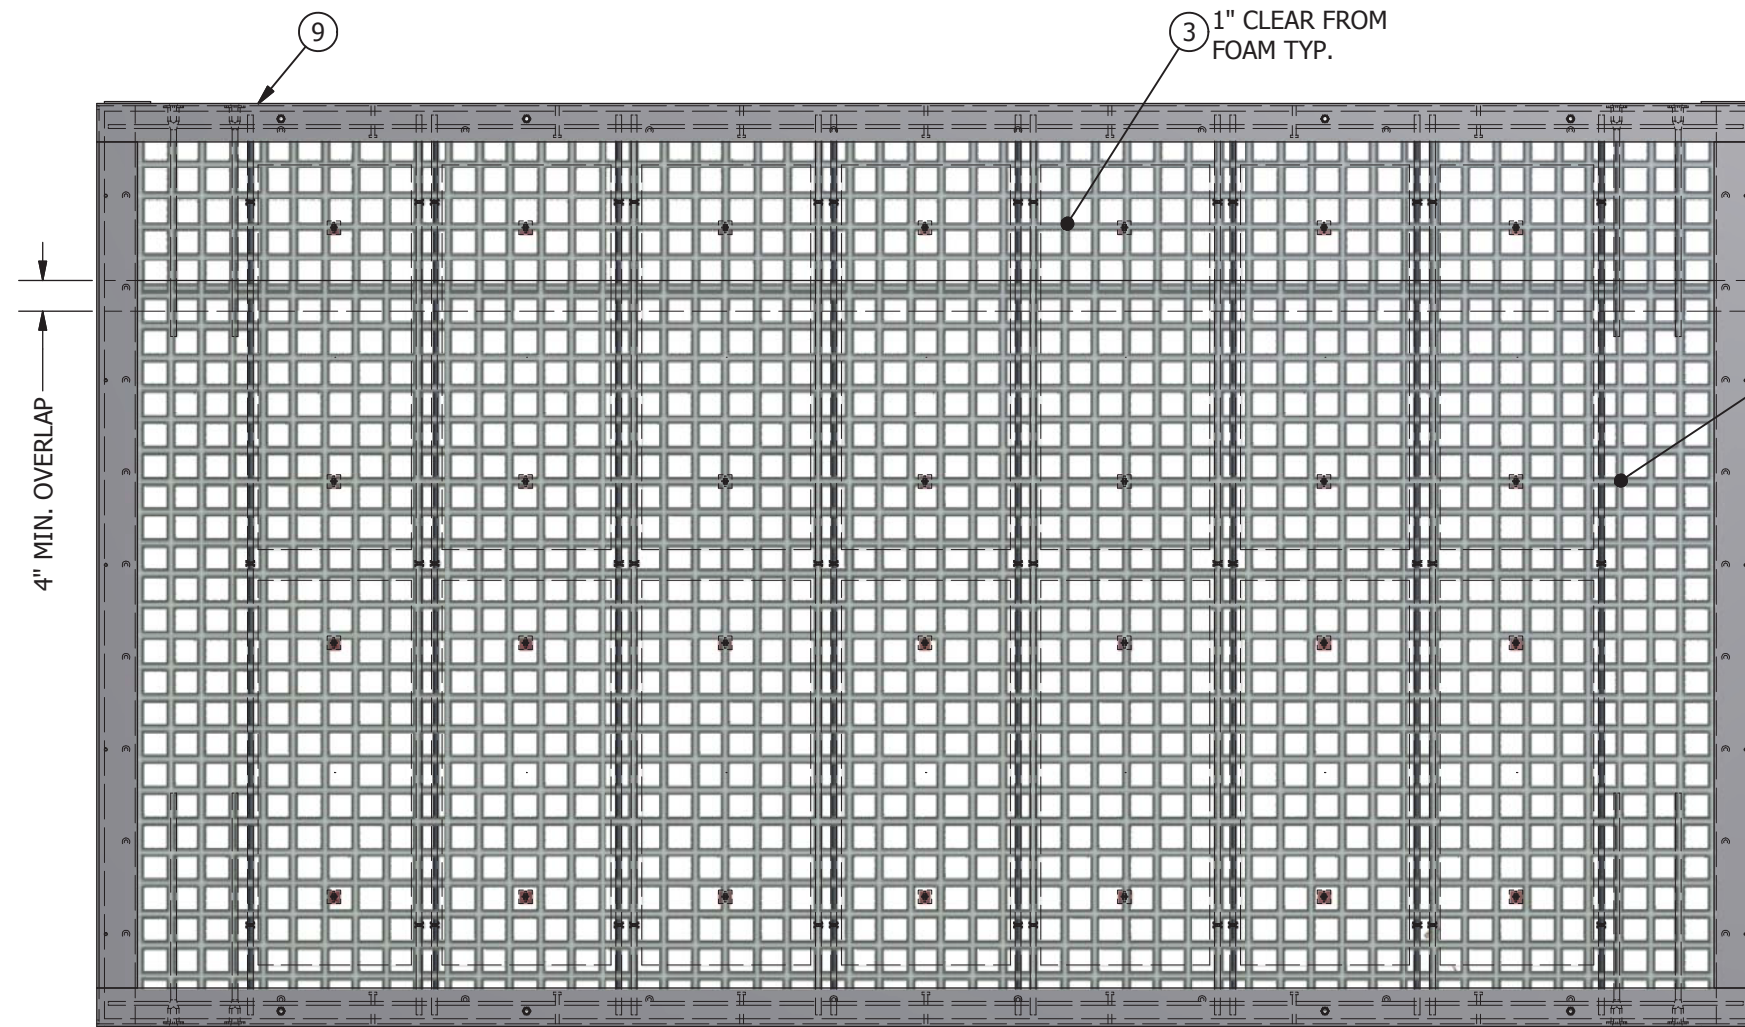

MESH LAYOUT  
SCALE 1:25

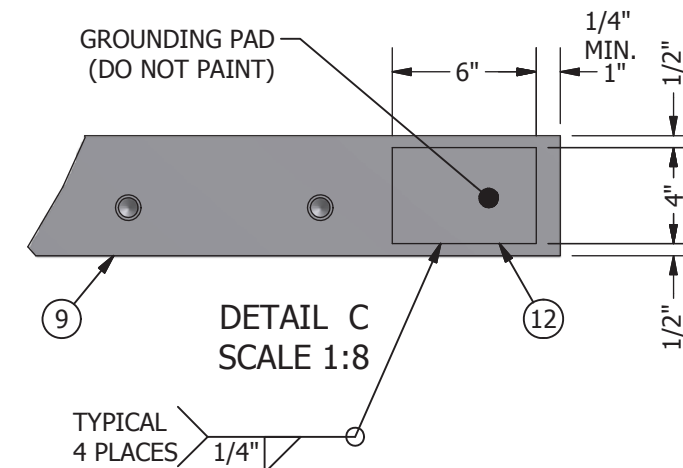

DETAIL C  
SCALE 1:8

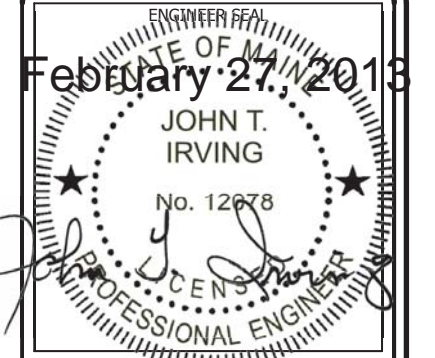

THIS DRAWING IS THE CONFIDENTIAL PROPERTY AND CONTAINS TRADE SECRETS OF CELLXION, LLC. ANY USE OF THESE DRAWINGS OR THE INFORMATION CONTAINED HEREIN FOR ANY REASON OTHER THAN AS EXPRESSLY AUTHORIZED BY CELLXION, LLC. IS STRICTLY PROHIBITED. THIS DRAWING HAS BEEN DISTRIBUTED WITH THE UNDERSTANDING THAT ANYONE RECEIVING OR OTHERWISE OBTAINING POSSESSION OF IT WILL BE EXPRESSLY NOTIFIED OF ITS CONFIDENTIAL NATURE.

**Cellxion**  
A Division of Sabre Industries, Inc.  
5031 Hazel Jones Road  
Bossier City, LA 71111  
voice: 318-213-2900  
fax: 318-213-2919  
www.cellxion.com

CUSTOMER:

PROJECT:  
**CONCRETE FLOOR ASSEMBLY KIT 10'-0"X18'-0"**

FILENAME: 221-1000X1800-02.dwg	
DESIGN BY: D. CHRISTOPHE	DATE: 5/4/2010
DRAWN BY: D. CHRISTOPHE	DATE: 5/4/2010
CHECKED BY: G. BRINKMAN	DATE: 5/4/2010
ENGINEERED BY:	DATE:
APPROVED BY:	DATE:


SHEET NO.:  
**2 OF 2**

DRAWING NO.:	REV:
<b>221-1000X1800-02</b>	<b>C</b>

PART LIST								
ITEM	QTY	U/M	P/N	DESCRIPTION	LENGTH	WIDTH	DEPTH	PCS
1	1.142	CU. YD.	100052-001	CONCRETE, 1 CUBIC YARD BATCH, WALLS	111.000 in	120.000 in		1
2	1	Each	10RH1000-03	END WALL RAIL ANGLE, TOP, 4" WALL				1
3	1	Each	10RH1000-04	END WALL RAIL ANGLE, BOTTOM, 4" WALL				1
4	.117	EA.	110001	MESH, WIRE, 4X4, W4XW4, 8'X20'	108.000 in	25.000 in		1
5	.45	EA.	110001	MESH, WIRE, 4X4, W4XW4, 8'X20'	108.000 in	96.000 in		1
6	54	FT.	112502	REBAR, #4 (1/2") #13 METRIC, GRADE 60	108.000 in			6
7	68.25	FT.	112502	REBAR, #4 (1/2") #13 METRIC, GRADE 60	117.000 in			7
8	12	FT.	112502	REBAR, #4 (1/2") #13 METRIC, GRADE 60	36.000 in			4
9	4.083	FT.	112502	REBAR, #4 (1/2") #13 METRIC, GRADE 60	49.000 in			1
10	5.875	FT.	112502	REBAR, #4 (1/2") #13 METRIC, GRADE 60	70.500 in			1
11	12	EA.	119015	REBAR CHAIR, PLASTIC, #4, 1 1/2"				12
12	2	EA.	221011	WALL EMBED ANGLE ASSEMBLY, 6" X 4" X 111"				2
13	2	Each	222000	INSERT ANGLE, WALL TO ROOF, 3.5" X 3.5" X 6"				2
14	2	EA.	223100	INSERT PLATE, WALL TO FLOOR/WALL				2

SHOP DETAILS	
DWG NO.	DESCRIPTION
14-001	WALL/FLOOR EMBED DETAIL
14-002	WALL/ROOF EMBED DETAIL
14-004	WALL DETAIL BLOCKOUT SECTION

WALL ASSEMBLY WEIGHT: 4250.698 lbmass  
 KEY WORDS: STD;AC2,L15,T12;AC1.5,R21,T39,AC1.5,R21,75.1875

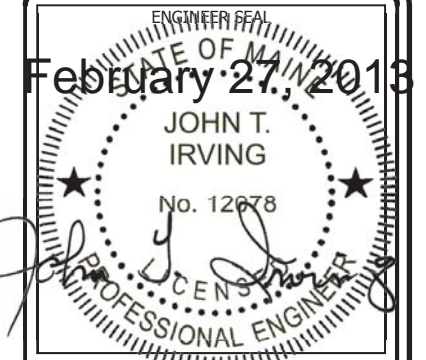


THIS DRAWING IS THE CONFIDENTIAL PROPERTY AND CONTAINS TRADE SECRETS OF CELLXION, LLC. ANY USE OF THESE DRAWINGS OR THE INFORMATION CONTAINED HEREIN FOR ANY REASON OTHER THAN AS EXPRESSLY AUTHORIZED BY CELLXION, LLC. IS STRICTLY PROHIBITED. THIS DRAWING HAS BEEN DISTRIBUTED WITH THE UNDERSTANDING THAT ANYONE RECEIVING OR OTHERWISE OBTAINING POSSESSION OF IT WILL BE EXPRESSLY NOTIFIED OF ITS CONFIDENTIAL NATURE.

**Cellxion**  
 A Division of Sabre Industries, Inc.  
 5031 Hazel Jones Road  
 Bossier City, LA 71111  
 voice: 318-213-2900  
 fax: 318-213-2919  
 www.cellxion.com


CUSTOMER:  
 PROJECT:  
**CONCRETE END WALL ASSEMBLY KIT**  
 10'0" X 9'3"

FILENAME:  
 222-1000X0903-008.dwg  
 DESIGN BY: M. TREKELL DATE: 11/3/2010  
 DRAWN BY: M. TREKELL DATE: 11/3/2010  
 CHECKED BY: W. RODRIGUEZ DATE: 11/3/2010  
 ENGINEERED BY: DATE:

APPROVED BY: DATE:  
 SHEET NO.:  
 1 OF 1  
 DRAWING NO.: 222-1000X0903-008 REV:

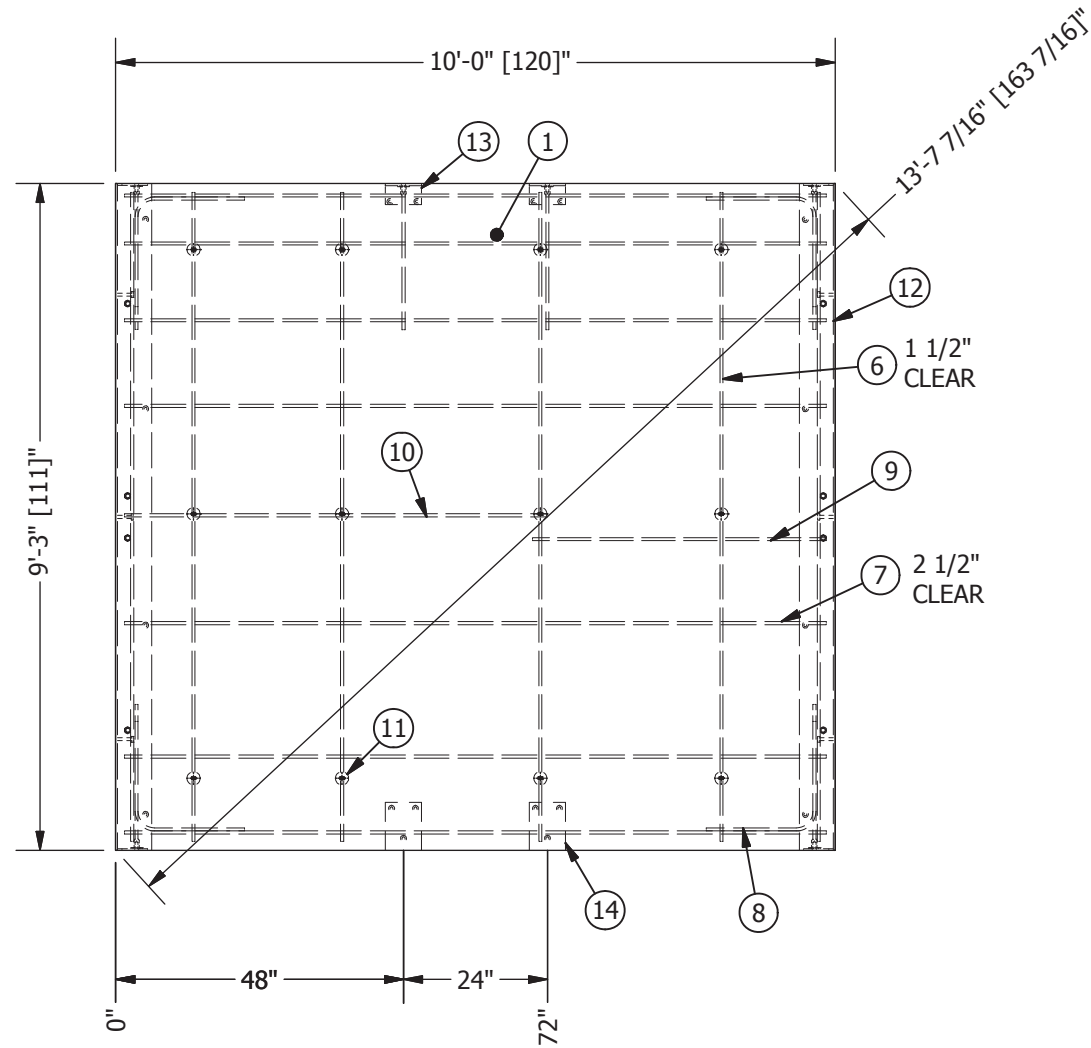

**STRUCTURAL LAYOUT END WALL (EXTERIOR VIEW)**  
 SCALE 1:32

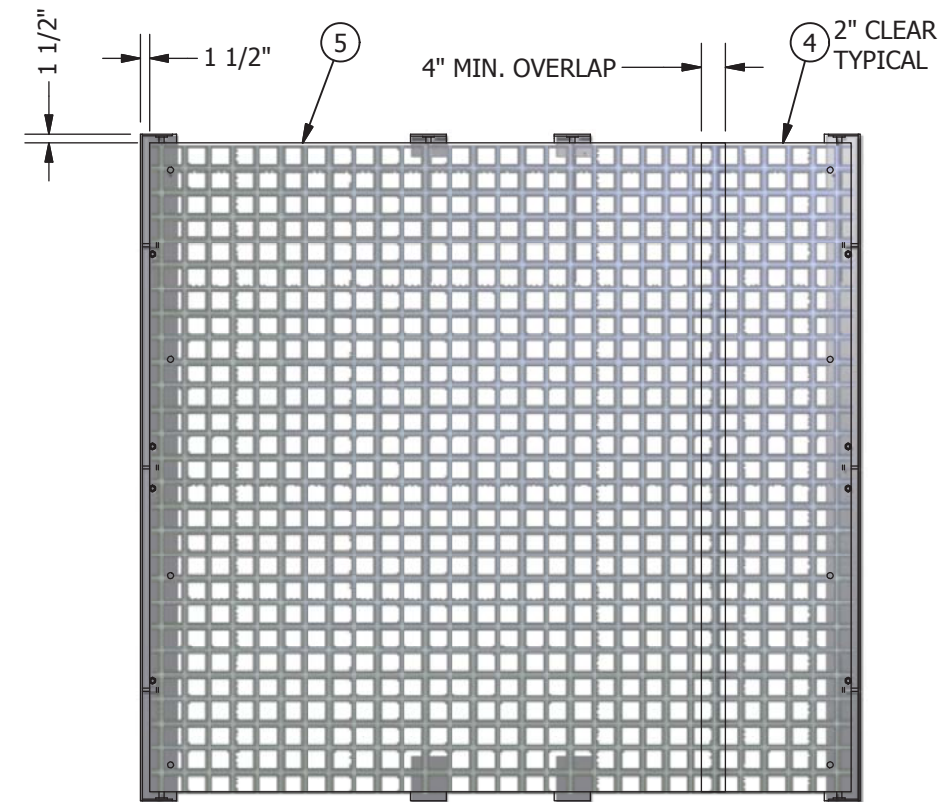

**MESH LAYOUT**  
 SCALE 1:32

**NOTES:**


1. SEE PROJECT SPECIFIC PLANS FOR ALL REQUIRED PVC PENETRATION AND BLOCKOUT SPECIFICATIONS.
2. CUT WIRE MESH AROUND ALL BLOCKOUTS.



PARTS LIST							
ITEM	QTY	U/M	P/N	DESCRIPTION	LENGTH	WIDTH	PCS
1	1.63	CU.YD.	100052-001	CONCRETE, 1 CUBIC YARD BATCH, WALLS			1
2	1	Each	10RH2000-01	SIDE WALL RAIL ANGLE, 20°-0" (PRODUCTION TOOL)			1
3	1	Each	10RH2000-02	SIDE WALL RAIL ANGLE, 20°-0" (PRODUCTION TOOL)			1
4	2	Each	10RV0903-01	SIDE WALL RAIL ANGLE, 9°-3" (PRODUCTION TOOL)			2
5	.45	EA.	110001	MESH, WIRE, 4X4, W4XW4, 8'X20'	108,000 in	96,000 in	1
6	.416	EA.	110001	MESH, WIRE, 4X4, W4XW4, 8'X20'	108,000 in	88,750 in	1
7	.131	EA.	110001	MESH, WIRE, 4X4, W4XW4, 8'X20'	108,000 in	28,000 in	1
8	81	FT.	112502	REBAR, #4 (1/2") #13 METRIC, GRADE 60	108,000 in		9
9	18	FT.	112502	REBAR, #4 (1/2") #13 METRIC, GRADE 60	36,000 in		6
10	51.188	FT.	112502	REBAR, #4 (1/2") #13 METRIC, GRADE 60	204,750 in		3
11	9.646	FT.	112502	REBAR, #4 (1/2") #13 METRIC, GRADE 60	115,750 in		1
12	3.333	FT.	112502	REBAR, #4 (1/2") #13 METRIC, GRADE 60	40,000 in		1
13	12	FT.	112502	REBAR, #4 (1/2") #13 METRIC, GRADE 60	36,000 in		4
14	27	EA.	119015	REBAR CHAIR, PLASTIC, #4, 1 1/2"			27
15	6	EA.	222000	INSERT ANGLE, WALL TO ROOF			6
16	8	EA.	223100	EMBED PLATE, WALL, 1/4"X6"X8", 3-STUD			8

SHOP DETAILS	
DWG NO.	DESCRIPTION
14-001	WALL/FLOOR EMBED DETAIL
14-002	WALL/ROOF EMBED DETAIL
14-004	WALL DETAIL BLOCKOUT SECTION

WALL ASSEMBLY WEIGHT: 6174.999 lbmass  
 KEY WORDS: STD;DR3670,R45

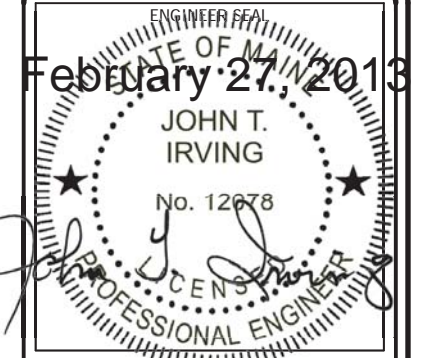

THIS DRAWING IS THE CONFIDENTIAL PROPERTY AND CONTAINS TRADE SECRETS OF CELLXION, LLC. ANY USE OF THESE DRAWINGS OR THE INFORMATION CONTAINED HEREIN FOR ANY REASON OTHER THAN AS EXPRESSLY AUTHORIZED BY CELLXION, LLC. IS STRICTLY PROHIBITED. THIS DRAWING HAS BEEN DISTRIBUTED WITH THE UNDERSTANDING THAT ANYONE RECEIVING OR OTHERWISE OBTAINING POSSESSION OF IT WILL BE EXPRESSLY NOTIFIED OF ITS CONFIDENTIAL NATURE.


**Cellxion**  
 A Division of Sabre Industries, Inc.  
 5031 Hazel Jones Road  
 Bossier City, LA 71111  
 voice: 318-213-2900  
 fax: 318-213-2919  
 www.cellxion.com

CUSTOMER:


PROJECT:

CONCRETE SIDE WALL ASSEMBLY KIT  
 18'0"X9'3"

FILENAME: 223-1800X0903-001.dwg	
DESIGN BY: M. TREKELL	DATE: 11/1/2010
DRAWN BY: M. TREKELL	DATE: 11/2/2010
CHECKED BY: W. RODRIGUEZ	DATE: 11/2/2010
ENGINEERED BY:	DATE:
APPROVED BY: S. LEGGETT	DATE: 11/8/2010
SHEET NO.: 1 OF 2	
DRAWING NO.: 223-1800X0903-001	REV:

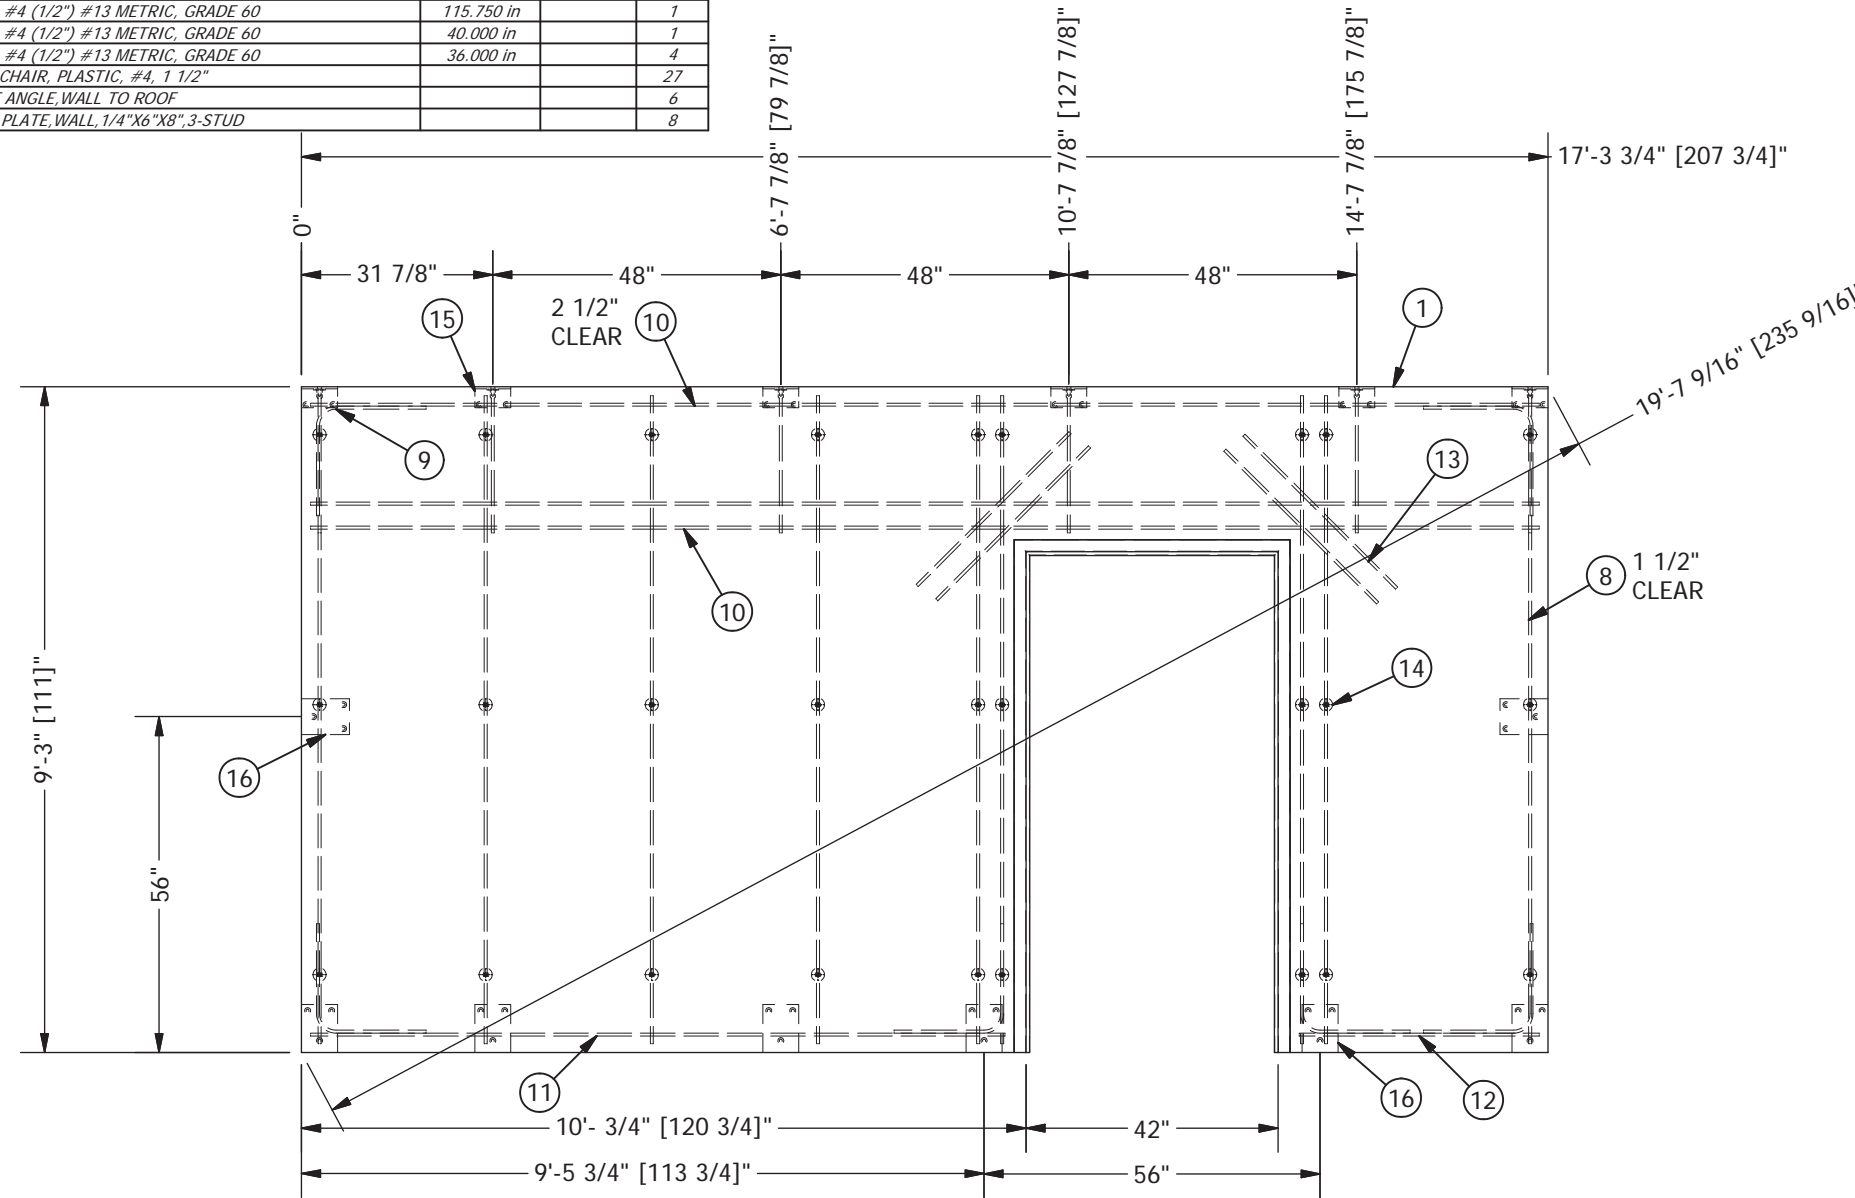

STRUCTURAL LAYOUT - SIDE WALL  
 SCALE 1:32

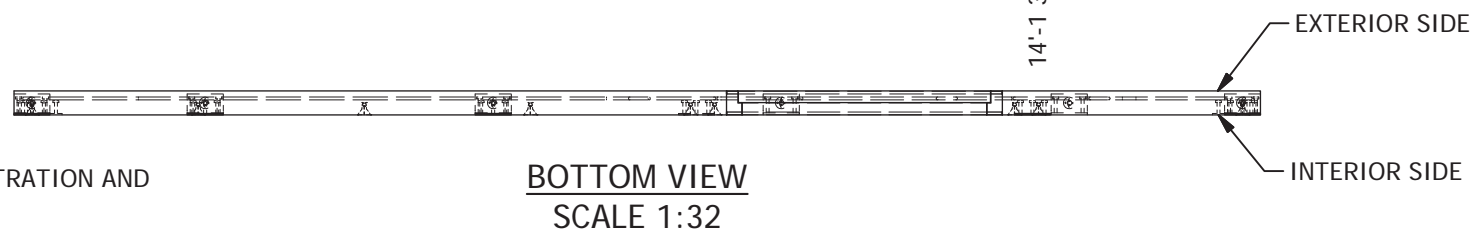


BOTTOM VIEW  
 SCALE 1:32


NOTES:

1. SEE PROJECT SPECIFIC PLANS FOR ALL REQUIRED PVC PENETRATION AND BLOCKOUT SPECIFICATIONS.

PARTS LIST							
ITEM	QTY	U/M	P/N	DESCRIPTION	LENGTH	WIDTH	PCS
5	.45	EA.	110001	MESH, WIRE, 4X4, W4XW4, 8'X20'	108.000 in	96.000 in	1
6	.416	EA.	110001	MESH, WIRE, 4X4, W4XW4, 8'X20'	108.000 in	88.750 in	1
7	.131	EA.	110001	MESH, WIRE, 4X4, W4XW4, 8'X20'	108.000 in	28.000 in	1

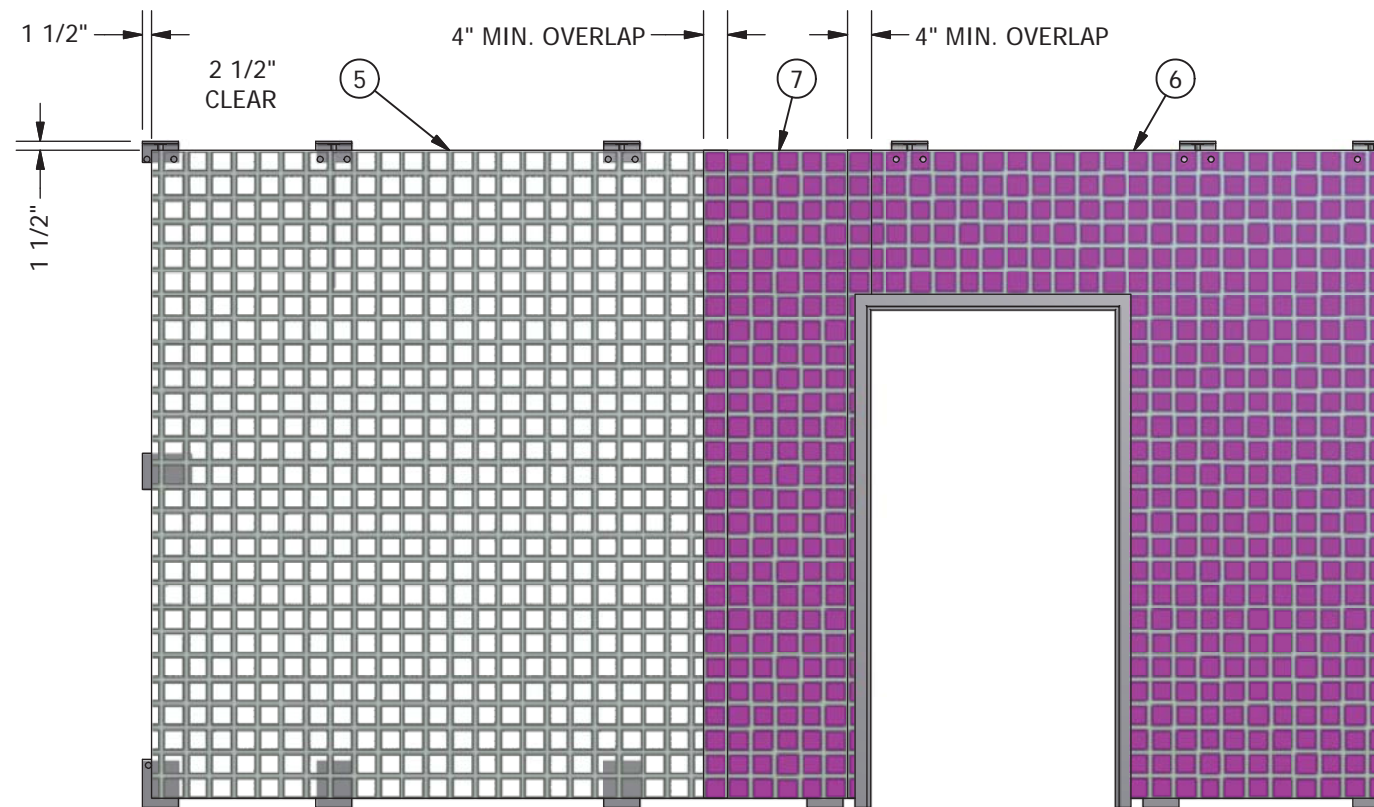

MESH LAYOUT  
SCALE 1:32

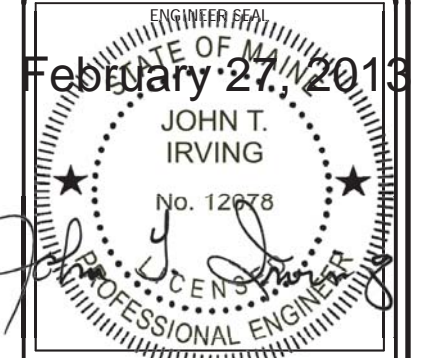

THIS DRAWING IS THE CONFIDENTIAL PROPERTY AND CONTAINS TRADE SECRETS OF CELLXION, LLC. ANY USE OF THESE DRAWINGS OR THE INFORMATION CONTAINED HEREIN FOR ANY REASON OTHER THAN AS EXPRESSLY AUTHORIZED BY CELLXION, LLC. IS STRICTLY PROHIBITED. THIS DRAWING HAS BEEN DISTRIBUTED WITH THE UNDERSTANDING THAT ANYONE RECEIVING OR OTHERWISE OBTAINING POSSESSION OF IT WILL BE EXPRESSLY NOTIFIED OF ITS CONFIDENTIAL NATURE.

**Cellxion**  
A Division of Sabre Industries, Inc.  
5031 Hazel Jones Road  
Bossier City, LA 71111  
voice: 318-213-2900  
fax: 318-213-2919  
www.cellxion.com

CUSTOMER:

PROJECT:  
**CONCRETE SIDE WALL ASSEMBLY KIT**  
**18'0"X9'3"**


FILENAME: 223-1800X0903-001.dwg	
DESIGN BY: M. TREKELL	DATE: 11/1/2010
DRAWN BY: M. TREKELL	DATE: 11/2/2010
CHECKED BY: W. RODRIGUEZ	DATE: 11/2/2010
ENGINEERED BY:	DATE:
APPROVED BY: S. LEGGETT	DATE: 11/8/2010
SHEET NO.: 2 OF 2	
DRAWING NO.: 223-1800X0903-001	REV:



PARTS LIST							
ITEM	QTY	U/M	P/N	DESCRIPTION	LENGTH	WIDTH	PCS
1	1.977	CU.YD.	100052-001	CONCRETE, 1 CUBIC YARD BATCH, WALLS		207.750 in	1
2	1	Each	10RH2000-01	SIDE WALL RAIL ANGLE, 20'-0" (PRODUCTION TOOL)			1
3	1	Each	10RH2000-02	SIDE WALL RAIL ANGLE, 20'-0" (PRODUCTION TOOL)			1
4	2	Each	10RV0903-01	SIDE WALL RAIL ANGLE, 9'-3" (PRODUCTION TOOL)			2
5	.45	EA.	110001	MESH, WIRE, 4X4, W4XW4, 8'X20'	108.000 in	96.000 in	1
6	.416	EA.	110001	MESH, WIRE, 4X4, W4XW4, 8'X20'	108.000 in	88.750 in	1
7	.131	EA.	110001	MESH, WIRE, 4X4, W4XW4, 8'X20'	108.000 in	28.000 in	1
8	72	FT.	112502	REBAR, #4 (1/2") #13 METRIC, GRADE 60	108.000 in		8
9	12	FT.	112502	REBAR, #4 (1/2") #13 METRIC, GRADE 60	36.000 in		4
10	51.188	FT.	112502	REBAR, #4 (1/2") #13 METRIC, GRADE 60	204.750 in		3
11	24	EA.	119015	REBAR CHAIR, PLASTIC, #4, 1 1/2"			24
12	6	Each	222000	INSERT ANGLE, WALL TO ROOF, 3.5" X 3.5" X 6"			6
13	8	EA.	223100	INSERT PLATE, WALL TO FLOOR/WALL			8
21	.347	FBM	360151	INSULATION, EPS, FOAM, RAW MATL B-FOOT	5.000 in	5.000 in	1

SHOP DETAILS	
DWG NO.	DESCRIPTION
14-001	WALL/FLOOR EMBED DETAIL
14-002	WALL/ROOF EMBED DETAIL
14-004	WALL DETAIL BLOCKOUT SECTION

WALL ASSEMBLY WEIGHT: N/A  
KEY WORDS: STD;BO10.75X12.75,L65.25,B30

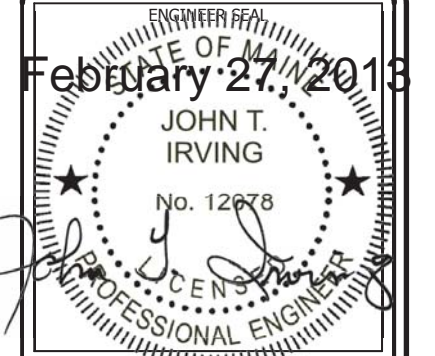

THIS DRAWING IS THE CONFIDENTIAL PROPERTY AND CONTAINS TRADE SECRETS OF CELLXION, LLC. ANY USE OF THESE DRAWINGS OR THE INFORMATION CONTAINED HEREIN FOR ANY REASON OTHER THAN AS EXPRESSLY AUTHORIZED BY CELLXION, LLC. IS STRICTLY PROHIBITED. THIS DRAWING HAS BEEN DISTRIBUTED WITH THE UNDERSTANDING THAT ANYONE RECEIVING OR OTHERWISE OBTAINING POSSESSION OF IT WILL BE EXPRESSLY NOTIFIED OF ITS CONFIDENTIAL NATURE.

**Cellxion**  
A Division of Sabre Industries, Inc.  
5031 Hazel Jones Road  
Bossier City, LA 71111  
voice: 318-213-2900  
fax: 318-213-2919  
www.cellxion.com

CUSTOMER:

PROJECT:

**CONCRETE SIDE WALL  
ASSEMBLY KIT  
18'0"X9'3"**


FILENAME: 223-1800X0903-002.dwg	
DESIGN BY: M. TREKELL	DATE: 11/1/2010
DRAWN BY: M. TREKELL	DATE: 11/2/2010
CHECKED BY: W. RODRIGUEZ	DATE: 11/2/2010
ENGINEERED BY:	DATE:

APPROVED BY:	DATE:
--------------	-------


SHEET NO.:  
**1 OF 2**

DRAWING NO.:  
**223-1800X0903-002**

REV:

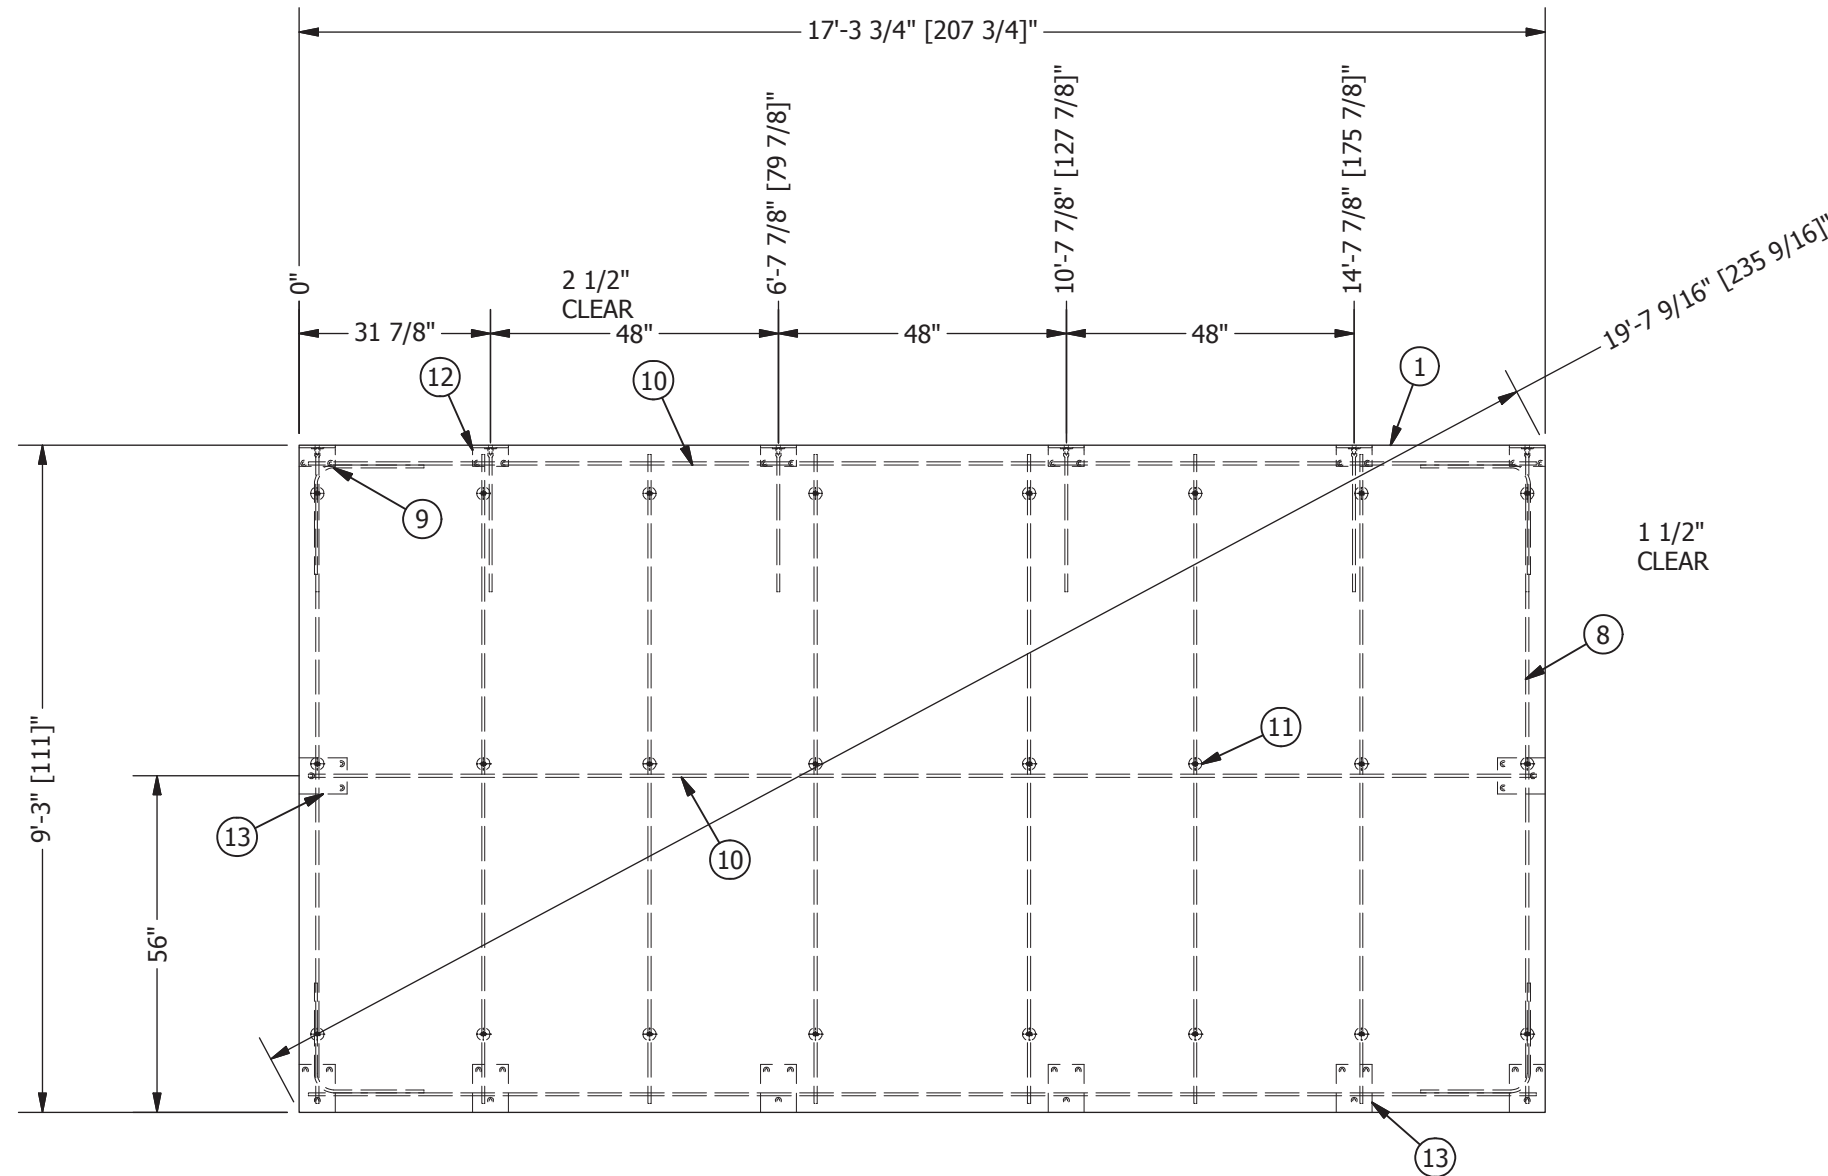

**STRUCTURAL LAYOUT - SIDE WALL**  
SCALE 1:32

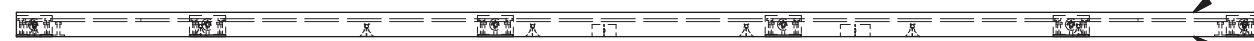

**BOTTOM VIEW**  
SCALE 1:32


EXTERIOR SIDE

INTERIOR SIDE


**NOTES:**

1. SEE PROJECT SPECIFIC PLANS FOR ALL REQUIRED PVC PENETRATION AND BLOCKOUT SPECIFICATIONS.

PARTS LIST							
ITEM	QTY	U/M	P/N	DESCRIPTION	LENGTH	WIDTH	PCS
5	.45	EA.	110001	MESH, WIRE, 4X4, W4XW4, 8'X20'	108.000 in	96.000 in	1
6	.416	EA.	110001	MESH, WIRE, 4X4, W4XW4, 8'X20'	108.000 in	88.750 in	1
7	.131	EA.	110001	MESH, WIRE, 4X4, W4XW4, 8'X20'	108.000 in	28.000 in	1

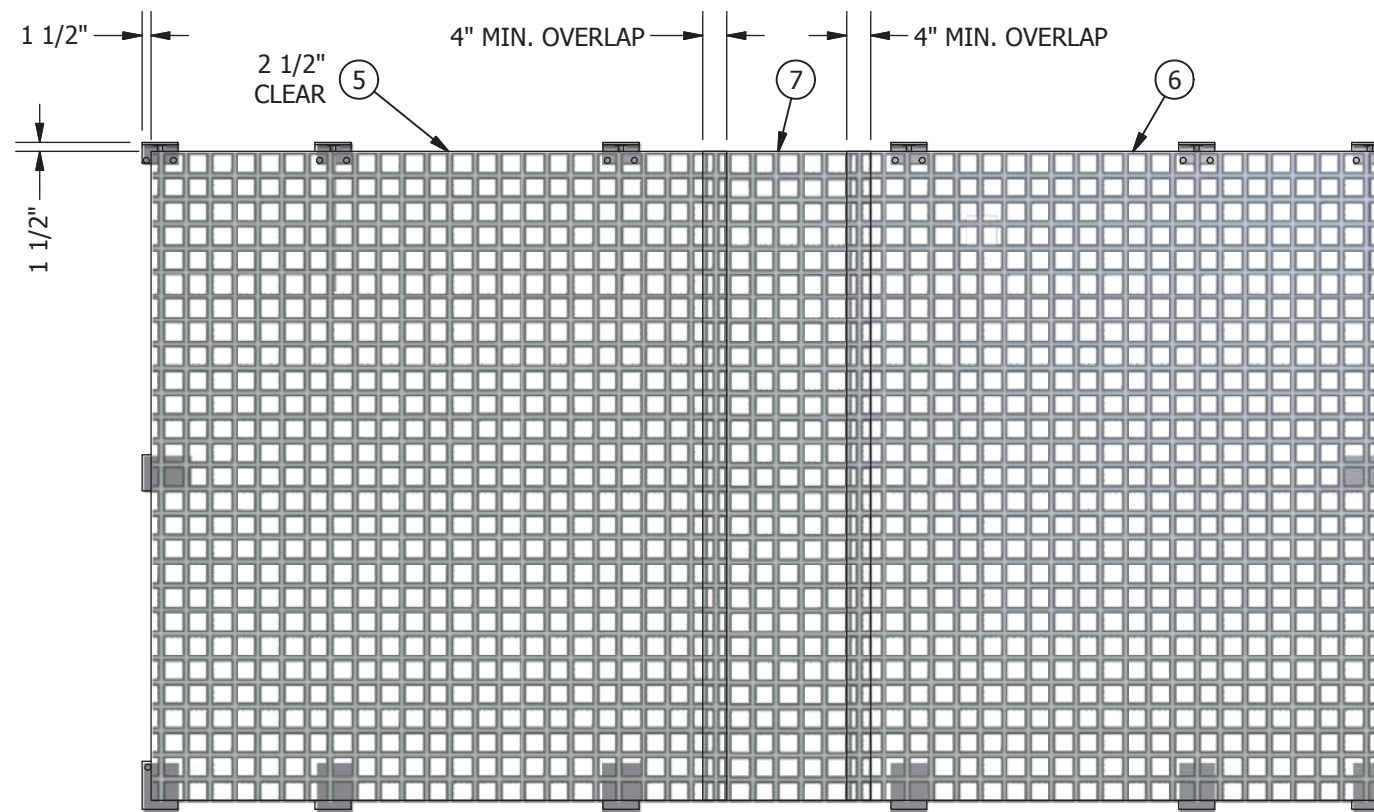

MESH LAYOUT  
SCALE 1:32

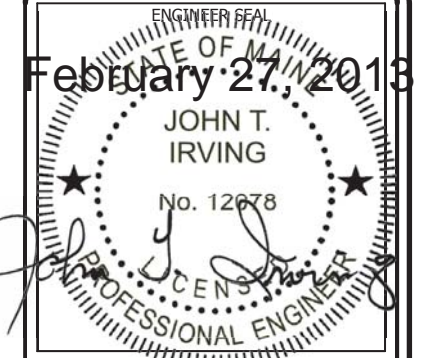

THIS DRAWING IS THE CONFIDENTIAL PROPERTY AND CONTAINS TRADE SECRETS OF CELLXION, LLC. ANY USE OF THESE DRAWINGS OR THE INFORMATION CONTAINED HEREIN FOR ANY REASON OTHER THAN AS EXPRESSLY AUTHORIZED BY CELLXION, LLC. IS STRICTLY PROHIBITED. THIS DRAWING HAS BEEN DISTRIBUTED WITH THE UNDERSTANDING THAT ANYONE RECEIVING OR OTHERWISE OBTAINING POSSESSION OF IT WILL BE EXPRESSLY NOTIFIED OF ITS CONFIDENTIAL NATURE.

**Cellxion**  
A Division of Sabre Industries, Inc.  
5031 Hazel Jones Road  
Bossier City, LA 71111  
voice: 318-213-2900  
fax: 318-213-2919  
www.cellxion.com

CUSTOMER:

PROJECT:  
**CONCRETE SIDE WALL ASSEMBLY KIT 18'0"X9'3"**

FILENAME: 223-1800X0903-002.dwg	
DESIGN BY: M. TREKELL	DATE: 11/1/2010
DRAWN BY: M. TREKELL	DATE: 11/2/2010
CHECKED BY: W. RODRIGUEZ	DATE: 11/2/2010
ENGINEERED BY:	DATE:
APPROVED BY:	DATE:


SHEET NO.:  
**2 OF 2**

DRAWING NO.: **223-1800X0903-002**      REV:


PART LIST							
ITEM	QTY	U/M	P/N	DESCRIPTION	LENGTH	WIDTH	PCS
1	2.765	CU.YD.	100052-003	CONCRETE, 1 CUBIC YARD BATCH, ROOF			1
2	2	Each	10RP1008-01	ROOF RAIL END PLATE, 10'-8", 4/5 (PRODUCTION TOOL)			2
3	2	Each	10RR1000-01	ROOF END RAIL ANGLE, 10'-0" (PRODUCTION TOOL)			2
4	2	Each	10RR2100-01	SIDE ROOF RAIL ANGLE, 21'-0" (PRODUCTION TOOL)			2
5	197.917	FT.	112502	REBAR, #4 (1/2") #13 METRIC, GRADE 60	125.000 in		19
6	147.333	FT.	112502	REBAR, #4 (1/2") #13 METRIC, GRADE 60	221.000 in		8
7	21	Each	119010	REBAR CHAIR, PLASTIC, #4 W/ BASE 1"			21
8	8	EA.	220211-01	ANCHOR, SWIFT LIFT, ASSEMBLY			8
9	16	EA.	223000	INSERT PLATE, ROOF TO WALL, 4" X 6" X 1/4"			16

SHOP DETAILS	
DWG NO.	DESCRIPTION
10-002	WALL TO ROOF CONNECTION
13-002	CONCRETE SHELTER ROOF EAVE SECTION
13-003	ROOF ANCHOR LIFTING INSERT DETAIL


ROOF ASSEMBLY WEIGHT: N/A  
 KEY WORDS: S31.875,48,48,48;E48,24

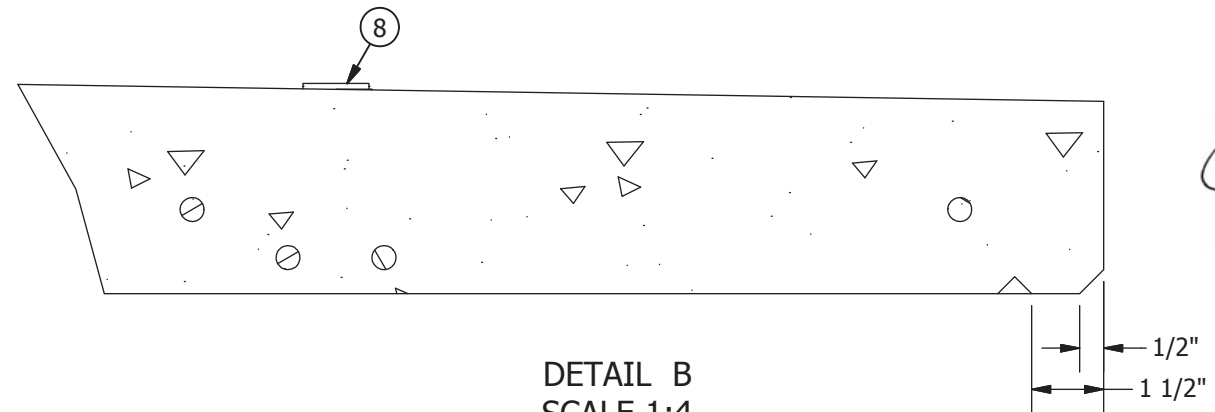


DETAIL B  
SCALE 1:4

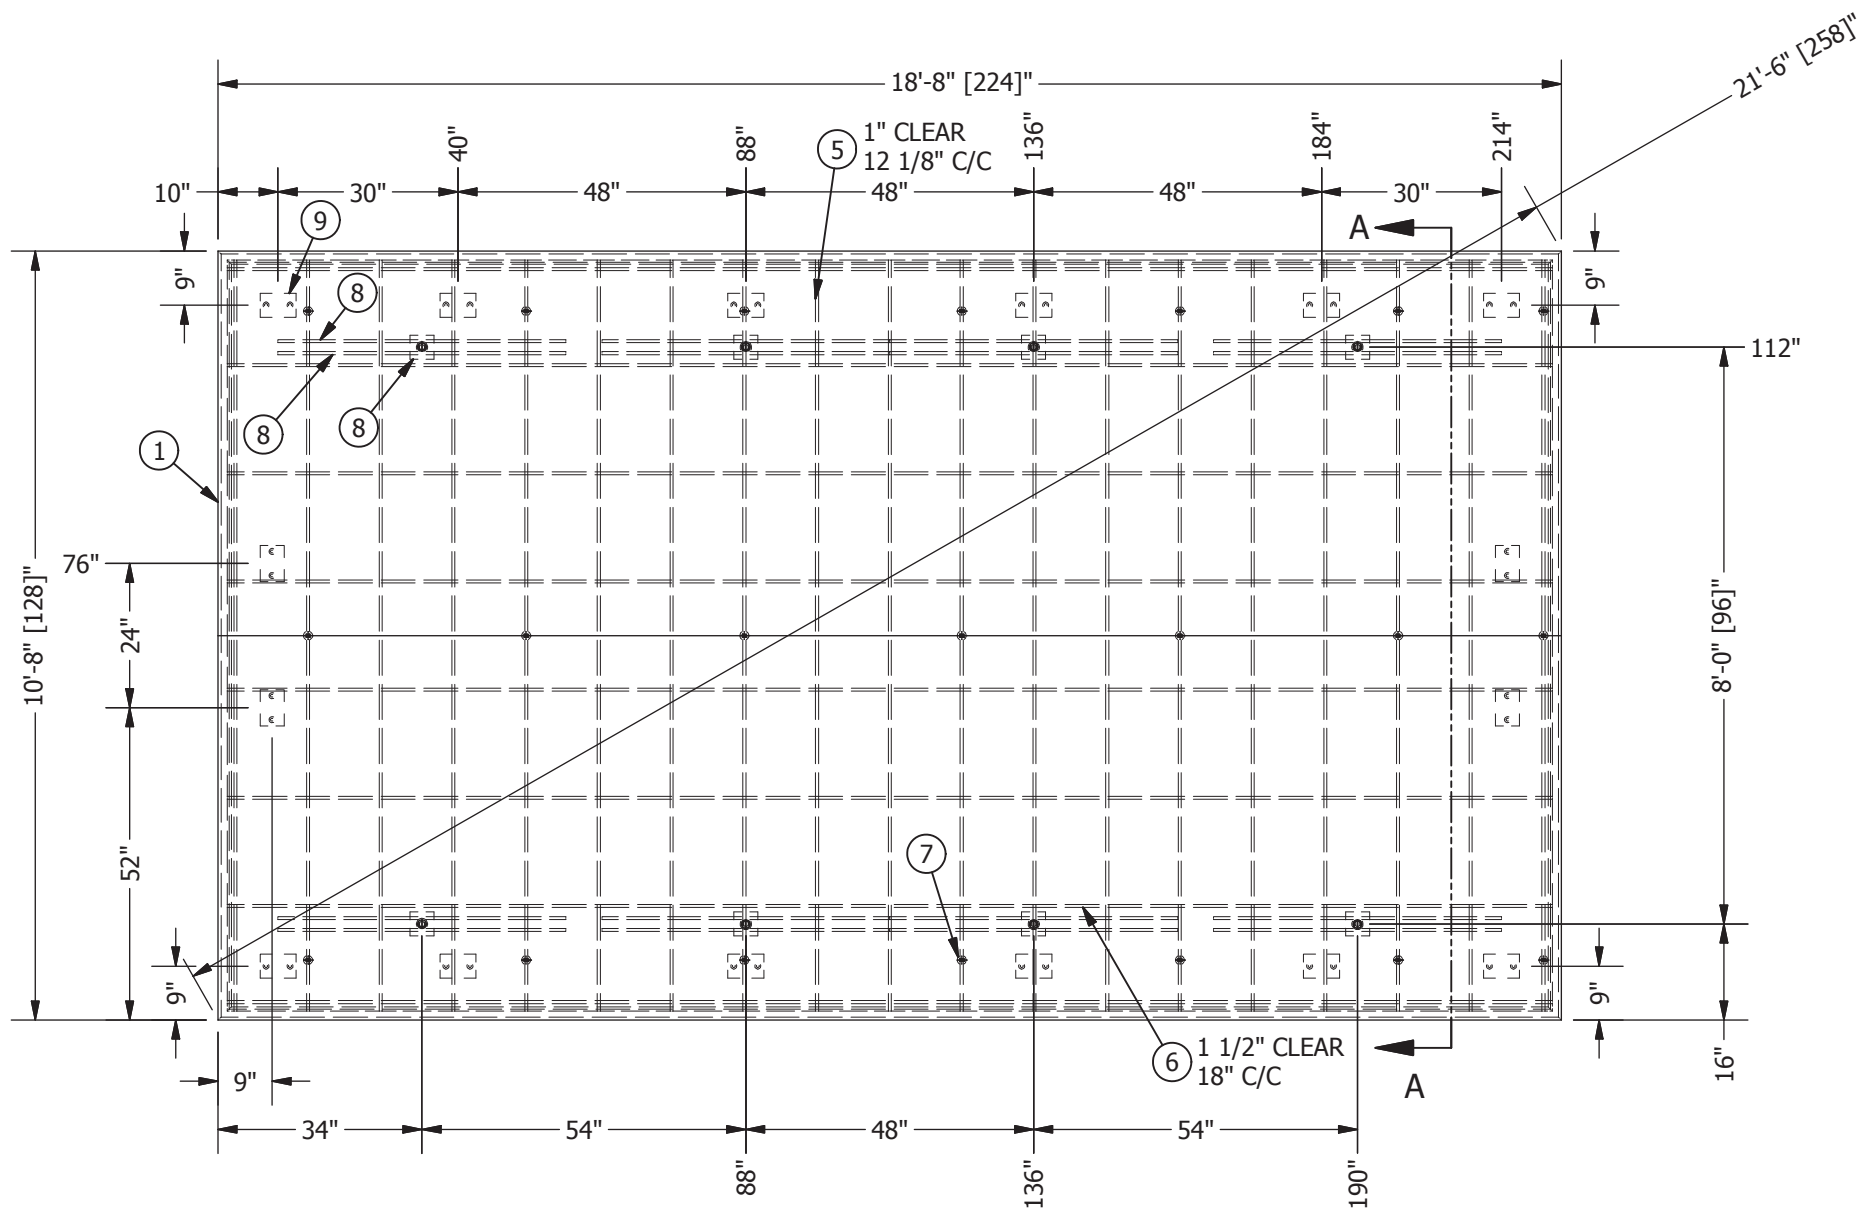

STRUCTURAL LAYOUT - ROOF  
SCALE 1:32

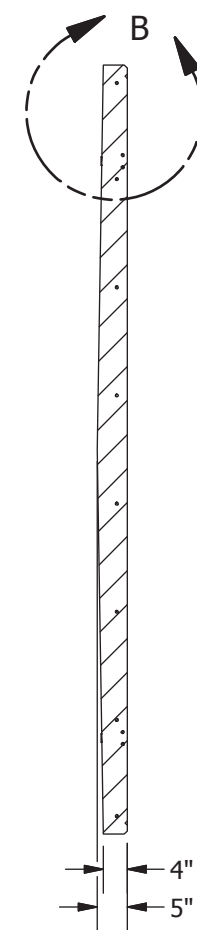

SECTION A-A  
SCALE 1:32

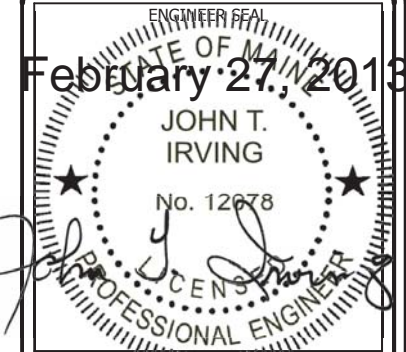

THIS DRAWING IS THE CONFIDENTIAL PROPERTY AND CONTAINS TRADE SECRETS OF CELLXION, LLC. ANY USE OF THESE DRAWINGS OR THE INFORMATION CONTAINED HEREIN FOR ANY REASON OTHER THAN AS EXPRESSLY AUTHORIZED BY CELLXION, LLC. IS STRICTLY PROHIBITED. THIS DRAWING HAS BEEN DISTRIBUTED WITH THE UNDERSTANDING THAT ANYONE RECEIVING OR OTHERWISE OBTAINING POSSESSION OF IT WILL BE EXPRESSLY NOTIFIED OF ITS CONFIDENTIAL NATURE.

**Cellxion**  
 A Division of Sabre Industries, Inc.  
 5031 Hazel Jones Road  
 Bossier City, LA 71111  
 voice: 318-213-2900  
 fax: 318-213-2919  
 www.cellxion.com

CUSTOMER:

PROJECT:  
**10'0"X18'0"**  
**CONCRETE ROOF**  
**ASSEMBLY KIT**

FILENAME: 226-1000X1800X4-00.dwg	
DESIGN BY: M. TREKELL	DATE: 11/3/2010
DRAWN BY: M. TREKELL	DATE: 11/4/2010
CHECKED BY: W. RODRIGUEZ	DATE: 11/4/2010
ENGINEERED BY:	DATE:

APPROVED BY: DATE:

SHEET NO.:  
1 OF 1

DRAWING NO.: **226-1000X1800X4-00** REV: