




Date:

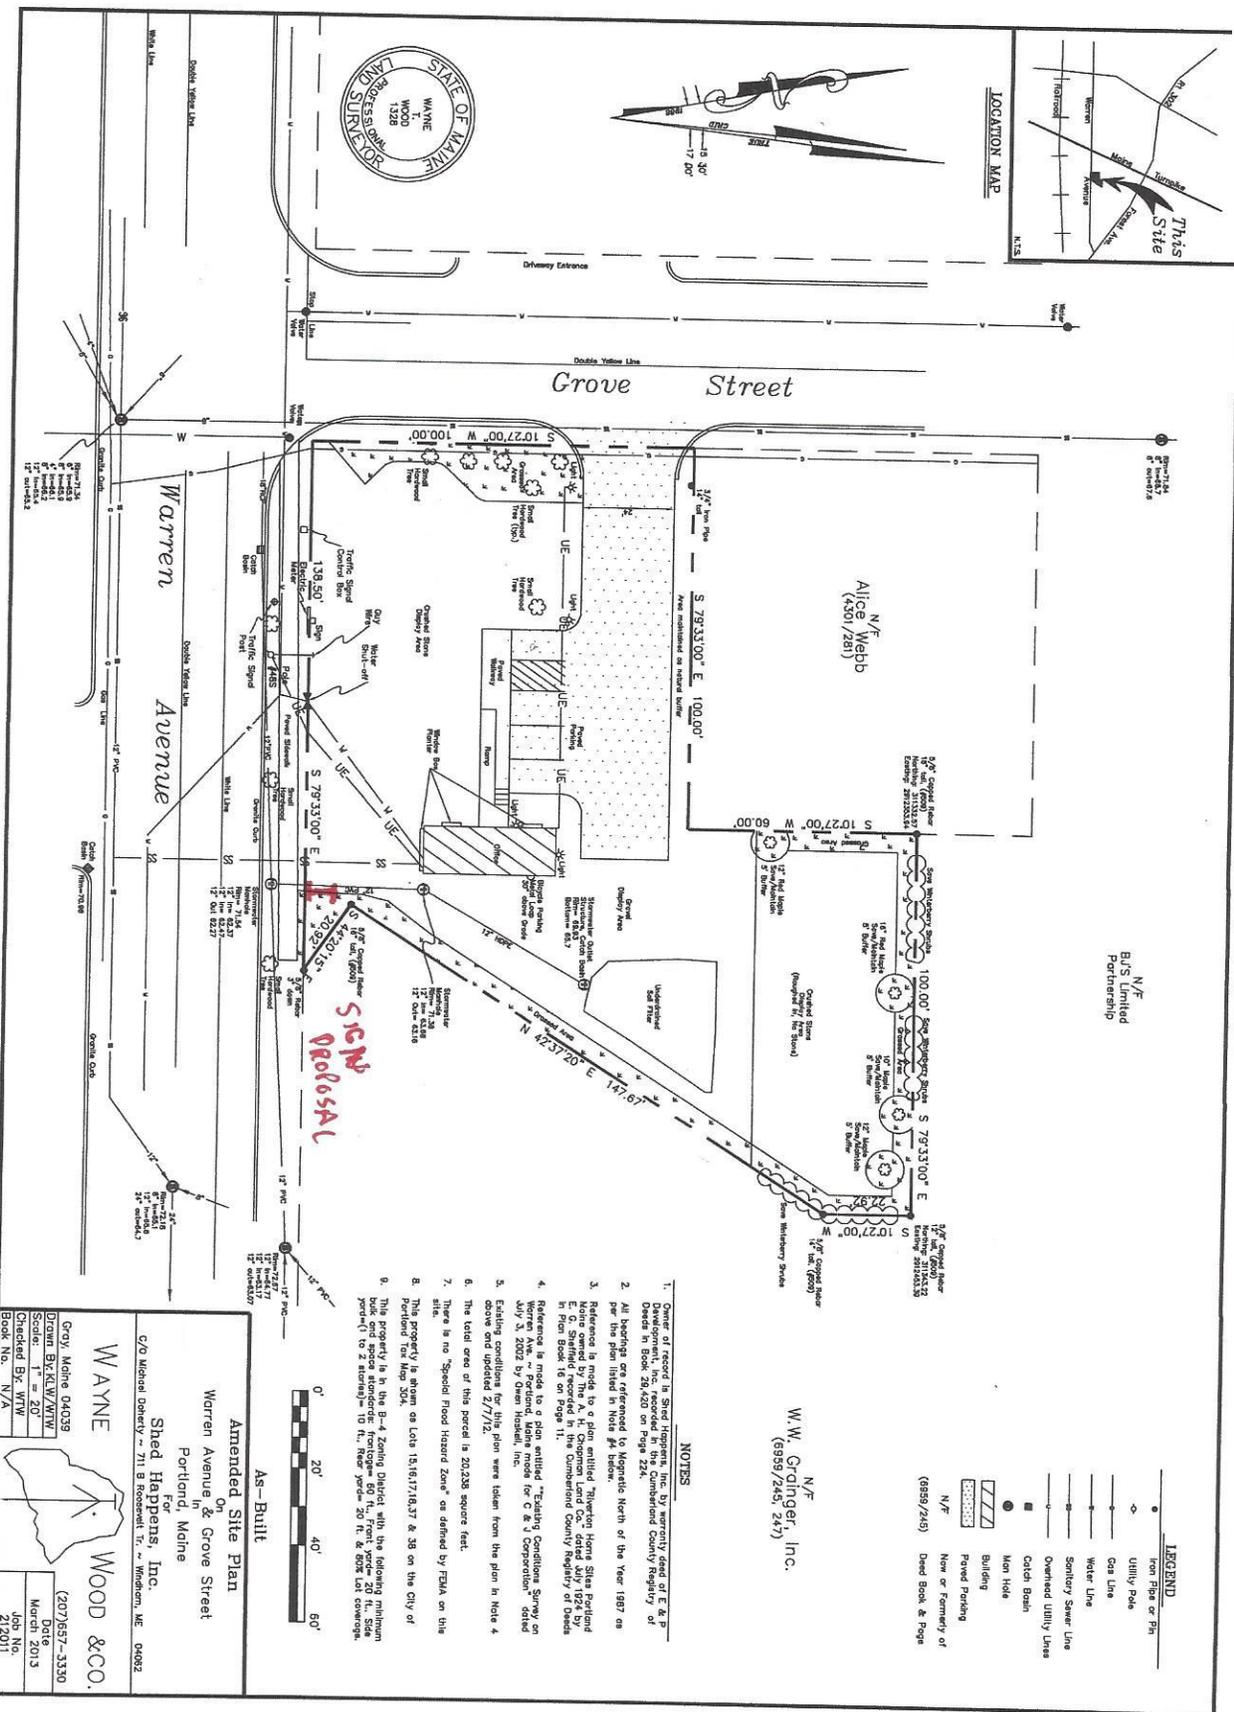

As-Built

Amended Site Plan

Warren Avenue & Grove Street
Portland, Maine

For
Shed Happens, Inc.
C/O Michael Doherty - 711 B Rosewell Tr. - Wintham, ME. 04092

WAYNE

WOOD & CO.

Gray, Maine 04039
Phone: (207)857-3330
Fax: (207)857-3330
E-mail: info@woodco.com
Website: www.woodco.com

Drawn By: KJW/MW
Scale: 1" = 20'
Checked By: WTW
Book No.: N/A

Job No. 212011