



ROOF PLAN

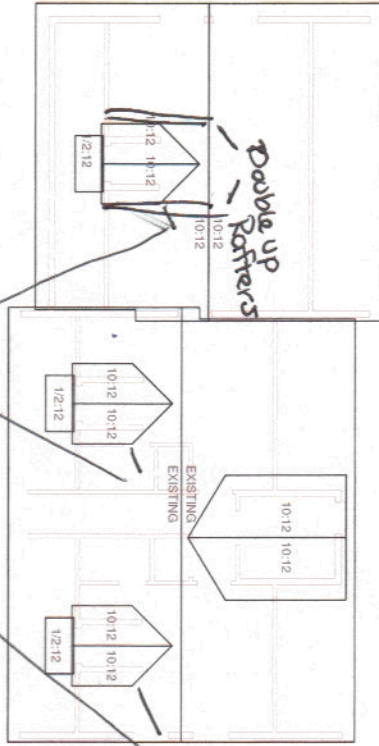

- NOTES:
- EXISTING DIMENSIONS ARE APPROXIMATE. PLEASE VERIFY IN FIELD.
 - EXISTING STRUCTURE IS SHOWN FOR REPRESENTATION PURPOSES. ONLY AND IS NOT MEANT TO BE USED AS AN AS-BUILT DRAWING. ANY VARIATIONS SHOULD BE CONSIDERED INVALID.
 - GRADE MAY VARY FROM ACTUAL SITE CONDITIONS.

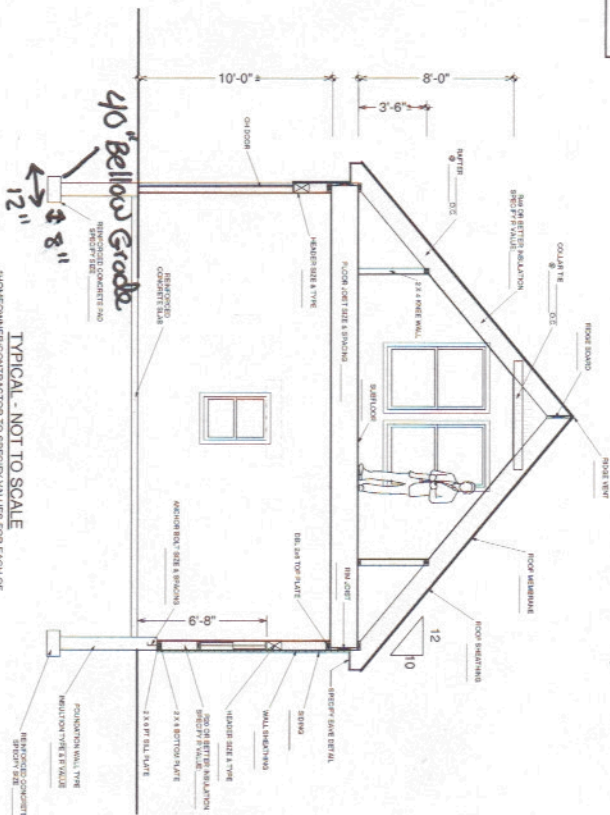

TYPICAL - NOT TO SCALE
 *HOMEOWNER/CONTRACTOR TO SPECIFY VALUES FOR EACH OF THE CALLOUTS. SOME CALLOUTS MAY NOT BE APPLICABLE.
 THIS DRAWING IS THE PROPERTY OF HAMMOND LUMBER COMPANY. IT IS TO BE USED ONLY FOR THE PROJECT AND SITE SPECIFICALLY IDENTIFIED HEREIN. IT IS NOT TO BE REPRODUCED, COPIED, OR TRANSMITTED IN ANY FORM OR BY ANY MEANS, ELECTRONIC OR MECHANICAL, INCLUDING PHOTOCOPYING, RECORDING, OR BY ANY INFORMATION STORAGE AND RETRIEVAL SYSTEM, WITHOUT THE WRITTEN PERMISSION OF HAMMOND LUMBER COMPANY. © 2014 HAMMOND LUMBER COMPANY. ALL RIGHTS RESERVED.

-All windows' Doors
 2x8" Triple Headers
 -Garage Doors Triple 9 7/8"



ENVY CONSTRUCTION
 AL & CAROL ADDITION

24' x 22'
 ADDITION

DESIGNED BY: BEP
 DRAWN BY: DJH

AD14055
 1/20/2016
 3 of 3

HOME PLANNING CENTER
 Drafting & Estimating
 Hammond Lumber Company

DISCLAIMER
 DRAWINGS ARE PROVIDED BY HAMMOND LUMBER COMPANY AS A SERVICE TO ITS CUSTOMERS AND ARE INTENDED FOR INFORMATIONAL AND ESTIMATING PURPOSES ONLY. THE INFORMATION PRESENTED IN THESE DRAWINGS IS NOT GUARANTEED TO BE ACCURATE. HAMMOND LUMBER COMPANY ASSUMES NO LIABILITY FOR ANY ERRORS OR OMISSIONS. THE CUSTOMER SHALL BE RESPONSIBLE FOR OBTAINING ALL NECESSARY PERMITS AND INSURANCE. HAMMOND LUMBER COMPANY SHALL NOT BE HELD RESPONSIBLE FOR ANY DAMAGES OR LOSSES, INCLUDING CONSEQUENTIAL DAMAGES, ARISING FROM THE USE OF THESE DRAWINGS. THE CUSTOMER SHALL BE RESPONSIBLE FOR VERIFYING ALL DIMENSIONS AND CONDITIONS OF THE SITE PRIOR TO CONSTRUCTION. HAMMOND LUMBER COMPANY SHALL NOT BE HELD RESPONSIBLE FOR ANY DAMAGES OR LOSSES, INCLUDING CONSEQUENTIAL DAMAGES, ARISING FROM THE USE OF THESE DRAWINGS.

- 12 LOCATIONS TO SERVE YOU BETTER
- ALBANY
 - BANGOR
 - BELORE
 - BOOTHBAY HARBOR
 - BREWER
 - DAMARISCOTTA
 - FAIRFIELD
 - FARMINGTON
 - GREENVILLE
 - HERMON
 - PORTLAND
 - SKOWHEGAN