


Whitten Architects  
37 Silver Street Portland, Me 04101

REVISION TO EAST WALL 4.29.2014  
13 ST. LAWRENCE STREET  
LAWRENCE WHITTEN LLC • G.P. WHITTEN ARCHITECT • PORTLAND

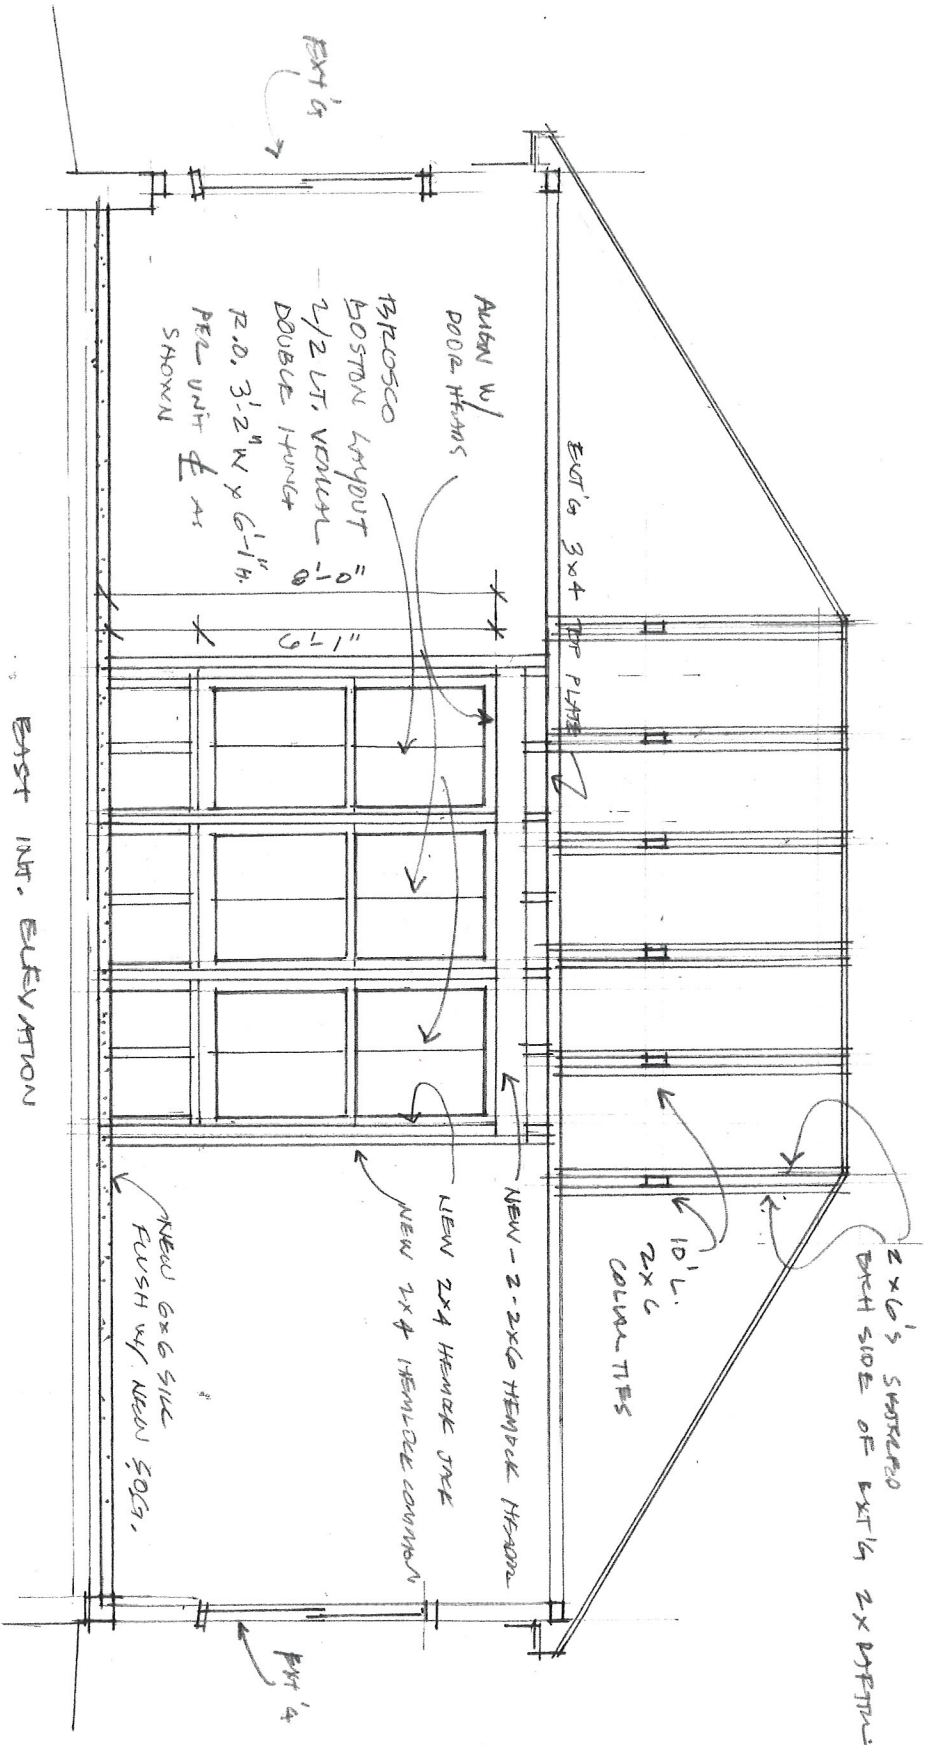



# BOSTON LAYOUT

## Set-up Double-Hung Wood Windows



### AUTHENTIC DIVIDED LIGHT (SSB or SSB w/Low "E" Panel)

#### 2/1 LIGHT

Rough Opening			2'-6"	2'-9"	2'-10"	3'-0"
Sash Opening			2'-3 5/8"	2'-6 5/8"	2'-7 5/8"	2'-9 5/8"
*Glass Size			24"	27"	28"	30"
4'-9"	4'-5"	24"	24" x 24"	27" x 24"	-	-
5'-1"	4'-9"	26"	-	27" x 26"	-	-
5'-5"	5'-1"	28"	-	27" x 28"	28" x 28"	30" x 28"
5'-9"	5'-5"	30"	-	-	-	30" x 30"

#### 2/2 LIGHT - HORIZONTAL

Rough Opening			2'-6"	2'-9"
Sash Opening			2'-3 5/8"	2'-6 5/8"
*Glass Size			24"	27"
3'-5"	3'-1"	8"	24" x 8"	27" x 8"
4'-1"	3'-9"	10"	24" x 10"	27" x 10"

#### 2/2 LIGHT - VERTICAL

Rough Opening			2'-3"	2'-6"	2'-9"	2'-10"	3'-0"	3'-2"
Sash Opening			2'-0 5/8"	2'-3 5/8"	2'-6 5/8"	2'-7 5/8"	2'-9 5/8"	2'-11 5/8"
*Glass Size			10 1/2"	12"	13 1/2"	14"	15"	16"
3'-9"	3'-5"	18"	10 1/2" x 18"	-	-	-	-	-
4'-1"	3'-9"	20"	-	12" x 20"	13 1/2" x 20"	-	-	-
4'-5"	4'-1"	22"	-	-	13 1/2" x 22"	-	-	-
4'-6"	4'-2"	22 1/2"	10 1/2" x 22 1/2"	-	-	-	-	-
4'-9"	4'-5"	24"	-	12" x 24"	13 1/2" x 24"	14" x 24"	15" x 24"	-
4'-11"	4'-7"	25"	-	12" x 25"	-	-	-	-
5'-1"	4'-9"	26"	-	-	13 1/2" x 26"	14" x 26"	15" x 26"	-
5'-5"	5'-1"	28"	-	-	13 1/2" x 28"	14" x 28"	15" x 28"	-
5'-9"	5'-5"	30"	-	-	13 1/2" x 30"	14" x 30"	15" x 30"	16" x 30"
6'-1"	5'-9"	32"	-	-	-	-	15" x 32"	16" x 32"

3 UNITS →

#### 3/3 LIGHT

Rough Opening			2'-9"
Sash Opening			2'-6 5/8"
*Glass Size			9"
2'-9"	2'-5"	12"	9" x 12"
2'-11"	2'-7"	13"	9" x 13"

#### 4/4 LIGHT

Rough Opening			1'-10"
Sash Opening			1'-7 5/8"
*Glass Size			8"
3'-5"	3'-1"	8"	8" x 8"
4'-1"	3'-9"	10"	8" x 10"
4'-5"	4'-1"	11"	8" x 11"
4'-9"	4'-5"	12"	8" x 12"

13 St. LAWRENCE

NFRC Rating	
Unit	"U" Value
Low "E" Insul Glass	.35
SSB with Low "E" Panel	.43
SSB Glass	.94

\*Glass sizes are approximate.