

Barber Schem

Riverside Indl. way, Portland, Maine

Proposed Office Plan

August 24, 2004

SCALE: 3/32"=1'-0"

04116



8

7

6

5


4

3

2

1

NO.	DATE	DESCRIPTION	BY	APPROVED

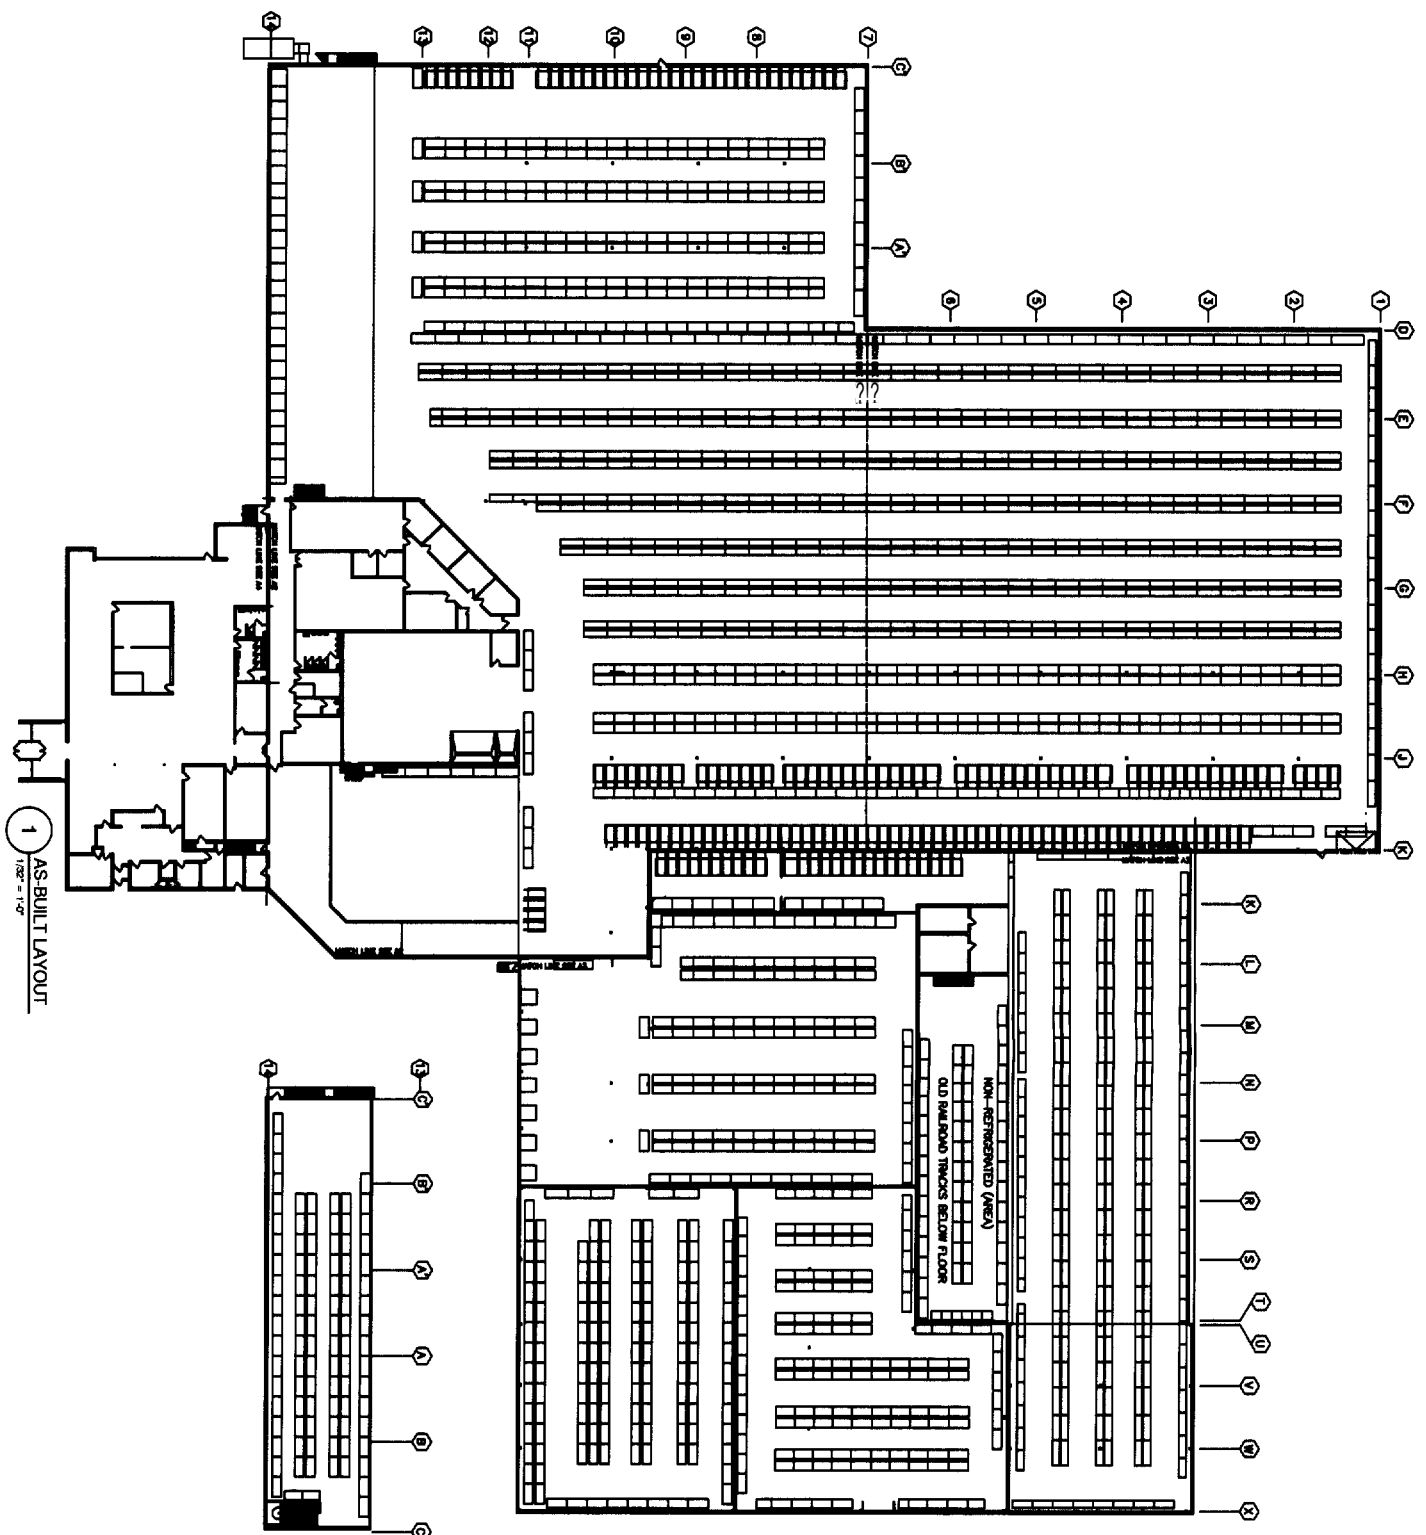

1 AS-BUILT LAYOUT
1/32" = 1'-0"

A

B

C

D

D

B

C

D

8 7 6 5 4 3 2 1

DESIGNED BY	DRAWN	LEN	DATE	06/03/04	DATE	06/03/04	DATE	06/03/04	DATE	06/03/04	DATE	06/03/04
CHECKED	FM	DATE	MM/DD/YY	MM/DD/YY	MM/DD/YY	MM/DD/YY	MM/DD/YY	MM/DD/YY	MM/DD/YY	MM/DD/YY	MM/DD/YY	MM/DD/YY
APPROVED	SCALE	1/32" = 1'-0"	SCALE	1/32" = 1'-0"	SCALE	1/32" = 1'-0"	SCALE	1/32" = 1'-0"	SCALE	1/32" = 1'-0"	SCALE	1/32" = 1'-0"



SUPERVALU WAREHOUSE
OVERALL LAYOUT
 AS-BUILT

34 St. Louis Street
 Portland, ME 04103
 207/725-1584

1
 2
 3

