

City of Portland, Maine - Building or Use Permit Application

389 Congress Street, 04101 Tel: (207) 874-8703, Fax: (207) 874-8716

Permit No: 02-0099	Issue Date: FEB 1 2002	CBL: 336 L008001
-----------------------	---------------------------	---------------------

Location of Construction: 27 Leisure Lane Unit #3	Owner Name: North Star Enterprises Inc	Owner Address: 21 Stuart St CITY OF PORTLAND	Phone: 207-878-0223
Business Name:	Contractor Name: O' Brien Edin	Contractor Address: P.O. Box 15004 Portland	Phone: 2073326281
Lessee/Buyer's Name	Phone:	Permit Type: Alterations - Dwellings	Zone:

Past Use: single family Condo #3	Proposed Use: single family	Permit Fee: \$107.00	Cost of Work: \$10,510.00	CEO District: 1
		FIRE DEPT: <input type="checkbox"/> Approved <input type="checkbox"/> Denied	INSPECTION: Use Group: <i>R4</i> Type: <i>5B</i>	

Proposed Project Description: finish second floor of unit #3 to include 2 bedrooms and bath	Signature: <i>N/A</i>	Signature: <i>[Signature]</i>
PEDESTRIAN ACTIVITIES DISTRICT (P.A.D.)		
Action: <input type="checkbox"/> Approved <input type="checkbox"/> Approved w/Conditions <input type="checkbox"/> Denied		
Signature:	Date:	

Permit Taken By: gg	Date Applied For: 01/31/2002	Zoning Approval	
------------------------	---------------------------------	------------------------	--

<ol style="list-style-type: none"> This permit application does not preclude the Applicant(s) from meeting applicable State and Federal Rules. Building permits do not include plumbing, septic or electrical work. Building permits are void if work is not started within six (6) months of the date of issuance. False information may invalidate a building permit and stop all work.. 	Special Zone or Reviews <input type="checkbox"/> Shoreland <input type="checkbox"/> Wetland <input type="checkbox"/> Flood Zone <input type="checkbox"/> Subdivision <input type="checkbox"/> Site Plan Maj <input type="checkbox"/> Minor <input type="checkbox"/> MM <input type="checkbox"/> Date: <i>1/31/0</i>	Zoning Appeal <input type="checkbox"/> Variance <input type="checkbox"/> Miscellaneous <input type="checkbox"/> Conditional Use <input type="checkbox"/> Interpretation <input type="checkbox"/> Approved <input type="checkbox"/> Denied Date:	Historic Preservation <input type="checkbox"/> Not in District or Landmark <input checked="" type="checkbox"/> Does Not Require Review <input type="checkbox"/> Requires Review <input type="checkbox"/> Approved <input type="checkbox"/> Approved w/Conditions <input type="checkbox"/> Denied Date:
	<i>No Expansion</i>		

CERTIFICATION

I hereby certify that I am the owner of record of the named property, or that the proposed work is authorized by the owner of record and that I have been authorized by the owner to make this application as his authorized agent and I agree to conform to all applicable laws of this jurisdiction. In addition, if a permit for work described in the application is issued, I certify that the code official's authorized representative shall have the authority to enter all areas covered by such permit at any reasonable hour to enforce the provision of the code(s) applicable to such permit.

SIGNATURE OF APPLICANT	ADDRESS	DATE	PHONE
RESPONSIBLE PERSON IN CHARGE OF WORK, TITLE		DATE	PHONE

All Purpose Building Permit Application

If you or the property owner owes real estate or personal property taxes or user charges on any property within the City, payment arrangements must be made before permits of any kind are accepted.


Location/Address of Construction: <u>27 LEISURE Lane PORTLAND UNIT 3</u>		
Total Square Footage of Proposed Structure <u>735</u>	Square Footage of Lot <u>40 x 78</u>	
Tax Assessor's Chart, Block & Lot Chart# <u>336</u> Block# <u>L</u> Lot# <u>009</u>	Owner: <u>CAROLYN DONOVAN</u>	Telephone: <u>878-0223</u>
Lessee/Buyer's Name (If Applicable)	Applicant name, address & telephone: <u>EOIN O'BRIEN</u> <u>P.O. BOX 15004 PORTLAND</u> <u>04112-3326281</u>	Cost Of Work: \$ <u>10,510-</u> Fee: \$ <u>107-</u>
Current use: <u>Single Family Condo</u>		
If the location is currently vacant, what was prior use: _____		
Approximately how long has it been vacant: _____		
Proposed use: <u>SINJAM</u>		
Project description: <u>Finishing 2nd floor -</u>		
Contractor's name, address & telephone: <u>EOIN O'BRIEN, P.O. BOX 15004</u> <u>PORT. 04112</u>		
Who should we contact when the permit is ready: <u>E O'BRIEN 332-6281</u>		
Mailing address: <u>SAME</u>		
We will contact you by phone when the permit is ready. You must come in and pick up the permit and review the requirements before starting any work, with a Plan Reviewer. A stop work order will be issued and a \$100.00 fee if any work starts before the permit is picked up. PHONE: 332-6281		


IF THE REQUIRED INFORMATION IS NOT INCLUDED IN THE SUBMISSIONS THE PERMIT WILL BE AUTOMATICALLY DENIED AT THE DISCRETION OF THE BUILDING/PLANNING DEPARTMENT, WE MAY REQUIRE ADDITIONAL INFORMATION IN ORDER TO APPROVE THIS PERMIT.

I hereby certify that I am the Owner of record of the named property, or that the owner of record authorizes the proposed work and that I have been authorized by the owner to make this application as his/her authorized agent. I agree to conform to all applicable laws of this jurisdiction. In addition, if a permit for work described in this application is issued, I certify that the Code Official's authorized representative shall have the authority to enter all areas covered by this permit at any reasonable hour to enforce the provisions of the codes applicable to this permit.


Signature of applicant: <u>[Signature]</u>	Date: <u>01-30-02</u>
--	-----------------------

This is NOT a permit, you may not commence ANY work until the permit is issued.
If you are in a Historic District you may be subject to additional permitting and fees with the Planning Department on the 4th floor of City Hall

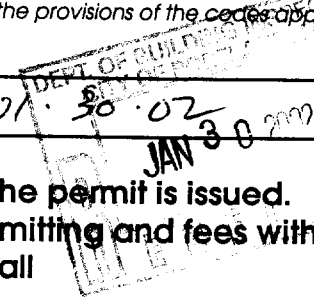

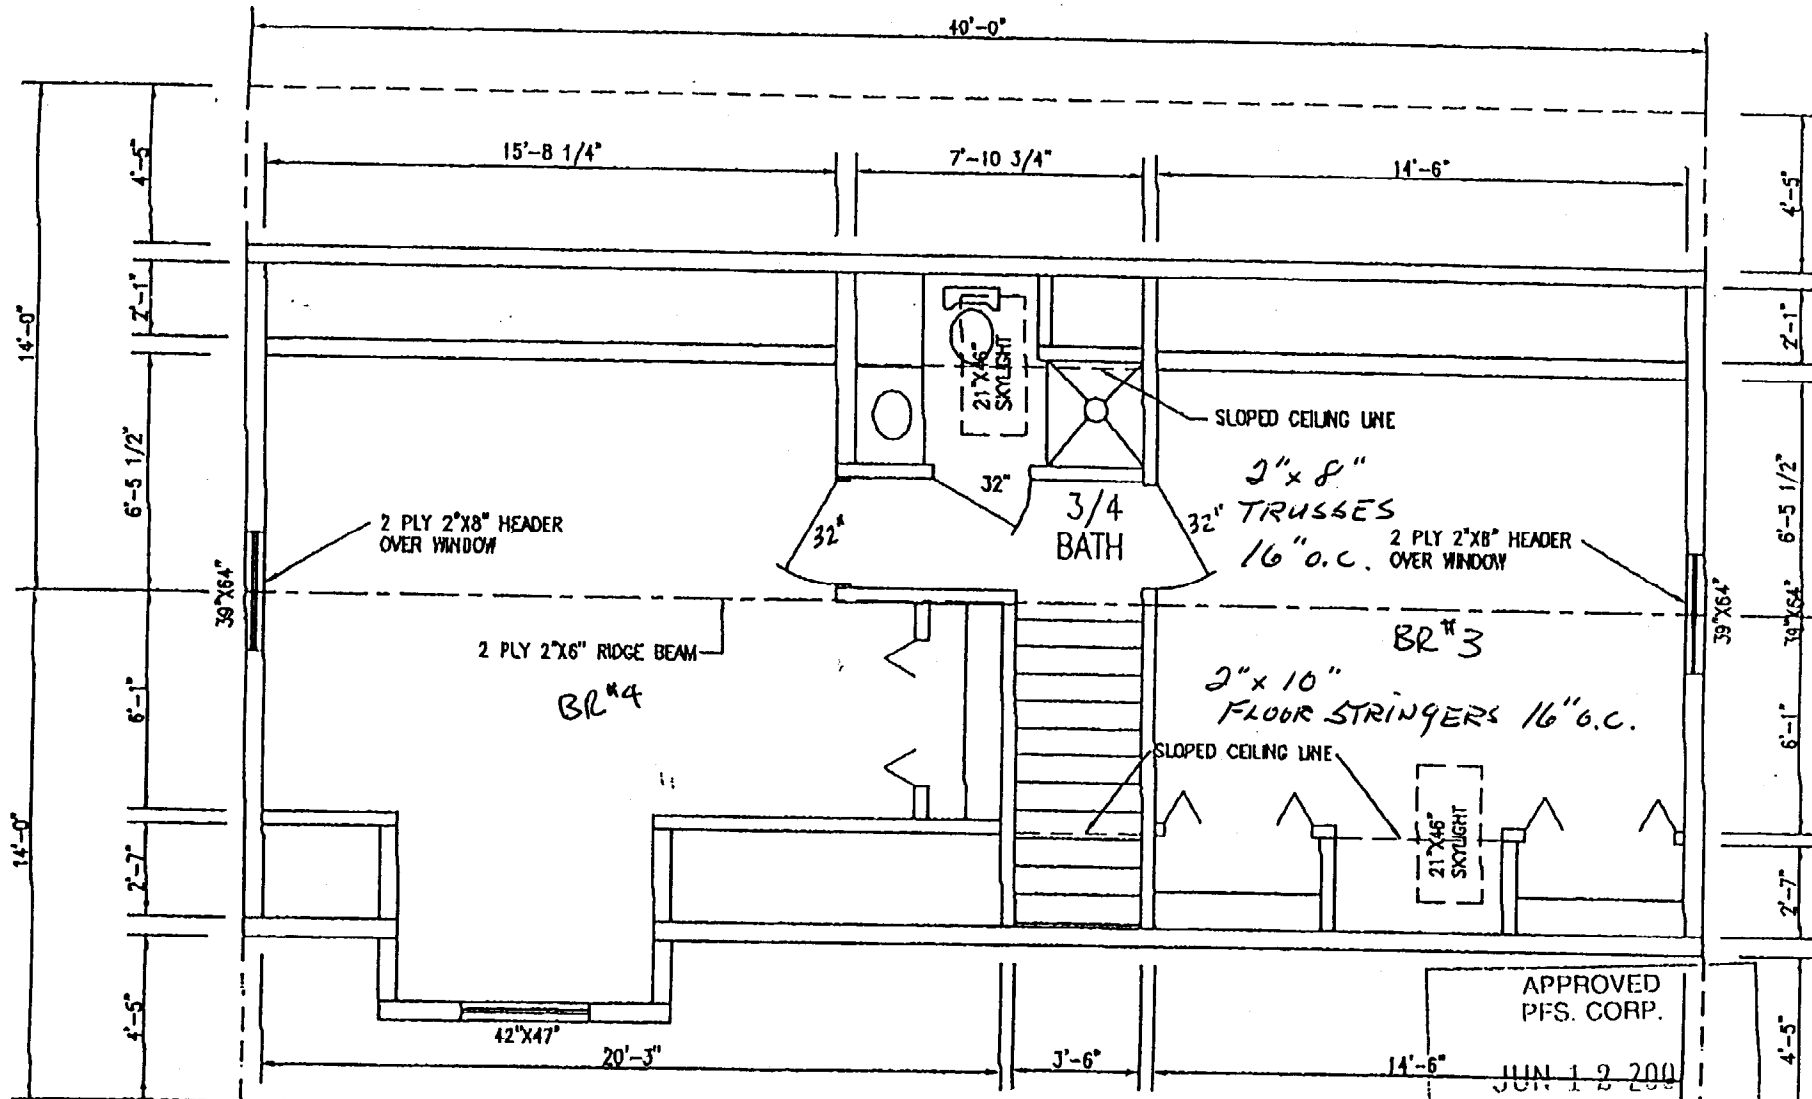

APPROVED
PFS. CORP.
JUN 12 2001
APPROVAL LIMITED TO
FACTORY BUILT PORTION

 MAPLE LEAF HOMES INC. FREDERICTON, N.B.	TITLE: SECOND FLOOR PLAN PLAN # MS5700		
	DRN. BY: (ALB)	DATE: JUNE 4 2001	CUSTOMER: STOCK
	CHK'D BY: O. BRYANT	DWG # MS5700	SCALE: N.T.S. SHEET 5 OF 6

BUILDING PERMIT INSPECTION PROCEDURES

Please call 874-8703 or 874-8693 to schedule your inspections as agreed upon

Permits expire in 6 months, if the project is not started or ceases for 6 months.

The Owner or their designee is required to notify the inspections office for the following inspections and provide adequate notice. Notice must be called in 48-72 hours in advance in order to schedule an inspection:

By initializing at each inspection time, you are agreeing that you understand the inspection procedure and additional fees from a "Stop Work Order" and "Stop Work Order Release" will be incurred if the procedure is not followed as stated below.

Pre-construction Meeting: Must be scheduled with your inspection team upon receipt of this permit. Jay Reynolds, Development Review Coordinator at 874-8632 must also be contacted at this time, before any site work begins on any project other than single family additions or alterations.

N/A **Footing/Building Location Inspection:** Prior to pouring concrete

N/A **Re-Bar Schedule Inspection:** Prior to pouring concrete

N/A **Foundation Inspection:** Prior to placing ANY backfill


 Framing/Rough Plumbing/Electrical: Prior to any insulating or drywalling


 Final/Certificate of Occupancy: Prior to any occupancy of the structure or use. NOTE: There is a \$75.00 fee per inspection at this point.

Certificate of Occupancy is not required for certain projects. Your inspector can advise you if your project requires a Certificate of Occupancy. All projects DO require a final inspection

 If any of the inspections do not occur, the project cannot go on to the next phase, REGARDLESS OF THE NOTICE OR CIRCUMSTANCES.

 CERTIFICATE OF OCCUPANCIES MUST BE ISSUED AND PAID FOR, BEFORE THE SPACE MAY BE OCCUPIED

 2-01-02
Signature of applicant/designee Date

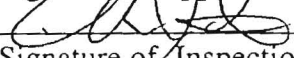 _____
Signature of Inspections Official Date

CBL: 336-4-8 Building Permit #: 020070