

Label Zone Along Rear St
2 St. Trees
Curb Cut Location
Reverse Pitch

CITY OF PORTLAND, MAINE
DEVELOPMENT REVIEW APPLICATION
PLANNING DEPARTMENT PROCESSING FORM
DRC Copy

2005-0236
Application I. D. Number
10/12/2005
Application Date
Ruby Lane #14
Project Name/Description

D.A. Brackett
Applicant
84 Country Lane, Portland, ME 04103
Applicant's Mailing Address

Jay Reynolds

RECEIVED OCT 18 2005

Set Letter
11-9

Dak Ridge

Consultant/Agent
Applicant Ph: (207) 772-8629 Agent Fax:
Applicant or Agent Daytime Telephone, Fax

65 - 65 Ruby Ln, Portland, Maine
Address of Proposed Site
342 B032001
Assessor's Reference: Chart-Block-Lot

Proposed Development (check all that apply): New Building Building Addition Change Of Use Residential Office Retail
 Manufacturing Warehouse/Distribution Parking Lot Other (specify) _____

1536 11730
Proposed Building square Feet or # of Units Acreage of Site Zoning

Check Review Required:

- Site Plan (major/minor)
- Subdivision # of lots _____
- PAD Review
- 14-403 Streets Review
- Flood Hazard
- Shoreland
- Historic Preservation
- DEP Local Certification
- Zoning Conditional Use (ZBA/PB)
- Zoning Variance
- Other _____

Fees Paid: Site Pla \$50.00 Subdivision _____ Engineer Review \$250.00 Date 10/12/2005

DRC Approval Status:

Approved Approved w/Conditions See Attached Denied
Reviewer Jay Reynolds
Approval Date 11-16-05 Approval Expiration _____ Extension to _____ Additional Sheets Attached
 Condition Compliance Jay Reynolds signature 11-16-05 date

Performance Guarantee Required* Not Required

* No building permit may be issued until a performance guarantee has been submitted as indicated below

- Performance Guarantee Accepted _____ date _____ amount _____ expiration date
- Inspection Fee Paid _____ date _____ amount _____
- Building Permit Issue _____ date _____
- Performance Guarantee Reduced _____ date _____ remaining balance _____ signature _____
- Temporary Certificate of Occupancy _____ date Conditions (See Attached) _____ expiration date
- Final Inspection _____ date _____ signature _____
- Certificate Of Occupancy _____ date _____
- Performance Guarantee Released _____ date _____ signature _____
- Defect Guarantee Submitted _____ submitted date _____ amount _____ expiration date
- Defect Guarantee Released _____ date _____ signature _____



Fax # 772-8629

PORTLAND MAINE

Strengthening a Remarkable City, Building a Community for Life [®] www.portlandmaine.gov

Planning and Development Department
Lee D. Urban, Director

Planning Division
Alexander Jaegerman, Director

Mr. Dwight Brackett
84 Country Lane
Portland, ME 04103

November 9, 2005

Dear Mr. Brackett:

RE: Application for Single Family Residences, Ruby Lane lots #13 and lot #14

Upon review of the site plans, the City's Planning Division has the following comments:

Lot # 13:

1. Street tree shown over the utilities needs to be moved.
2. The topography and spot grades indicate that the rear yard will be pitched towards the building. Please correct.
3. Please label the no-cut/undisturb zone along the rear property line.
4. The curb cut on your plan does not match the curb cut location on the approved subdivision plans. Please clarify.

Lot #14:


1. Please add two street trees to your plan.
2. Same items listed above (2., 3., and 4.).

Please resubmit 4 copies of the site plan to my attention:

Sincerely,


Jay Reynolds
Development Review Coordinator

cc: Sarah Hopkins, Development Review Services Manager

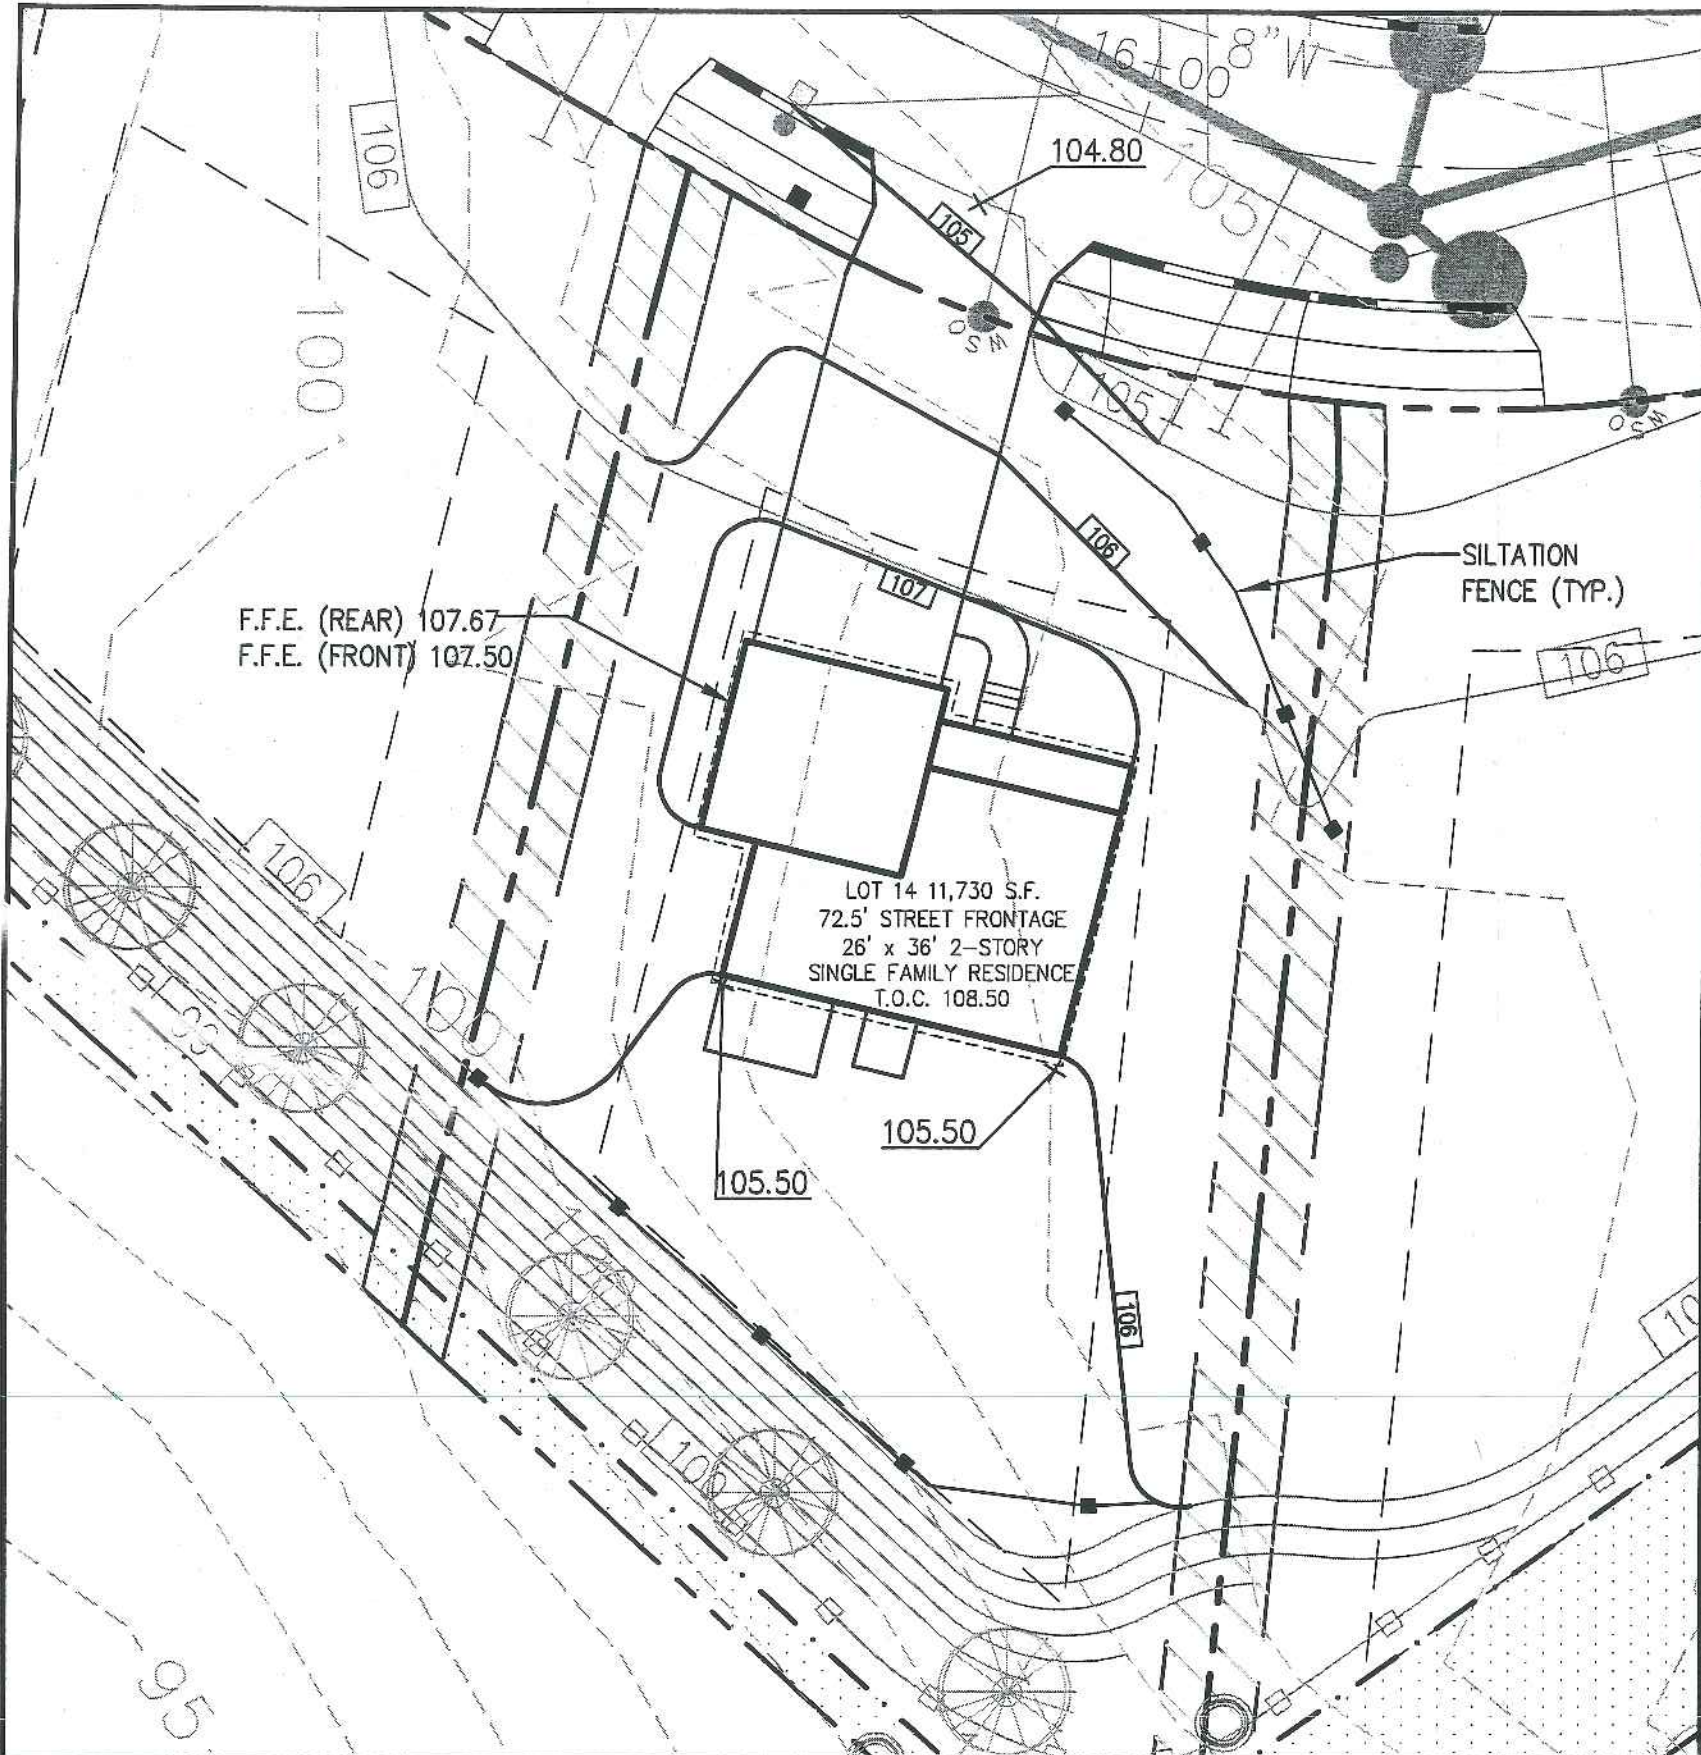

ZONING REGULATIONS

ZONE:	R-3
MINIMUM LOT SIZE:	6,500 S.F.
MINIMUM LOT WIDTH:	75 FEET
MINIMUM STREET FRONTAGE:	50 FEET
MINIMUM FRONT YARD SETBACK:	25 FEET OR AT MIN. 75' LOT WIDTH
MINIMUM REAR YARD SETBACK:	25 FEET
MINIMUM SIDE YARD SETBACK:	16 FEET (FOR 2½ STORY DWELLING) 8 FEET (FOR 1½ STORY DWELLING)

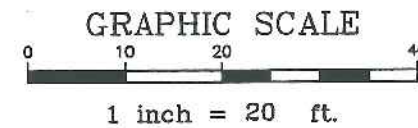

Rev 10-18

PREPARED 10.06.05

DH
DeLuca-Hoffman Associates, Inc.
778 MAIN STREET, SUITE 8
SOUTH PORTLAND, ME 04106
207.775.1121
WWW.DELUCAHOFFMAN.COM


DRAWN:	CDD	DATE:	MAR. 2005
DESIGNED:	DDA	SCALE:	1" = 20'
CHECKED:	DDA	JOB NO.:	2568
FILE NAME:	2568-SP		

RUBY LANE
PORTLAND, MAINE

LOT 14 GRADING & EROSION
CONTROL PLAN


FIGURE

14-B

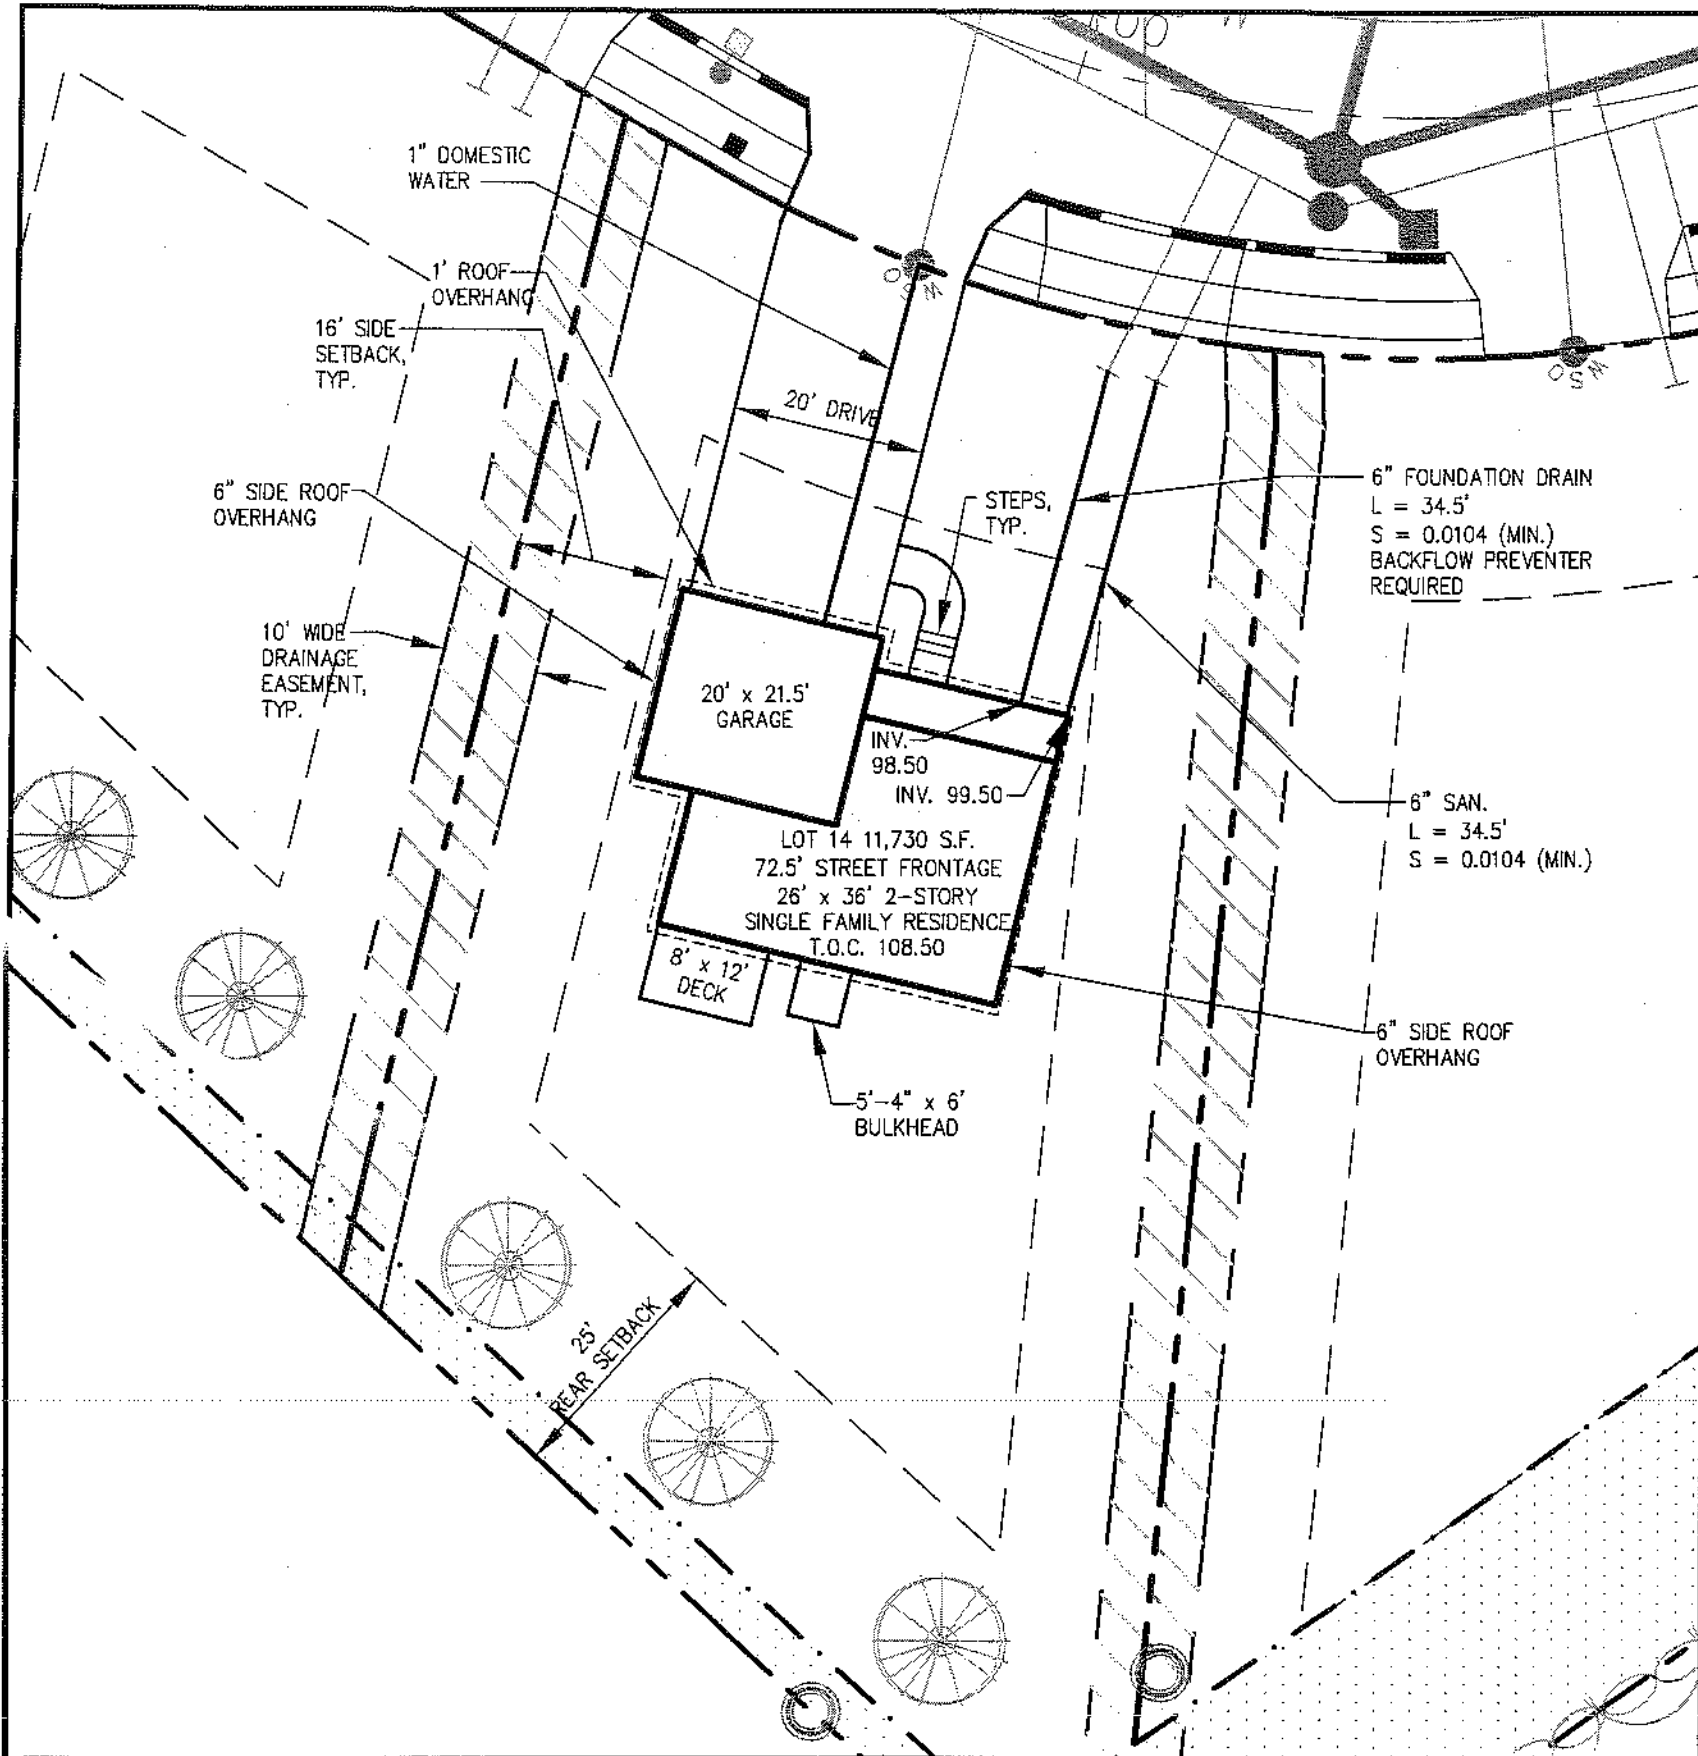

ZONING REGULATIONS

ZONE:	R-3
MINIMUM LOT SIZE:	6,500 S.F.
MINIMUM LOT WIDTH:	75 FEET
MINIMUM STREET FRONTAGE:	50 FEET
MINIMUM FRONT YARD SETBACK:	25 FEET OR AT MIN. 75' LOT WIDTH
MINIMUM REAR YARD SETBACK:	25 FEET
MINIMUM SIDE YARD SETBACK:	16 FEET (FOR 2½ STORY DWELLING) 8 FEET (FOR 1½ STORY DWELLING)

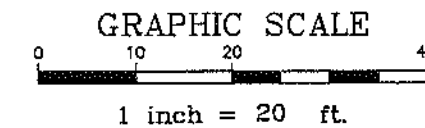

PREPARED 10.06.05


DH
DeLuca-Hoffman Associates, Inc.
778 MAIN STREET, SUITE 8
SOUTH PORTLAND, ME 04106
207.775.1121
WWW.DELUCAHOFFMAN.COM

DRAWN:	SMW	DATE:	MAR. 2005
DESIGNED:	DDA	SCALE:	1" = 20'
CHECKED:	DDA	JOB NO.	2568
FILE NAME:	2568-SP		

RUBY LANE
PORTLAND, MAINE


LOT 14 LAYOUT & UTILITIES PLAN

FIGURE
14-A

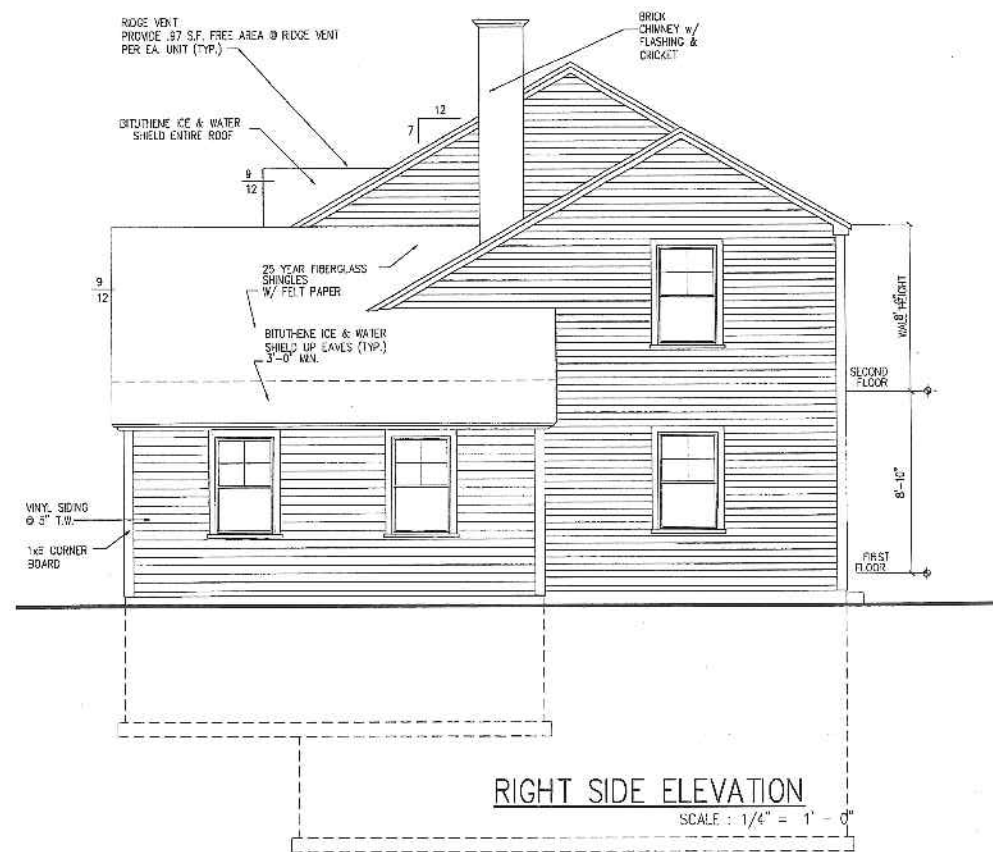


RIGHT SIDE ELEVATION

SCALE : 1/4" = 1' - 0"

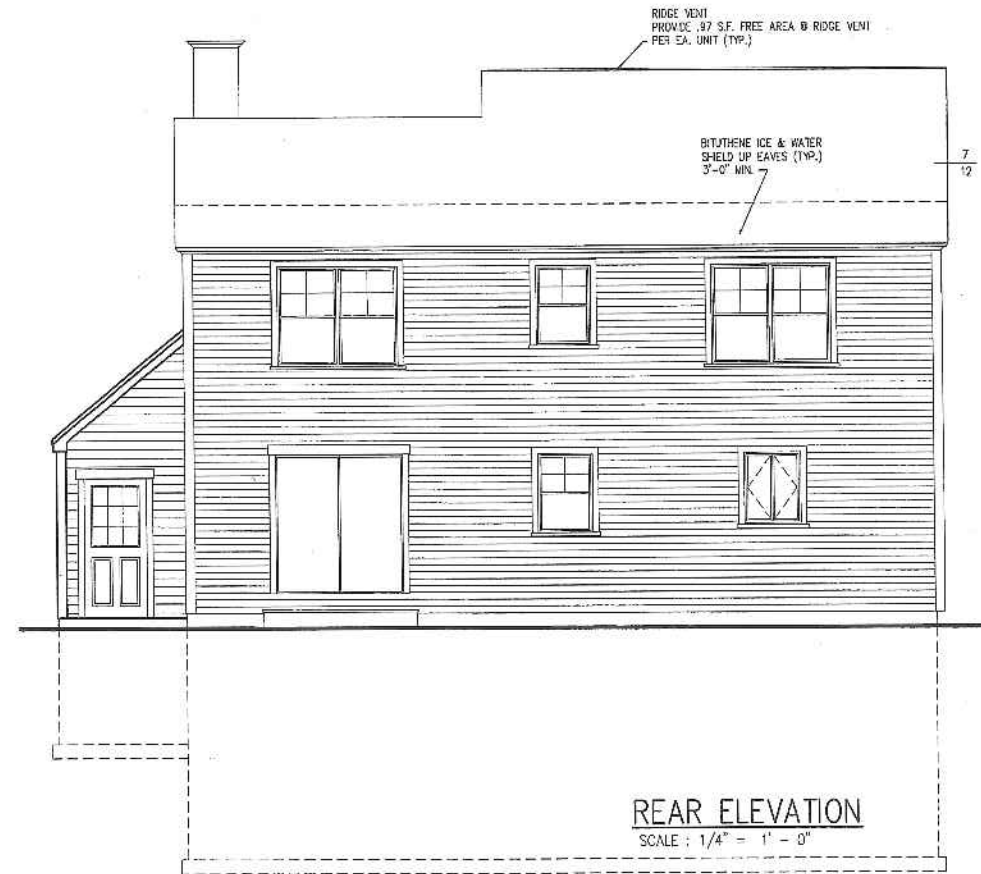

REAR ELEVATION

SCALE : 1/4" = 1' - 0"

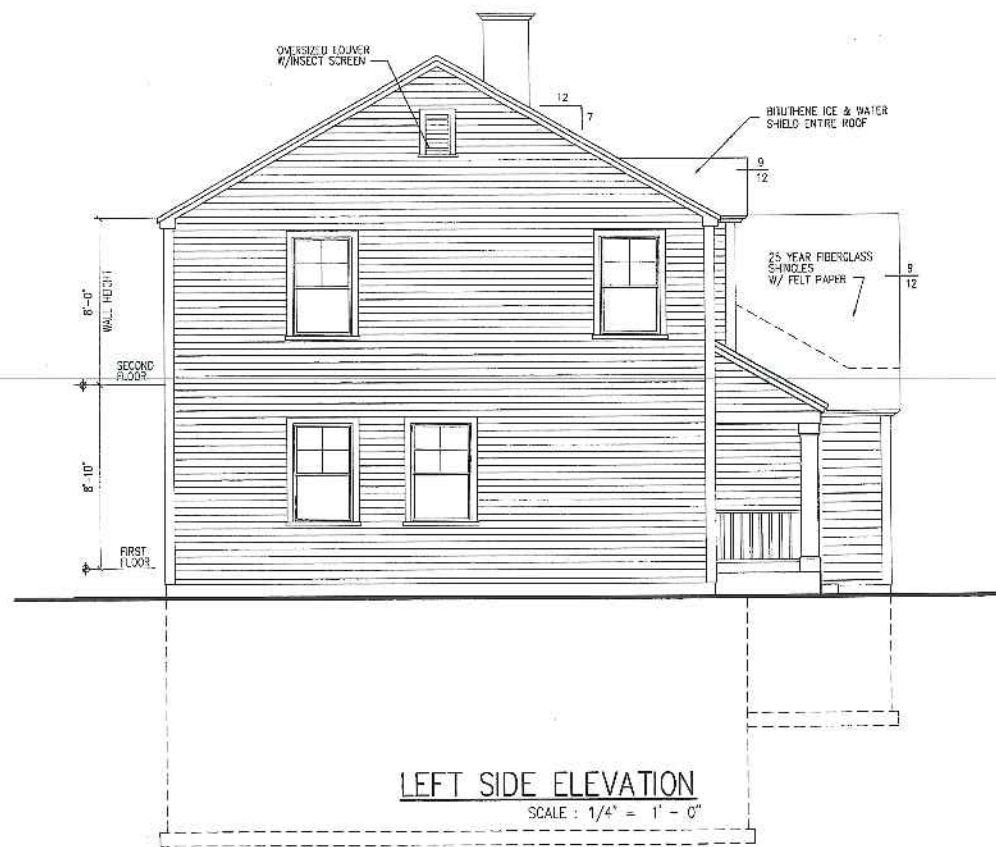

LEFT SIDE ELEVATION

SCALE : 1/4" = 1' - 0"



FRONT ELEVATION

SCALE : 1/4" = 1' - 0"

DRAWINGS THIS SHEET

ELEVATIONS

DATE
10/04/05

205 #14

A3

GENERAL NOTES:

- All work shall be in accordance with BOCA State Building Code, NFPA-10 National Electric Code, Value State Plumbing Code, ASHRAE, U.L., NFPA Codes, Americans with Disabilities Act 1990 (ADA) and all local, State and Federal requirements.
- All applicable Federal, State and Municipal regulations shall be followed, including the Federal Department of Labor Occupational Safety and Health act.
- All required City and State permits must be obtained before any construction begins.
- It is the contractor's sole responsibility to determine erection, structures and sequence to ensure the safety of the building and its components during erection. This includes the addition of necessary shoring, bracing, temporary bracing, guys or tie-downs. Such materials shall remain the property of the contractor after completion of the project.
- Structural, Mechanical, Electrical and Plumbing design and installation by others shall be performed in accordance with local, State and Federal standards.
- All fire ratings indicated shall be continuous to underside of fire rated ceiling or underside of roof deck. See all openings & mechanical penetrations with approved fire rating material.
- Building shall be sprinkled in accordance with NFPA-13. Contractor shall submit plans for State Fire Marshal approval prior to construction in accordance to state law.
- Building shall have approved smoke detectors in accordance with NFPA-101 Life Safety Code. Smoke detectors shall initiate alarm that is audible in the sleeping rooms of each unit.
- Portable fire extinguishers shall be provided in all hazardous areas in accordance with NFPA-101, Local authority having jurisdiction needs to provide written requirements.
- Balconies must maintain a 42" eave height and shall be kept free and clear of ice and snow at all times to ensure the second means of egress.
- HVAC installation to be in accordance with ASHRAE, NFPA-90A, OR NFPA-90B out of local and State codes. Ventilation of Fuel equipment shall be in accordance with NFPA-91, NFPA-211, NFPA-213, NFPA-24 and NFPA-70 as applicable.

FOUNDATION NOTES:


- PROVIDE SILL SEALER ON TOP OF ALL FOUNDATION WALLS.
- FOUNDATION WALLS SHALL BE BACKFILLED SIMULTANEOUSLY ON BOTH SIDES.
- ALL STEEL REINFORCING IN FOOTINGS TO BE A MINIMUM 3" CLEAR FROM BOTTOM OF FOOTING.
- ALL STEEL REINFORCING IN FOUNDATION WALLS BELOW GRADE TO BE MINIMUM OF 2" CLEAR FROM FACE OF WALL.
- ALL WOOD IN CONTACT WITH CONCRETE SHALL BE PRESURE PRESERVATIVE TREATED W/CCA TO 0.4% OF RETENTION FOR ANPA.
- ALL CONCRETE SURFACES SHALL HAVE A STEEL BROWEL & 1/8" BROOM FINISH.
- SET BOTTOM OF FOOTINGS MIN. 4'-0" BELOW GRADE.
- SET ALL FOOTINGS ON UNDISTURBED SOIL OR COMPACTED STRUCTURAL FILL.
- RADIANT HEAT IN SLAB.
- FIRST FLOOR SLAB SHALL BE 4" THICK CONCRETE SLAB ON GRADE W/ FIBER MESH REINFORCEMENT, PROVIDE CONTROL JOINTS @ 15x15' SPACING (2255F).
- ALL CONCRETE SHALL BE 3000 PSI (f'_c) STRENGTH AT 28 DAYS.
- ALL CONCRETE SHALL BE AIR ENTRAINED 4-8%.
- ALL OTHER ADJUSTURES SHALL BE PRE-APPROVED.
- WATERPROOFING / DAMP PROOFING ASPHALT TAR.
- PROVIDE FILTER FABRIC OVER STONE.

FRAMING NOTES:

- ALL EXTERIOR WALLS TO BE 2x6 WOOD STUD WALLS @ 24" O.C. W/ 1/2" C.W.S. AND VAPOR BARRIER @ INSIDE FACE OF WALL, 6" BATT INSULATION (R-19), AND 7/16" APA RATED SHEATHING @ EXTERIOR FACE OF WALL.
- ALL INTERIOR WALLS TO BE 2x4 WOOD STUD WALLS (UNLESS NOTED OTHERWISE) W/ ONE LAYER 1/2" G.M.B. LATH & SCRE.
- INSTALL BLOCKING BEHIND ALL SURFACE APPLIED FIXTURES, TRAY, AND SHELVES WHEN MOUNTED ON WALLS.
- THE LOCATION OF ALL DOOR FRAMES SHALL BE 4 1/2" (UNLESS NOTED OTHERWISE) FROM ADJACENT WALLS.


ROUGH OPENING	HEADER SIZE
0 - 3'-0"	(3) - 2x6
3'-1" - 4'-6"	(3) - 2x6
4'-7" - 5'-6"	(3) - 2x10
5'-7" - 7'-0"	(3) - 2x12

NOTE: PROVIDE JAMBS BOTH ENDS AS FOLLOWS:
 2x6 JACK PLUS 2x6 KING UP TO 4'-6" ROUGH OPENING
 (2) 2x6 JACKS PLUS (2) 2x6 KINGS UP TO 7'-0" ROUGH OPENING

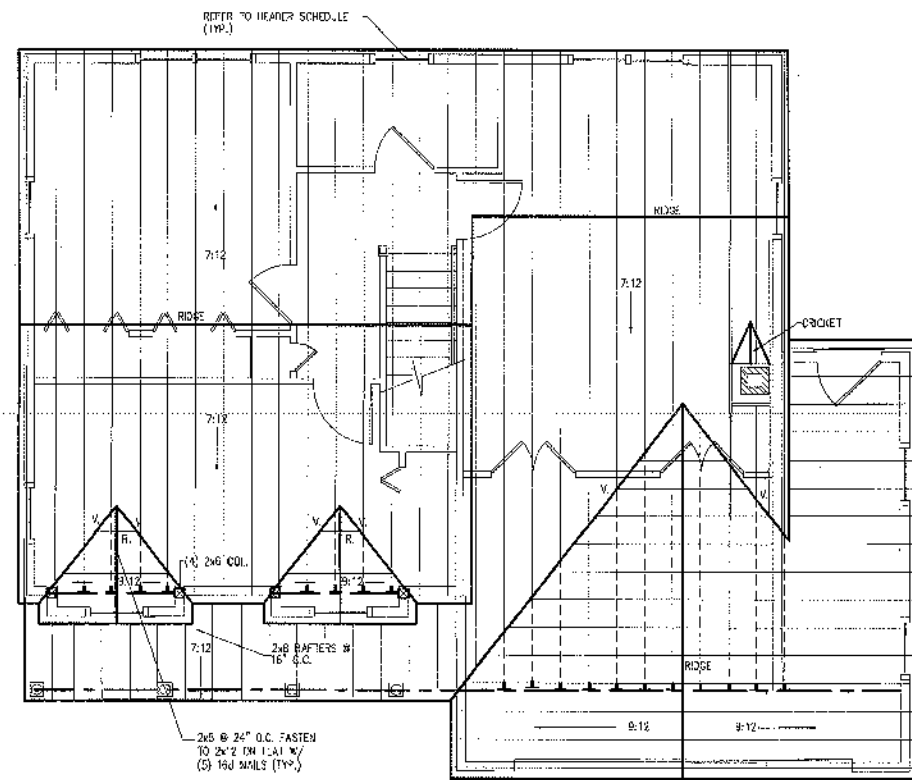


ROOF FRAMING PLAN


SCALE: 1/4" = 1' - 0"

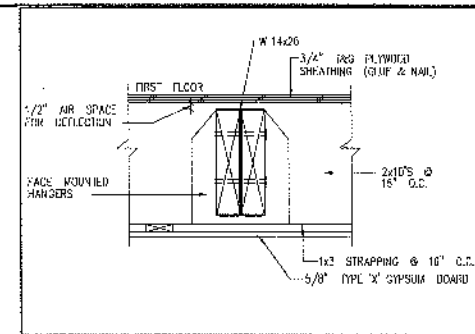


BEAM / JOIST CONNECTION

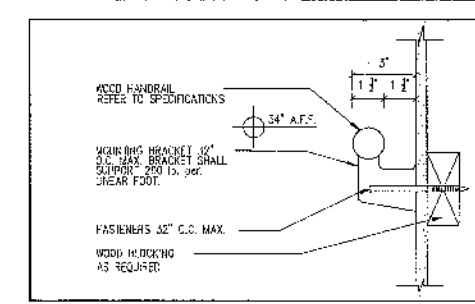

HANDRAIL DETAIL

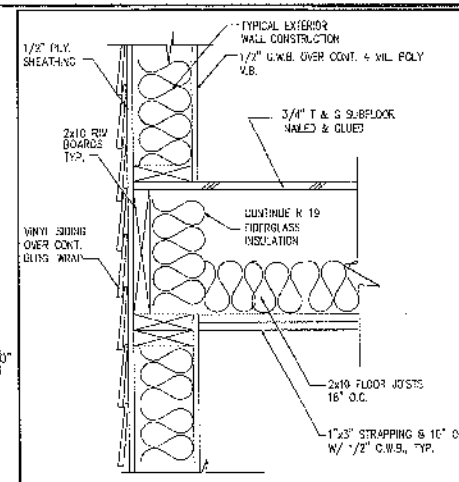


FLOOR FRAMING DETAIL

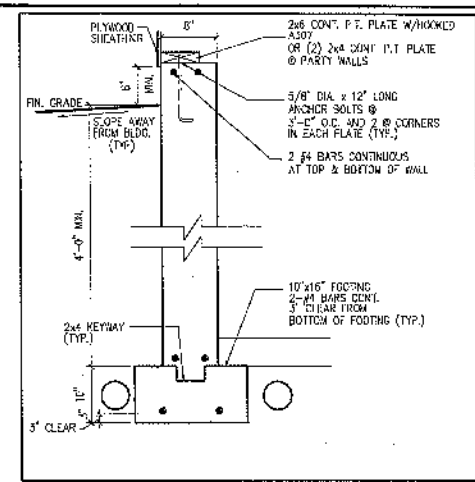

TYPICAL FOUNDATION WALL

SCALE: 1" = 1'-0"

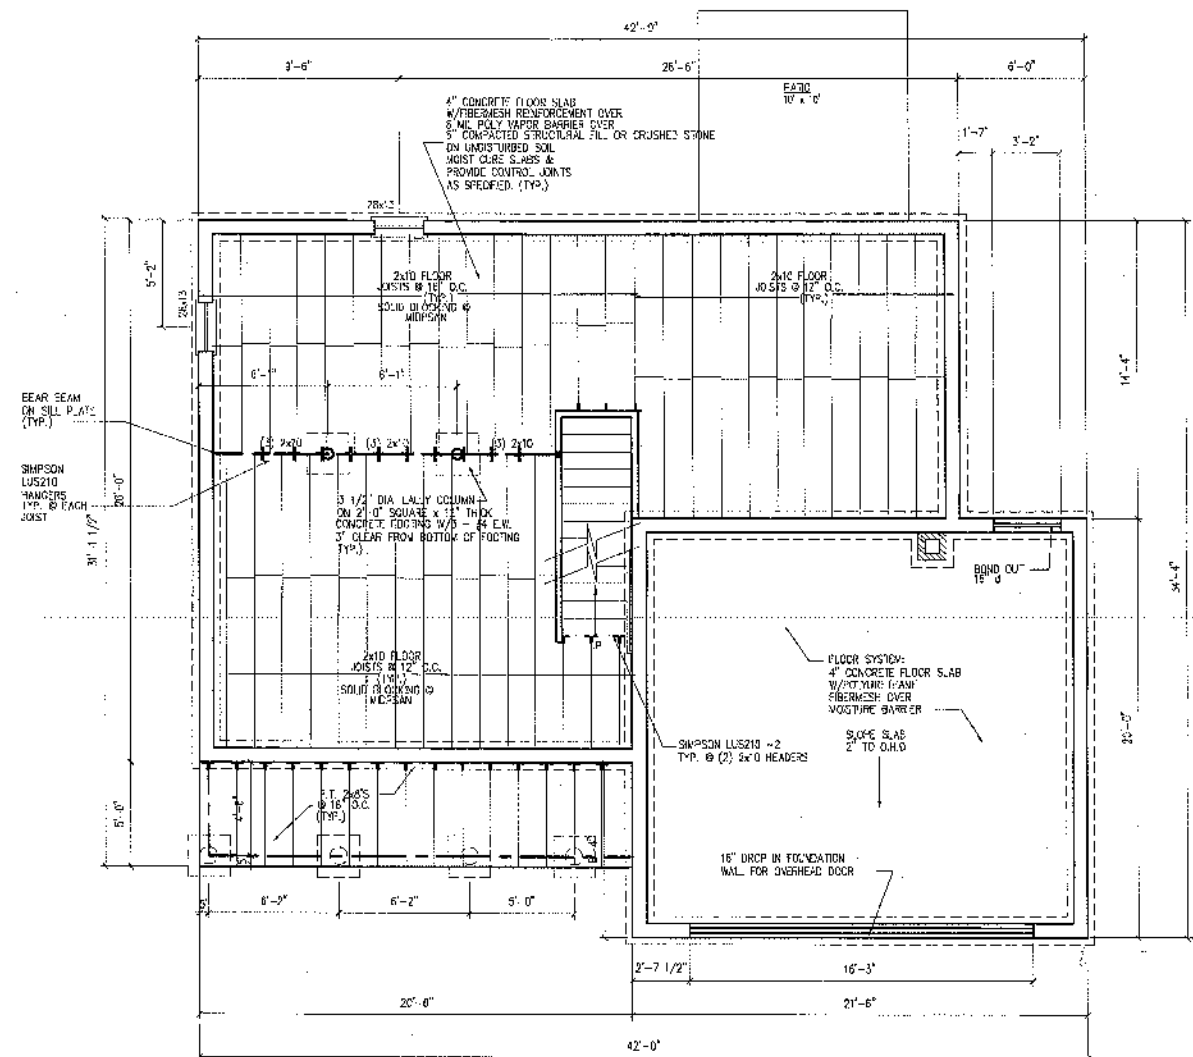


FOUNDATION PLAN

SCALE: 1/4" = 1' - 0"

DRAWINGS THIS SHEET
FOUNDATION PLAN
ROOF PLAN
NOTES

DATE
 10/04/08


A1

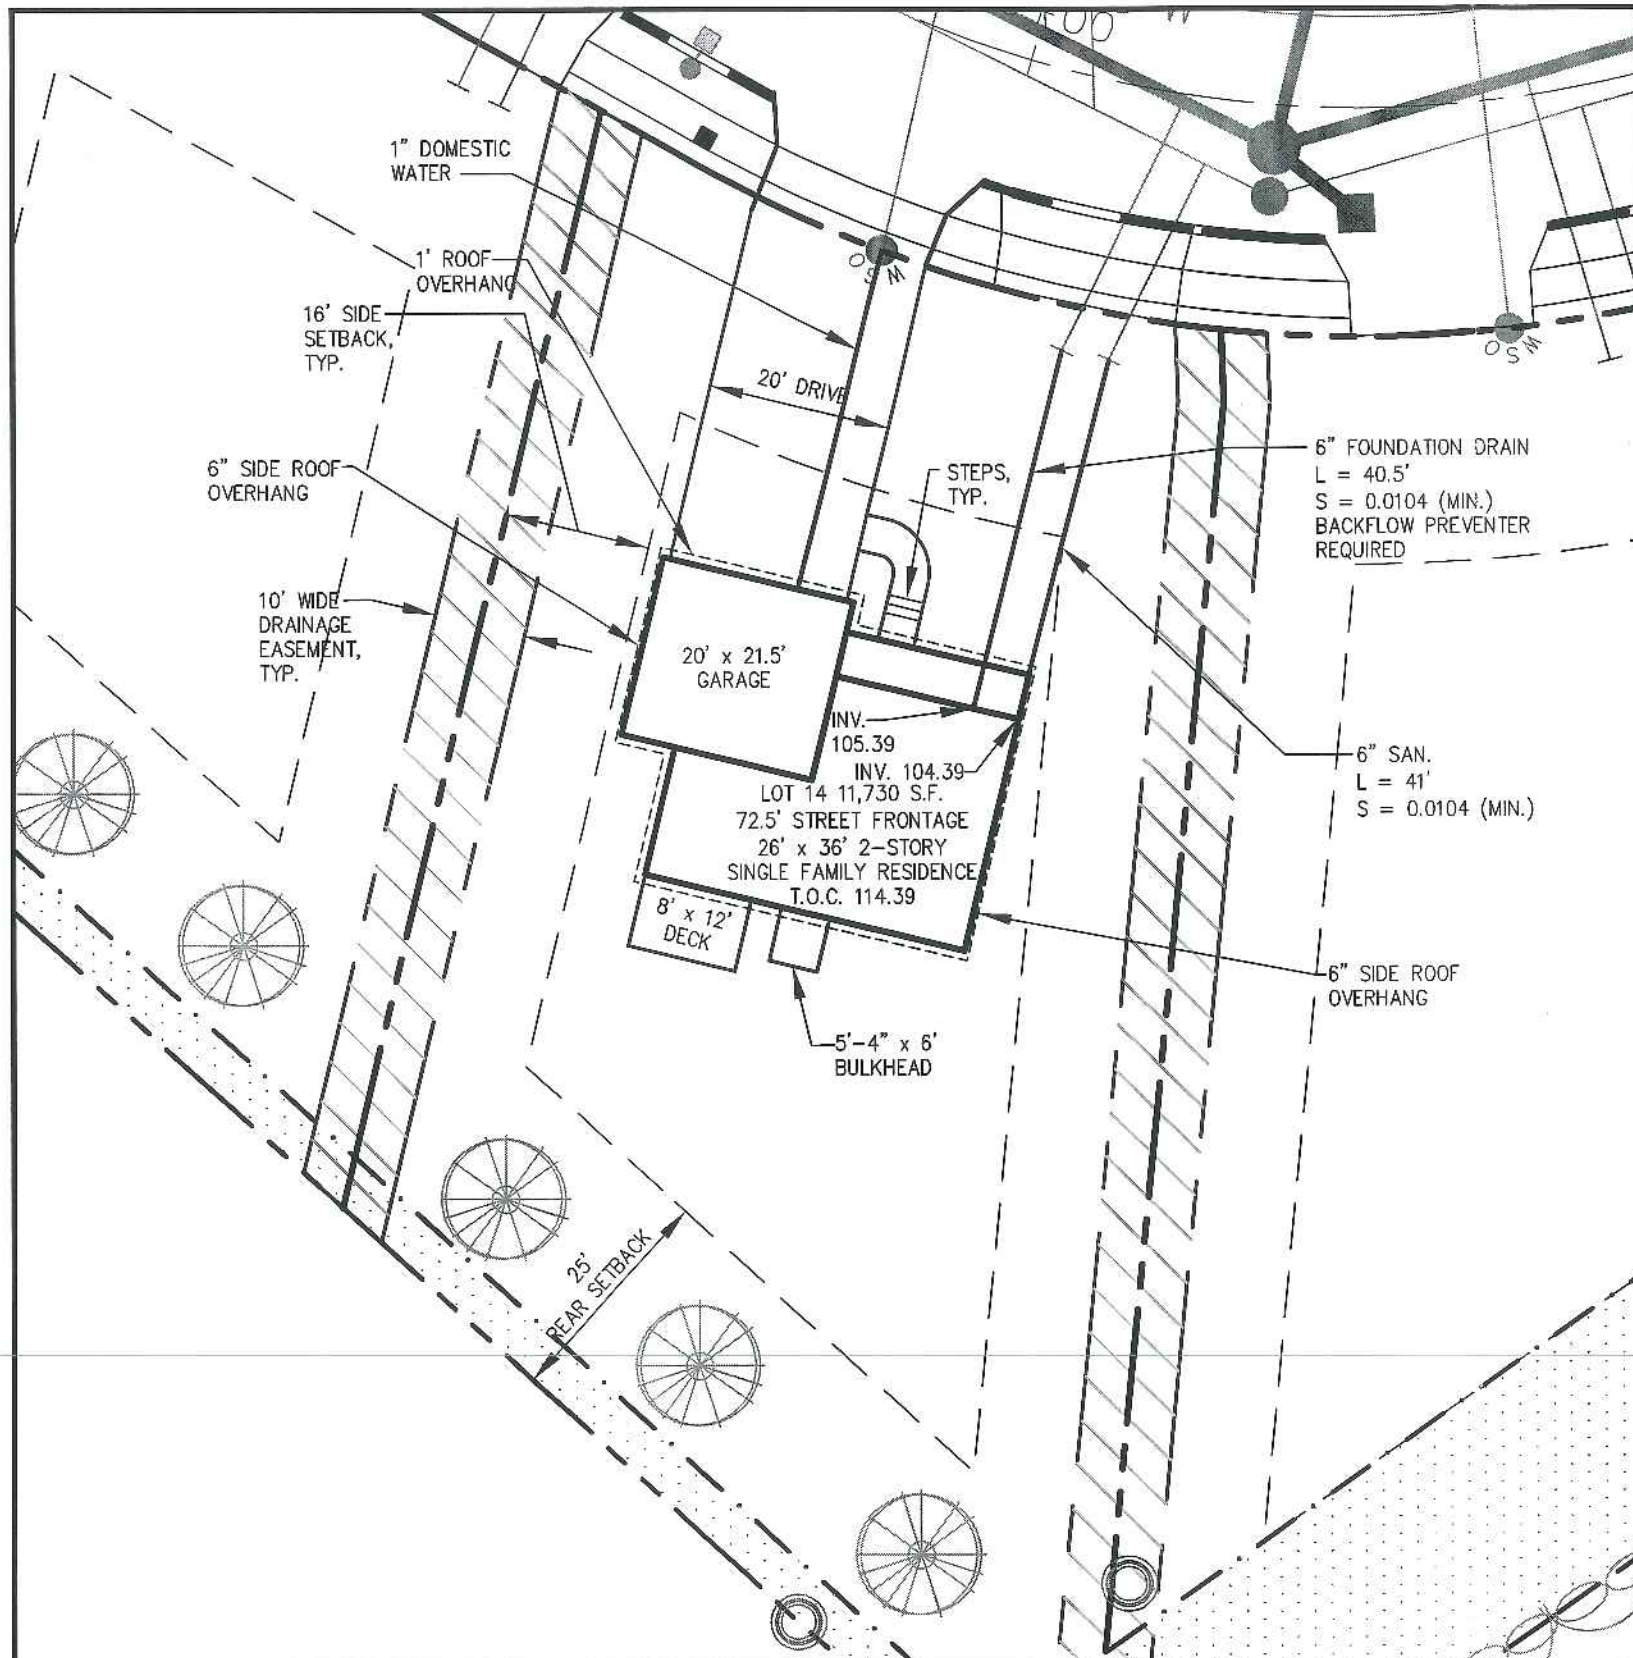

RECEIVED NOV 7 2005

ZONING REGULATIONS

ZONE:	R-3
MINIMUM LOT SIZE:	6,500 S.F.
MINIMUM LOT WIDTH:	75 FEET
MINIMUM STREET FRONTAGE:	50 FEET
MINIMUM FRONT YARD SETBACK:	25 FEET OR AT MIN. 75' LOT WIDTH
MINIMUM REAR YARD SETBACK:	25 FEET
MINIMUM SIDE YARD SETBACK:	16 FEET (FOR 2½ STORY DWELLING) 8 FEET (FOR 1½ STORY DWELLING)

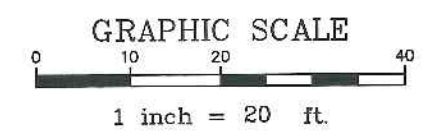

REVISED 11.02.05


DH DeLuca-Hoffman Associates, Inc.
778 MAIN STREET, SUITE 8
SOUTH PORTLAND, ME 04106
207.775.1121
WWW.DELUCAHOFFMAN.COM

DRAWN:	SMW	DATE:	MAR. 2005
DESIGNED:	DDA	SCALE:	1" = 20'
CHECKED:	DDA	JOB NO.	2459.02
FILE NAME:	245902-LOTS		

RUBY LANE
PORTLAND, MAINE


LOT 14 LAYOUT & UTILITIES PLAN

FIGURE
14-A

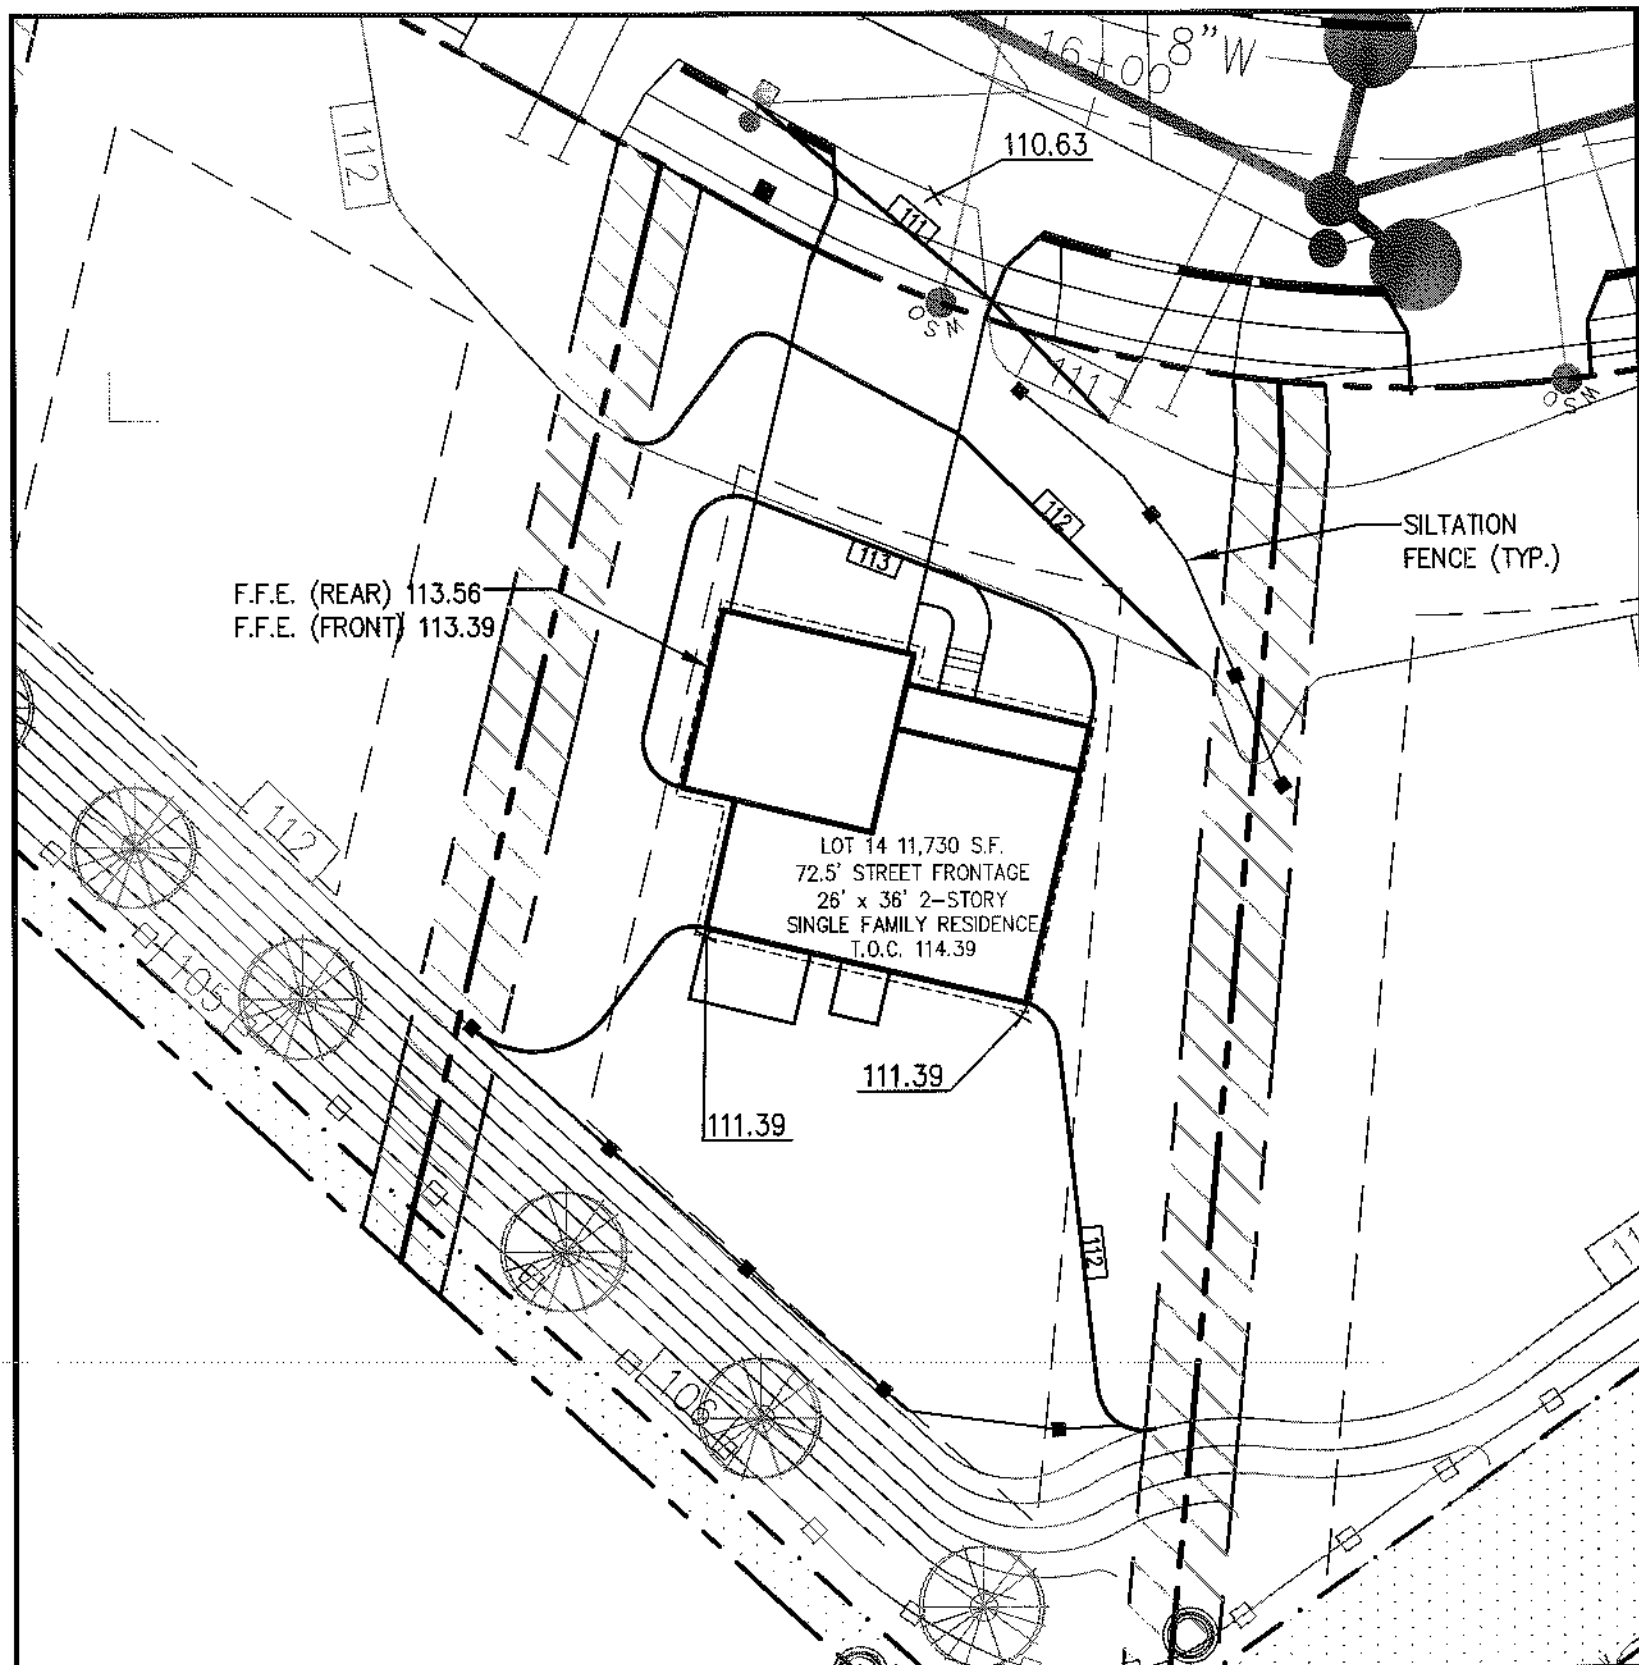

ZONING REGULATIONS

ZONE:	R-3
MINIMUM LOT SIZE:	6,500 S.F.
MINIMUM LOT WIDTH:	75 FEET
MINIMUM STREET FRONTAGE:	50 FEET
MINIMUM FRONT YARD SETBACK:	25 FEET OR AT MIN. 75' LOT WIDTH
MINIMUM REAR YARD SETBACK:	25 FEET
MINIMUM SIDE YARD SETBACK:	16 FEET (FOR 2½ STORY DWELLING) 8 FEET (FOR 1½ STORY DWELLING)

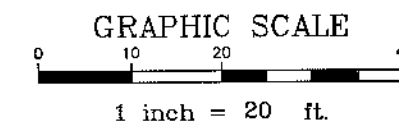

REVISED 11.02.05




DeLuca-Hoffman Associates, Inc.
778 MAIN STREET, SUITE 8
SOUTH PORTLAND, ME 04106
207.775.1121
WWW.DELUCAHOFFMAN.COM

DRAWN:	CDD	DATE:	MAR. 2005
DESIGNED:	DDA	SCALE:	1" = 20'
CHECKED:	DDA	JOB NO.:	2459.02
FILE NAME:	245902-LOTS		

RUBY LANE
PORTLAND, MAINE

LOT 14 GRADING & EROSION
CONTROL PLAN

FIGURE
14-B

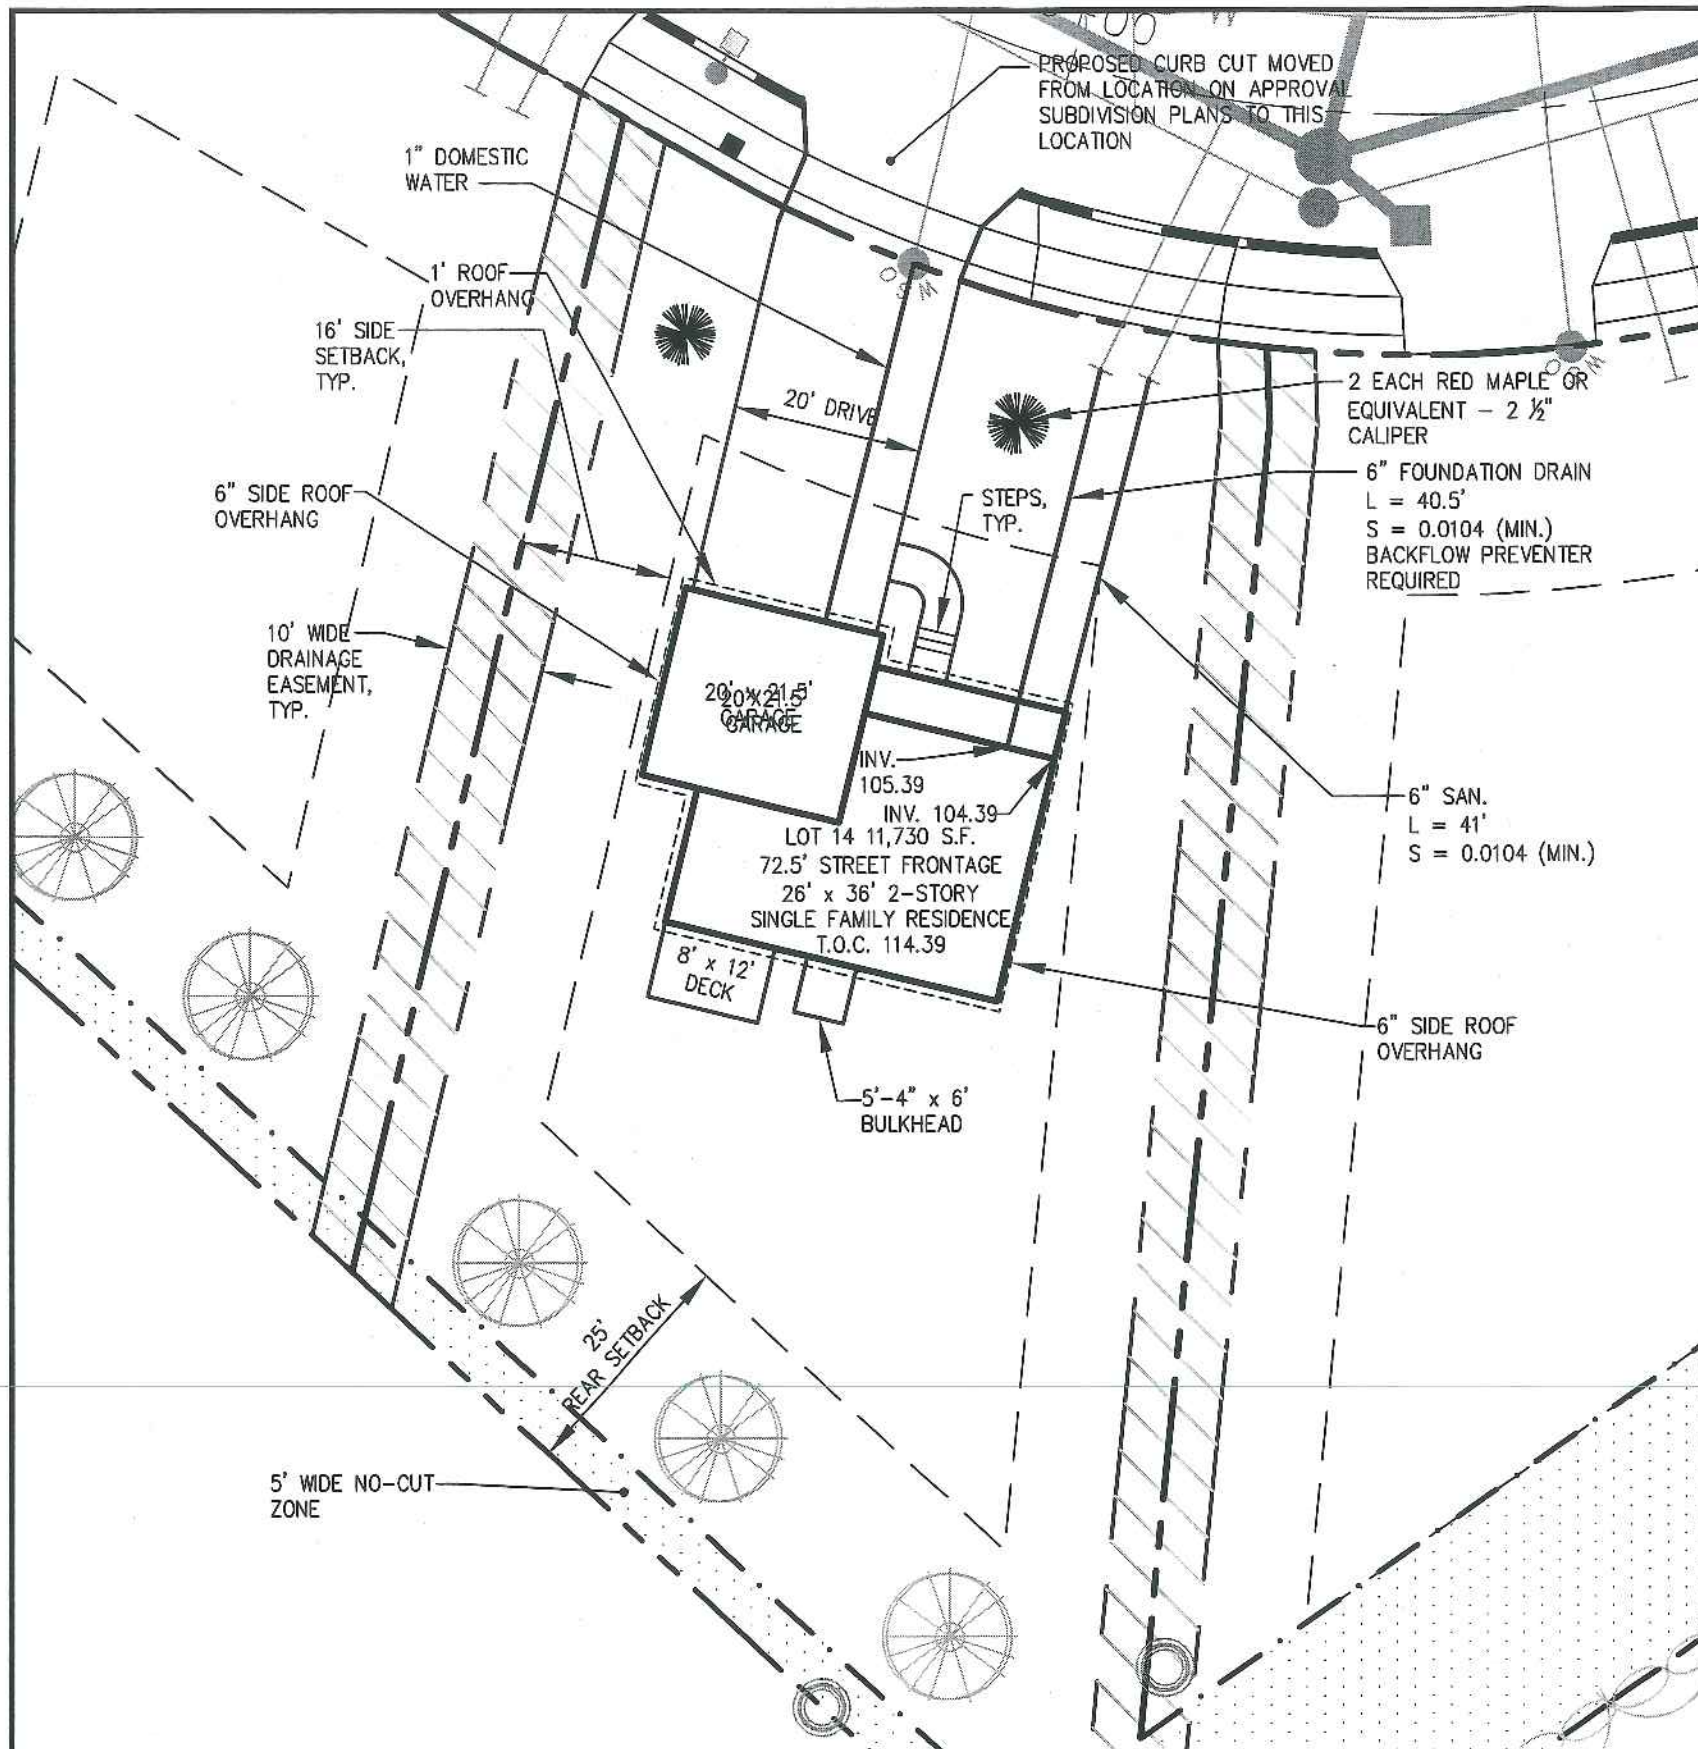


RECEIVED NOV 15 2005

**CITY OF PORTLAND
APPROVED SITE PLAN**
Subject to Dept. Conditions
Date of Approval: 11-16-05

ZONING REGULATIONS

ZONE:	R-3
MINIMUM LOT SIZE:	6,500 S.F.
MINIMUM LOT WIDTH:	75 FEET
MINIMUM STREET FRONTAGE:	50 FEET
MINIMUM FRONT YARD SETBACK:	25 FEET OR AT MIN. 75' LOT WIDTH
MINIMUM REAR YARD SETBACK:	25 FEET
MINIMUM SIDE YARD SETBACK:	16 FEET (FOR 2½ STORY DWELLING) 8 FEET (FOR 1½ STORY DWELLING)

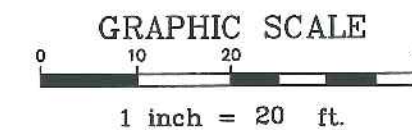

REVISED 11.10.05




DeLuca-Hoffman Associates, Inc.
778 MAIN STREET, SUITE 8
SOUTH PORTLAND, ME 04106
207.775.1121
WWW.DELUCAHOFFMAN.COM

DRAWN:	SMW	DATE:	MAR. 2005
DESIGNED:	DDA	SCALE:	1" = 20'
CHECKED:	DDA	JOB NO.	2459.02
FILE NAME:	245902-LOTS		

RUBY LANE
PORTLAND, MAINE

LOT 14 LAYOUT & UTILITIES PLAN

FIGURE
14-A

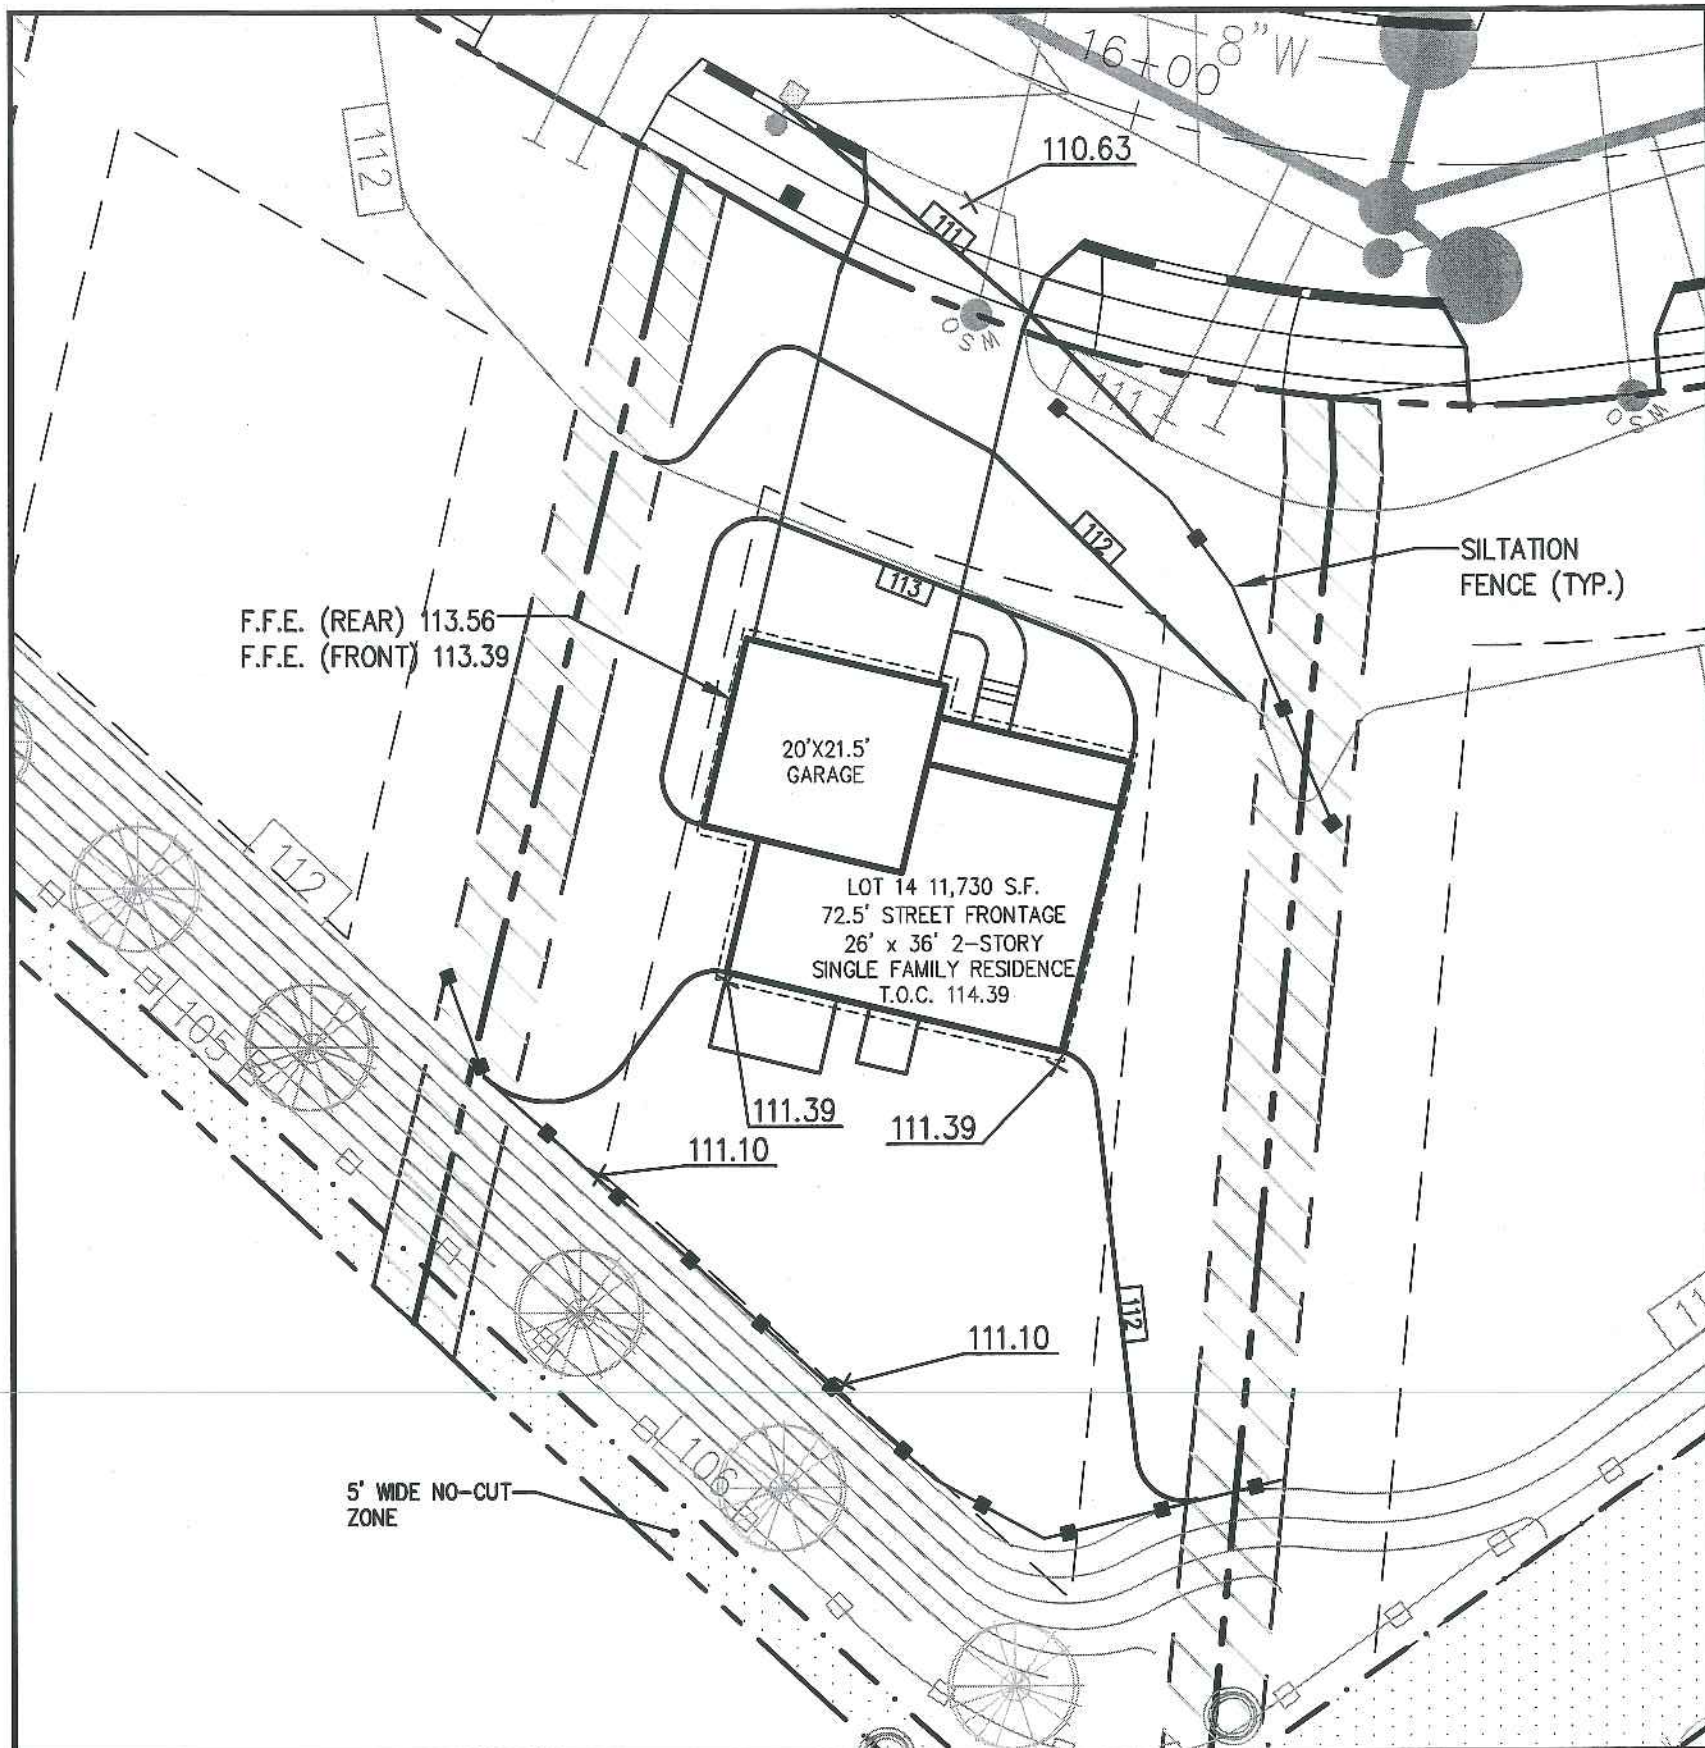


RECEIVED NOV 15 2005

ZONING REGULATIONS

ZONE:	R-3
MINIMUM LOT SIZE:	6,500 S.F.
MINIMUM LOT WIDTH:	75 FEET
MINIMUM STREET FRONTAGE:	50 FEET
MINIMUM FRONT YARD SETBACK:	25 FEET OR AT MIN. 75' LOT WIDTH
MINIMUM REAR YARD SETBACK:	25 FEET
MINIMUM SIDE YARD SETBACK:	16 FEET (FOR 2½ STORY DWELLING) 8 FEET (FOR 1½ STORY DWELLING)

**CITY OF PORTLAND
APPROVED SITE PLAN**
Subject to Dept. Conditions
Date of Approval: 11-16-05

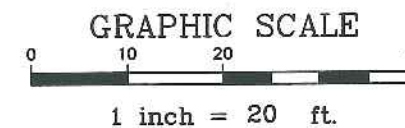

REVISED 11.10.05




DeLuca-Hoffman Associates, Inc.
778 MAIN STREET, SUITE 8
SOUTH PORTLAND, ME 04106
207.775.1121
WWW.DELUCAHOFFMAN.COM

DRAWN:	CDD	DATE:	MAR. 2005
DESIGNED:	DDA	SCALE:	1" = 20'
CHECKED:	DDA	JOB NO.:	2459.02
FILE NAME:	245902-LOTS		

RUBY LANE
PORTLAND, MAINE

LOT 14 GRADING & EROSION
CONTROL PLAN

FIGURE
14-B

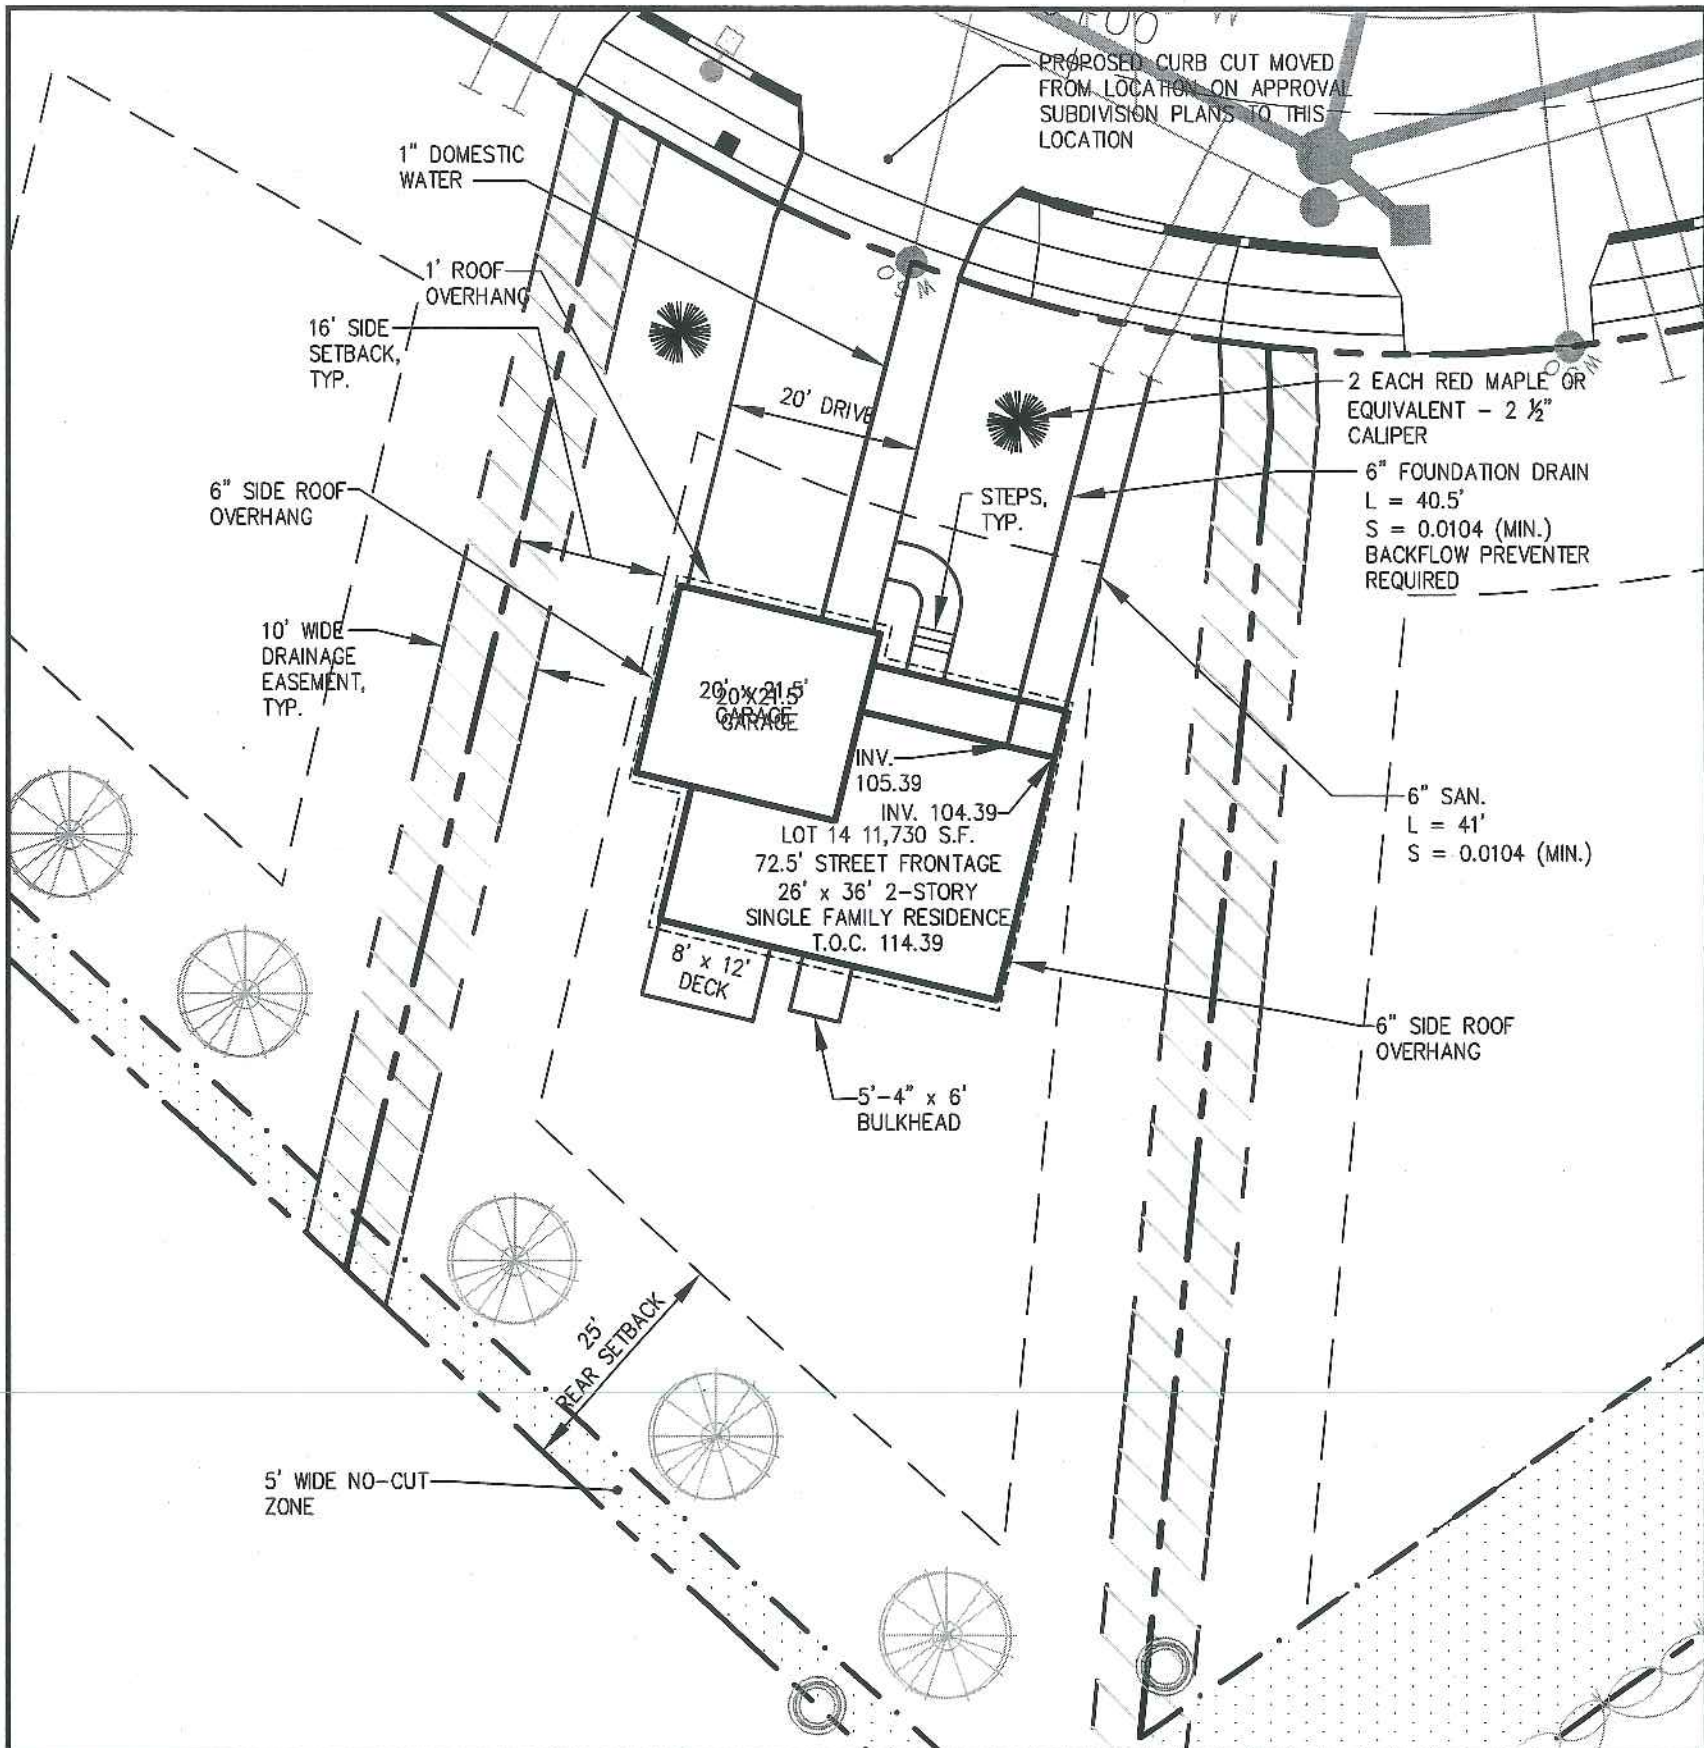


RECEIVED NOV 15 2005

CITY OF PORTLAND
 APPROVED SITE PLAN
 Subject to Dept. Conditions
 Date of Approval: 11-16-05

ZONING REGULATIONS

ZONE:	R-3
MINIMUM LOT SIZE:	6,500 S.F.
MINIMUM LOT WIDTH:	75 FEET
MINIMUM STREET FRONTAGE:	50 FEET
MINIMUM FRONT YARD SETBACK:	25 FEET OR AT MIN. 75' LOT WIDTH
MINIMUM REAR YARD SETBACK:	25 FEET
MINIMUM SIDE YARD SETBACK:	16 FEET (FOR 2½ STORY DWELLING) 8 FEET (FOR 1½ STORY DWELLING)

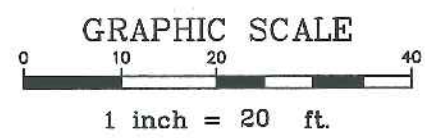

REVISED 11.10.05


DH
 DeLuca-Hoffman Associates, Inc.
 778 MAIN STREET, SUITE 8
 SOUTH PORTLAND, ME 04106
 207.775.1121
 WWW.DELUCAHOFFMAN.COM

DRAWN:	SMW	DATE:	MAR. 2005
DESIGNED:	DDA	SCALE:	1" = 20'
CHECKED:	DDA	JOB NO.:	2459.02
FILE NAME:	245902-LOTS		

RUBY LANE
 PORTLAND, MAINE

LOT 14 LAYOUT & UTILITIES PLAN

FIGURE
 14-A

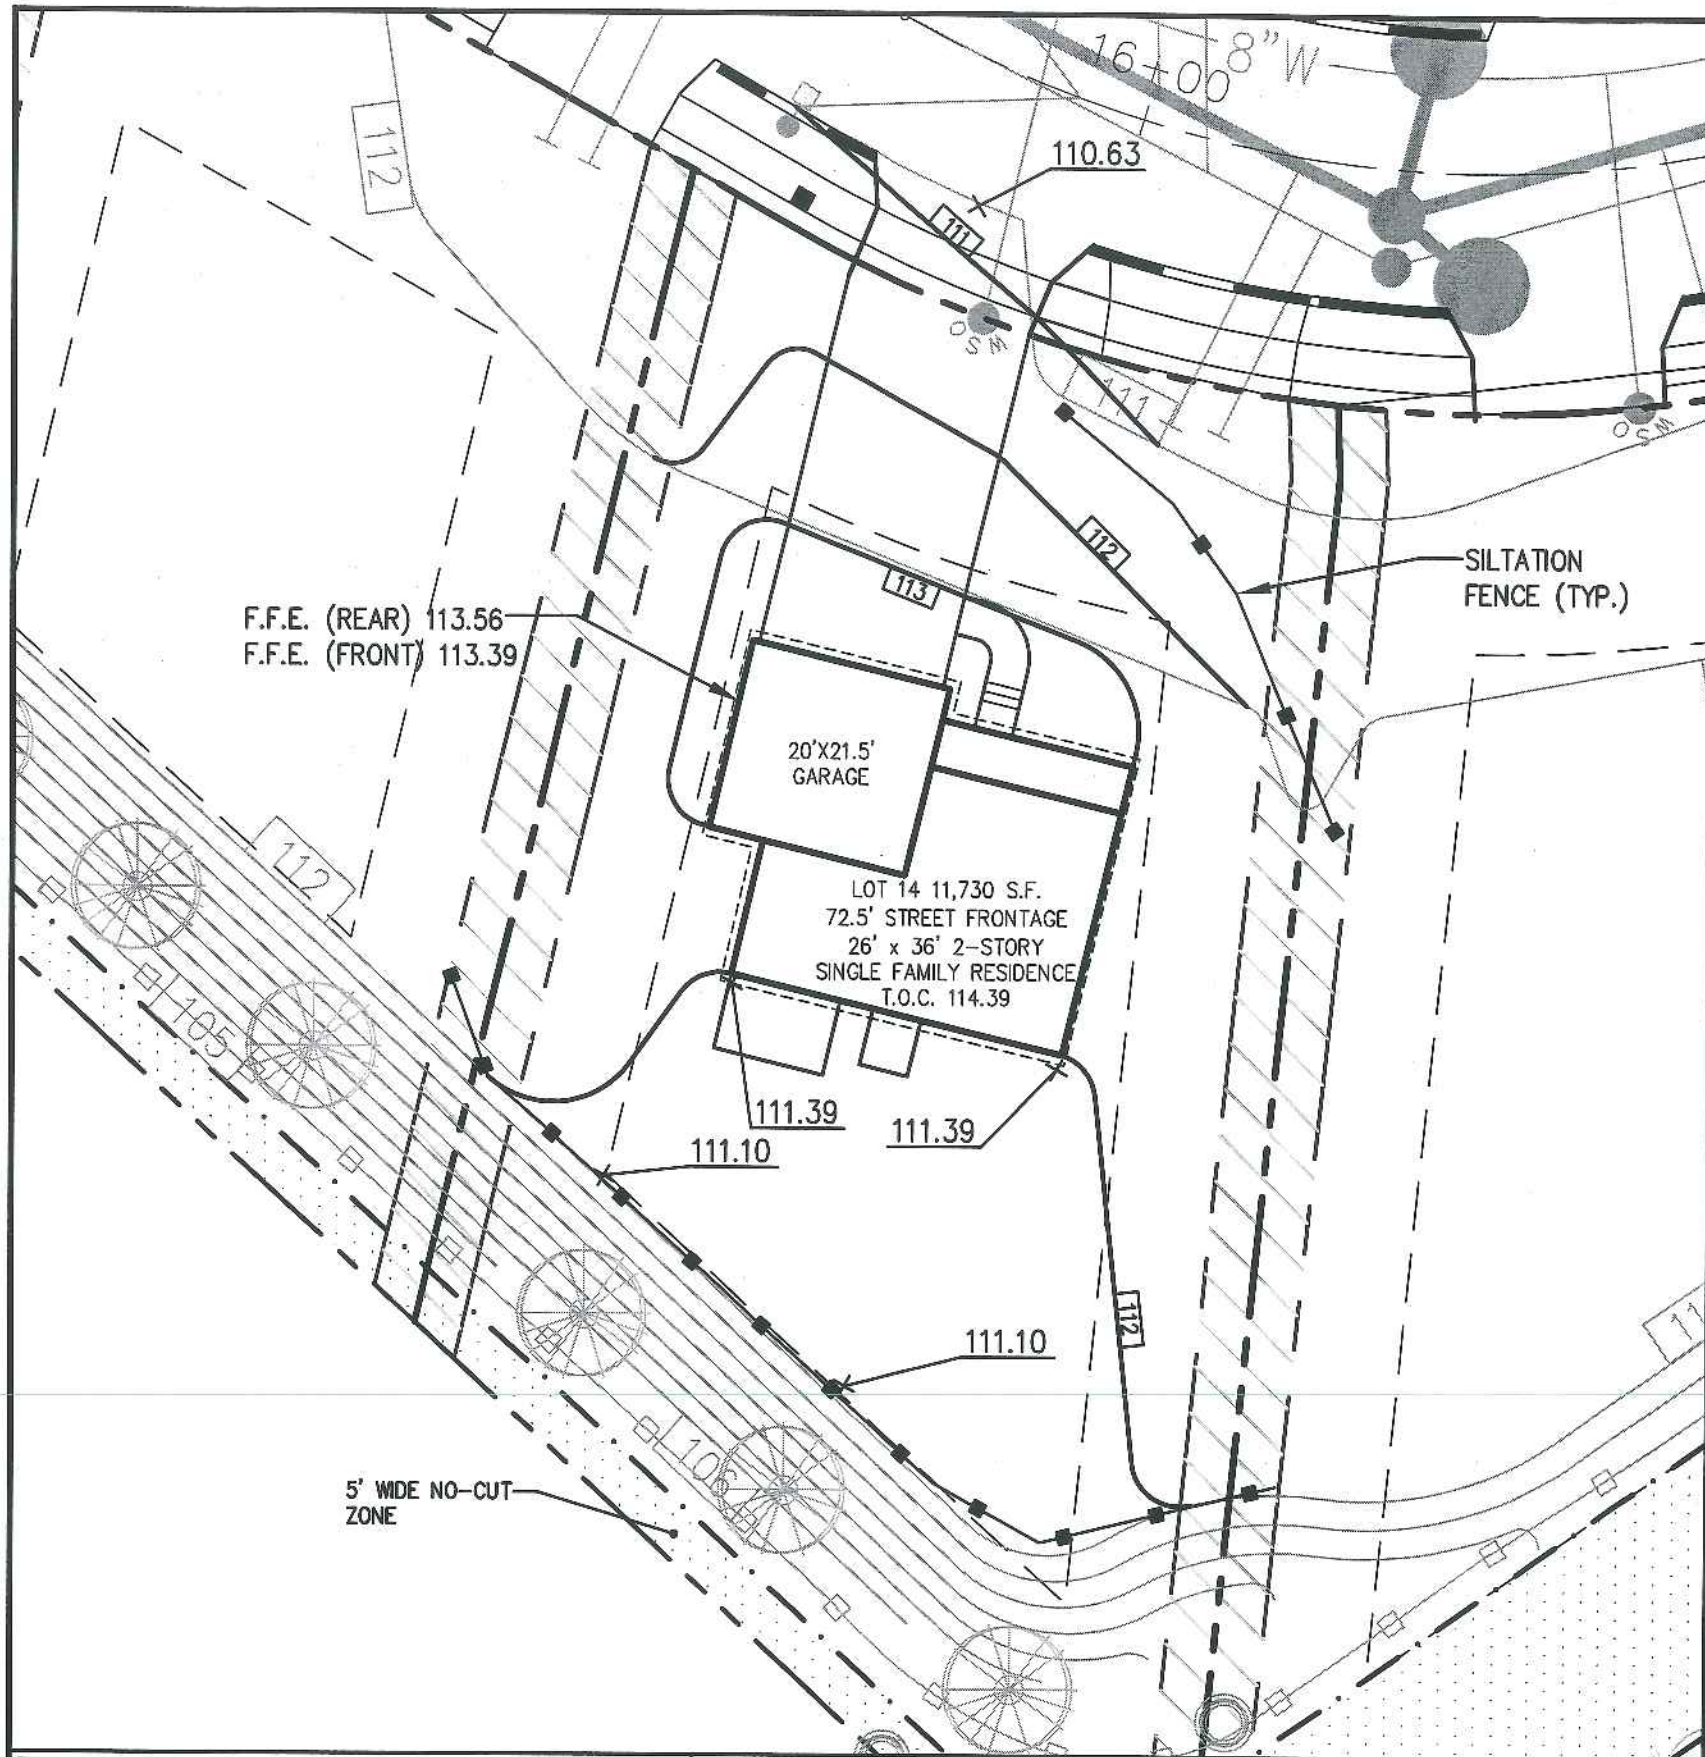


RECEIVED NOV 15 2005

ZONING REGULATIONS

ZONE:	R-3
MINIMUM LOT SIZE:	6,500 S.F.
MINIMUM LOT WIDTH:	75 FEET
MINIMUM STREET FRONTAGE:	50 FEET
MINIMUM FRONT YARD SETBACK:	25 FEET OR AT MIN. 75' LOT WIDTH
MINIMUM REAR YARD SETBACK:	25 FEET
MINIMUM SIDE YARD SETBACK:	16 FEET (FOR 2½ STORY DWELLING) 8 FEET (FOR 1½ STORY DWELLING)

CITY OF PORTLAND
APPROVED SITE PLAN
Subject to Dept. Conditions
Date of Approval: 11-16-05

GRAPHIC SCALE

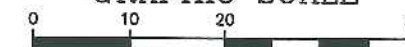

1 inch = 20 ft.

REVISED 11.10.05

DH
DeLuca-Hoffman Associates, Inc.
778 MAIN STREET, SUITE 8
SOUTH PORTLAND, ME 04106
207.775.1121
WWW.DELUCAHOFFMAN.COM

DRAWN:	CDD	DATE:	MAR. 2005
DESIGNED:	DDA	SCALE:	1" = 20'
CHECKED:	DDA	JOB NO.	2459.02
FILE NAME:	245902-LOTS		

RUBY LANE
PORTLAND, MAINE

LOT 14 GRADING & EROSION
CONTROL PLAN

FIGURE
14-B