


FOUNDATION PLAN

(N.T.S.)

ANCHOR BOLTS REQ'D

(62) 3/8"Ø x 3 3/4" THUNDERSTUDS

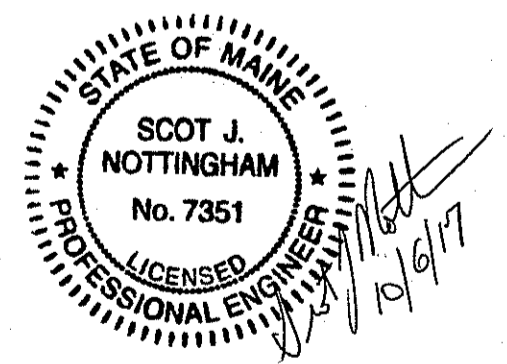

GROUND SNOW LOAD: 70 PSF
WIND LOAD: 90 MPH

REV.	BY	DATE	DESCRIPTION
1	SJN	10/6/17	REV. SECTION 6/4A WAS 6/4A

APPROVED	DATE	APPROVED AS NOTED
<input type="checkbox"/> CUSTOMER	_____	<input type="checkbox"/>
<input type="checkbox"/> ARCHITECT	_____	<input type="checkbox"/>
<input type="checkbox"/> CONTRACTOR	_____	<input type="checkbox"/>
<input type="checkbox"/> DEALER	_____	<input type="checkbox"/>
<input type="checkbox"/> OTHER	_____	<input type="checkbox"/>

FLEXOSPAN
BOX 515 RAILROAD STREET
SANDY LAKE, PA. 16145-0515
PHONE: 800-245-0398
FAX: 724-376-3884

FOUNDATION PLAN & DETAILS

JMC STORAGE
980 RIVERSIDE DRIVE
PORTLAND, ME
207-653-6339

DRAWN BY: AZKACART 10/25/16
CHECKED BY: _____

21667M-3A