

4/11/17

Nelson Property
Mike Melanson
831-9311


Revision on Step Dimension
Property Address
Overhead Door company
533 Riverside Industrial
Parkway, Portland ME.
04103
Permit # 2016-02842

Box Down
12" Indes
Compact New Gravel
1" and then
pave over

70'

12'

Chris Rogers

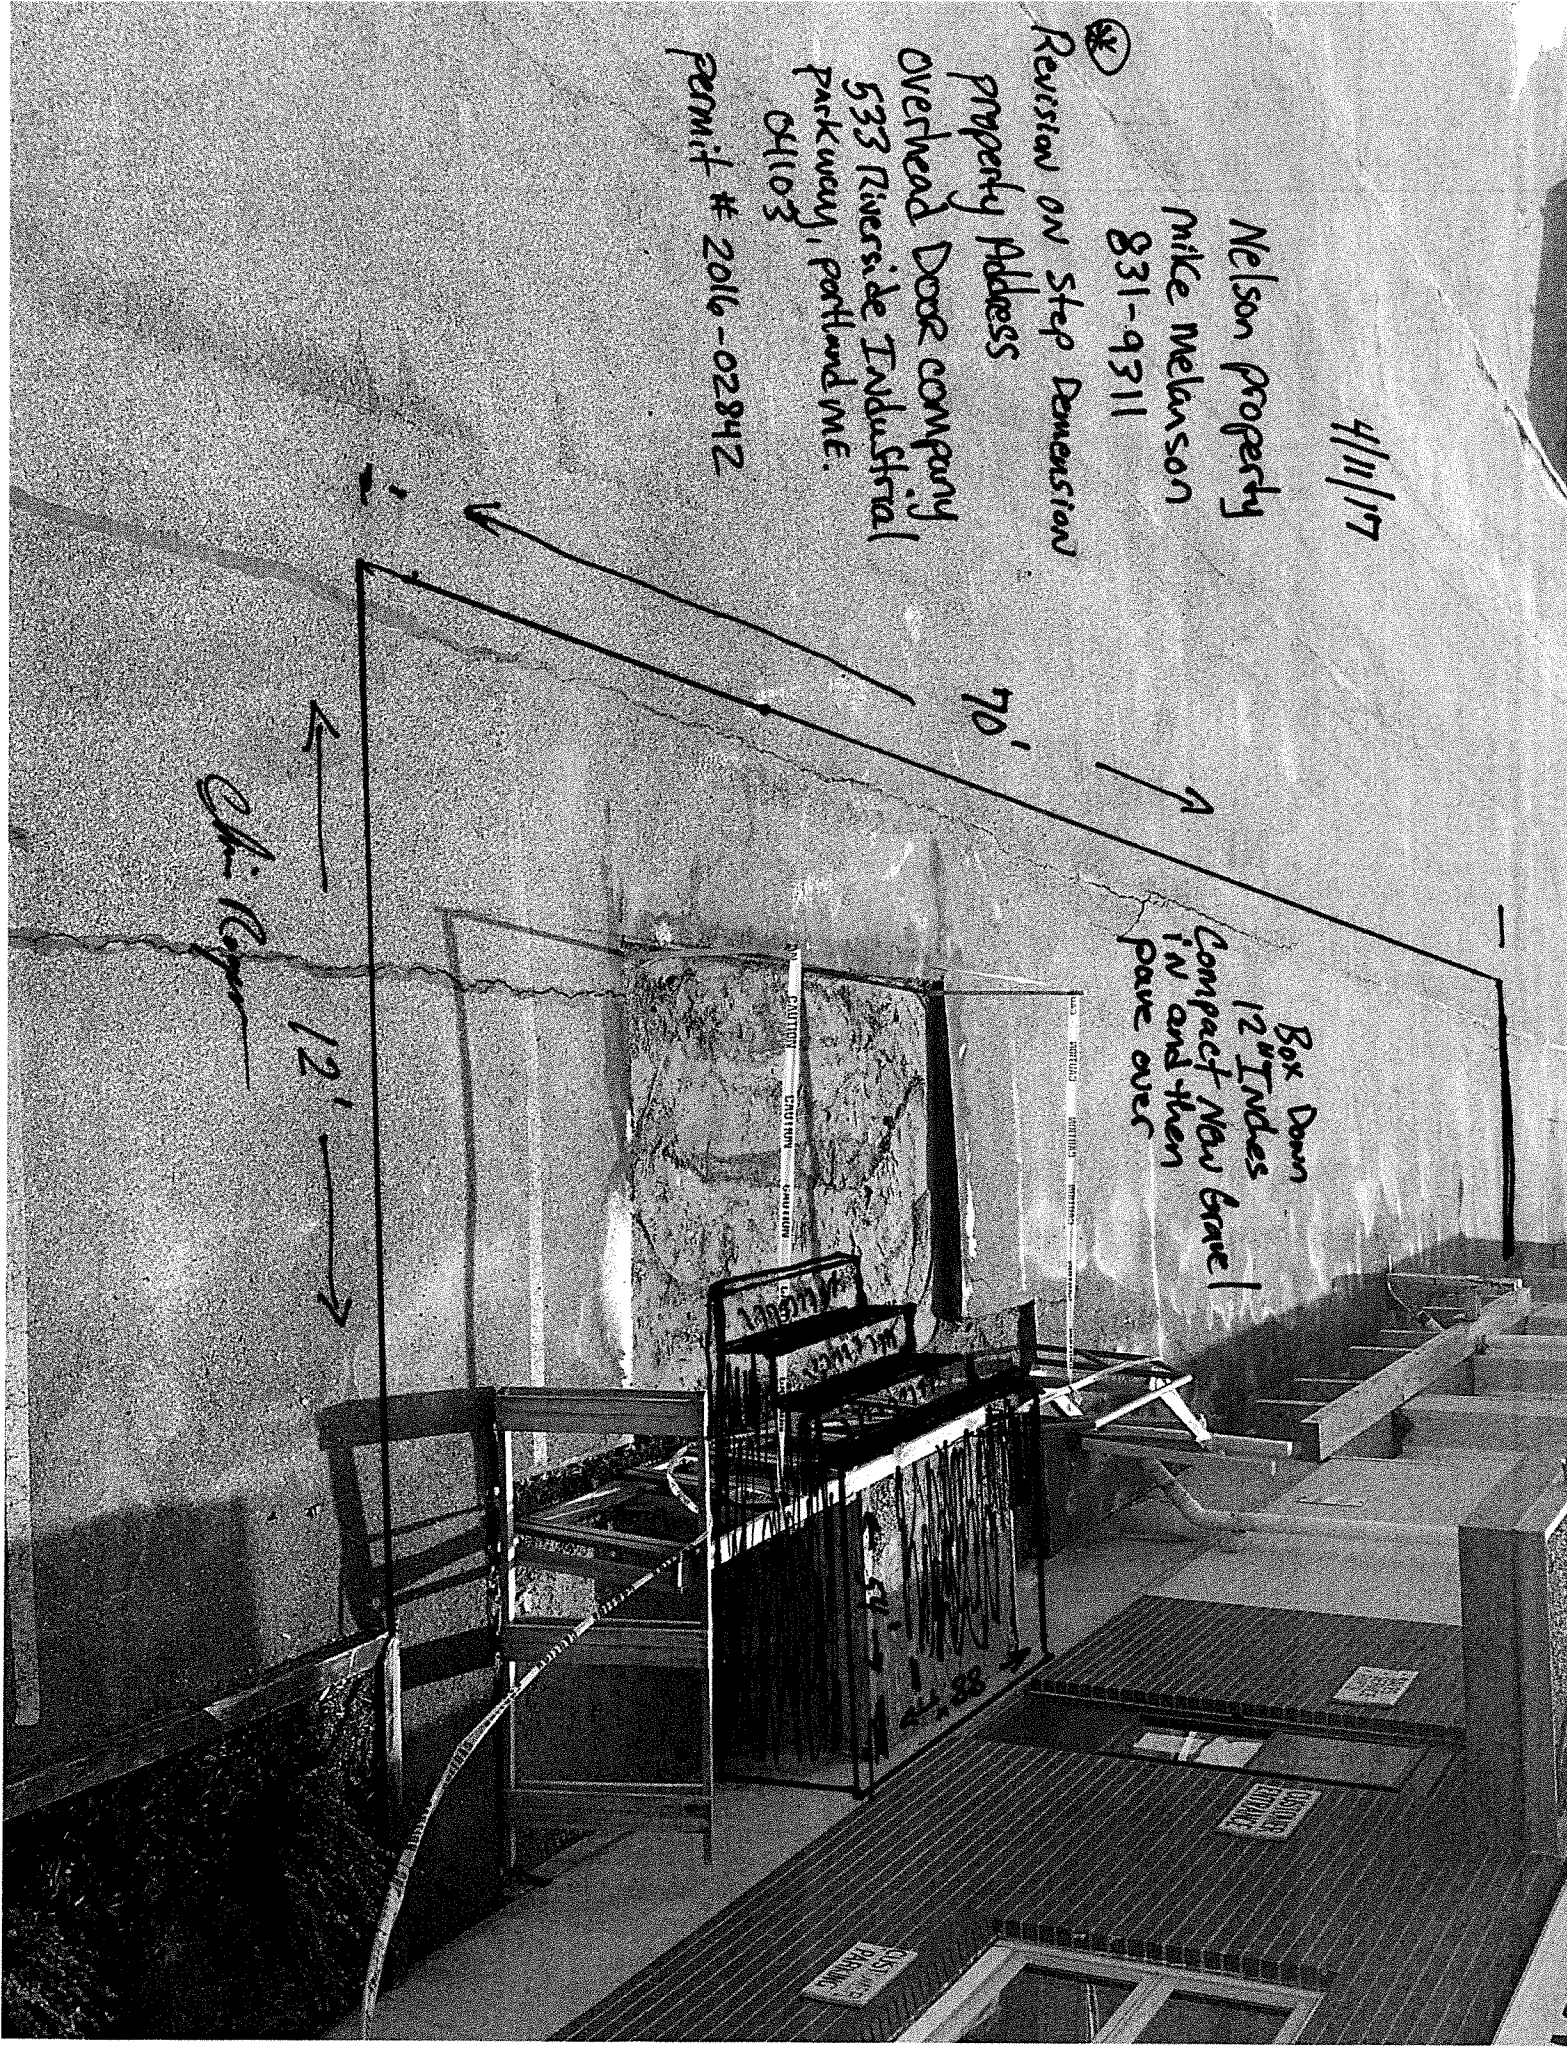



Reviewed for Code Compliance
Inspectional Division
Approved with Conditions
02/02/17

Date:

Overhead Door Co

533 Riverside

Industrial parkway
Portland ME 04103

1/13/17

CAR

Steps to

Be


7/11

Configuration

POURED concrete with
Rebar REINFORCEMENT
and wire mesh if needed.

Hand Rails will be
made to meet code.

TOP view

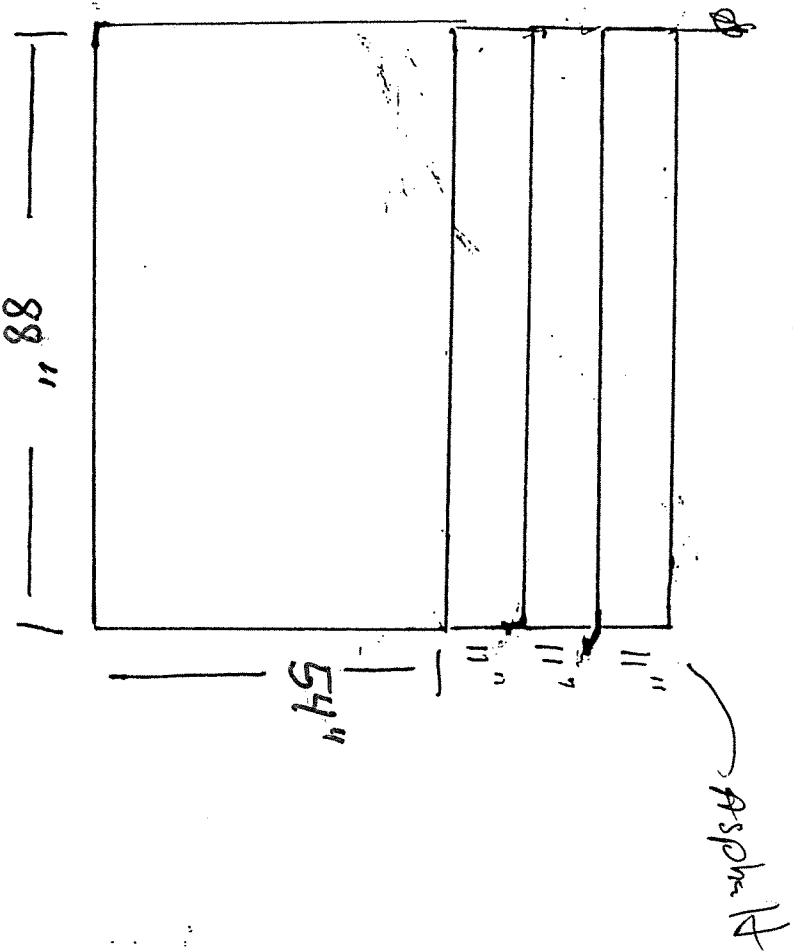

Revised 4/11/17

Chris Rogers

Permit # 2016-02842