



Reviewed for Code Compliance
Inspectors Division
Agreement with Conditions
02/07/17

Overhead Door Company
Reed Door Company
Holland ME


Revision Hand Rail Detail 2/9/17

533 Riverside Ind Pkwy
Portland ME 04103

2/3/17

* Extends 12" Beyond Top Riser
Rail continues to post


533 Riverside Ind. Pkwy
Portland, ME 04103
Tel. 1-800-287-6733
Fax: 207-797-0542

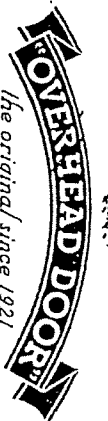

Hand Rail Detail
1 1/4" Round Steel Pipe
Schedule 40 (1.66 dia)
* Rail Heights & materials
Same Both Sides

Chris Rogers

Idris 1.38

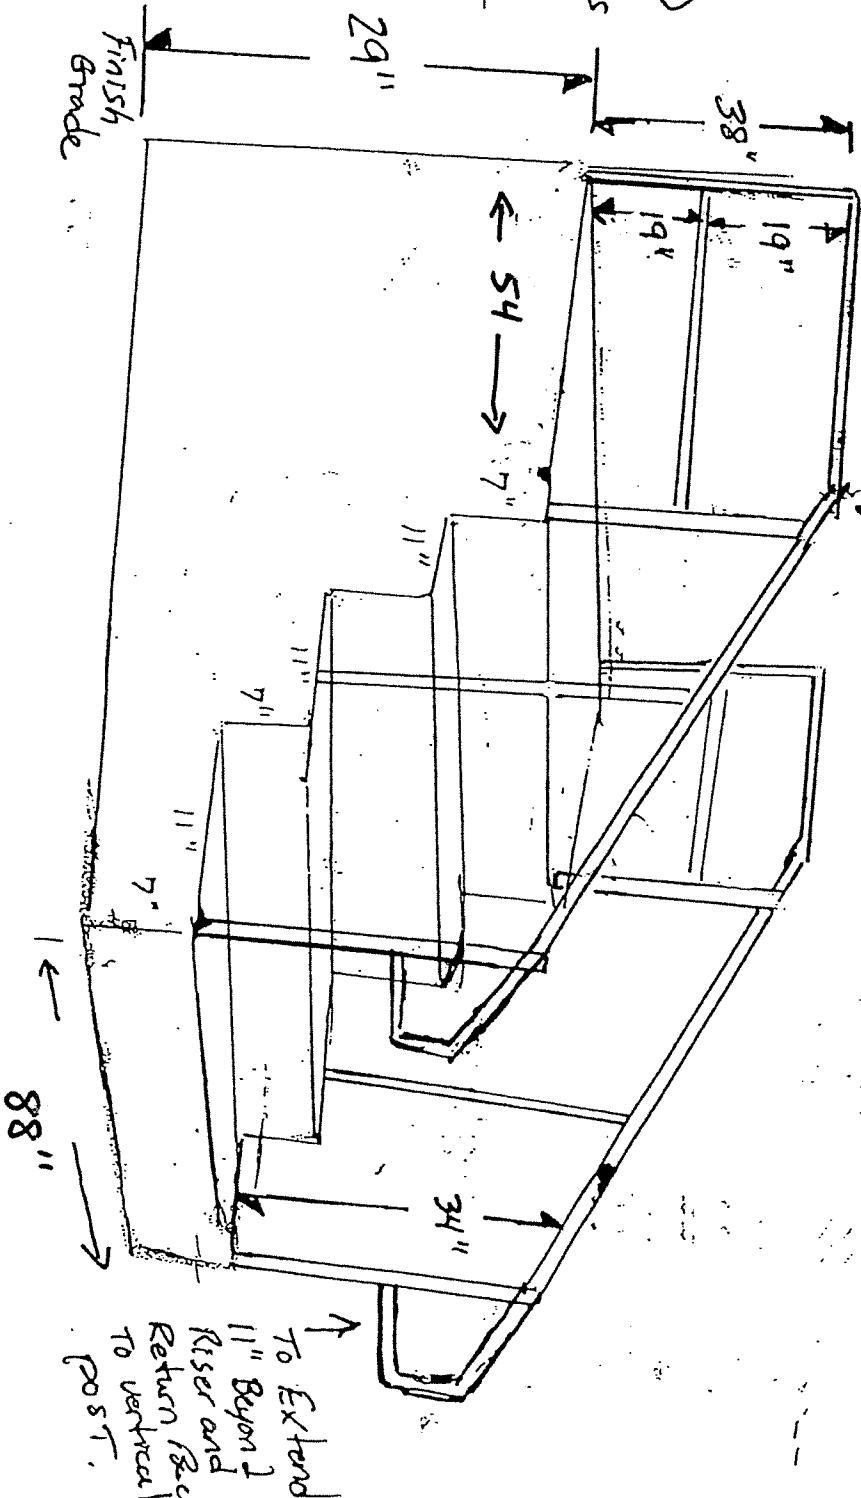

Building Permit #
2016-02842

* Revision 4/11/17 Stair width & landing area Depth

Change - concrete forms need to be set so that
Landing Depth is 54" and stairs width will be
88"

