


X New doors
New walls

MARRS 24 PLYSONS PAINT AS BUILT

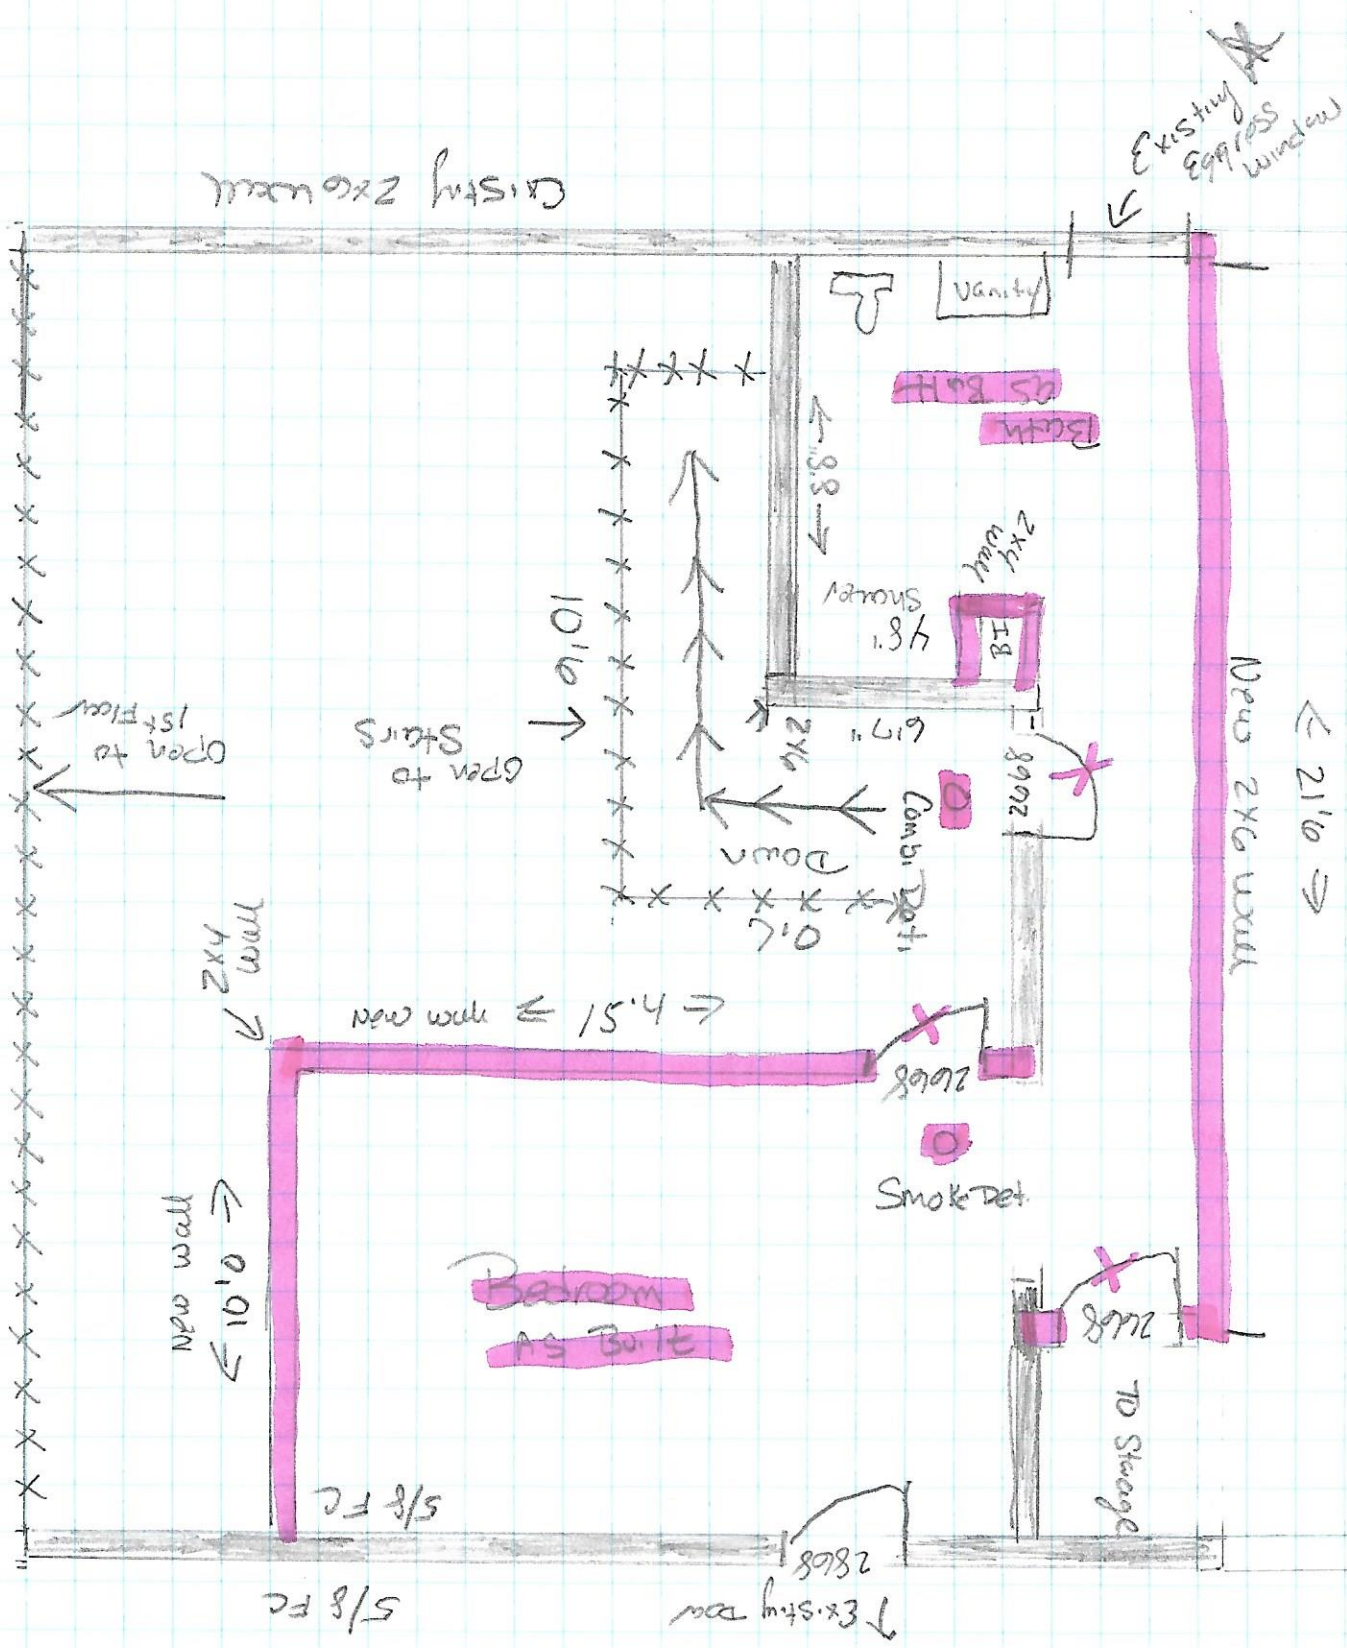

TO Storage over garage