

City of Portland, Maine – Building or Use Permit Application 389 Congress Street, 04101, Tel: (207) 874-8703, FAX: 874-8716

Location of Construction: 64 Auburn Street		Owner: Marion Christy		Phone: 797-3339		Permit No: 010032
Owner Address: 1479 Washington Ave. Portland, ME		Lessee/Buyer's Name: **Mr. Bagel <i>John Duran</i>		Phone: **797-7500		
Contractor Name: Baily Sign		Address: 9 Thomas Drive, Westbrook, ME		Phone: 04092 774-2843		Permit Issued:
Past Use: Commercial		Proposed Use: Commercial		COST OF WORK: \$(52.25sf) PERMIT FEE: \$ 40.45 FIRE DEPT. <input type="checkbox"/> Approved <input type="checkbox"/> Denied INSPECTION: <i>Sigmond</i> Use Group: Type: <i>BOCA999</i> Signature: <i>[Signature]</i>		
Proposed Project Description: Relocation of existing sign; adding a message board to it <i>per revised plan dated 1/5/01</i>				PEDESTRIAN ACTIVITIES DISTRICT (P.A.D.) Action: <input type="checkbox"/> Approved <input type="checkbox"/> Approved with Conditions <input type="checkbox"/> Denied Signature: _____ Date: _____		Zone: BT CBL: 375-A-003 Zoning Approval: <i>[Signature]</i> Special Zone or Reviews: <input type="checkbox"/> Shoreland <input type="checkbox"/> Wetland <input type="checkbox"/> Flood Zone <input type="checkbox"/> Subdivision <input type="checkbox"/> Site Plan maj <input type="checkbox"/> minor <input type="checkbox"/> mm <input type="checkbox"/> <i>1/5/01</i>
Permit Taken By: Gayle		Date Applied For: December 20, 2000 GG				

1. This permit application does not preclude the Applicant(s) from meeting applicable State and Federal rules.
2. Building permits do not include plumbing, septic or electrical work.
3. Building permits are void if work is not started within six (6) months of the date of issuance. False information may invalidate a building permit and stop all work..

Zoning Appeal

Variance
 Miscellaneous
 Conditional Use
 Interpretation
 Approved
 Denied

Historic Preservation

Not in District or Landmark
 Does Not Require Review
 Requires Review

PERMIT ISSUED WITH REQUIREMENTS

CERTIFICATION

I hereby certify that I am the owner of record of the named property, or that the proposed work is authorized by the owner of record and that I have been authorized by the owner to make this application as his authorized agent and I agree to conform to all applicable laws of this jurisdiction. In addition, if a permit for work described in the application is issued, I certify that the code official's authorized representative shall have the authority to enter all areas covered by such permit at any reasonable hour to enforce the provisions of the code(s) applicable to such permit

December 20, 2000

SIGNATURE OF APPLICANT _____ ADDRESS: _____ DATE: _____ PHONE: _____

RESPONSIBLE PERSON IN CHARGE OF WORK, TITLE _____ PHONE: _____

PERMIT ISSUED WITH REQUIREMENTS

Action:

Approved
 Approved with Conditions
 Denied

Date: *[Signature]*

CEO DISTRICT

THIS IS NOT A PERMIT/CONSTRUCTION CANNOT COMMENCE UNTIL THE PERMIT IS ISSUED

SIGNAGE APPLICATION

Com.

THIS IS NOT A PERMIT

CONSTRUCTION CANNOT NOT COMMENCE UNTIL THE PERMIT IS ISSUED

In the interest of processing your application in the quickest possible manner, please complete the Information below for a Building or Use Permit.

NOTE**If you or the property owner owes real estate or personal property taxes or user charges on any property within the City, payment arrangements must be made before permits of any kind are accepted.


Location/Address of Construction: <u>64 AUBURN ST, PORTLAND, ME 04103</u>		
Total Square Footage of Proposed Structure <u>52.25 SQ FT</u>	Square Footage of Lot <u>-</u>	
Tax Assessor's Chart, Block & Lot Number Chart# <u>375</u> Block# <u>A</u> Lot# <u>003</u>	Owner: <u>MARION CHRISTY</u> <u>1479 1275 WASHINGTON AVE</u> <u>PORTLAND, ME</u>	Telephone #: <u>797.3339</u>
Lessee/Buyer's Name (If Applicable) <u>MR BAGEL</u> <u>C/O JOHN DURAN</u>	Owner's/Purchaser/Lessee Address: <u>A342</u> <u>7500 8-2 hours</u>	Cost Of Works: Fee: <u>\$52.55</u> \$ <u>40.45</u>
Current use: _____ Proposed use: _____		
Project description: <u>5.5 x 5.5 = 30.25 #</u> <u>1' x 5.5' = 22 #</u> <u>RELOCATION OF EXISTING SIGN</u> <u>ADDING A MESSAGE BOARD TO IT</u>		
Contractor's Name, Address & Telephone <u>BAILEY SIGN, 9 THOMAS DR WESTBROOK, ME 04092</u> <u>774.2843</u> Rec'd By: <u>12/19</u>		

Please check off the following indicating that you have included the below items to expedite the process of this sign application:

- "Certification of Liability" listing the City additionally insured
- Letter of permission from the owner

A sketch plan indicating the following:

- Drawing of the property showing all dimensions of the lot
- Location of all buildings and property setbacks from all buildings
- Driveways and abutting streets showing street frontage and any right of ways
- Indicate on drawing the dimensions of all buildings on the lot
- Define in footage the frontage of your business front
- Indicate on drawing of existing signage and dimensions of each sign
- Indicate on drawing all proposed signage and dimension of each sign
- Sign area height and setback of each existing and proposed freestanding sign

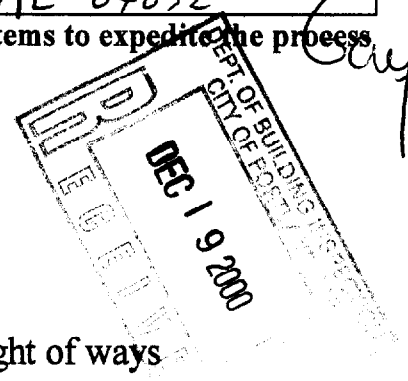

**THIS IS NOT A PERMIT/CONSTRUCTION CANNOT COMMENCE UNTIL THE
PERMIT IS ISSUED**

- Certification of flammability required for awning/canopy at time of application
- UL # required for lighted signs at the time of Final Inspection. Failure to provide this information will invalidate the Sign Permit.

The Provisions of Section 3102.0 of the City's Building Code "The BOCA National Building Code 1999 edition" shall govern the construction, alteration, repair and maintenance of outdoor signs together with the associated appurtenant and auxiliary devices in respect to structural and fire safety. In accordance to section 3102.4.4 of BOCA construction documents and owners consent is all follows; "Before any permit is issued for the erection of a sign, Construction Documents shall be filed with the code official showing the dimensions, materials and required details of construction, including loads, stresses and anchorage. The applications shall be accompanied by the written contract of the owner or lessees of the premises upon which the sign is to be erected. **NO PERMIT CAN OR WILL BE ISSUED UNLESS THIS INFORMATION IS SBUMITTED AND APPROVED BY THE INSPECTIONS OFFICE.**

ELECTRICAL SIGNAGE PERMITS/RESPONSIBILITIES

All sign companies or any persons engaged in the installation, interchange or maintenance of signage in the City of Portland must have the Electrician or Electrical Contractor who provided power to the sign(s) or associated equipment apply for an electrical permit in the Inspections Office.

It is the responsibility of your company to contact your sub-contractor or he owner to inform them of this policy. Whether your company does the final connections, which requires a valid Maine Electricians License or your sub contractor provides this service; permits and inspections shall be required.

Failure to comply with this procedure may result in the denial of sign permits by this office for your company or its representation to install or interchange any future signage in the City of Portland.

A separate sketch may be required if in the Historical District of any proposed sign(s), indicating dimensions, materials, source of illustration and construction method.

Certification

I hereby certify that I am the Owner of record of the named property, or that the owner of record authorizes the proposed work and that I have been authorized by the owner to make this application as his/her authorized agent. I agree to conform to all applicable laws of this jurisdiction. In addition, if a permit for work described in this application is issued, I certify that the Code Official's authorized representative shall have the authority to enter all areas covered by this permit at any reasonable hour to enforce the provisions of the codes applicable to this permit.

Signature of applicant:	Date:
--------------------------------	--------------

Sign Permit Fee: \$30.00 plus \$0.20 per square foot.

A building permit is also required for any awning based on cost of work-\$30.00 for the first \$1,000.00 and \$6.00 for each additional \$1,000.00

Side Walk Signs Design/Location/Construction Standards

Quantity

One sign per establishment for each street frontage having a public entrance provided that all dimension and location standards are met. When standards would not otherwise permit a sign, a sign may consist of multiple listings.

Sign Dimensions

Single listing: Maximum width – 24 inches or such lesser width sufficient to retain 4 ½ feet of unobstructed sidewalk width perpendicular to major flow. Maximum height – 40 inches to top of sign in place. Minimum height 30 inches to top of sign in place.

Multiple: Maximum width – 30 inches or such lesser width sufficient to retain 4 ½ feet of unobstructed sidewalk width perpendicular to major flow. Maximum height – 4- inches to top of sign in place. Minimum height 30 inches to top of sign in place.

Location

Minimum distance between signs – 20 feet. Maximum distance of sign from public entrance of advertiser 20 feet. The City may vary these distances for exceptional physical circumstances where public safety and streetscape aesthetics will be maintained. However, under no circumstances shall signs obstruct vehicular stops, benches, fire hydrants, or other street visual amenities. Signs shall be located near the curb rather than the building face.

Materials and Graphics

All signs shall be of an A-Frame type design, shall be constructed of durable, weather-resistant materials and finish, shall have no moving parts, and shall be non-electrified. All signs shall be maintained in a clean and original appearance. Sign materials, graphics, and finish shall be of a unified design and shall be compatible with the local streetscape. All signs shall have horizontal braces spanning each side of the sign to assure rigid support. Lettering shall be legible and consistent.

Sign Removal

All signs shall be removed when the business is closed or while any snow or ice exists on the walk within eight feet of the sign in any direction.

Insurance

No permit shall be issued unless the applicant has posted in advance with the City a suitable public liability insurance certificate in an amount adequate to protect the City.

Enforcement

A sign may be removed after notice to the owner and the permit, if issued, may be revoked if the sign does not conform to the standards herein.

For permit come to City Hall 389 Congress Street room 315 with:

1. Certificate of liability insurance
2. Drawing of sign showing dimensions
3. Payment of .20 per sq. ft. plus \$30.00

BUILDING PERMIT REPORT

DATE: 20 Dec. 2000 ADDRESS: 64 Auburn St. CBL: 375-A-003

REASON FOR PERMIT: Signage

BUILDING OWNER: Marion Christy

PERMIT APPLICANT: CONTRACTOR Bailey Sign

USE GROUP: CONSTRUCTION TYPE: CONSTRUCTION COST: PERMIT FEES: \$40.45

The City's Adopted Building Code (The BOCA National Building Code/1999 with City Amendments)
The City's Adopted Mechanical Code (The BOCA National Mechanical Code/1993)


CONDITION(S) OF APPROVAL

This permit is being issued with the understanding that the following conditions shall be met: #1, #36, #31, #37

- *1. This permit does not excuse the applicant from meeting applicable State and Federal rules and laws.
2. Before concrete for foundation is placed, approvals from the Development Review Coordinator and Inspection Services must be obtained.
3. Foundation drain shall be placed around the perimeter of a foundation that consists of gravel or crushed stone containing not more than 10 percent material that passes through a No. 4 sieve.
4. Foundations anchors shall be a minimum of 1/2" in diameter, 7" into the foundation wall, minimum of 12" from corners of foundation and a maximum 6' O.C. between bolts.
5. Waterproofing and dampproofing shall be done in accordance with Section 1813.0 of the building code.
6. Precaution must be taken to protect concrete and masonry.
7. It is strongly recommended that a registered land surveyor check all foundation forms before concrete is placed.
8. Private garages located beneath habitable rooms in occupancies in Use Group R-1, R-2, R-3 or I-1 shall be separated from adjacent interior spaces by fire partitions and floor/ceiling assembly which are constructed with not less than 1-hour fire resisting rating.
9. All chimneys and vents shall be installed and maintained as per Chapter 12 of the City's Mechanical Code.
10. Sound transmission control in residential building shall be done in accordance with Chapter 12, Section 1214.0 of the City's Building Code.
11. Guardrails & Handrails: A guardrail system is a system of building components located near the open sides of elevated walking surfaces for the purpose of minimizing the possibility of an accidental fall from the walking surface to the lower level.
12. Headroom in habitable space is a minimum of 7'6".
13. Stair construction in Use Group R-3 & R-4 is a minimum of 10" tread and 7 1/4" maximum rise.
14. The minimum headroom in all parts of a stairway shall not be less than 80 inches.
15. Every sleeping room below the fourth story in buildings of Use Groups R and I-1 shall have at least one operable window or exterior door approved for emergency egress or rescue.
16. Each apartment shall have access to two (2) separate, remote and approved means of egress.
17. All vertical openings shall be enclosed with construction having a fire rating of at least one (1) hour, including fire doors with self closure's.
18. The boiler shall be protected by enclosing with (1) hour fire rated construction including fire doors and ceiling, or by providing automatic extinguishment.

19. All single and multiple station smoke detectors shall be of an approved type and shall be installed in accordance with the provisions of the City's Building Code Chapter 9, Section 920.3.2 (BOCA National Building Code/1999), and NFPA 101 Chapter 18 & 19. (Smoke detectors shall be installed and maintained at the following locations):
 - In the immediate vicinity of bedrooms
 - In all bedrooms
 - In each story within a dwelling unit, including basements
20. A portable fire extinguisher shall be located as per NFPA #10. They shall bear the label of an approved agency and be of an approved type. (Section 921.0)
21. The Fire Alarm System shall be installed and maintained to NFPA #72 Standard.
22. The Sprinkler System shall be installed and maintained to NFPA #13 Standard.
23. All exit signs, lights and means of egress lighting shall be done in accordance with Chapter 10 Section & Subsections 1023.0 & 1024.0 of the City's Building Code. (The BOCA National Building Code/1999)
24. Section 25 - 135 of the Municipal Code for the City of Portland states, "No person or utility shall be granted a permit to excavate or open any street or sidewalk from the time of November 15 of each year to April 15 of the following year".
25. The builder of a facility to which Section 4594-C of the Maine State Human Rights Act Title 5 MRSA refers, shall obtain a certification from a design professional that the plans commencing construction of the facility, the builder shall submit the certification the Division of Inspection Services.
26. Ventilation and access shall meet the requirements of Chapter 12 Sections 1210.0 and 1211.0 of the City's Building Code. (Crawl spaces & attics).
27. All electrical, plumbing and HVAC permits must be obtained by Master Licensed holders of their trade. No closing in of walls until all electrical (min. 72 hours notice) and plumbing inspections have been done.
28. All requirements must be met before a final Certificate of Occupancy is issued.
29. All building elements shall meet the fastening schedule as per Table 2305.2 of the City's Building Code (The BOCA National Building Code/1996).
30. Ventilation of spaces within a building shall be done in accordance with the City's Mechanical code (The BOCA National Mechanical Code/1993). (Chapter M-16)
31. Please read and implement the attached Land Use Zoning report requirements. *OK per Approved Revised Plan date 1/5/20*
32. Boring, cutting and notching shall be done in accordance with Sections 2305.3, 2305.3.1, 2305.4.4 and 2305.5.1 of the City's Building Code.
33. Bridging shall comply with Section 2305.16.
34. Glass and glazing shall meet the requirements of Chapter 24 of the building code. (Safety Glazing Section 2406.0)
35. All flashing shall comply with Section 1406.3.10.
36. All signage shall be done in accordance with Section 3102.0 signs of the City's Building Code, (The BOCA National Building Code/1999).

~~37- No flashing, or intermittent, blinking lights allowed~~

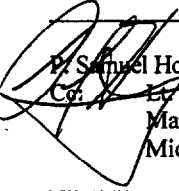

D. Samuel Hoffses, Building Inspector
 Sgt. E. McDougall, PFD
 Marge Schmuckal, Zoning Administrator
 Michael Nugent, Inspection Service Manager

PSH 10/1/00

****This permit is herewith issued, on the basis of plans submitted and conditions placed on these plans, any deviations shall require a separate approval.**

*****THIS PERMIT HAS BEEN ISSUED WITH THE UNDERSTANDING THAT ALL THE CONDITIONS OF THE APPROVAL SHALL BE COMPLETED. THEREFORE, BEFORE THE WORK IS COMPLETED A REVISED PLAN OR STATEMENT FROM THE PERMIT HOLDER SHALL BE SUBMITTED TO THIS OFFICE SHOWING OR EXPLAINING THAT THE CONDITIONS HAVE BEEN MET. IF THIS REQUIREMENT IS NOT RECEIVED YOUR CERTIFICATE OF OCCUPANCY SHALL BE WITHHELD. (You Shall Call for Inspections)**

******ALL PLANS THAT REQUIRE A PROFESSIONAL DESIGNER'S SEAL, (AS PER SECTION 114.0 OF THE BUILDING CODE) SHALL ALSO BE PRESENTED TO THIS DIVISION ON AUTO CAD LT. 2000, DXF FORMAT OR EQUIVALENT.**

*******CERTIFICATE OF OCCUPANCY FEE \$50.00**

ACORD CERTIFICATE OF LIABILITY INSURANCE

DATE (MM/DD/YY)
12.19.00

PRODUCER

COASTAL INSURANCE GROUP
4 Newton Street
Portland Maine 04103
207 797-4900

THIS CERTIFICATE IS ISSUED AS A MATTER OF INFORMATION ONLY AND CONFERS NO RIGHTS UPON THE CERTIFICATE HOLDER. THIS CERTIFICATE DOES NOT AMEND, EXTEND OR ALTER THE COVERAGE AFFORDED BY THE POLICIES BELOW.

COMPANIES AFFORDING COVERAGE

- COMPANY A Middlesex Mutual Assurance Co
- COMPANY B _____
- COMPANY C _____
- COMPANY D _____

INSURED

697
CCMM INC DBA MR Bagel
64 Auburn St
Portland ME 04103

COVERAGES

THIS IS TO CERTIFY THAT THE POLICIES OF INSURANCE LISTED BELOW HAVE BEEN ISSUED TO THE INSURED NAMED ABOVE FOR THE POLICY PERIOD INDICATED. NOTWITHSTANDING ANY REQUIREMENT, TERM OR CONDITION OF ANY CONTRACT OR OTHER DOCUMENT WITH RESPECT TO WHICH THIS CERTIFICATE MAY BE ISSUED OR MAY PERTAIN, THE INSURANCE AFFORDED BY THE POLICIES DESCRIBED HEREIN IS SUBJECT TO ALL THE TERMS, EXCLUSIONS AND CONDITIONS OF SUCH POLICIES. LIMITS SHOWN MAY HAVE BEEN REDUCED BY PAID CLAIMS.

CO LTR	TYPE OF INSURANCE	POLICY NUMBER	POLICY EFFECTIVE DATE (MM/DD/YY)	POLICY EXPIRATION DATE (MM/DD/YY)	LIMITS
	GENERAL LIABILITY				
	COMMERCIAL GENERAL LIABILITY				GENERAL AGGREGATE \$
	CLAIMS MADE OCCUR		12.15.00	12.15.01	PRODUCTS - COMPO AGG \$
	OWNER'S & CONTRACTOR'S PROT				PERSONAL & ADJ INJURY \$
	<u>Business Owners Liability (per occurrence) TBA</u>				EACH OCCURRENCE \$ 1,000,000
					FIRE DAMAGE (Any one fire) \$
					MED EXP (Any one person) \$
	AUTOMOBILE LIABILITY				
	ANY AUTO				COMBINED SINGLE LIMIT \$
	ALL OWNED AUTOS				BODILY INJURY (F&A) \$
	SCHEDULED AUTOS				BODILY INJURY (F&A) \$
	HIREN AUTOS				PROPERTY DAMAGE \$
	NON-OWNED AUTOS				
	GARAGE LIABILITY				
	ANY AUTO				AUTO ONLY - EA ACCIDENT \$
					OTHER THAN AUTO ONLY:
					EACH ACCIDENT \$
					AGGREGATE \$
	EXCESS LIABILITY				
	UMBRELLA FORM				EACH OCCURRENCE \$
	OTHER THAN UMBRELLA FORM				AGGREGATE \$
	WORKERS COMPENSATION AND EMPLOYERS' LIABILITY				
	THE PROPRIETOR/ PARTNERS/ EXECUTIVE OFFICERS ARE	INC/ EXC			WC STATUTORY LIMITS OTH-ER
	OTHER				EL EACH ACCIDENT \$
					EL DISEASE - POLICY LIMIT \$
					EL DISEASE - EA EMPLOYEE \$

DESCRIPTION OF OPERATIONS/LOCATIONS/VEHICLES/SPECIAL ITEMS


CERTIFICATE HOLDER

City of Portland
City Planning & Urban Development
City Hall

CANCELLATION

SHOULD ANY OF THE ABOVE DESCRIBED POLICIES BE CANCELLED BEFORE THE EXPIRATION DATE THEREOF, THE ISSUING COMPANY WILL ENDEAVOR TO MAIL _____ DAYS WRITTEN NOTICE TO THE CERTIFICATE HOLDER NAMED TO THE LEFT, BUT FAILURE TO MAIL SUCH NOTICE SHALL IMPOSE NO OBLIGATION OR LIABILITY OF ANY KIND UPON THE COMPANY, ITS AGENTS OR REPRESENTATIVES.

AUTHORIZED REPRESENTATIVE

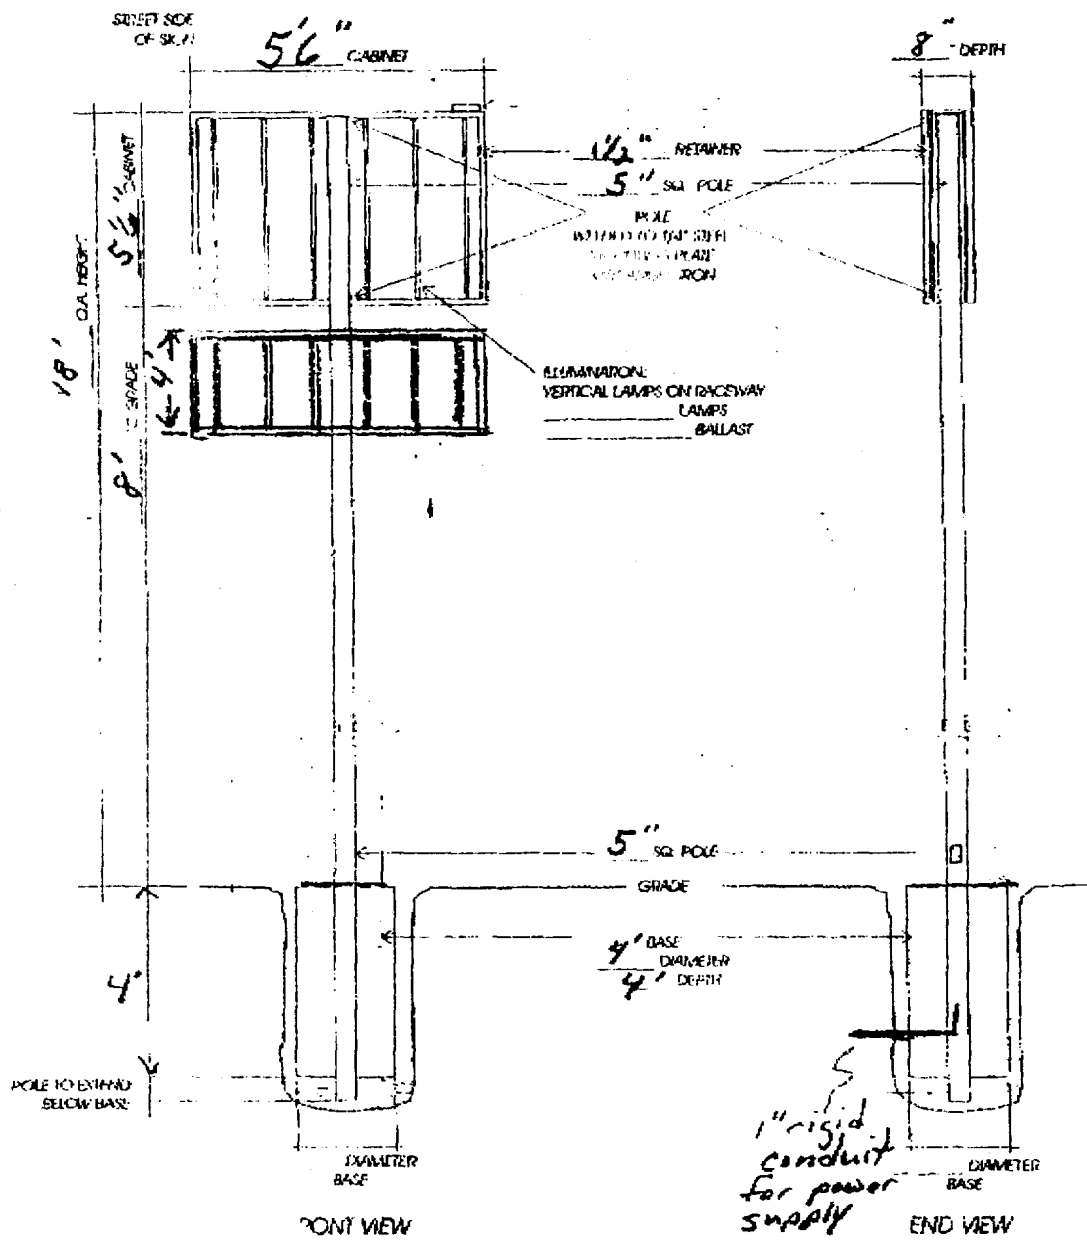

1 - 20 AMP CIR
110 VOLT

VOLTAGE

IS FAST LIGHT

THESE LAMPS ARE THE MOST EFFICIENT OF THE GROUP AND USE THE LEAST ENERGY TO PRODUCE THE MOST LIGHT.

THESE LAMPS ARE THE MOST EFFICIENT OF THE GROUP AND USE THE LEAST ENERGY TO PRODUCE THE MOST LIGHT.

THESE LAMPS ARE THE MOST EFFICIENT OF THE GROUP AND USE THE LEAST ENERGY TO PRODUCE THE MOST LIGHT.



CUSTOMER: MR Bag
LOCATION: 64 Anbur. Portland.

SALESPERSON:
DRAWN BY: L.W. ME.

ACCEPTANCE SIGNATURE

SALES	DATE
PS #	WO #
SCALE	N.T.S.
DATE	




DRAWING NO: 10
SET

NOTES:

DESIGN STATUS:

OK - max height
16'-0"

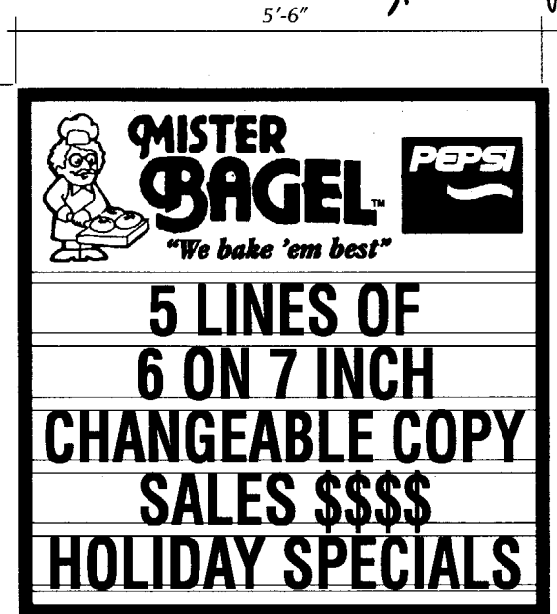

same size as old one, just relocated

4 5/8" L IN "MISTER"
7 7/8" L IN "BAGEL"


REINSTALL EXISTING 5'-6" X 5'-6" X _____" INTERNALLY ILLUMINATED SIGN
(2) FACE REPLACEMENT W/ R.A.B. TRACK

EXISTING CABINET & _____ RETAINER: _____ BRONZE
MOUNTING: NEW _____ SQ. POLE - BRONZE
O.A. HT. = 16'-0"
MR. BAGEL LOGO: PLEASE PROVIDE VECTOR ART & COLOR SPECS
12" PEPSI LOGO: GERBER TRANSLUCENT VINYL: RED & DARK BLUE
R.A.B. SECTION: B/G WHITE
5 LINES OF 6 ON 7 INCH CHANGEABLE LETTERS
MIN. VERTICAL V.O. 40"

Approved plan

PRESENTATION PRINT	DATE:
PROGRESS PRINT #.:	
CONSTRUCTION/MOUNTING:	DATE:
PERMIT/SITE PLAN:	DATE:
APPROVED MANUFACTURING:	
DATE:	
VOLTAGE:	
REVISIONS:	12/18/00 PLOT PLAN
	12/29/00 PLOT PLAN

PLEASE NOTE:
THIS IS A PROGRESS PRINT - FIELD MEASUREMENTS MAY OR MAY NOT NEED TO BE VERIFIED.
THIS DESIGN IS THE EXCLUSIVE PROPERTY OF BAILEY SIGN INCORPORATED AND ALL RIGHTS TO ITS USE OR REPRODUCTION ARE RESERVED.
COLORS SHOWN HERE ARE FOR DISTRIBUTION ONLY COLOR MATCH NUMBERS WILL BE NEEDED
IF AN ELECTRIC SIGN, THEN INSTALLATION MUST BE ACCOMPLISHED IN TOTAL COMPLIANCE WITH THE NATIONAL ELECTRIC CODE, THE REQUIREMENTS OF UNDERWRITERS LABORATORY, CANADIAN STANDARDS ASSOCIATION, AND APPLICABLE LOCAL CODES.

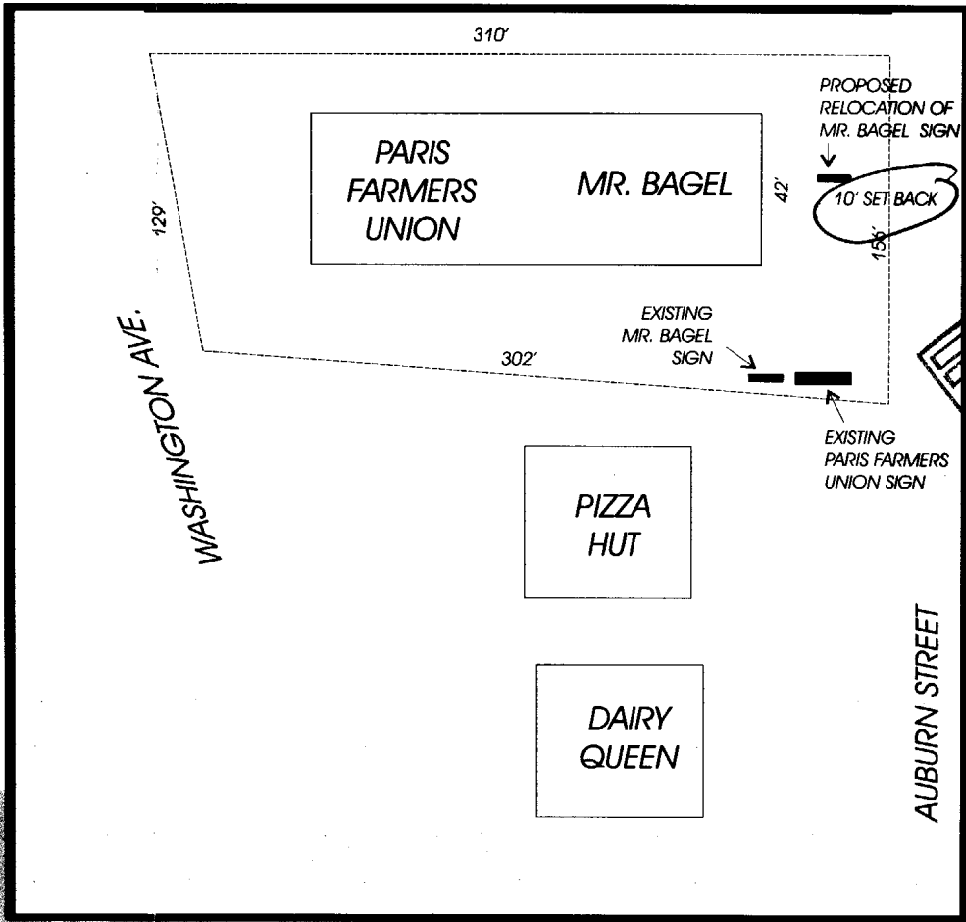

5 min OK
DEPT. OF BUILDING INSPECTION
CITY OF PORTLAND, ME
5 2000

CUSTOMER:	S&R - MR. BAGEL
LOCATION:	64 AUBURN STREET PORTLAND, MAINE
SALESPERSON:	R.B.
DRAWN BY:	L.W.M.
ACCEPTANCE SIGNATURE	DATE:
CLIENT:	
P.S. #	D-776
W.O. #	
SCALE	1/2" = 1'
DATE	11/28/00
DRAWING NO:	
SHEET	04488 R2




5'-6"

18'-0"

4'-0"

6"

5'-6"

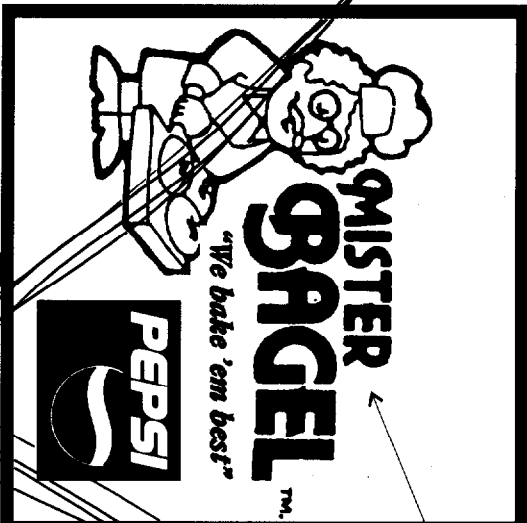

5 LINES OF
6 ON 7 INCH
CHANGEABLE COPY
SALES \$\$\$\$
HOLIDAYS HOURS

30.25
22.00
52.25

single format (of all sizes!)
NO
AREA = 32' MAX
Height = 16' high MAX
setback = 5' min - 10' shown

total 4x 5.5 = 22' 4"
= 35' 8" 5 - (55' 11" on line)

5x 5.5 = 30.25'

EXISTING CABINET & FACES W/ COLOR MR. BAGEL LOGO & LOGOTYPE (B&W SHOWN HERE)

REINSTALL EXISTING 5'-6" X 5'-6" X " INTERNALLY ILLUMINATED SIGN

[2] 18" PEPSI LOGOS


18" X 22.43" PEPSI LOGO: GERBER TRANSLUCENT VINYL: RED & DARK BLUE

TO BE FILED SURVEYED: AREA FOR LOGO MUST BE CONFIRMED
SPECS TO MATCH EXISTING CABINET COLOR & DEPTH

[1] D.F. 4'-0" X 5'-6" X " INTERNALLY ILLUMINATED SIGN

CABINET & RETAINER: BRONZE TO MATCH EXISTING TOP CABINET

R.A.B. SECTION: B/G WHITE
5 LINES OF 6 ON 7 INCH CHANGEABLE LETTERS
MIN. VERTICAL V.O. 40"

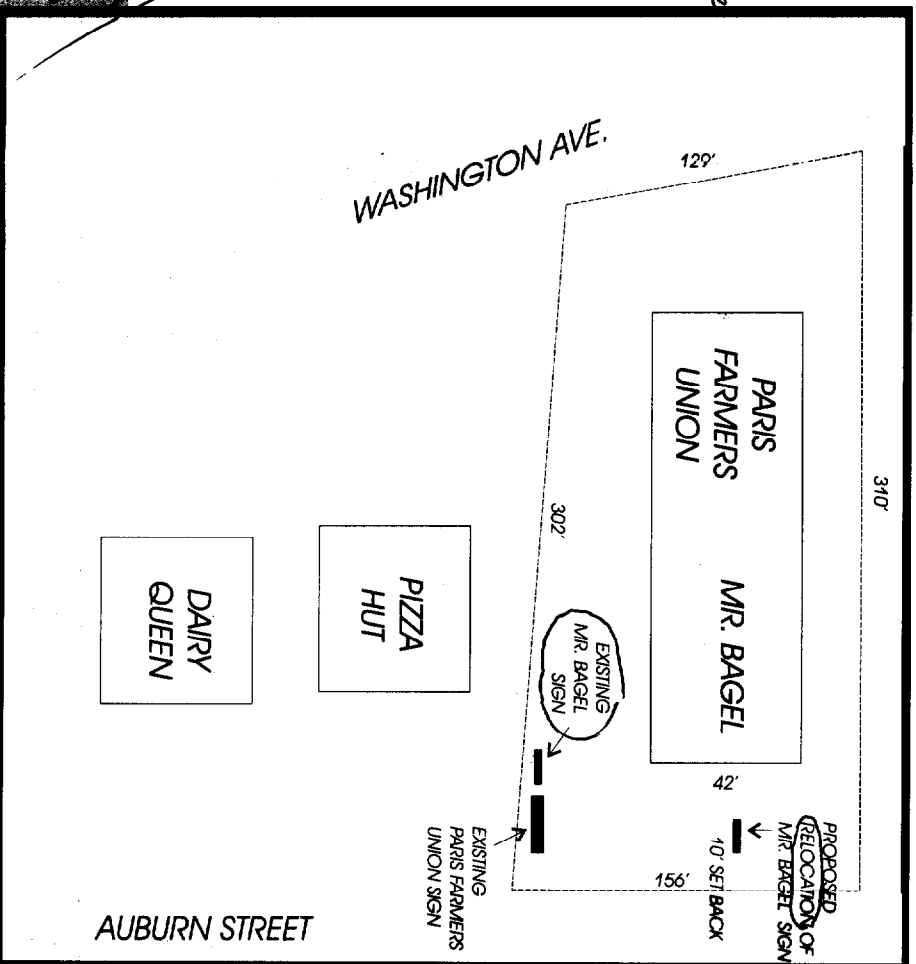

NOTES: DESIGN STATUS:

PRESENTATION PRINT DATE:

PROGRESS PRINT #:

CONSTRUCTION/MOUNTING: DATE:


PERMIT/SITE PLAN: DATE:

APPROVED MANUFACTURING:

DATE:

VOLTAGE:

REVISIONS: 12/18/00 PLOT PLAN

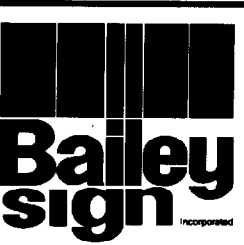

9 Thomas Drive
Col. Westbrook Executive Park
Westbrook, ME 04092
207-774-2843 / 1-800-539-SIGN
Fax: 774-1193
E-Mail: newsign@baileysign.com

COPYRIGHT 2000

PLEASE NOTE:

THIS IS A PROGRESS PRINT - FIELD MEASUREMENTS MAY OR MAY NOT NEED TO BE VERIFIED.
THIS DESIGN IS THE EXCLUSIVE PROPERTY OF BAILEY SIGN INCORPORATED AND ALL RIGHTS TO ITS USE OR REPRODUCTION ARE RESERVED.
COLORS SHOWN HERE ARE FOR DISTRIBUTION ONLY
IF AN ELECTRIC SIGN, THEN INSTALLATION MUST BE ACCOMPANIED BY THE COMPANY WITH THE NATIONAL ELECTRIC CODE, THE REQUIREMENTS OF UNDERWRITERS LABORATORY, CANADIAN STANDARDS ASSOCIATION, AND APPLICABLE LOCAL CODES.

CUSTOMER: S&R - MR. BAGEL

LOCATION: 64 AUBURN STREET PORTLAND, MAINE

SALESPERSON: R.B. DRAWN BY: L.W.M.

ACCEPTANCE SIGNATURE DATE:


RS. # D-776

W.O. #

SCALE 1/2" = 1' DATE 11/28/00

DRAWING NO: 04488 R1



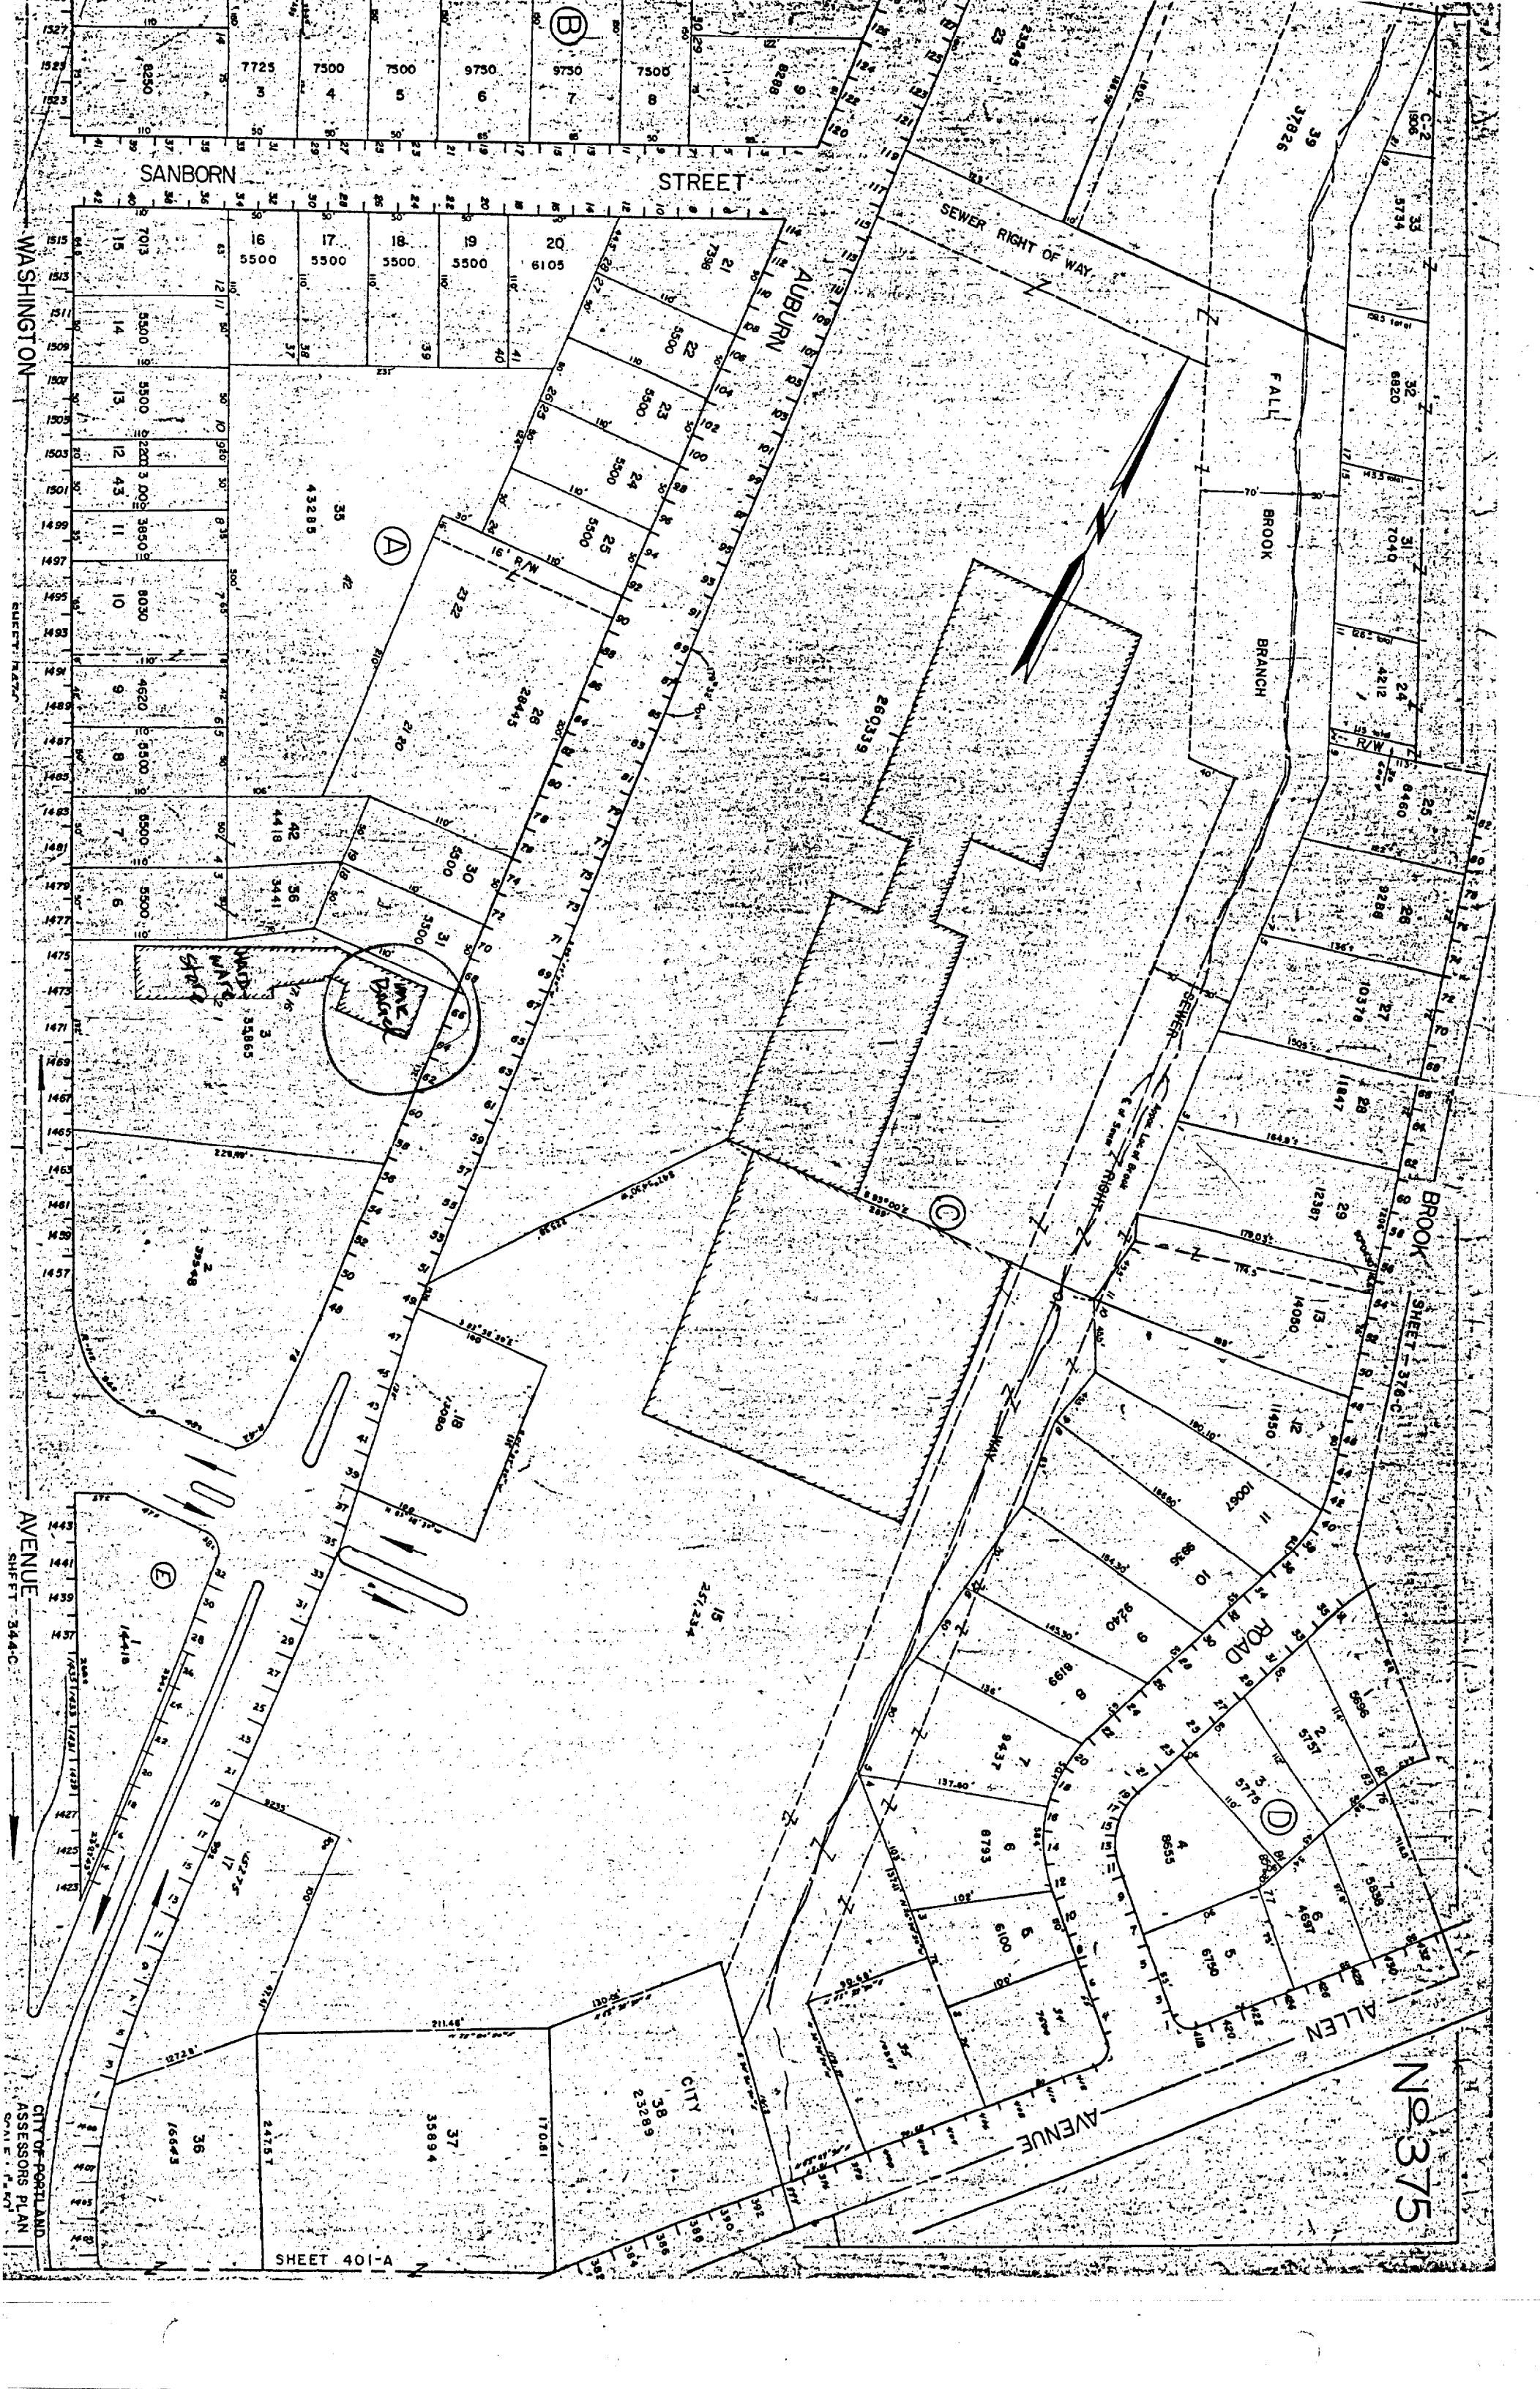

N 375

SHEET 401-A

CITY OF PORTLAND
ASSESSORS PLAN
SCALE: 1" = 40'

AVENUE
SHEET 344-C

SHEET 344-B

WASHINGTON

SANBORN

STREET

AUBURN

SEWER RIGHT OF WAY

FALL
BROOK
BRANCH

BROOK
SHEET 376-C-11

ALLEN
AVENUE

ROAD

CITY

(A)

(B)

(C)

(D)

(E)

Map containing numerous lot numbers (e.g., 1, 2, 3, 999, 1000).