



FIRE ALARM SYMBOL LEGEND	
[P]	PULL STATION
②	SMOKE DETECTOR
②	DUCT SMOKE DETECTOR
[M]	MONITOR MODULE
[R]	FAN SHUTDOWN RELAY
⊗	STROBE ONLY (WALL)
⊗/⊘	HORN/STROBE (CEILING)
⊗/⊘	HORN/STROBE (WALL)
Ⓜ	HEAT DETECTOR (CONV)

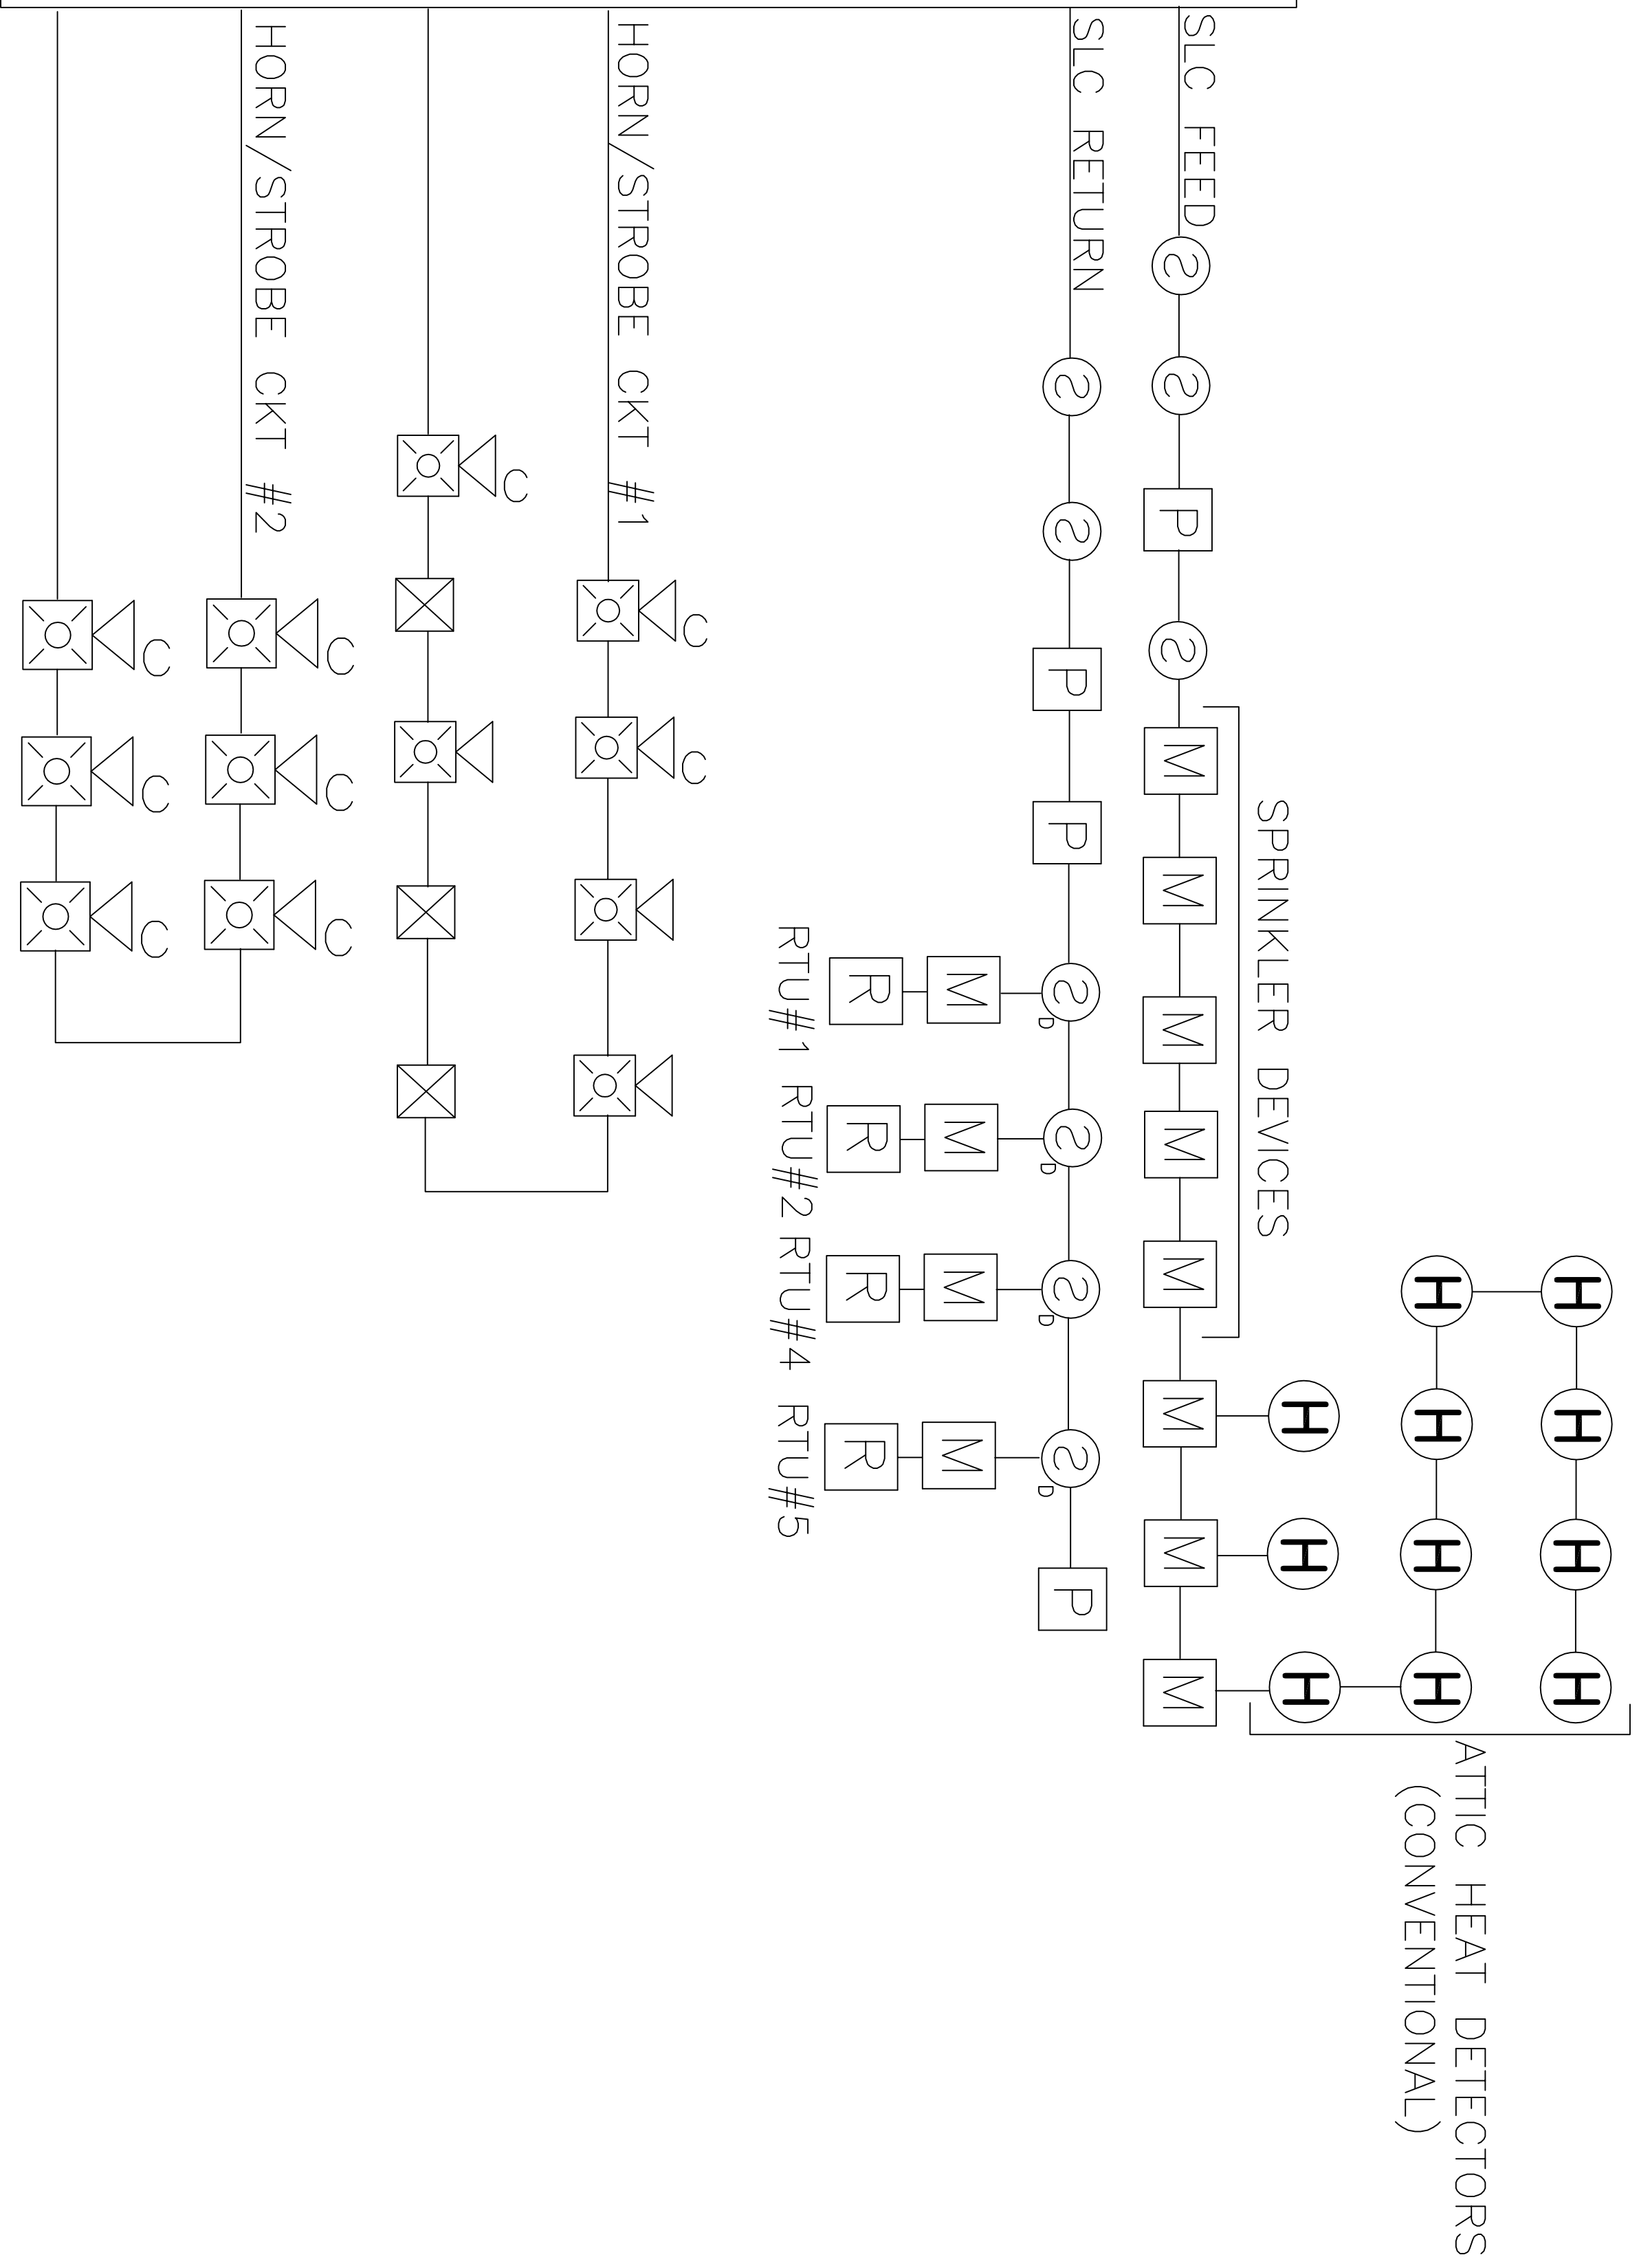


AS-BUILT 4/07/10

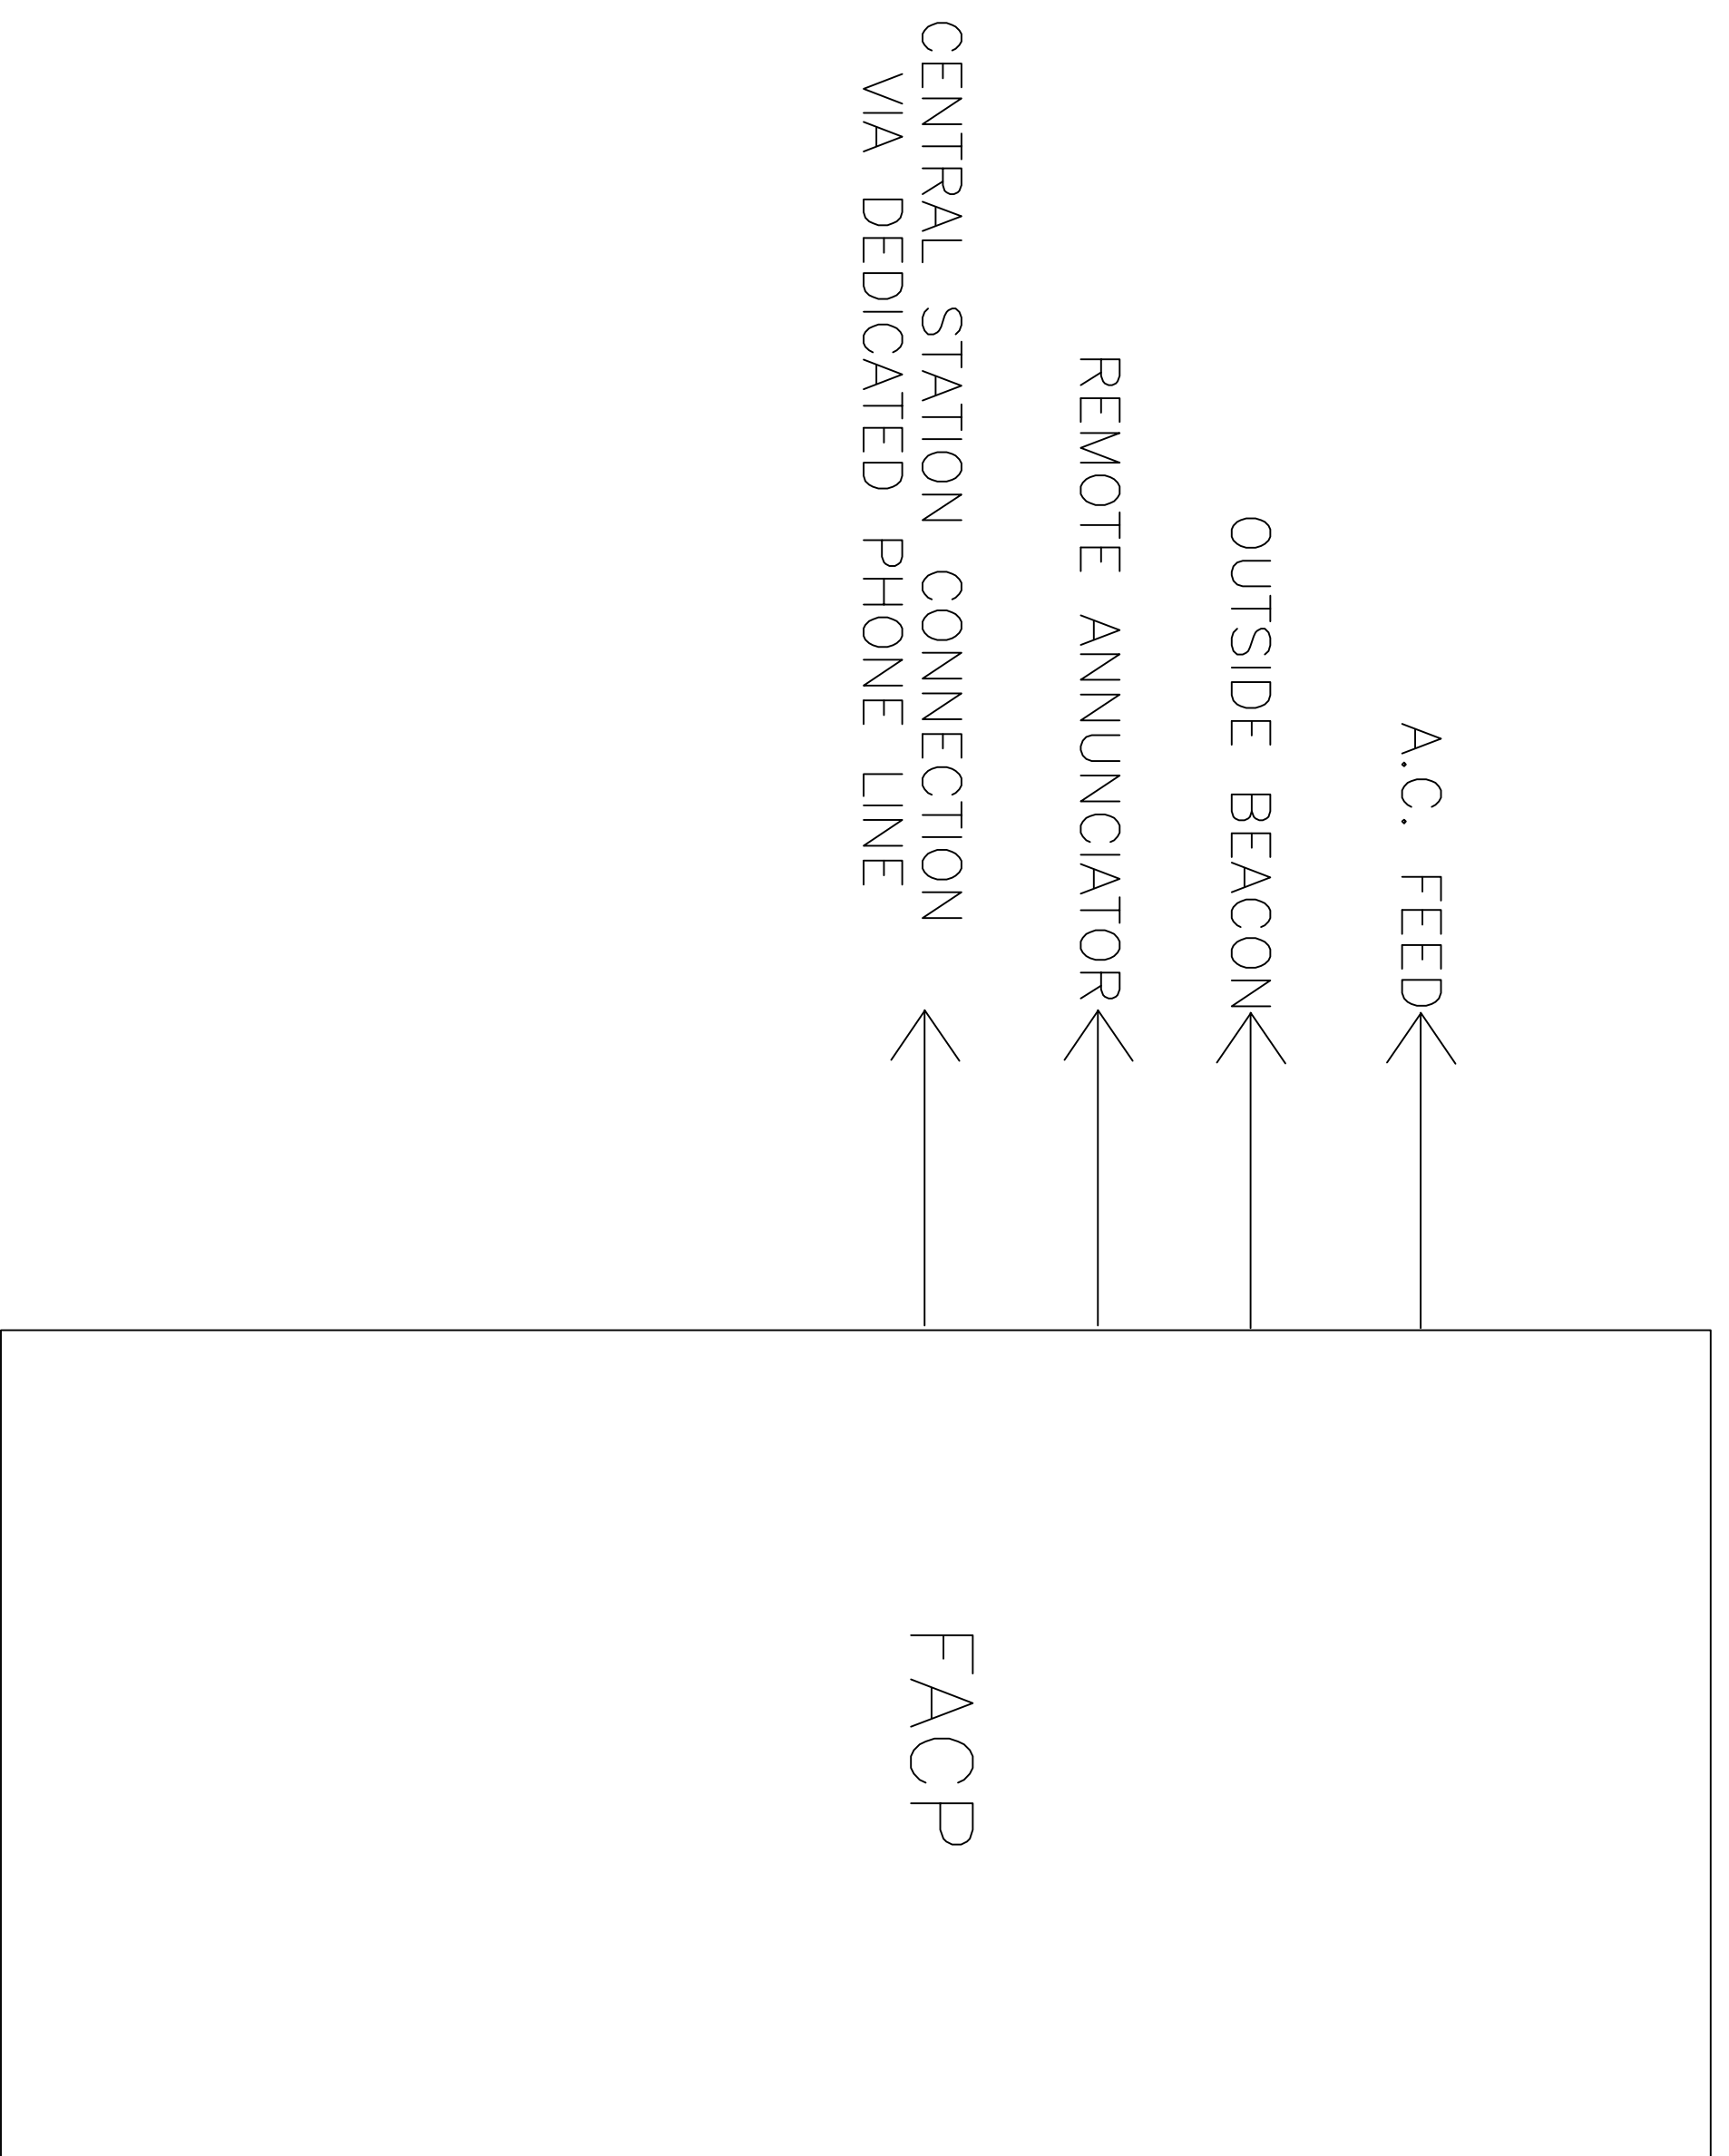

AFA PROTECTIVE SYSTEMS, INC.
200 HIGH ST. BOSTON, MA. 02110
PHONE: 617-772-5900 FAX: 617-772-5923

FIRE ALARM PRINT BY:
JOSEPH DONOVAN C.E.T.

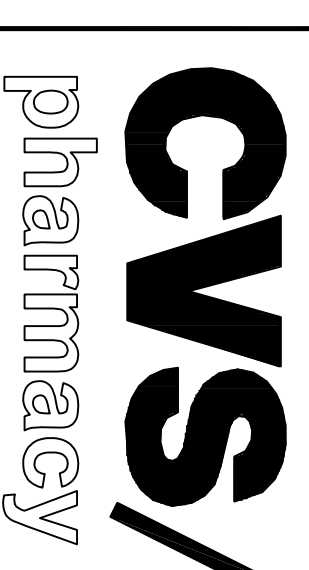

RELO

STORE NUMBER: 329

NORTHGATE PLAZA
91 AUBURN STREET
PORTLAND, MAINE

FIRE ALARM
RISER DIAGRAM