


12/21/09

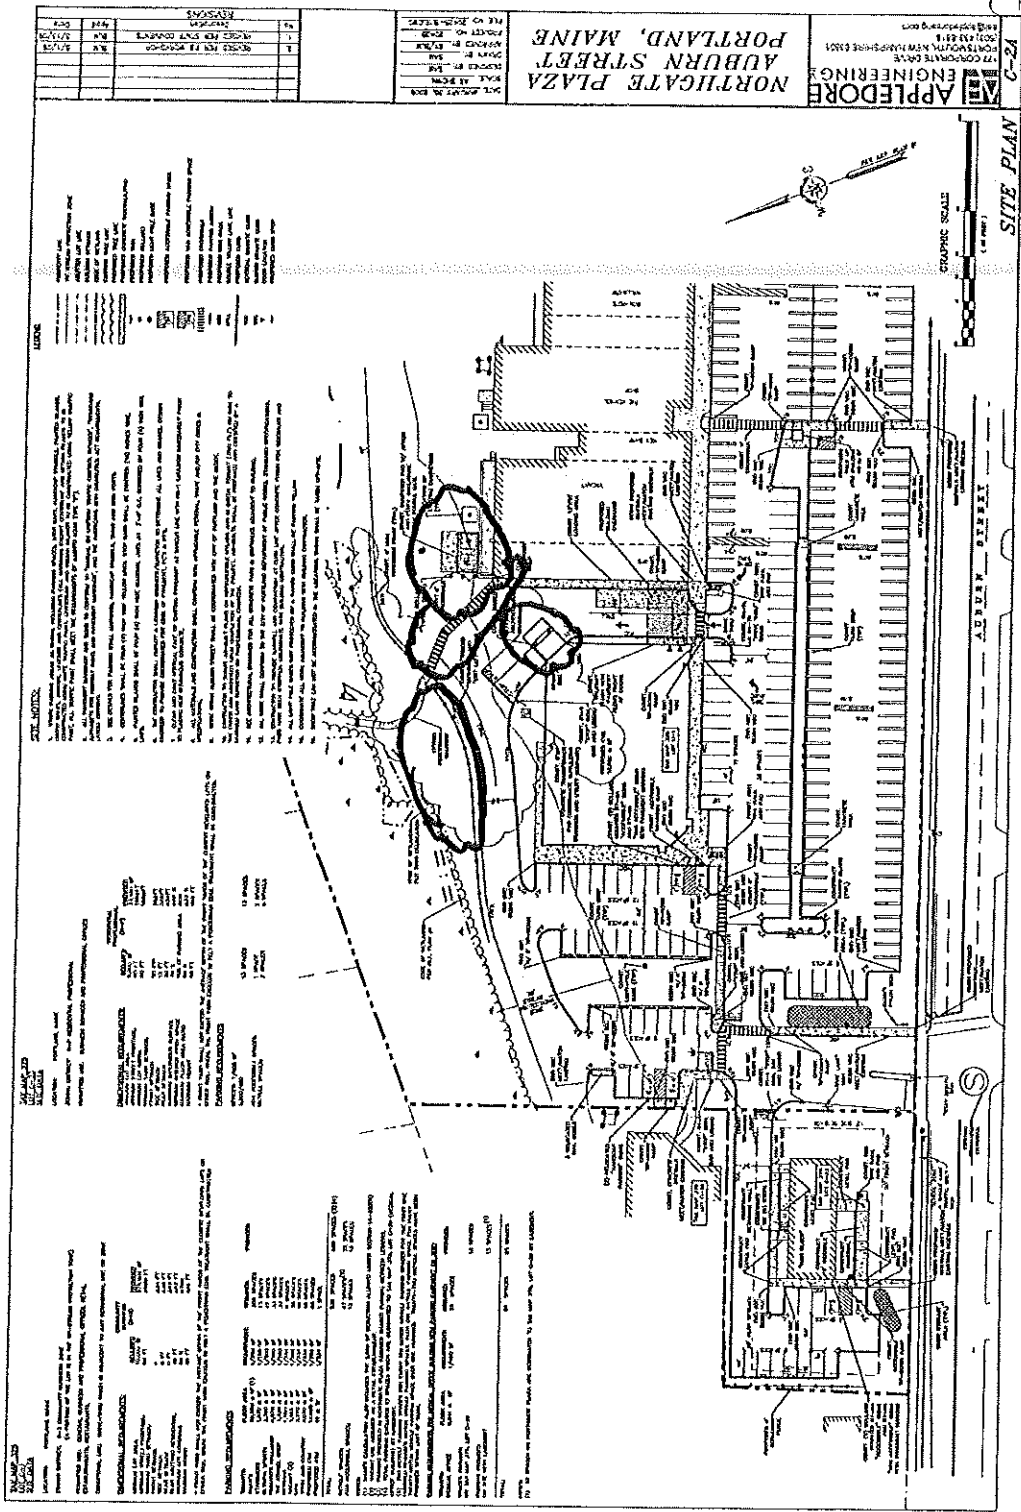

APPLEDORE ENGINEERING
 17 CORPORATE DRIVE
 PORTLAND, ME 04106
 PHONE: 603.733.8888
 FAX: 603.733.8889
 E-MAIL: apple@apple-engineering.com

NORTHGATE PLAZA
AUBURN STREET
PORTLAND, MAINE

DATE: 12/21/09
 DRAWN BY: [Name]
 CHECKED BY: [Name]
 PROJECT NO.: [Number]

REVISIONS

NO.	DATE	DESCRIPTION
1	12/21/09	ISSUED FOR PERMITS
2	12/21/09	ISSUED FOR PERMITS
3	12/21/09	ISSUED FOR PERMITS

NOTES

1. ALL DIMENSIONS ARE IN FEET AND INCHES. DIMENSIONS IN PARENTHESES ARE IN FEET.
2. ALL DIMENSIONS ARE TO FACE UNLESS OTHERWISE NOTED.
3. ALL DIMENSIONS ARE TO FACE UNLESS OTHERWISE NOTED.
4. ALL DIMENSIONS ARE TO FACE UNLESS OTHERWISE NOTED.
5. ALL DIMENSIONS ARE TO FACE UNLESS OTHERWISE NOTED.
6. ALL DIMENSIONS ARE TO FACE UNLESS OTHERWISE NOTED.
7. ALL DIMENSIONS ARE TO FACE UNLESS OTHERWISE NOTED.
8. ALL DIMENSIONS ARE TO FACE UNLESS OTHERWISE NOTED.
9. ALL DIMENSIONS ARE TO FACE UNLESS OTHERWISE NOTED.
10. ALL DIMENSIONS ARE TO FACE UNLESS OTHERWISE NOTED.

EXISTING CONDITIONS

1. ALL EXISTING CONDITIONS ARE AS SHOWN ON THE ATTACHED SURVEY AND AS-BUILT DRAWINGS.

2. ALL EXISTING CONDITIONS ARE AS SHOWN ON THE ATTACHED SURVEY AND AS-BUILT DRAWINGS.

3. ALL EXISTING CONDITIONS ARE AS SHOWN ON THE ATTACHED SURVEY AND AS-BUILT DRAWINGS.

4. ALL EXISTING CONDITIONS ARE AS SHOWN ON THE ATTACHED SURVEY AND AS-BUILT DRAWINGS.

5. ALL EXISTING CONDITIONS ARE AS SHOWN ON THE ATTACHED SURVEY AND AS-BUILT DRAWINGS.

PROPOSED CONDITIONS

1. ALL PROPOSED CONDITIONS ARE AS SHOWN ON THE ATTACHED SURVEY AND AS-BUILT DRAWINGS.

2. ALL PROPOSED CONDITIONS ARE AS SHOWN ON THE ATTACHED SURVEY AND AS-BUILT DRAWINGS.

3. ALL PROPOSED CONDITIONS ARE AS SHOWN ON THE ATTACHED SURVEY AND AS-BUILT DRAWINGS.

4. ALL PROPOSED CONDITIONS ARE AS SHOWN ON THE ATTACHED SURVEY AND AS-BUILT DRAWINGS.

5. ALL PROPOSED CONDITIONS ARE AS SHOWN ON THE ATTACHED SURVEY AND AS-BUILT DRAWINGS.

10/20/15