


ALL DRAWINGS, PLANS, SKETCHES ETC. ARE PROVIDED TO OUR CLIENTS BASED UPON INFORMATION PROVIDED BY THE CLIENT AND DRAWN IN ACCORDANCE WITH COMMON BUILDING PRACTICES. NONE OF THE EMPLOYEES OF MORIN DRAFTING ARE REGISTERED ARCHITECTS, STRUCTURAL ENGINEERS OR PROFESSIONAL LAND SURVEYORS. ALL CODES SHALL BE REVIEWED AND APPROVED BY APPROPRIATE REGISTERED PROFESSIONAL. IF NOT, IT SHALL BE THE RESPONSIBILITY OF THE CONTRACTOR OR OWNER. ALL NOTING, SPECIFICATIONS AND DIMENSIONS SHALL BE VERIFIED BY CLIENT AND/OR CONTRACTOR BEFORE WORK BEGINS. ALL DIMENSIONS SHALL BE BROUGHT TO THE ATTENTION OF MORIN DRAFTING AFTER REVIEW. IF PLANS ARE NOT VERIFIED BY CLIENT AND/OR CONTRACTOR BEFORE CONSTRUCTION BEGINS, MORIN DRAFTING SHALL BE HELD HARMLESS. IN ALL EVENTS DAMAGES SHALL BE LIMITED TO THE COST OF THE PLANS. MORIN DRAFTING ASSUMES NO LIABILITY FOR CONSTRUCTION DEFECTS, CHANGES AND/OR REVISIONS TO THE PLANS. ALL PLANS ARE THE PROPERTY OF MORIN DRAFTING.

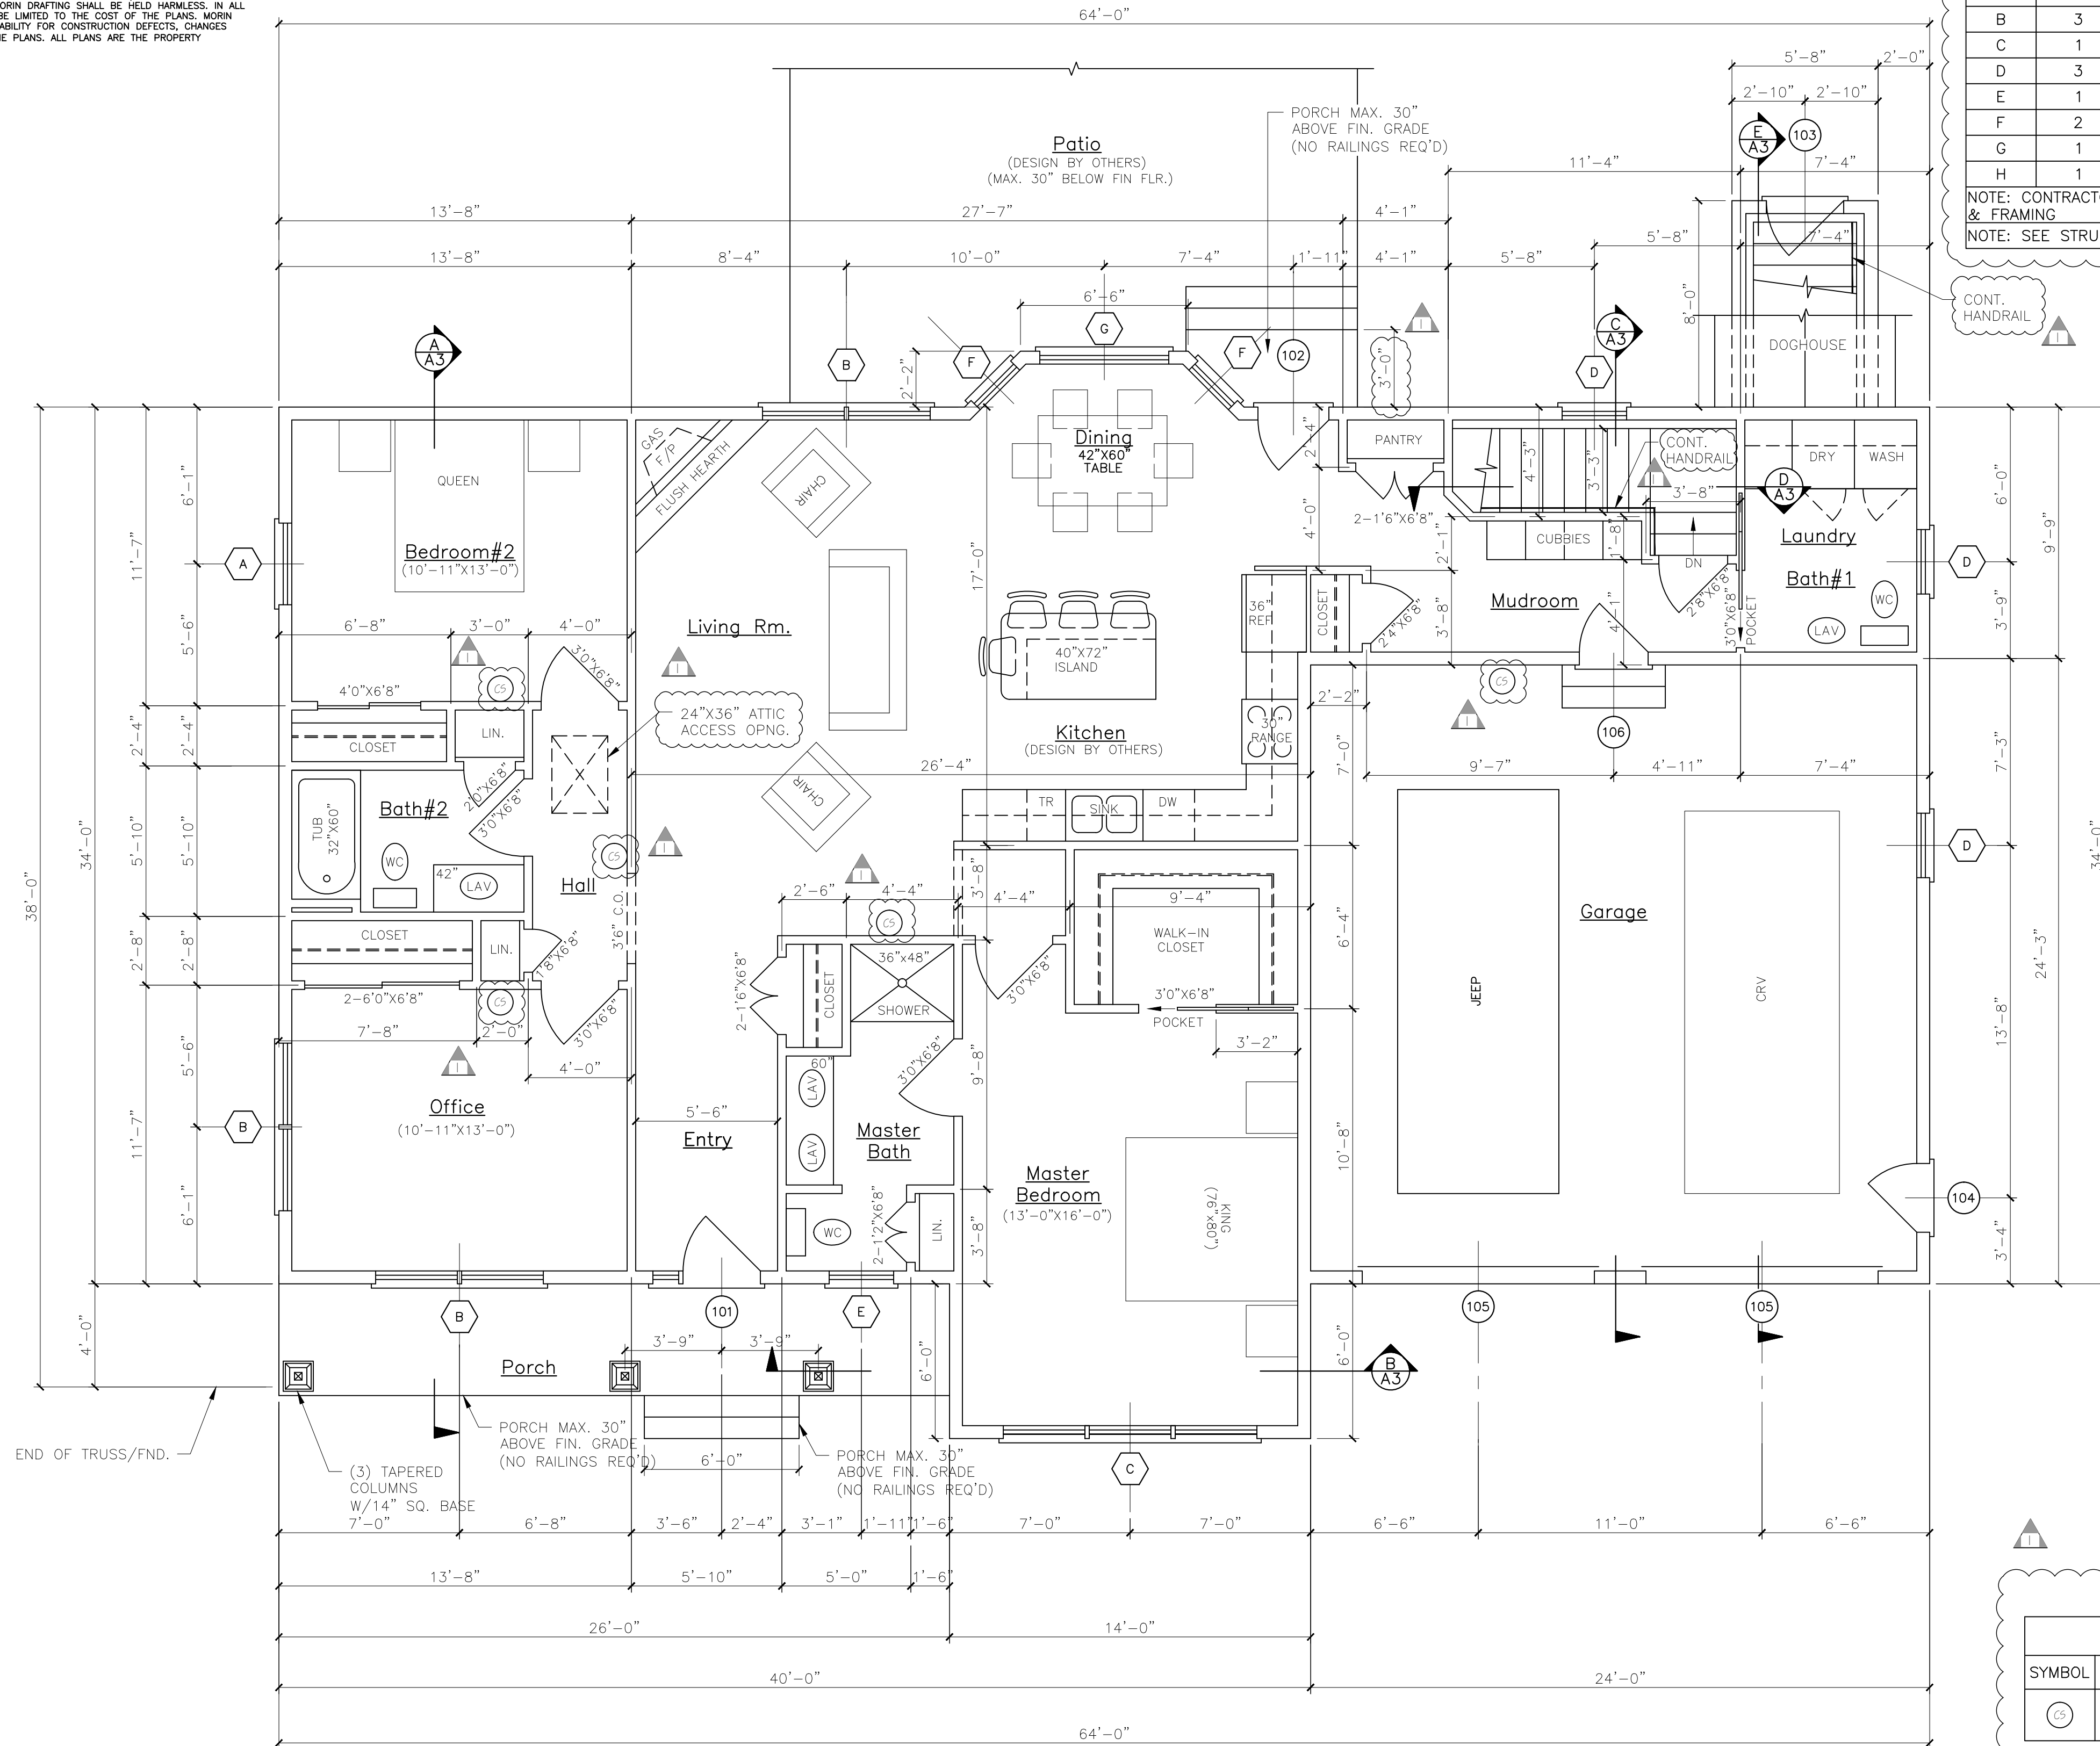

FIRST FLOOR PLAN
SCALE: 1/4"=1'-0" (TOTAL FINISHED SQ. 1702)

| WINDOW SCHEDULE | | | | | | | | | |
|-----------------|------|----------------|-------------|-----------------------|---------|--------|----------|----------------------|--|
| LTR. | QTY. | UNIT TYPE | UNIT NUMBER | R.O. SIZE (WxH) | GLAZING | EGRESS | MANUF. | REMARKS | |
| A | 1 | DOUBLE HUNG | TW3046 | 3'-2 1/8"x4'-8 7/8" | INSUL. | YES | ANDERSEN | TILT-WASH,400 SERIES | |
| B | 3 | DOUBLE HUNG | TW3046-2 | 6'-3 15/16"x4'-8 7/8" | INSUL. | YES | ANDERSEN | TILT-WASH,400 SERIES | |
| C | 1 | DOUBLE HUNG | TW3046-3 | 9'-5 3/4"x4'-8 7/8" | INSUL. | - | ANDERSEN | TILT-WASH,400 SERIES | |
| D | 3 | DOUBLE HUNG | TW2442 | 2'-6 1/8"x4'-4 7/8" | INSUL. | - | ANDERSEN | TILT-WASH,400 SERIES | |
| E | 1 | DOUBLE HUNG | TW24310 | 2'-6 1/8"x4'-0 7/8" | INSUL. | - | ANDERSEN | TILT-WASH,400 SERIES | |
| F | 2 | DOUBLE HUNG | TW2046 | 2'-2 1/8"x4'-8 7/8" | INSUL. | - | ANDERSEN | TILT-WASH,400 SERIES | |
| G | 1 | PICTURE | DHP41046 | 4'-11 7/8"x4'-8 7/8" | INSUL. | - | ANDERSEN | 400 SERIES | |
| H | 1 | AWNING (FIXED) | A21 | 2'-0 5/8"x2'-0 5/8" | INSUL. | - | ANDERSEN | 400 SERIES | |

NOTE: CONTRACTOR SHALL VERIFY WINDOW UNIT NUMBERS, SIZES, GRILLE STYLES, AND ROUGH OPENINGS PER MANUFACTURER'S SPECIFICATIONS BEFORE ORDERING & FRAMING
NOTE: SEE STRUCTURAL DRAWINGS FOR HEADER SIZES

CONSTRUCTION STANDARD NOTES:

(THE FOLLOWING NOTES ARE FOR INFORMATION USE ONLY. THEY SHOULD NOT BE INTERPRETED AS CODE OR VIEWED AS THE COMPLETE CODE. THE CONTRACTOR SHALL BE RESPONSIBLE FOR REVIEWING THE CITY ADOPTED CODE BEFORE ANY CONSTRUCTION BEGINS AND SHALL FULLY IMPLEMENT THE CODE DURING CONSTRUCTION.)

STAIRS

1. ALL STAIR SHALL COMPLY WITH THE CITY ADOPTED STAIR CODE. OPEN SIDES OF STAIRS WITH TOTAL RISE OF MORE THAN 30" ABOVE FLOOR OR GRADE SHALL HAVE GUARDS NOT LESS THAN 34" NOR MORE THAN 38" ABOVE SURFACE OF TREAD. OPENINGS BETWEEN BALUSTERS SHALL BE LESS THAN 4". GUARDS SHALL NOT BE CONSTRUCTED WITH HORIZONTAL RAILS OR ORNAMENTAL PATTERNS THAT RESULT IN A LADDER EFFECT.
2. ALL PORCHES, BALCONIES, & DECKS AND RAMPED SURFACES MORE THAN 30" ABOVE FLOOR OR GRADE SHALL HAVE GUARDS NOT LESS THAN 34" IN HEIGHT. OPENINGS BETWEEN BALUSTERS SHALL BE LESS THAN 4". LADDERS SHALL NOT BE CONSTRUCTED WITH HORIZONTAL RAILS OR ORNAMENTAL PATTERNS THAT RESULT IN A LADDER EFFECT.
3. ALL STAIRS SHALL MAINTAIN A MINIMUM OF 36" IN CLEAR WIDTH AT ALL POINTS ABOVE, THE PERMITTED HANDRAIL HEIGHT AND BELOW THE REQUIRED HEADROOM HEIGHT. HANDRAILS SHALL NOT PROJECT MORE THAN 4.5" ON EITHER SIDE AND MAINTAIN MINIMUM CLEAR WIDTH AT AND BELOW THE HANDRAIL HEIGHT, INCLUDING TREAD AND LANDINGS. STAIR WIDTH SHALL NOT BE LESS THAN 31.5", WHERE A HANDRAIL IS INSTALLED ON ONE SIDE AND 27" WHERE HANDRAILS ARE ON BOTH SIDES. THE MIN. HEADROOM OF THE STAIRWAY SHALL NOT BE LESS THAN 6'-8" MEASURED VERTICALLY FROM THE SLOPED PLANE ADJOINING THE TREAD RISING OR FROM SURFACE OF LANDING OR PLATFORM.
4. THE MAXIMUM RISER HEIGHT SHALL BE 7 3/4" AND MINIMUM SHALL BE 4". THE MINIMUM TREAD DEPTH SHALL BE 10" (MEASURED FROM LEADING EDGE OF TREAD TO LEADING EDGE OF TREAD). A RISER NOT BE LESS THAN 3/4" BUT NOT MORE THAN 1/4" SHALL BE REQUIRED ON TREADS WHERE THE DEPTH IS LESS THAN 11". OPENINGS IN RISERS SHALL NOT EXCEED 4". THE GREATEST TREAD DEPTH AND RISER HEIGHT WITHIN ANY FLIGHT OF STAIRS SHALL NOT EXCEED THE SMALLEST BY MORE THAN 3/8".

SMOKE/CO ALARMS AND SPRINKLERS

1. ALL ALARMS SHALL BE A COMBINATION SMOKE AND CO ALARMS AND SHALL BE LISTED IN ACCORDANCE WITH UL 217. THEY SHALL BE INSTALLED IN PROVISION TO THE CODE AND THE HOUSEHOLD FIRE WARNING EQUIPMENT PROVISIONS OF NFPA 72. SMOKE ALARMS SHALL BE INSTALLED IN EACH SLEEPING ROOM AND SMOKE/CO ALARMS SHALL BE INSTALLED OUTSIDE EACH SEPARATE SLEEPING AREA IN THE IMMEDIATE VICINITY OF THE BEDROOMS. ALSO ONE SHALL BE INSTALLED ON EACH ADDITIONAL STORY OF THE DWELLING, INCLUDING BASEMENT. IN NEW CONSTRUCTION SMOKE/CO ALARMS SHALL BE CONNECTED TO THE PRIMARY BUILDING POWER AND USE A BATTERY BACKUP.
2. THE ENTIRE STRUCTURE SHALL BE SPRINKLED IN COMPLIANCE WITH NFPA 130, PER CITY CODE (NFPA 101 2009 ED.) WITH A NFPA 13R SPRINKLER SYSTEM DESIGNED AND INSTALLED BY A LICENSED SPRINKLER COMPANY.

WINDOWS

1. BASEMENTS AND EVERY SLEEPING ROOM SHALL HAVE AT LEAST ONE OPERABLE EMERGENCY ESCAPE AND RESCUE OPENING EXTING DIRECTLY TO THE OUTSIDE. EGRESS WINDOWS SHALL MEET NET OPENING REQUIREMENTS OF 5.0 SQ. FT. (GRADE FLOOR) AND 5.7 SQ. FT. (OTHER FLOORS) WITH A MIN. CLEAR OPENING HEIGHT OF 24", A MIN. CLEAR OPENING WIDTH OF 20" AND A MAXIMUM SILL HEIGHT OF 44".
2. TEMPERED GLAZING SHALL BE INSTALLED IN THE FOLLOWING CONDITIONS:
 - GLAZING IN BATHROOMS WHERE IT IS LOWER THAN 60" FROM ANY VERTICAL SURFACE.
 - GLAZING LESS THAN 60" ABOVE ANY SURFACE, ADJACENT TO A DOOR WHERE THE NEAREST VERTICAL EDGE IS WITHIN A 24" ARC OF THE DOOR IN CLOSED POSITION.
 - GLAZING BOTTOM LESS THAN 24" ABOVE THE FLOOR.
 - GLAZING ENCLOSING STAIRWAY LANDINGS OR WITHIN 60" OF TOP & BOTTOM OF STAIRWAYS WHERE THE BOTTOM EDGE OF THE GLASS IS LESS THAN 60" ABOVE THE WALKING SURFACE.
3. FALL PREVENTION CLIPS SHALL BE INSTALLED ON ALL WINDOWS WHERE THE SILL IS LOCATED MORE THAN 72" ABOVE FINISH FLOOR OR SURFACE BELOW, AND THE LOWEST PART OF THE CLEAR OPENING OF THE WINDOW IS LESS THAN 24" ABOVE FINISH FLOOR.

INSULATION & VENTILATION

1. COMPLY WITH MAINE UNIFORM BUILDING AND ENERGY CODE
LOCATION: CUMBERLAND COUNTY, MAINE
HDD: 7,000-8,400
MINIMUM INSULATION R-VALUES:
GLAZING: U=0.35 MINIMUM
SKYLIGHT: R=40
WOOD FRAMED WALLS: R-21
WOOD FLOORS (OVER HEATED SPACE): R30
BASEMENT WALLS: R-15 CONTINUOUS OR 19 CAVITY
SLAB (HEATED SPACE): R-VALUE & DEPTH: R-10 TO 4 FT. PERIMETER
CEILING: R-49
CRAWL SPACE: R-10 CONTINUOUS OR 13 CAVITY
2. UNHEATED CRAWL SPACES SHALL HAVE VENTILATION OPENINGS OF A MINIMUM OF 1 SQ. FT. FOR EACH 150 SQ. FT. OF UNDER FLOOR AREA AND SHALL BE WITHIN 3'-0" OF EACH CORNER OF THE BUILDING. UNHEATED CRAWL SPACES SHALL HAVE A VAPOR RETARDER WITH 6" OVERLAPPED SEALED SEAMS AND EDGES THAT SHALL EXTEND UP 6" ON THE STEM WALLS WHICH SHALL BE ATTACHED AND SEALED. UNHEATED CRAWL SPACE SHALL HAVE A CONTINUOUSLY OPERATING MECHANICAL EXHAUST SYSTEM OR CONDITIONED AIR SUPPLY PER IRC CODE REQUIREMENTS.

| LEGEND | | |
|--------|-------------------|---------|
| SYMBOL | DESCRIPTION | REMARKS |
| ⊙ | CO/SMOKE DETECTOR | |

| EXTERIOR DOOR SCHEDULE | | | | | | | | | | | |
|------------------------|------|-------------|-------|--------------|-----------|-----------|------------|-------------|---------|----------|-------------------------|
| NO. | QTY. | SIZE (WxH) | TYPE | MANUFACTURER | MODEL NO. | STYLE | INSULATION | FIRE RATING | GLAZING | SWING | REMARKS |
| 101 | 1 | 3'-0"x6'-8" | STEEL | - | - | 3/4 VIEW | R7 | - | INSUL. | SEE PLAN | (1) 12" SIDELIGHT |
| 102 | 1 | 2'-9"x6'-8" | TRIUM | ANDERSEN | FWH29611 | FULL VIEW | R7 | - | INSUL. | SEE PLAN | 400 SERIES |
| 103 | 1 | 3'-0"x6'-8" | STEEL | - | - | 6 PANEL | R7 | - | INSUL. | SEE PLAN | - |
| 104 | 1 | 2'-8"x6'-8" | STEEL | - | - | 9-LITE | R7 | - | INSUL. | SEE PLAN | - |
| 105 | 2 | 9'-0"x8'-0" | STEEL | - | - | O.H. DOOR | R7 | - | INSUL. | - | STYLE SELECTED BY OWNER |
| 106 | 1 | 3'-0"x6'-8" | STEEL | - | - | 6 PANEL | R7 | 1 HR. | INSUL. | SEE PLAN | W/CLOSER |

NOTE: CONTRACTOR SHALL SPECIFY HARDWARE PER BUILDING CODE REQUIREMENTS AND VERIFY TYPE WITH OWNER
NOTE: CONTRACTOR SHALL VERIFY DOOR QUANTITIES, SIZES, SWINGS, CODE REQUIREMENTS, & RGH. OPNGS. PER MANUFACTURER'S SPECIFICATIONS BEFORE ORDERING & FRAMING
NOTE: SEE FLOOR PLANS FOR INTERIOR DOOR SIZES, SWINGS, TYPES. CONTRACTOR SHALL VERIFY WITH OWNER PRIOR TO PLACING ORDER.

THESE PLANS HAVE BEEN LICENSED TO THE CUSTOMER FOR USE IN CONSTRUCTION OF ONE BUILDING ONLY AND ARE SUBJECT TO THE CONDITIONS OF LICENSE ADOPTED BY THE CUSTOMER. USE OF ANY PART OF THE PLANS BY ANY PARTY OTHER THAN THE CUSTOMER, EXCEPT ON LOAN BY THE CUSTOMER TO THIRD PARTIES NECESSARY TO ASSIST THE CUSTOMER IN USING THE PLANS, SUCH AS CONTRACTORS AND SUBCONTRACTORS, IS STRICTLY PROHIBITED. THE PLANS MAY NOT BE RE-USED OR COPIED IN WHOLE OR IN PART, WITHOUT WRITTEN PERMISSION FROM MORIN DRAFTING WHICH RETAINS COPYRIGHTS TO AND OWNERSHIP OF THE PLANS.

ISSUED FOR CONSTRUCTION
03-30-2016

0 2' 4' 8'
SCALE: 1/4" = 1'-0"

REVISIONS:
1 REVISED PER CITY REVIEW COMMENTS 03-30-2017

| |
|--|
| White Homes, Inc. 878-3361 |
| MORIN DRAFTING 318-1177 |
| DORLER RESIDENCE MORNINGSTAR LANE, PORTLAND, ME. (LOT NO. 3) |
| FLOOR PLAN |
| DRAWN: J. MORIN SCALE: 1/4"=1'-0" DATE: 05-22-2016 PLAN NO: |

A2