


ALL DRAWINGS, PLANS, SKETCHES ETC. ARE PROVIDED TO OUR CLIENTS BASED UPON INFORMATION PROVIDED BY THE CLIENT AND DRAWN IN ACCORDANCE WITH COMMON BUILDING PRACTICES. NONE OF THE EMPLOYEES OF MORIN DRAFTING ARE REGISTERED ARCHITECTS, STRUCTURAL ENGINEERS OR PROFESSIONAL LAND SURVEYORS. ALL CODES SHALL BE REVIEWED AND APPROVED BY APPROPRIATE REGISTERED PROFESSIONALS. IF NOT, IT SHALL BE THE RESPONSIBILITY OF THE CONTRACTOR OR OWNER. ALL NOTING, SPECIFICATIONS AND DIMENSIONS SHALL BE VERIFIED BY CLIENT AND/OR CONTRACTOR BEFORE WORK BEGINS. ALL DIMENSIONS SHALL BE BROUGHT TO THE ATTENTION OF MORIN DRAFTING AFTER REVIEW. IF PLANS ARE NOT VERIFIED BY CLIENT AND/OR CONTRACTOR BEFORE CONSTRUCTION BEGINS, MORIN DRAFTING SHALL BE HELD HARMLESS. IN ALL EVENTS DAMAGES SHALL BE LIMITED TO THE COST OF THE PLANS. MORIN DRAFTING ASSUMES NO LIABILITY FOR CONSTRUCTION DEFECTS, CHANGES AND/OR REVISIONS TO THE PLANS. ALL PLANS ARE THE PROPERTY OF MORIN DRAFTING.

FOUNDATION NOTES:

1. (DO NOT) BACKFILL MORE THAN 3'-0" BEFORE 1ST FLR. FRAMING-FOIST & SUBFLOOR IS COMPLETE.
2. ALL FINISH WALL, FOOTING & FLOOR HEIGHTS & ELEVATIONS SHALL BE VERIFIED IN THE FIELD BY CONTRACTOR PRIOR TO EXCAVATION.
3. BASEMENT WINDOW LOCATIONS & AND ROUGH OPNGS. SHALL BE CHECKED & VERIFIED IN FIELD WITH CONTRACTOR. OTHERWISE IF NOT SHOWN SHALL BE DETERMINED IN FIELD BY CONTRACTOR.
4. ALL ANCHOR BOLTS SHALL BE 1/2"x1'-0" HOOKED OR EQUIVALENT. 4'-0" MAX. OC. & 1'-0" MIN. FROM ALL CORNERS.
5. ALL LALLY COLUMNS, FOOTINGS, WALLS & BEAMS SHALL BE CHECKED & ENGINEERED BY CONTRACTOR BEFORE FORMS HAVE BEEN SET.
6. ALL DAYLIGHT BASEMENT CONSIDERATIONS TO BE DETERMINED IN FIELD BY CONTRACTOR IF APPLICABLE.
7. ALL CONSIDERATIONS FOR UTILITIES ARE THE RESPONSIBILITY OF THE CONTRACTOR.
8. CONTRACTOR SHALL CHECK ALL DIMENSIONS WITH FLOOR PLAN & VERIFY PRODUCT (IE. BULKHEAD, DOORS ETC.) DIMENSIONS & SPECS. BEFORE FORMS ARE SET.
9. CONTRACTOR SHALL ADJUST WALL AND FOOTINGS SIZES TO SOIL BEARING CAPACITIES AS REQ'D.
10. DRAIN TILE SHALL BE PLACED ON INTERIOR AND EXTERIOR OF FOUNDATION. ALL DRAIN TILE PIPE SHALL BE WRAPPED IN FILTER FABRIC. FABRIC SHALL ENCASE 3/4" CRUSHED STONE AROUND ENTIRE DIA. PIPE DRAIN TO ATMOSPHERE OR TO DRY WELL.
11. SEE ARCHITECTURAL FOR DIMENSIONS & ADDITIONAL INFORMATION.
12. ALL CONCRETE SLABS SHALL HAVE (C) SAW-CUT CONTROL JOINTS @ 12'-0" MAX. SAWS WITHIN 6 HOURS OF SLAB POUR. UNLESS NOTED OTHERWISE.
13. ALL EXTERIOR CONCRETE FOUNDATION WALLS, BELOW GRADE, SHALL BE COATED WITH BITUMINOUS DAMPPROOFING INSTALLED PER MANUF. SPEC.
14. ADDITIONAL DRAINAGE MAYBE REQUIRED. SUMP PITT CONSULT CONTRACTOR FOR PROFESSIONAL RECOMMENDATIONS.
15. STEP FOOTINGS AS REQUIRED TO ACHIEVE FOOTING FROST DEPTH.
16. 4" CONC. SLAB ON 6 MIL. VAPOR BARRIER ON MIN. 8" DEEP 3/4" CRUSHED STONE.
17. PITCH ALL GARAGE SLABS 1/4"/FT. TOWARD OVERHEAD DOOR.
18. CONCRETE MIN. 3000 PSF FOR WALLS AND FOOTINGS.
19. 2"x4" TAPERED KEYWAY AT ALL WALL TO FOOTING CONNECTIONS.
20. 4" DIA. PERFORATED RADON PIPES UNDER SLAB @ 20" MAX. CONNECTED TO UNDERDRAIN. PROVIDE TWO (2) STUBS FOR FUTURE VENTILATION.
21. PITCH ALL EXTERIOR SLABS 1/4"/FT.

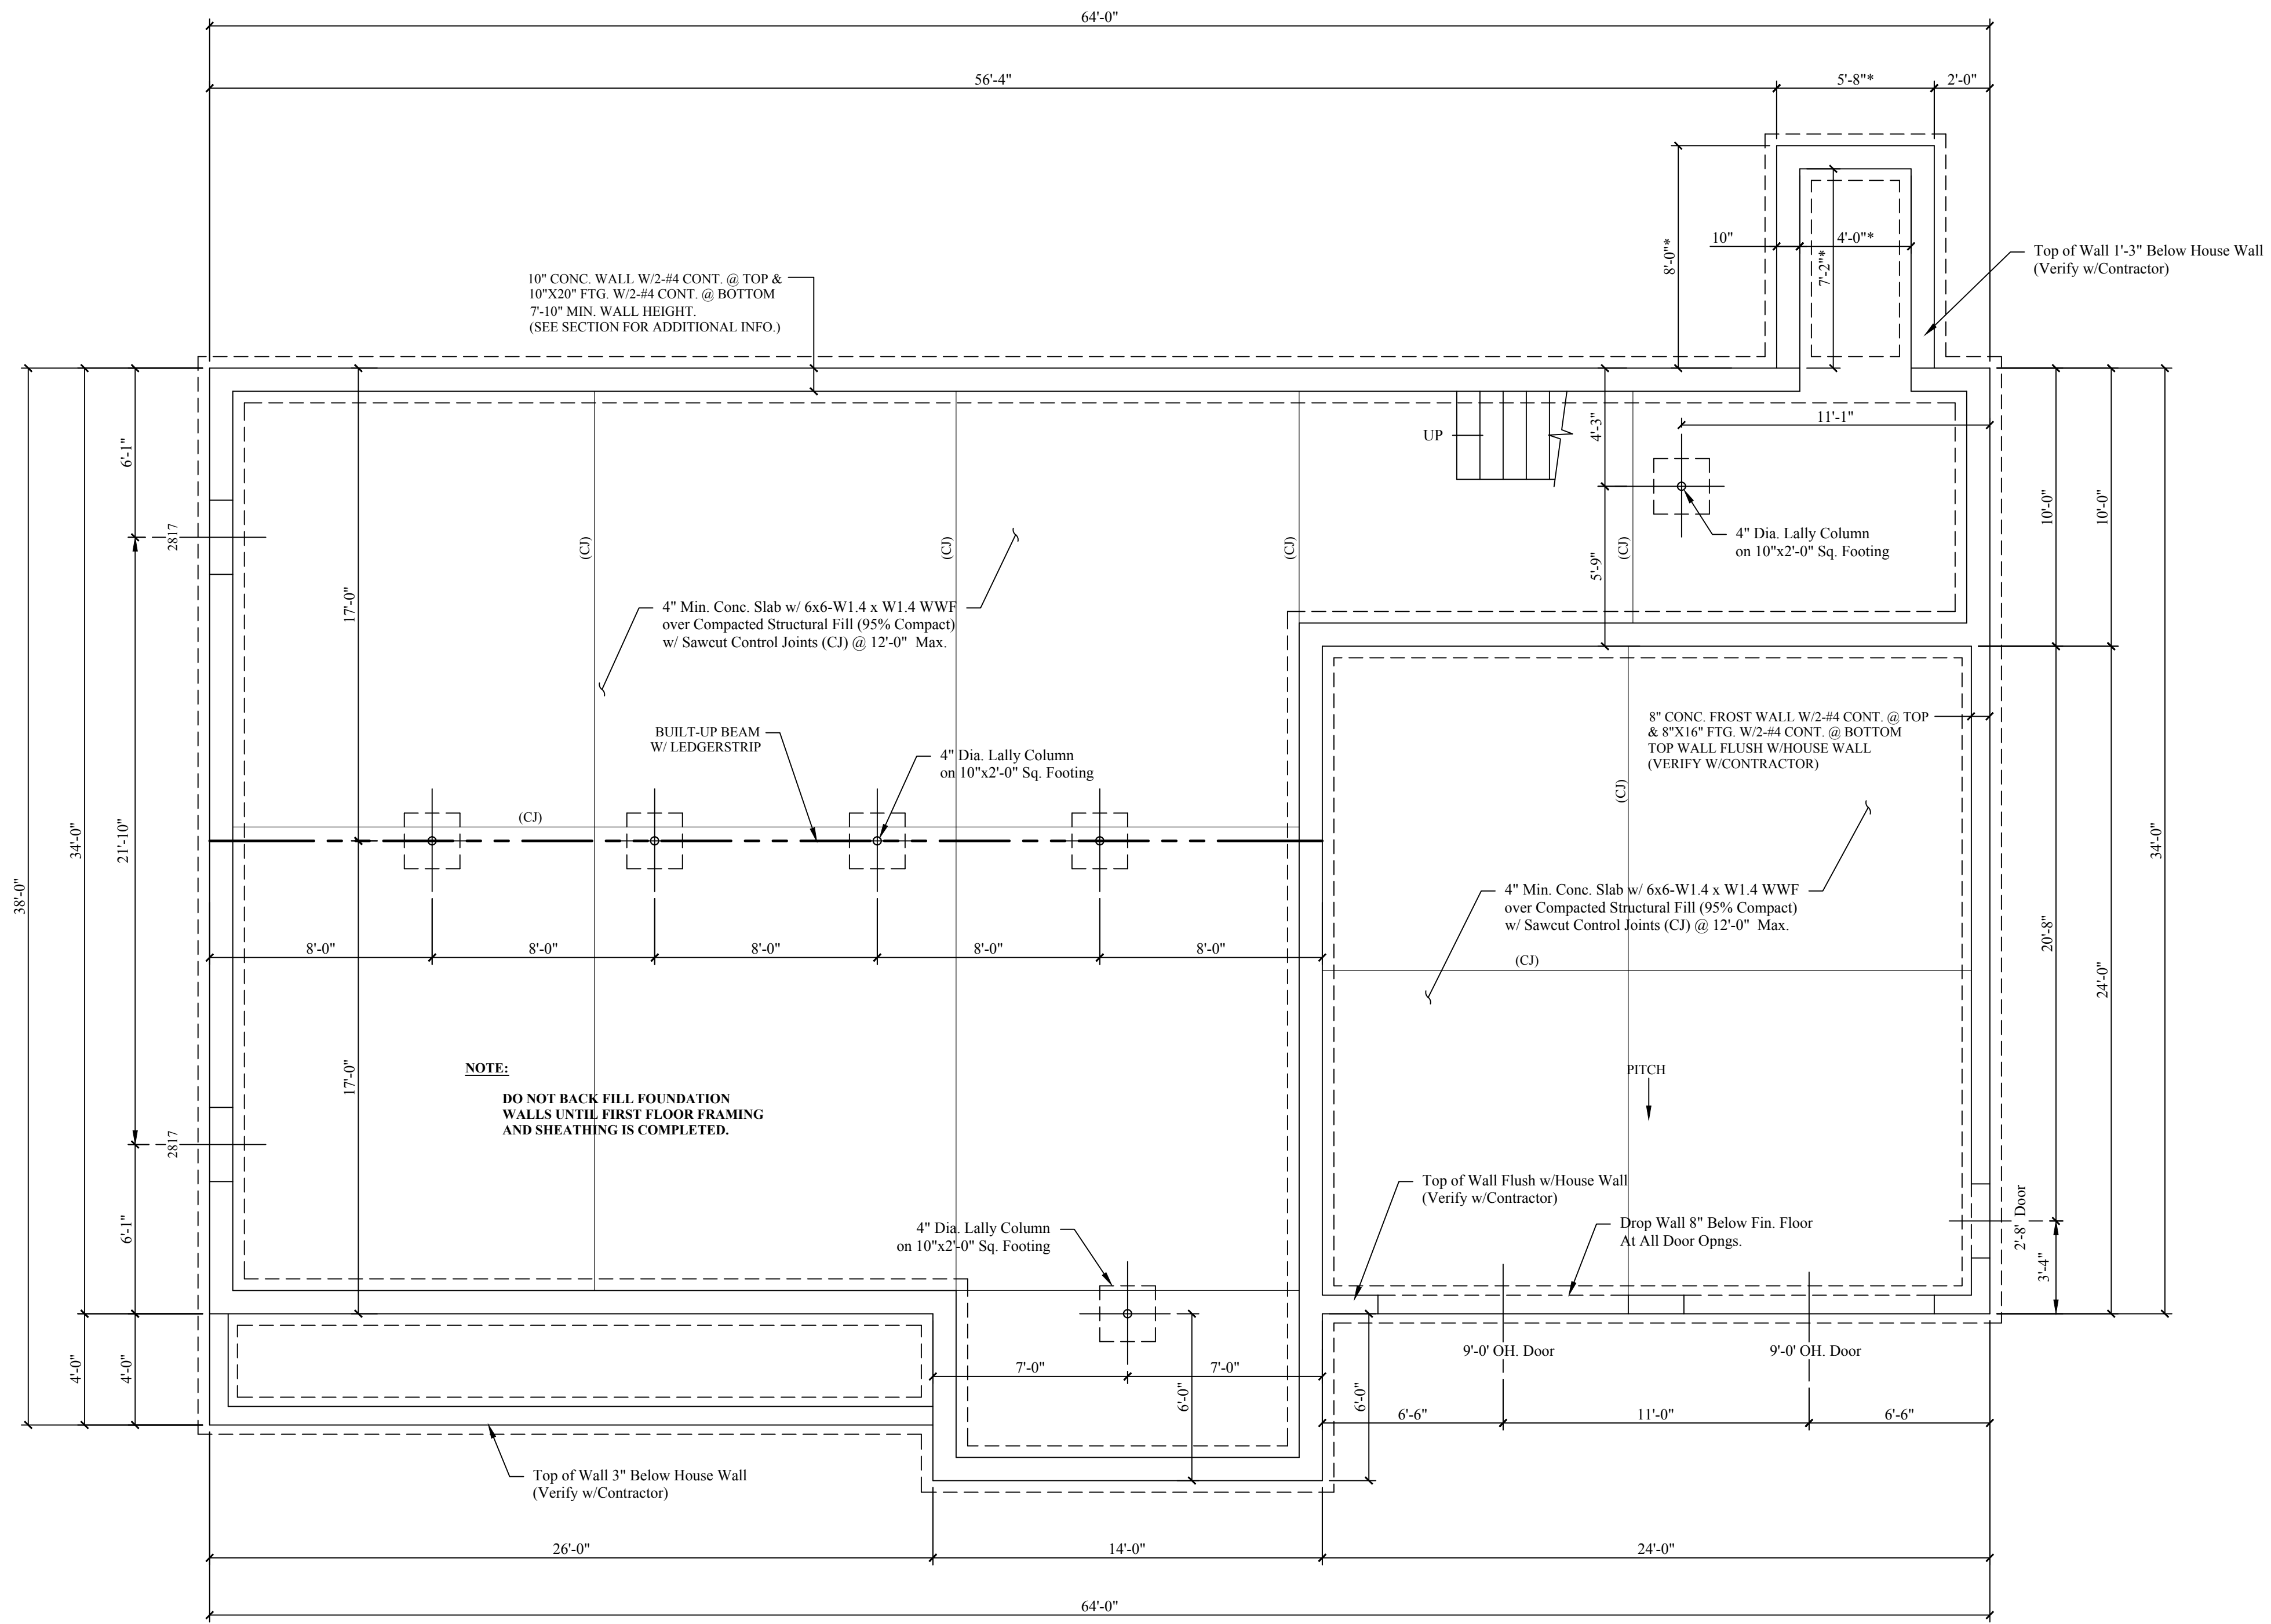

FOUNDATION PLAN

Scale: 1/4" = 1'-0"


REVISIONS:

1. REVISED PER CITY REVIEW COMMENTS 03-30-2017

THESE PLANS HAVE BEEN LICENSED TO THE CUSTOMER FOR USE IN CONSTRUCTION OF ONE BUILDING ONLY AND ARE SUBJECT TO THE CONDITIONS OF LICENSE ACCEPTED BY THE CUSTOMER. USE OF ANY PART OF THE PLANS BY ANY PARTY OTHER THAN THE CUSTOMER, EXCEPT ON LOAN BY THE CUSTOMER TO THIRD PARTIES NECESSARY TO ASSIST THE CUSTOMER IN USING THE PLANS, SUCH AS CONTRACTORS AND SUBCONTRACTORS, IS STRICTLY PROHIBITED. THE PLANS MAY NOT BE RE-USED OR COPIED IN WHOLE OR IN PART, WITHOUT WRITTEN PERMISSION FROM MORIN DRAFTING WHICH RETAINS COPYRIGHTS TO AND OWNERSHIP OF THE PLANS.

ISSUED FOR CONSTRUCTION

11-23-2016

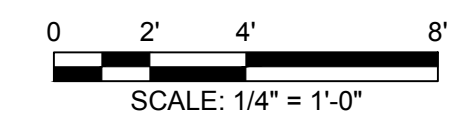

Mechanical, Electrical and Plumbing Design and Building Weatherization-Insulation-Ventilation by Others.

White Homes, Inc.
878-3361

MORIN DRAFTING 318-1177

DORLER RESIDENCE
MORNINGSTAR LANE, PORTLAND, ME. (LOT NO. 3)

FOUNDATION PLAN

DRAWN: J. MORIN
SCALE: 1/4"=1'-0"
DATE: 05-22-2016
PLAN NO:

S1