


2x10 LEDGER W/ 3" LAG BOLT @ 16" O.C. STAGGERED
JOIST HANGERS

CONFIRM GAS FIREPLACE REQUIREMENTS

1 1/2" AISI @ 16" O.C.

3/4" ADVANTECH SUBFLOOR
GLUED AND NAILED W/ 3d
ANNULAR RINGSHANK @ 6" O.C.
WITH PANELS (TYPICAL)

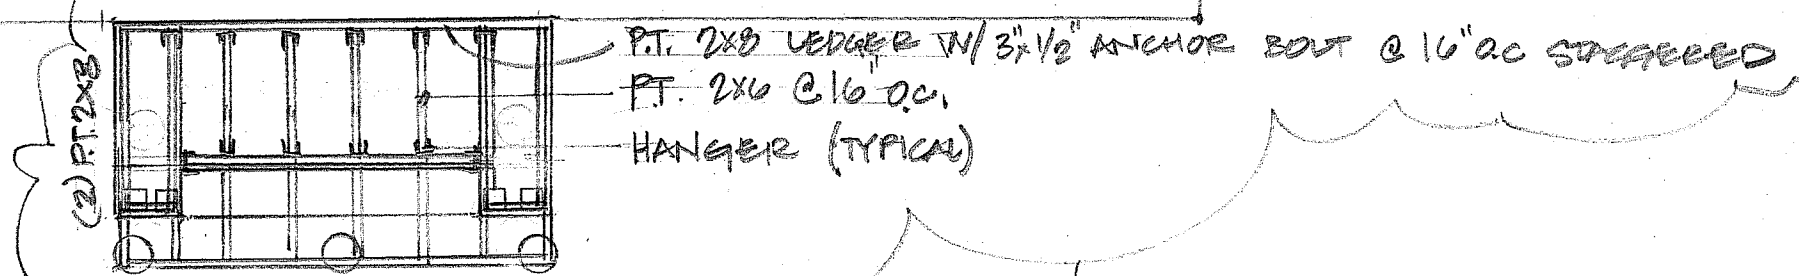

PT. 2x8 LEDGER W/ 3x1/2" ANCHOR BOLT @ 16" O.C. STAGGERED
PT. 2x6 @ 16" O.C.
HANGER (TYPICAL)

COPYRIGHT 2015
PETERSON DESIGN GROUP
Reuse or reproduction of the contents of this document is not permitted without written permission of PETERSON DESIGN GROUP.
Peterson Design Group is a subsidiary of Eric C. Peterson Custom Residential Design, Inc.

PETERSON DESIGN GROUP
ARCHITECTURE
10 Dana Street, Suite 201
Portland, Maine 04101
Tel: 207-775-8339 Fax: 207-775-3393
info@petersondesigngroup.us

ADDITION AND RENOVATION FOR:
JORDAN RESIDENCE
ROARING BROOK ROAD * PORTLAND, MAINE

DRAWN BY:
E.H.L.

CHECKED BY:

JOB No.:
1445

DATE:
MARCH 2, 2015
MARCH 4, 2015
APRIL 1, 2015
APRIL 30, 2015

SHEET No.:

6

FIRST FLOOR FRAMING PLAN
SUBMIT 4/1/15