





FRONT ELEVATION
SCALE 1/4" = 1'-0"

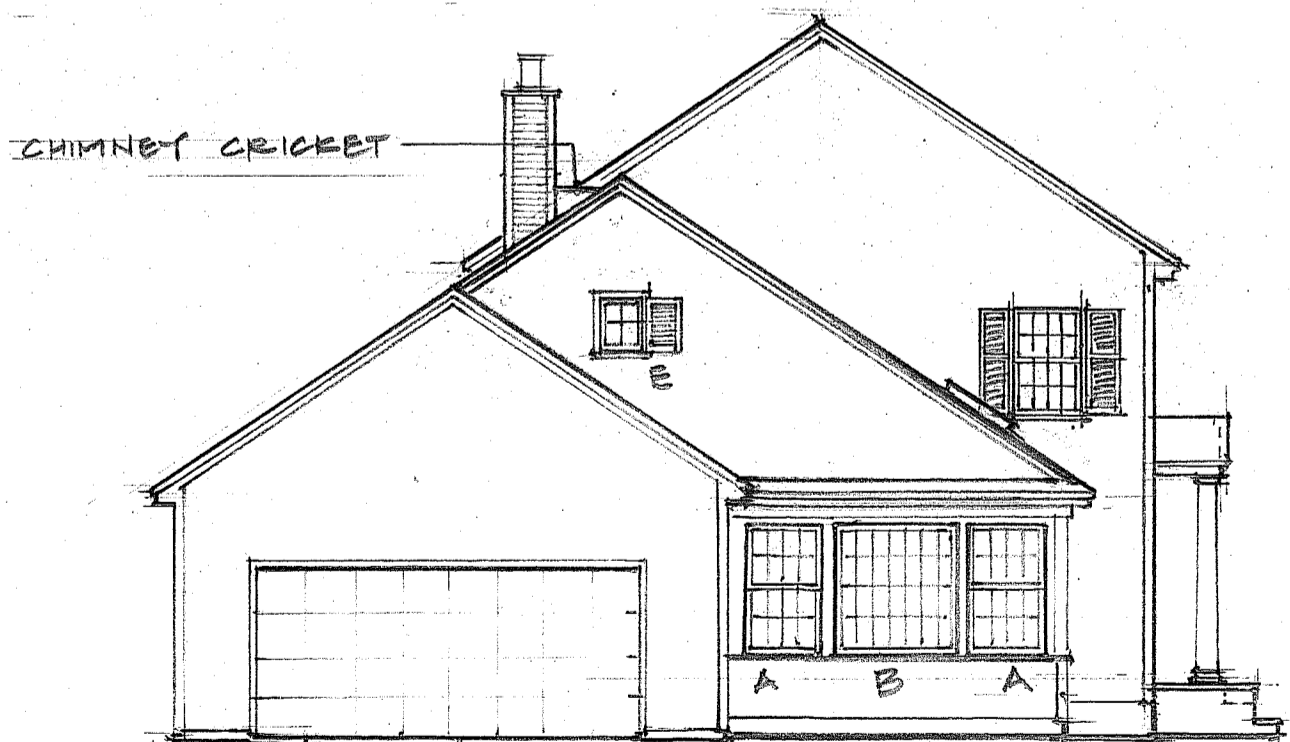

LEFT SIDE ELEVATION
SCALE 1/8" = 1'-0"

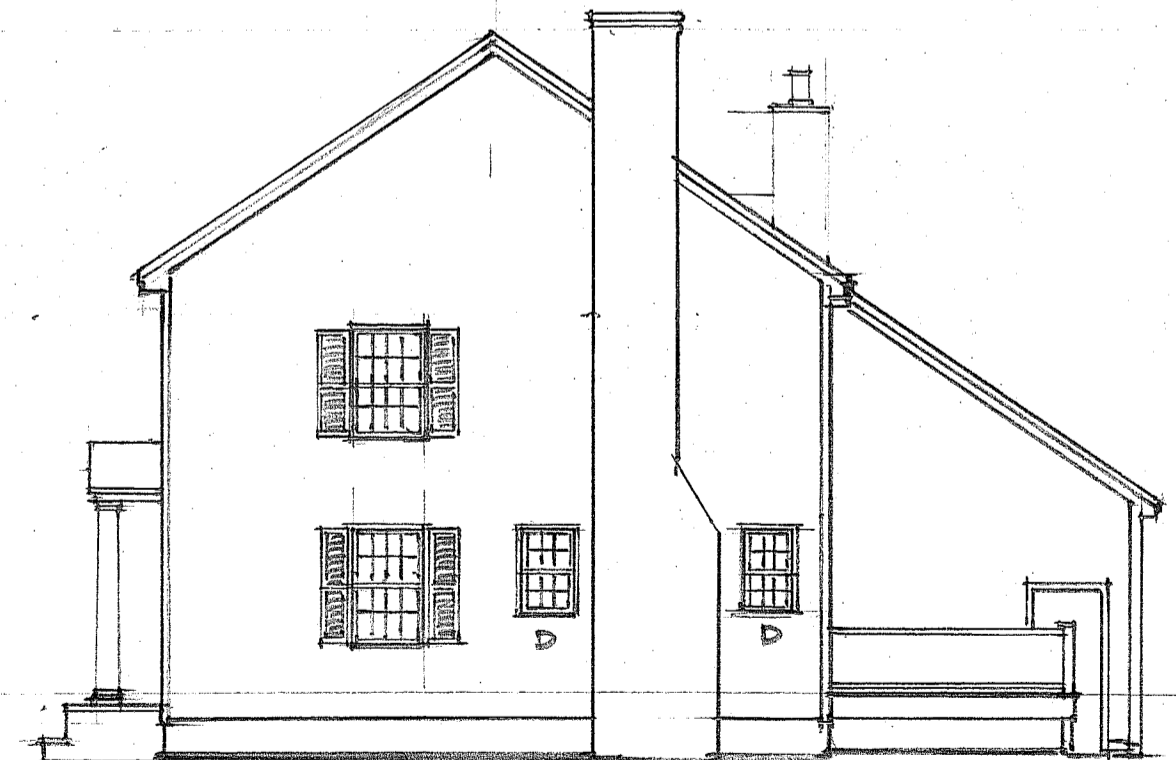

RIGHT SIDE ELEVATION
SCALE 1/8" = 1'-0"

ELEVATIONS

COPYRIGHT 2015
PETERSON DESIGN GROUP
No reuse or reproduction of the
contents of this document is not permitted
without written permission of
PETERSON DESIGN GROUP.
Peterson Design Group is a subsidiary of Eric
C. Peterson Custom Residential Design, Inc.

PETERSON DESIGN GROUP
ARCHITECTURE
10 Dana Street, Suite 201
Portland, ME 04101
Tel: 207-775-3399 Fax: 207-775-3393
info@petersondesigngroup.us

ADDITION AND RENOVATION FOR:
JORDAN RESIDENCE
ROARING BROOK ROAD * PORTLAND, MAINE

DRAWN BY:
EHL
CHECKED BY:
JOB No.:
1445
DATE:
MARCH 2, 2015
MARCH 4, 2015
APRIL 30, 2015
SHEET No.:

5-10-15