


Total Property: **10.960 sq ft.**
Building: 1180 + 1478 = **2658 sq ft. = 24.3 %**

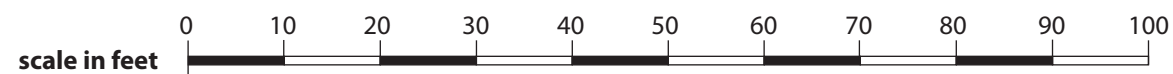

SITE PLAN