



FOUNDATION PLAN

SCALE: 1/4" = 1'-0"

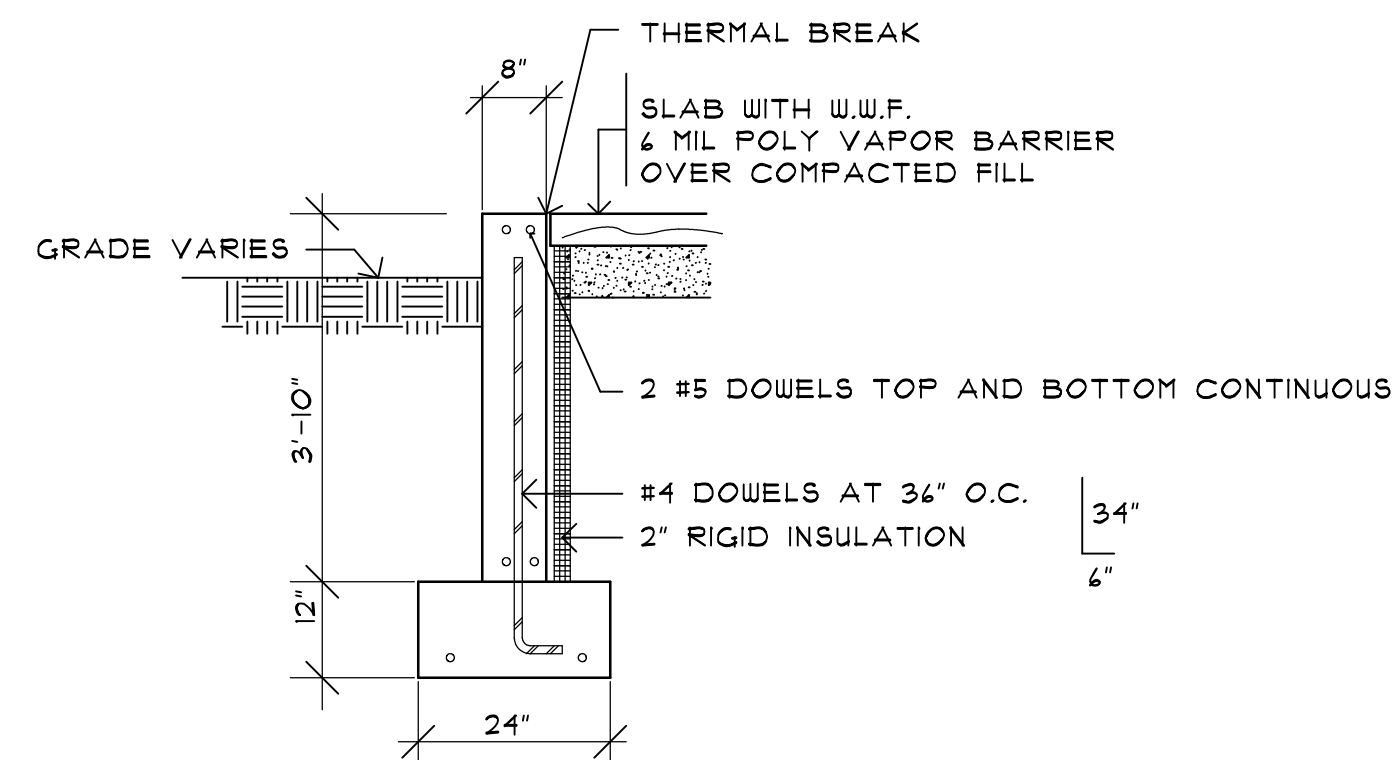

SECTION 1 TYPICAL FROST WALL AT GARAGE

SCALE: 1/2" = 1'-0"

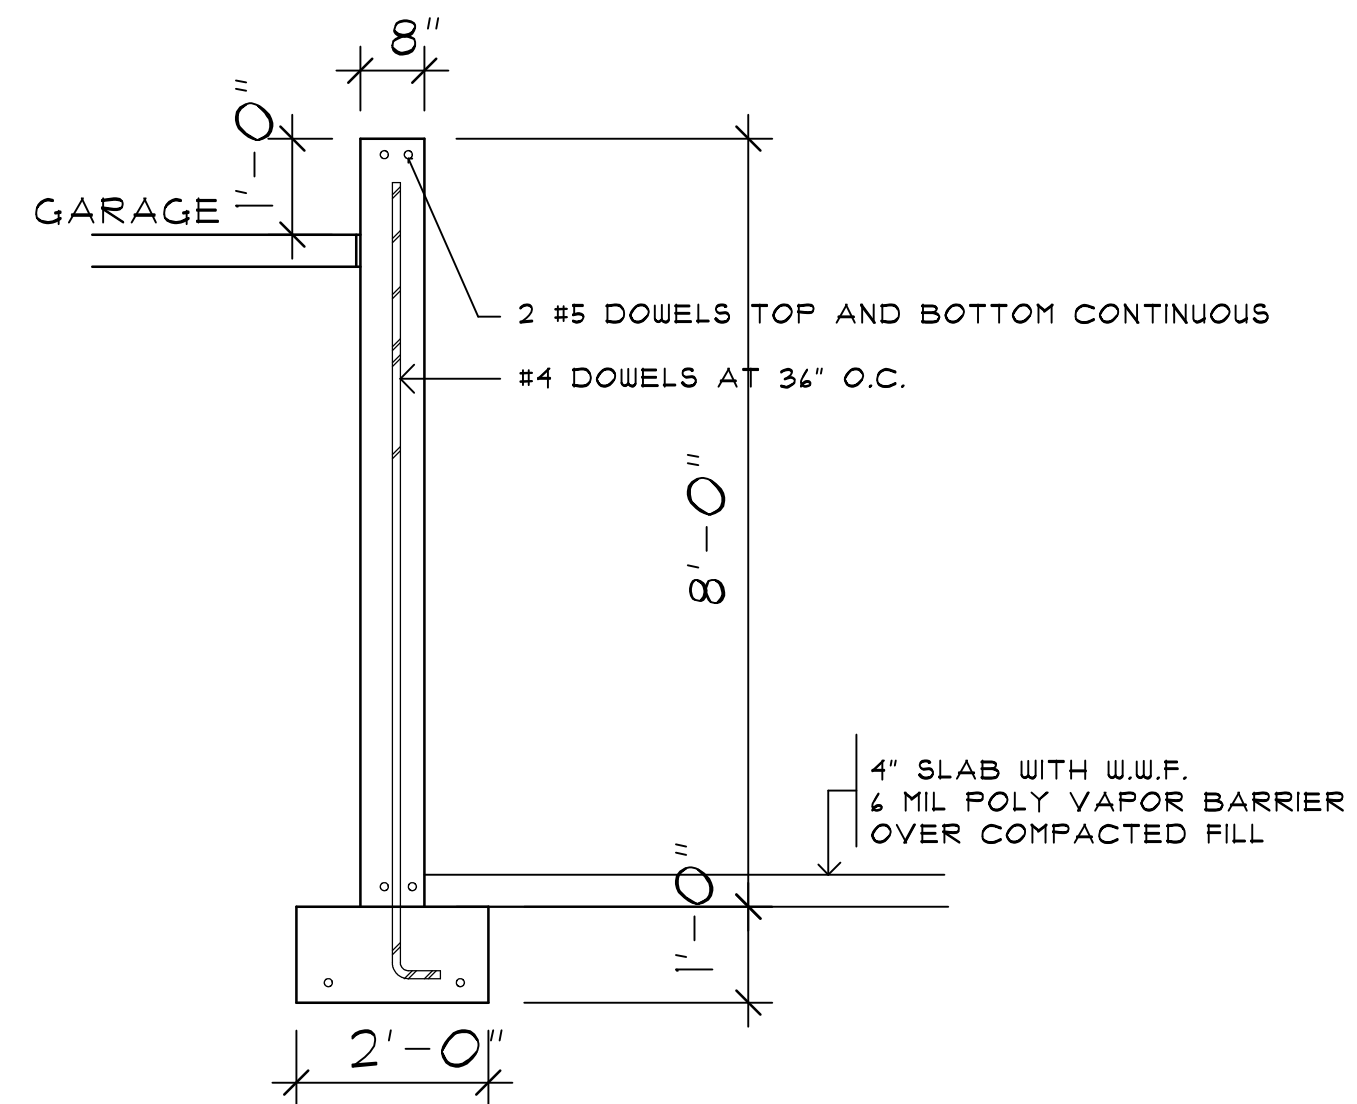

SECTION 2 TYPICAL AT HOUSE

SCALE: 1/2" = 1'-0"

NO.	DESCRIPTION OF REVISION	DATE
1	AS BUILT	03/15/12

NEW HOUSE
 LOT 7, STEPPING STONE LANE
 PORTLAND, MAINE

Gleason Architects
 P.O. BOX 596, 152 PORTSMOUTH AVENUE
 STRATHAM, NEW HAMPSHIRE 03885
 603.772-7370 FAX. NO. 603.772-6044

ARCHITECT

ENGINEER
 DATE: 12/21/12
 PROJECT NO. 201240
 SHEET NO.

A-1

OF SHEETS