

**SECOND FLOOR FRAMING PLAN**


SCALE: 1/4" = 1'-0"

**DOOR SCHEDULE**

MARK	DOOR WIDTH	DOOR HEIGHT	REMARKS
<b>FIRST FLOOR</b>			
1.	3'-0"	6'-8"	ENTRY DOOR
2.	PR. 2'-0"	6'-8"	CLOSET DOOR
3.	3'-0"	6'-8"	ENTRY DOOR TO GARAGE - 60 MIN. RATED
4.	2'-6"	6'-8"	BASEMENT DOOR
5.	2'-0"	6'-8"	POCKET DOOR - BATHROOM
6.	6'-0"	6'-8"	SLIDER TO DECK
7.	8'-0"	8'-0"	OVER HEAD DOOR
8.	NOT USED		
<b>SECOND FLOOR</b>			
9.	2'-6"	6'-8"	BEDROOM
10.	2'-6"	6'-8"	CLOSET
11.	2'-6"	6'-8"	BATHROOM
12.	1'-6"	6'-8"	CLOSET
13.	2'-6"	6'-8"	BEDROOM
14.	PR. 2'-6"	6'-8"	CLOSET - BIFOLD
15.	PR. 2'-6"	6'-8"	CLOSET - BIFOLD
16.	2'-6"	6'-8"	BEDROOM
17.	NOT USED		
18.	PR. 2'-6"	6'-8"	LAUNDRY - BIFOLD
19.	2'-6"	6'-8"	BATHROOM

**WINDOW SCHEDULE**

MARK	DOOR WIDTH	DOOR HEIGHT	REMARKS
2438	2'-0 1/2"	3'-2 1/2"	ALSIDE
3860	3'-2 1/2"	5'-0 1/2"	ALSIDE - EGRESS UNIT
4642	2 - 2'-0 1/2"	3'-6 1/2"	ALSIDE - KITCHEN (CASEMENT)
4860	4'-4 1/2"	5'-0 1/2"	ALSIDE

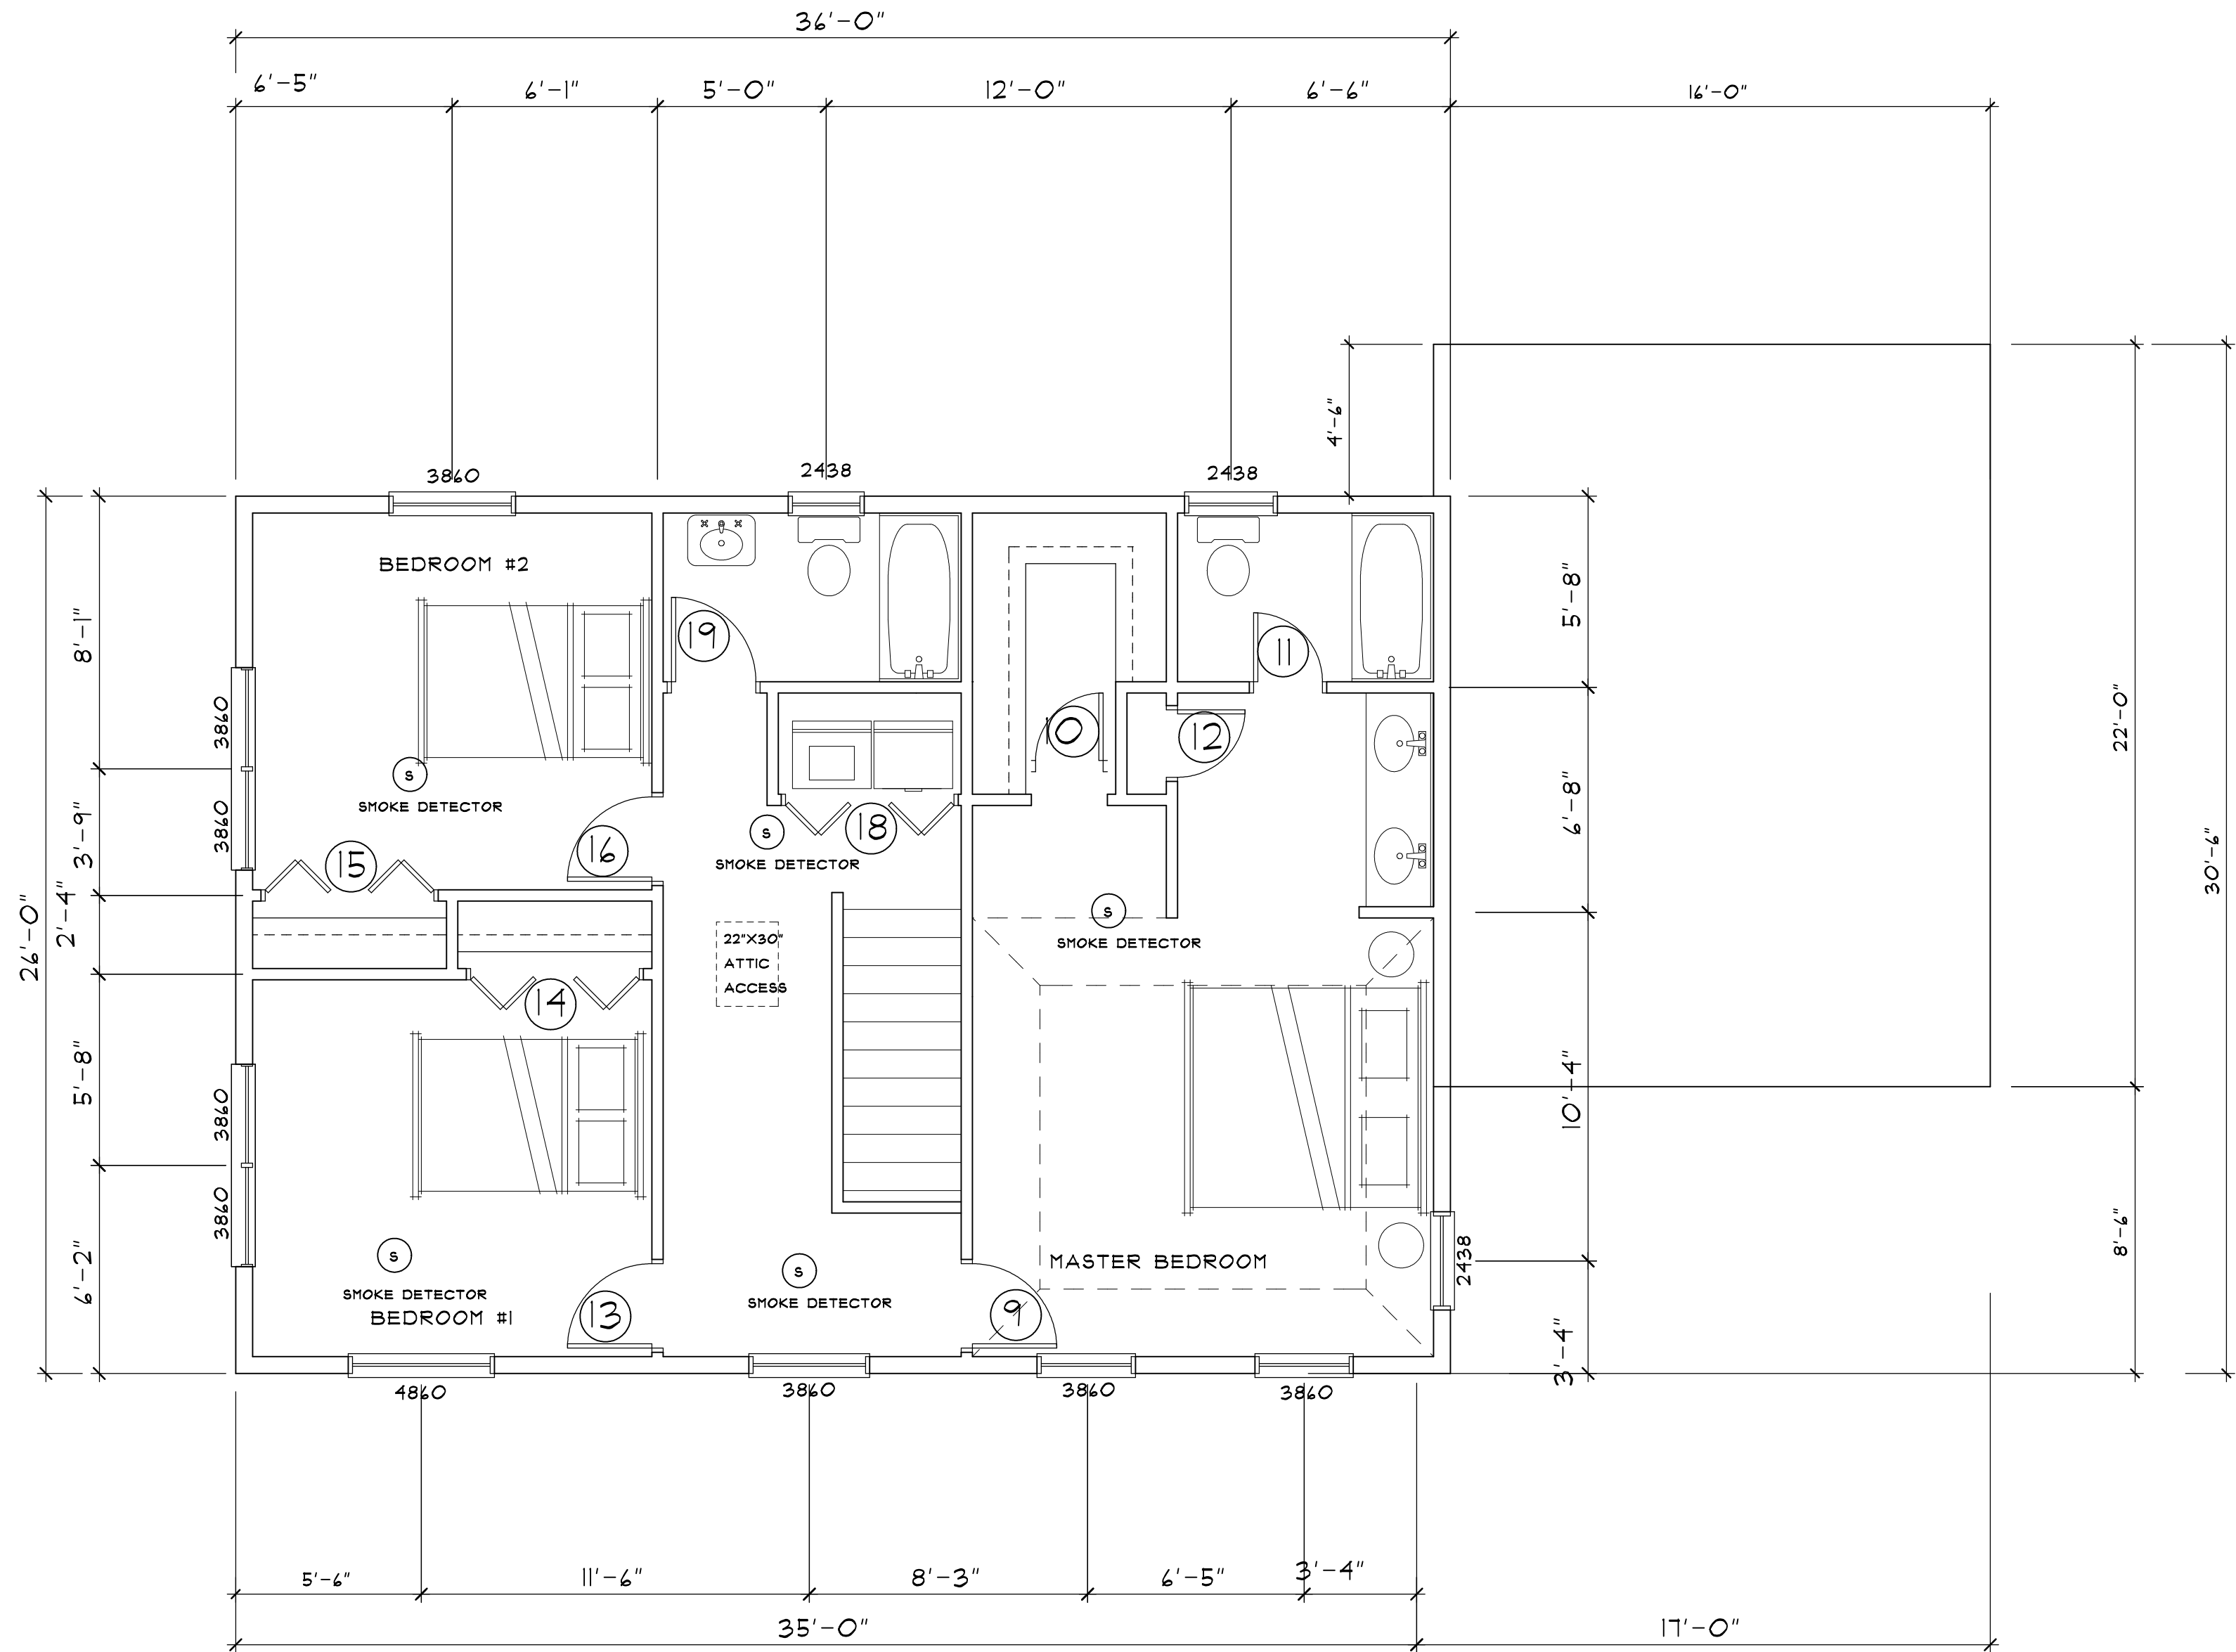

**SECOND FLOOR PLAN**

SCALE: 1/4" = 1'-0"

NO.	DESCRIPTION OF REVISION	DATE
1	AS BUILT	03/15/12

**NEW HOUSE**  
 LOT 7, STEPPING STONE LANE  
 PORTLAND, MAINE

**Gleason Architects**  
 P.O. BOX 596, 152 PORTSMOUTH AVENUE  
 STRATHAM, NEW HAMPSHIRE 03885  
 603 772-7370 FAX. NO. 603 772-6044

ARCHITECT

ENGINEER

DATE: 12/21/12  
 PROJECT NO. 201240  
 SHEET NO.

A-3

OF SHEETS