




SECTION THRU GARAGE
SCALE: 1/8" = 1'-0"

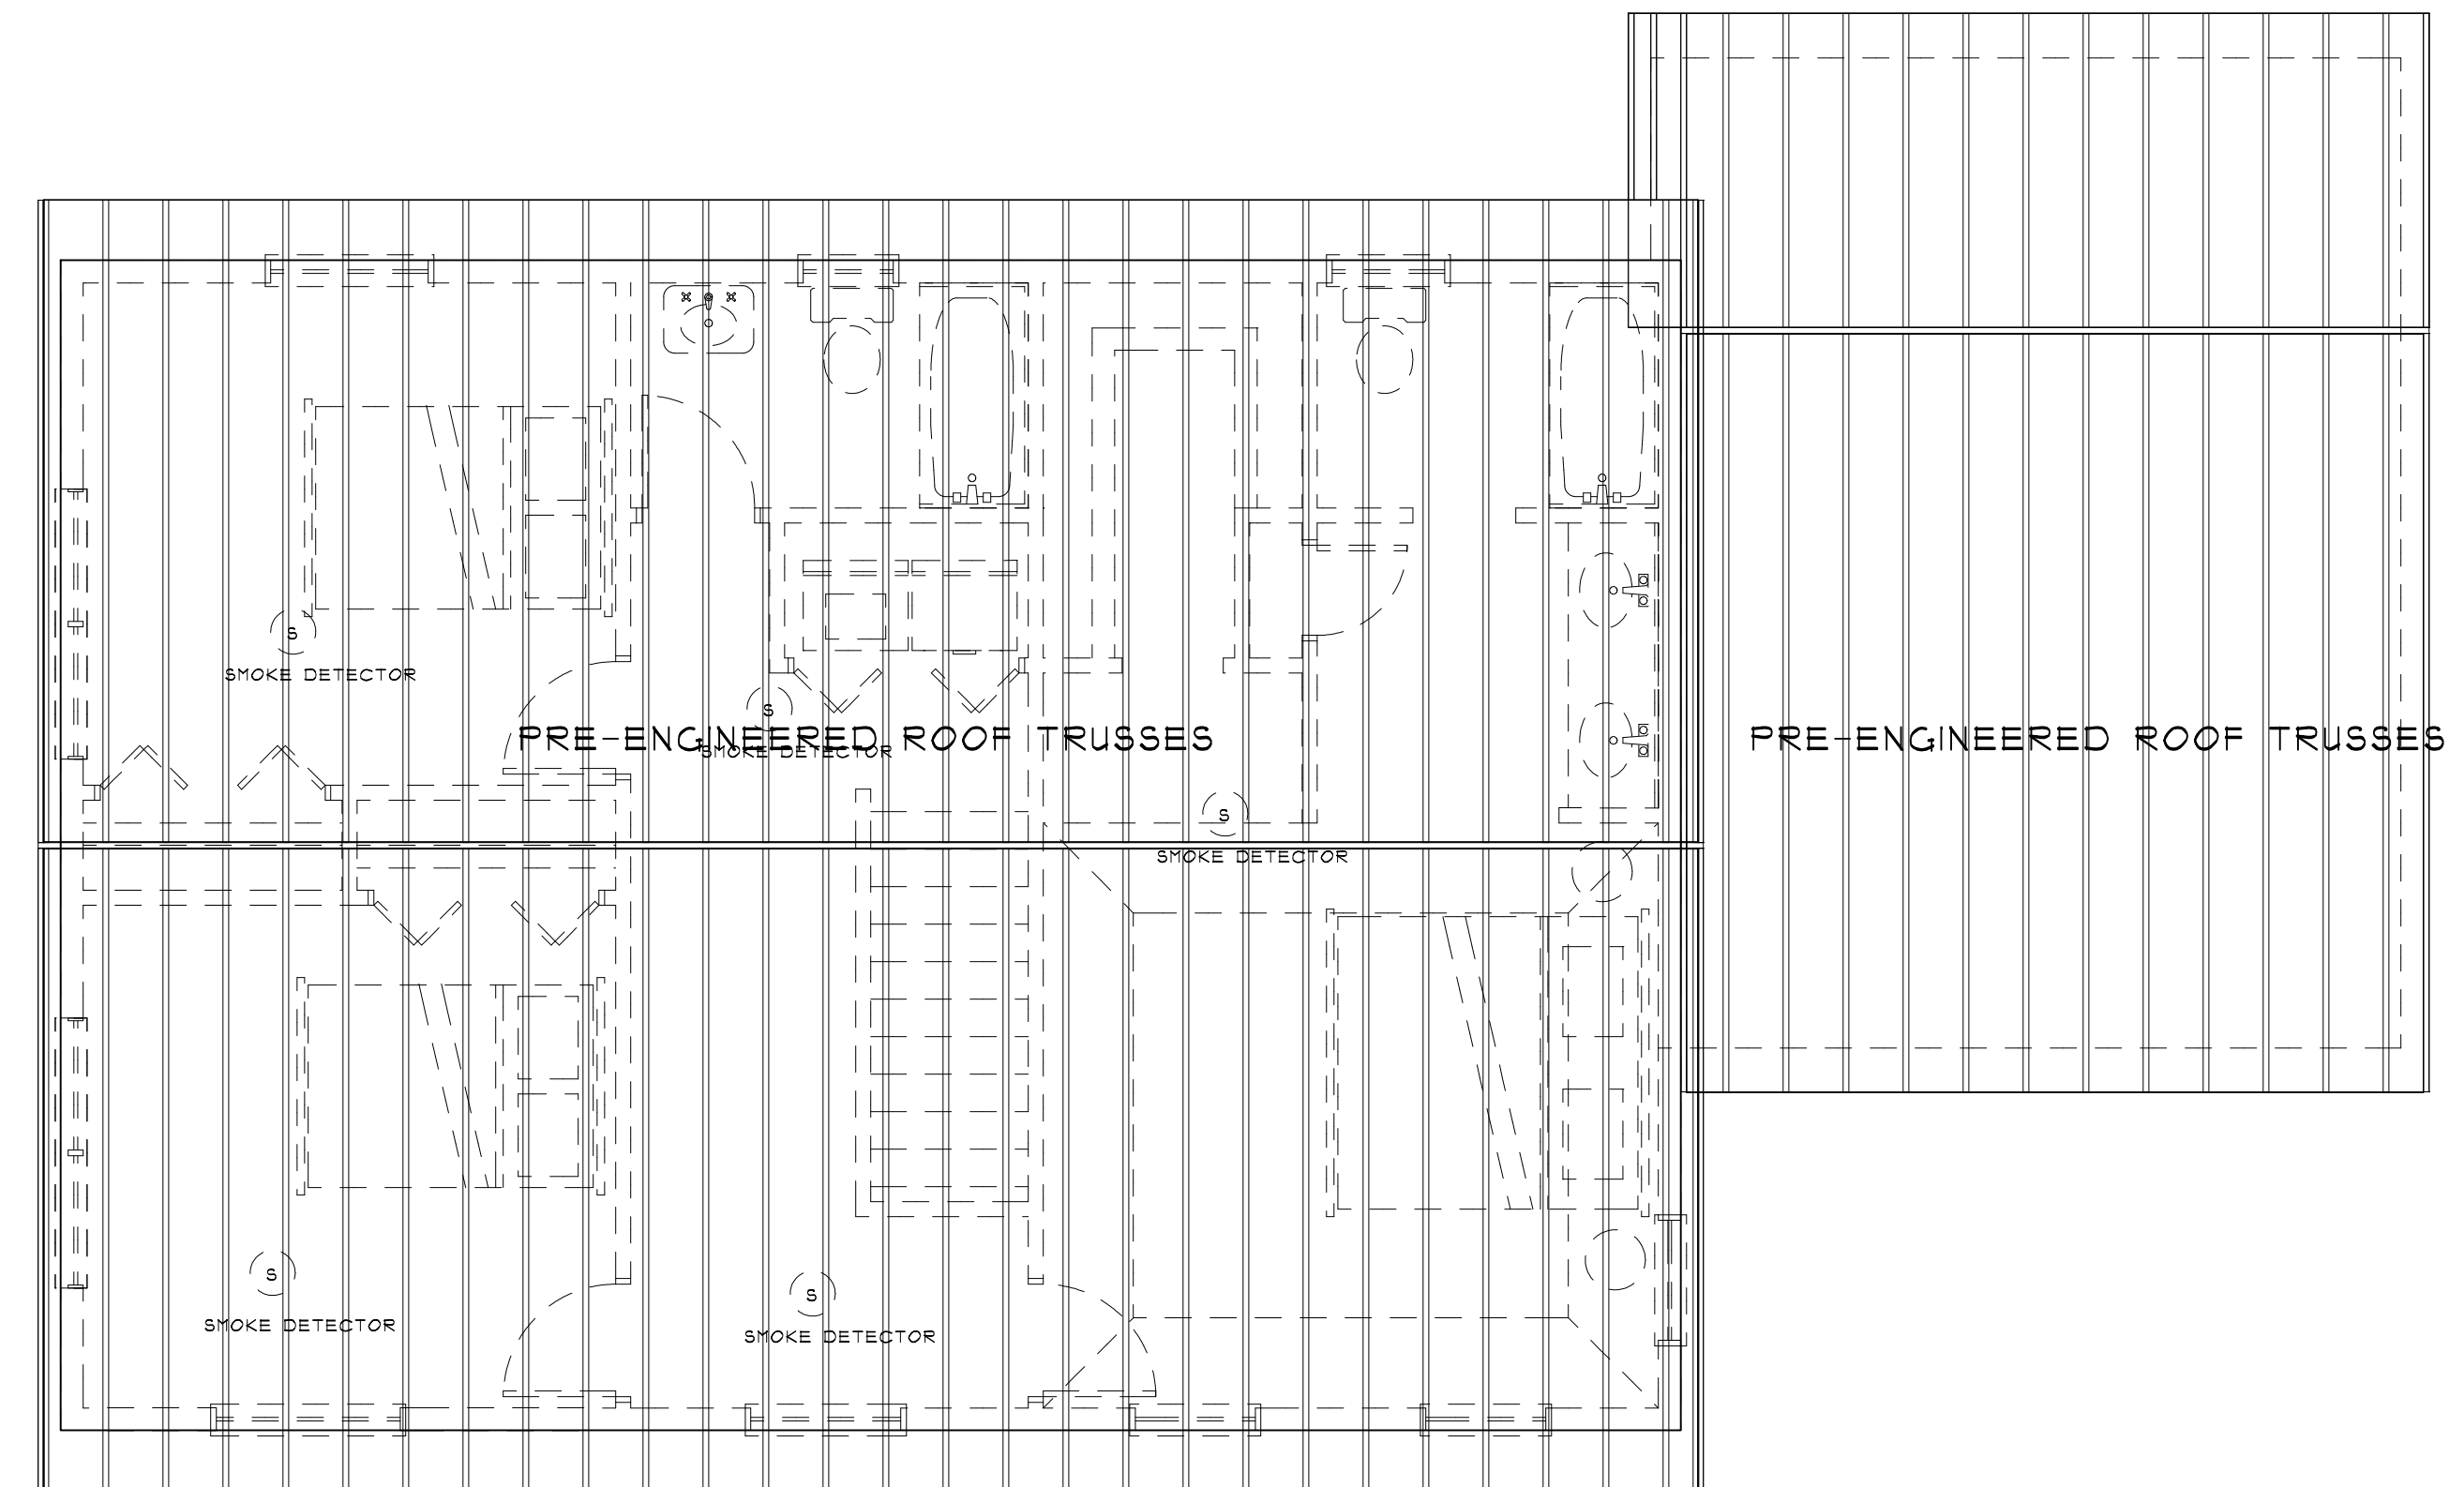

ROOF FRAMING PLAN
SCALE: 1/8" = 1'-0"

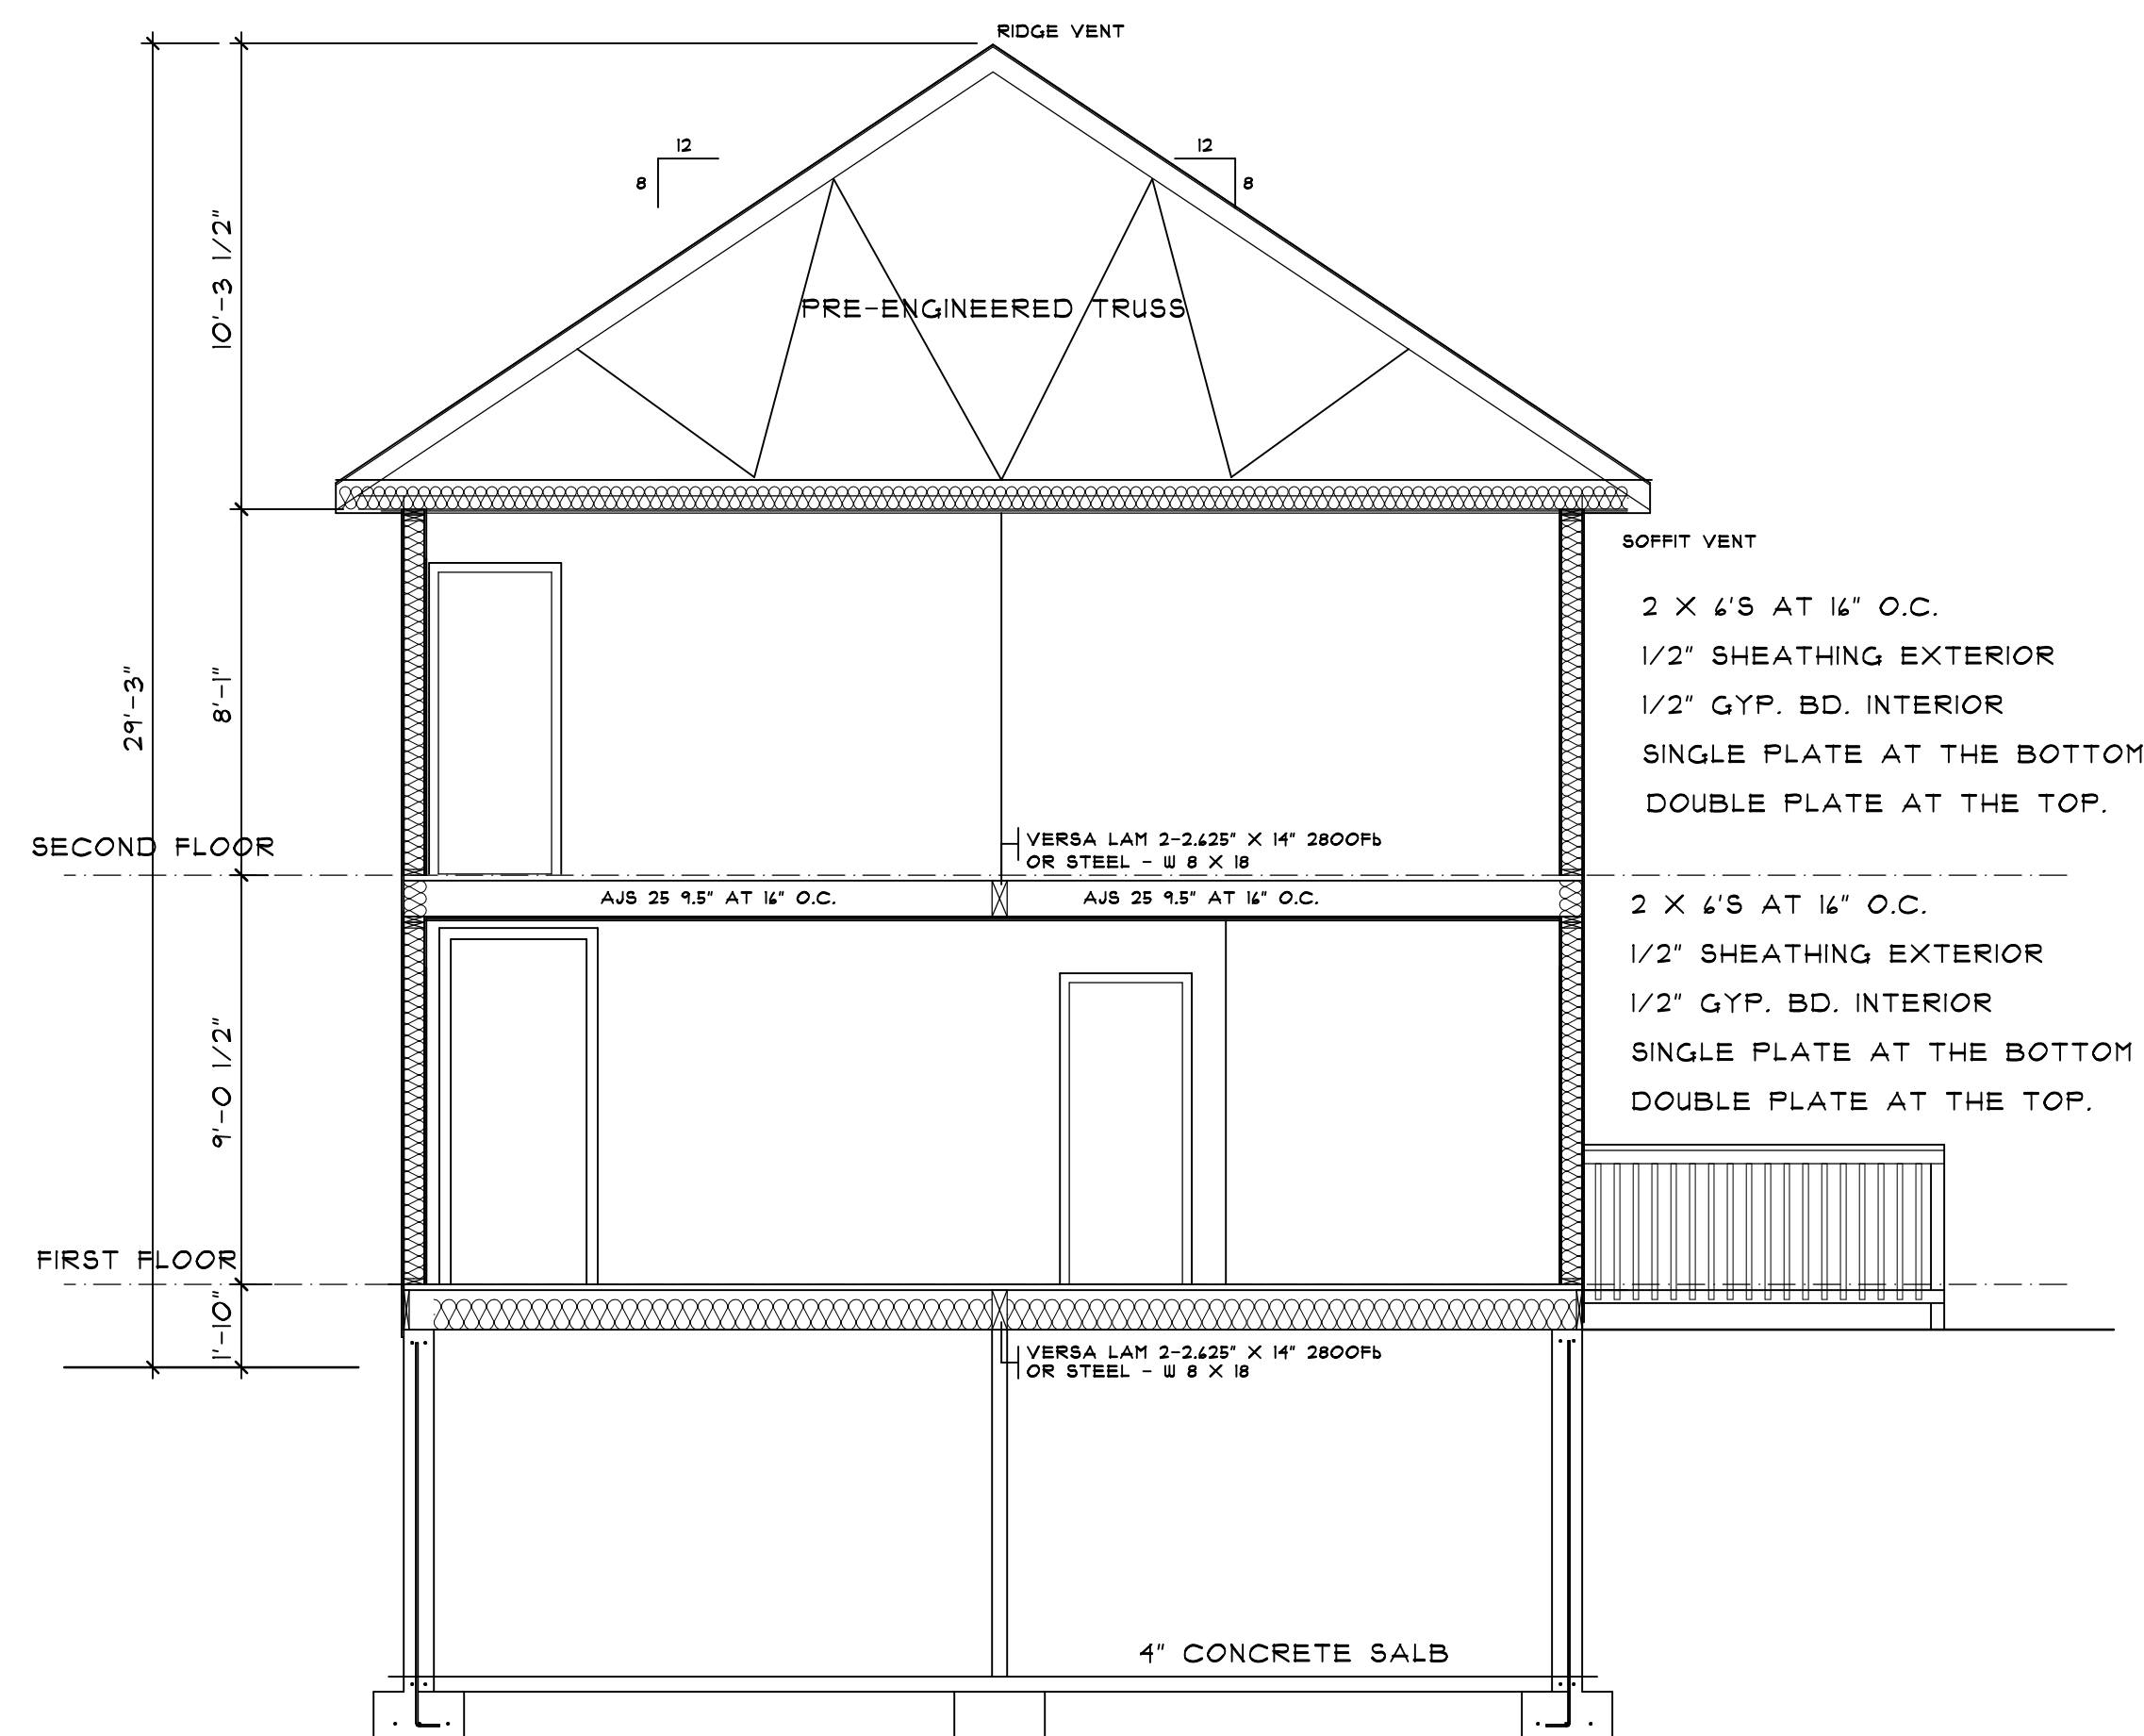

SECTION THRU HOUSE
SCALE: 1/8" = 1'-0"

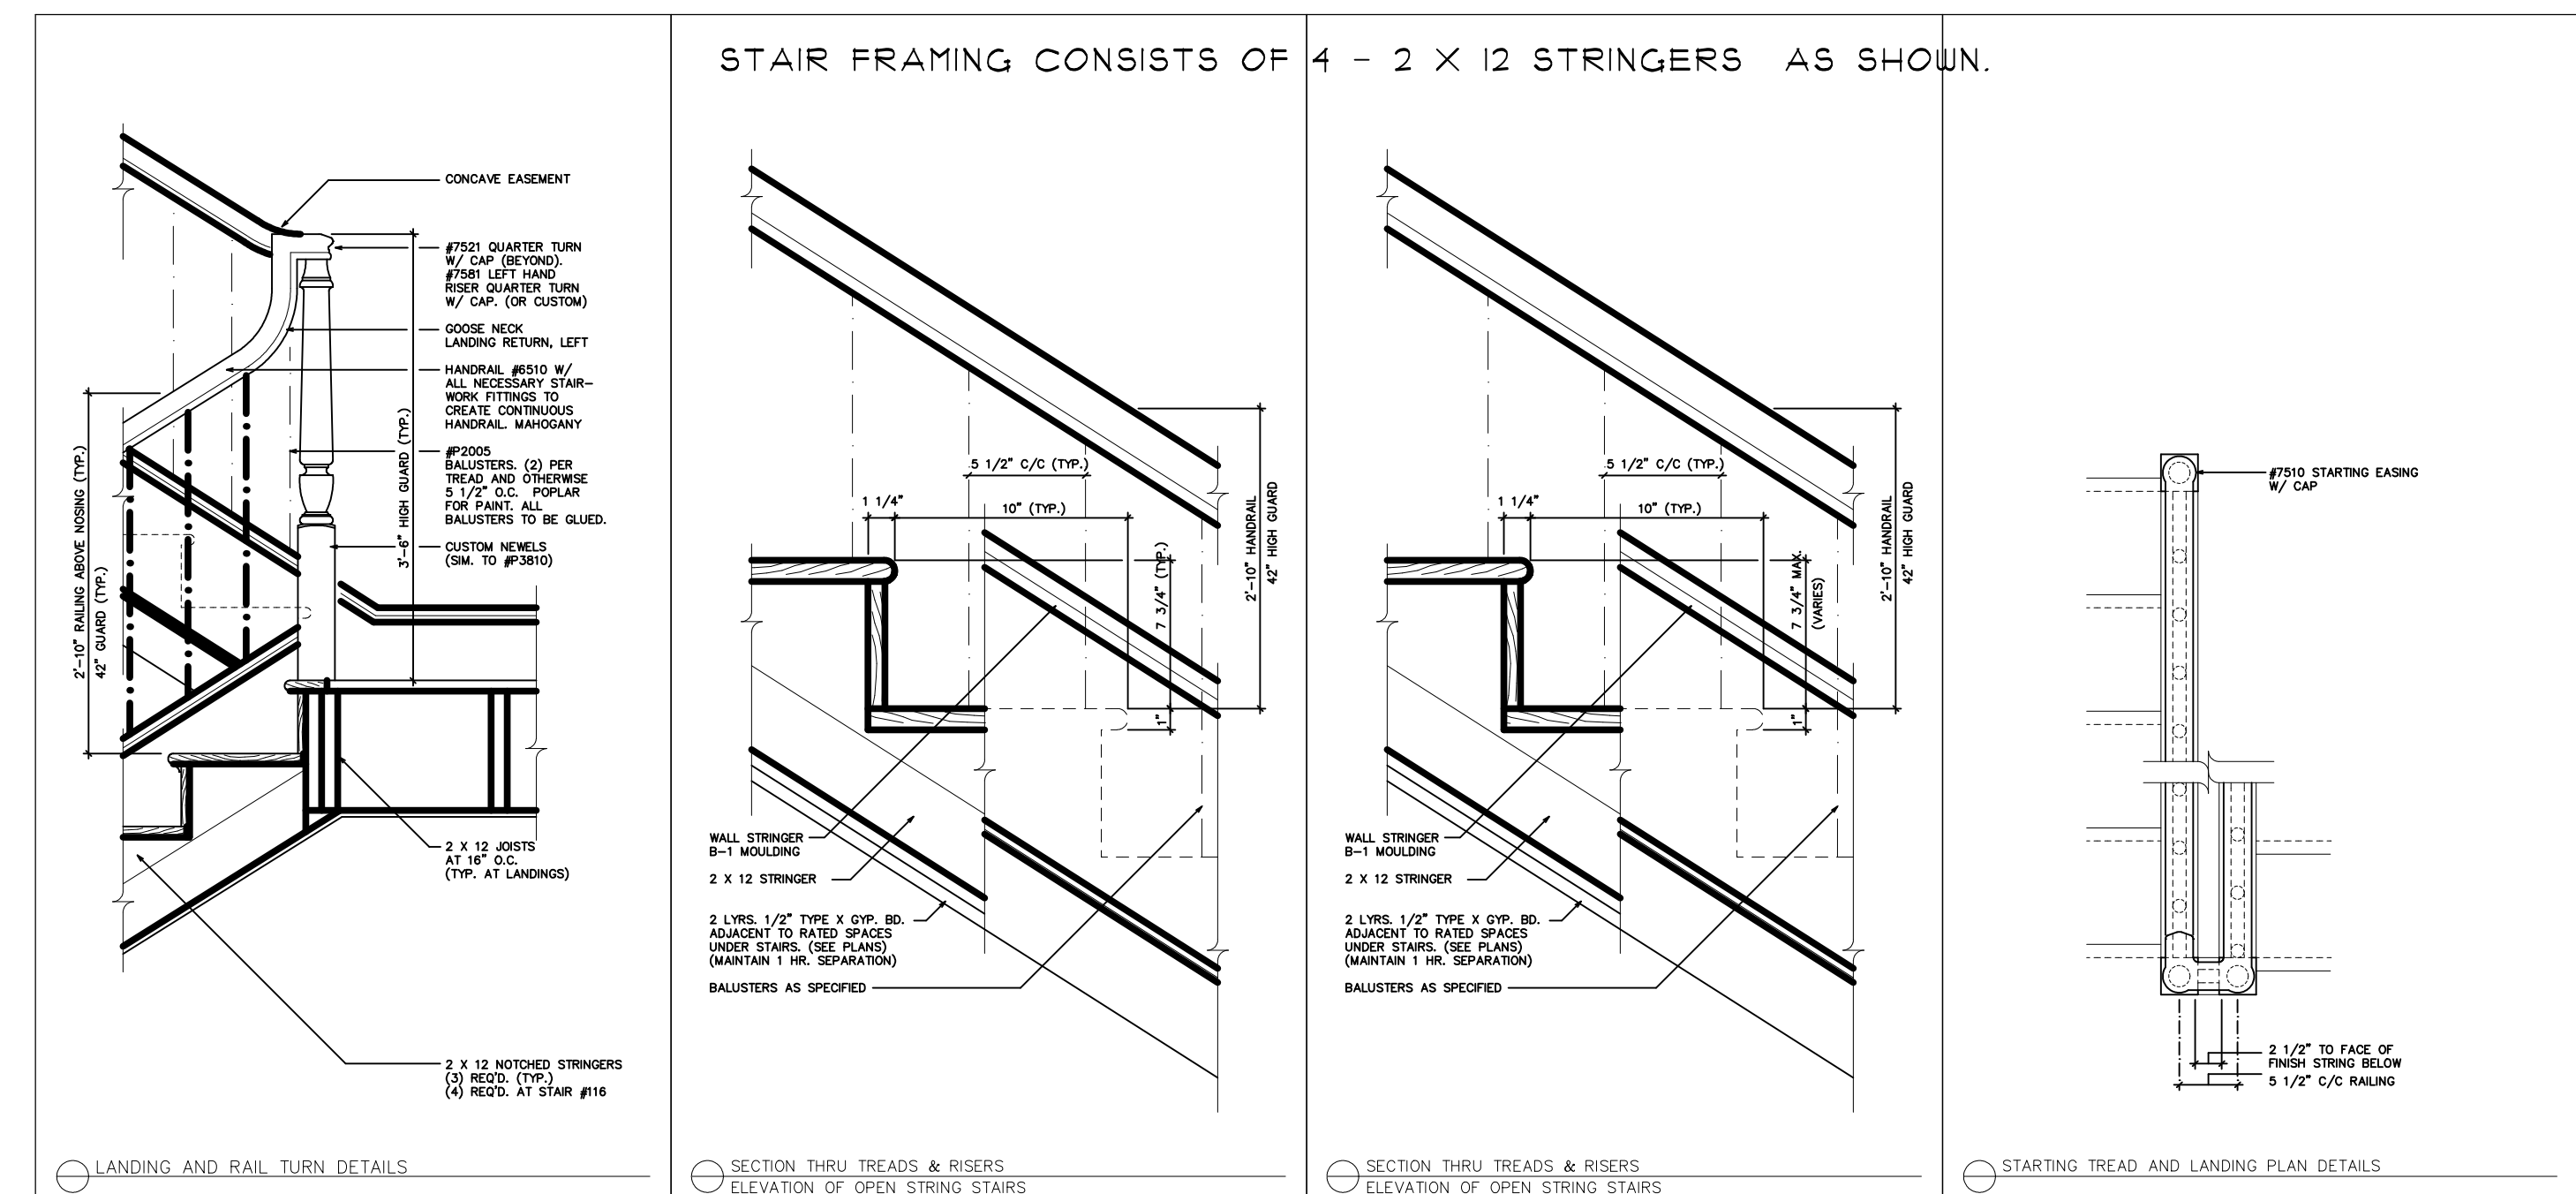

NO.	DESCRIPTION OF REVISION	DATE
1	AS BUILT	03/15/12

NEW HOUSE
LOT 7, STEPPING STONE LANE
PORTLAND, MAINE

Gleason Architects
P.O. BOX 596, 152 PORTSMOUTH AVENUE
STRATHAM, NEW HAMPSHIRE 03885
603.772-7370 FAX. NO. 603.772-6044

ARCHITECT

ENGINEER
DATE: 12/21/12
PROJECT NO. 201240
SHEET NO.

A-5

OF SHEETS