


City of Portland, Maine - Building or Use Permit Application

389 Congress Street, 04101 Tel: (207) 874-8703, Fax: (207) 874-8716

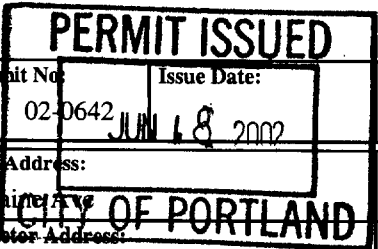

Permit No: 02-0642	Issue Date: JUN 18 2002	CBL: 407 J001001
-----------------------	----------------------------	---------------------

Location of Construction: 68 Maine Ave	Owner Name: Doughty Sylvania	Owner Address: 68 Maine Ave	Phone: 207-582-7007
Business Name:	Contractor Name: macdonald, john	Contractor Address: 318 Fishery Road Bowdoinham	Phone: 2076665619
Lessee/Buyer's Name	Phone:	Permit Type: Alterations - Dwellings	Zone:

Past Use: Residential	Proposed Use: Residential w/remodeled bathroom	Permit Fee: \$58.00	Cost of Work: \$4,600.00	CEO District: 2
--------------------------	---	------------------------	-----------------------------	--------------------

Proposed Project Description: Remodel bathroom	FIRE DEPT: <input type="checkbox"/> Approved <input checked="" type="checkbox"/> Denied <i>N/A</i>	INSPECTION: Use Group: <i>R-3</i> Type: <i>SB</i> <i>BOCA 1999</i>
	Signature: <i>[Signature]</i>	Signature: <i>[Signature]</i>

PEDESTRIAN ACTIVITIES DISTRICT (P.A.D.)	
Action: <input type="checkbox"/> Approved <input checked="" type="checkbox"/> Approved w/Conditions <input type="checkbox"/> Denied	
Signature: <i>[Signature]</i>	Date:

Permit Taken By: jmy	Date Applied For: 06/12/2002	Zoning Approval
-------------------------	---------------------------------	------------------------

<p>1. This permit application does not preclude the Applicant(s) from meeting applicable State and Federal Rules.</p> <p>2. Building permits do not include plumbing, septic or electrical work.</p> <p>3. Building permits are void if work is not started within six (6) months of the date of issuance. False information may invalidate a building permit and stop all work..</p>	Special Zone or Reviews <input type="checkbox"/> Shoreland <input type="checkbox"/> Wetland <input type="checkbox"/> Flood Zone <input type="checkbox"/> Subdivision <input type="checkbox"/> Site Plan Maj <input type="checkbox"/> Minor <input type="checkbox"/> MM <input type="checkbox"/> Date: <i>6/17/02</i>	Zoning Appeal <input type="checkbox"/> Variance <input type="checkbox"/> Miscellaneous <input type="checkbox"/> Conditional Use <input type="checkbox"/> Interpretation <input type="checkbox"/> Approved <input type="checkbox"/> Denied Date:	Historic Preservation <input checked="" type="checkbox"/> Not in District or Landmark <input type="checkbox"/> Does Not Require Review <input type="checkbox"/> Requires Review <input type="checkbox"/> Approved <input type="checkbox"/> Approved w/Conditions <input type="checkbox"/> Denied Date: <i>6/17/02</i>
---	--	---	---

CERTIFICATION

I hereby certify that I am the owner of record of the named property, or that the proposed work is authorized by the owner of record and that I have been authorized by the owner to make this application as his authorized agent and I agree to conform to all applicable laws of this jurisdiction. In addition, if a permit for work described in the application is issued, I certify that the code official's authorized representative shall have the authority to enter all areas covered by such permit at any reasonable hour to enforce the provision of the code(s) applicable to such permit.

SIGNATURE OF APPLICANT ADDRESS DATE PHONE

RESPONSIBLE PERSON IN CHARGE OF WORK, TITLE DATE PHONE

02-0642

All Purpose Building Permit Application

If you or the property owner owes real estate or personal property taxes or user charges on any property within the City, payment arrangements must be made before permits of any kind are accepted.

Location/Address of Construction: 68 Maine Avenue		
Total Square Footage of Proposed Structure		Square Footage of Lot 15,000 +/-
Tax Assessor's Chart, Block & Lot Chart# 407 Block# J Lot# 001		Owner: Sylvanus Doughty Telephone: 207 582 7007 207 797 4240
Lessee/Buyer's Name (If Applicable) N/A	Applicant name, address & telephone: Sylvanus Doughty P.O.Box 225 Hallowell, ME 04347	Cost Of Work: \$ 4,600+/- Fee: \$ 50-
Current use: <u>residence, single family</u>		
If the location is currently vacant, what was prior use: <u>occupied</u>		
Approximately how long has it been vacant: _____		
Proposed use: _____		
Project description: <u>re-model bathroom</u>		
Contractor's name, address & telephone: John Macdonald 666-5619 318 Fisher Road Bowdoinham, ME 04008		
Who should we contact when the permit is ready: <u>Sylvanus Doughty</u>		
Mailing address: P.O.Box 225 Hallowell, ME 04347		
We will contact you by phone when the permit is ready. You must come in and pick up the permit and review the requirements before starting any work, with a Plan Reviewer. A stop work order will be issued and a \$100.00 fee if any work starts before the permit is picked up. PHONE: 582 7007 797 4240		


Call here when ready


IF THE REQUIRED INFORMATION IS NOT INCLUDED IN THE SUBMISSIONS THE PERMIT WILL BE AUTOMATICALLY DENIED AT THE DISCRETION OF THE BUILDING/PLANNING DEPARTMENT, WE MAY REQUIRE ADDITIONAL INFORMATION IN ORDER TO APPROVE THIS PERMIT.

I hereby certify that I am the Owner of record of the named property, or that the owner of record authorizes the proposed work and that I have been authorized by the owner to make this application as his/her authorized agent. I agree to conform to all applicable laws of this jurisdiction. In addition, if a permit for work described in this application is issued, I certify that the Code Official's authorized representative shall have the authority to enter all areas covered by this permit at any reasonable hour to enforce the provisions of the codes applicable to this permit.

Signature of applicant:  Date: 12 June 2002

This is NOT a permit, you may not commence ANY work until the permit is issued. If you are in a Historic District you may be subject to additional permitting and fees with the Planning Department on the 4th floor of City Hall.

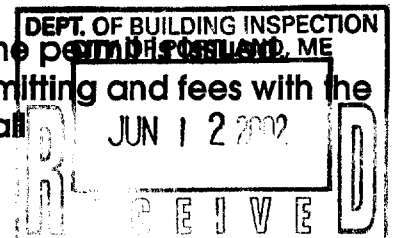

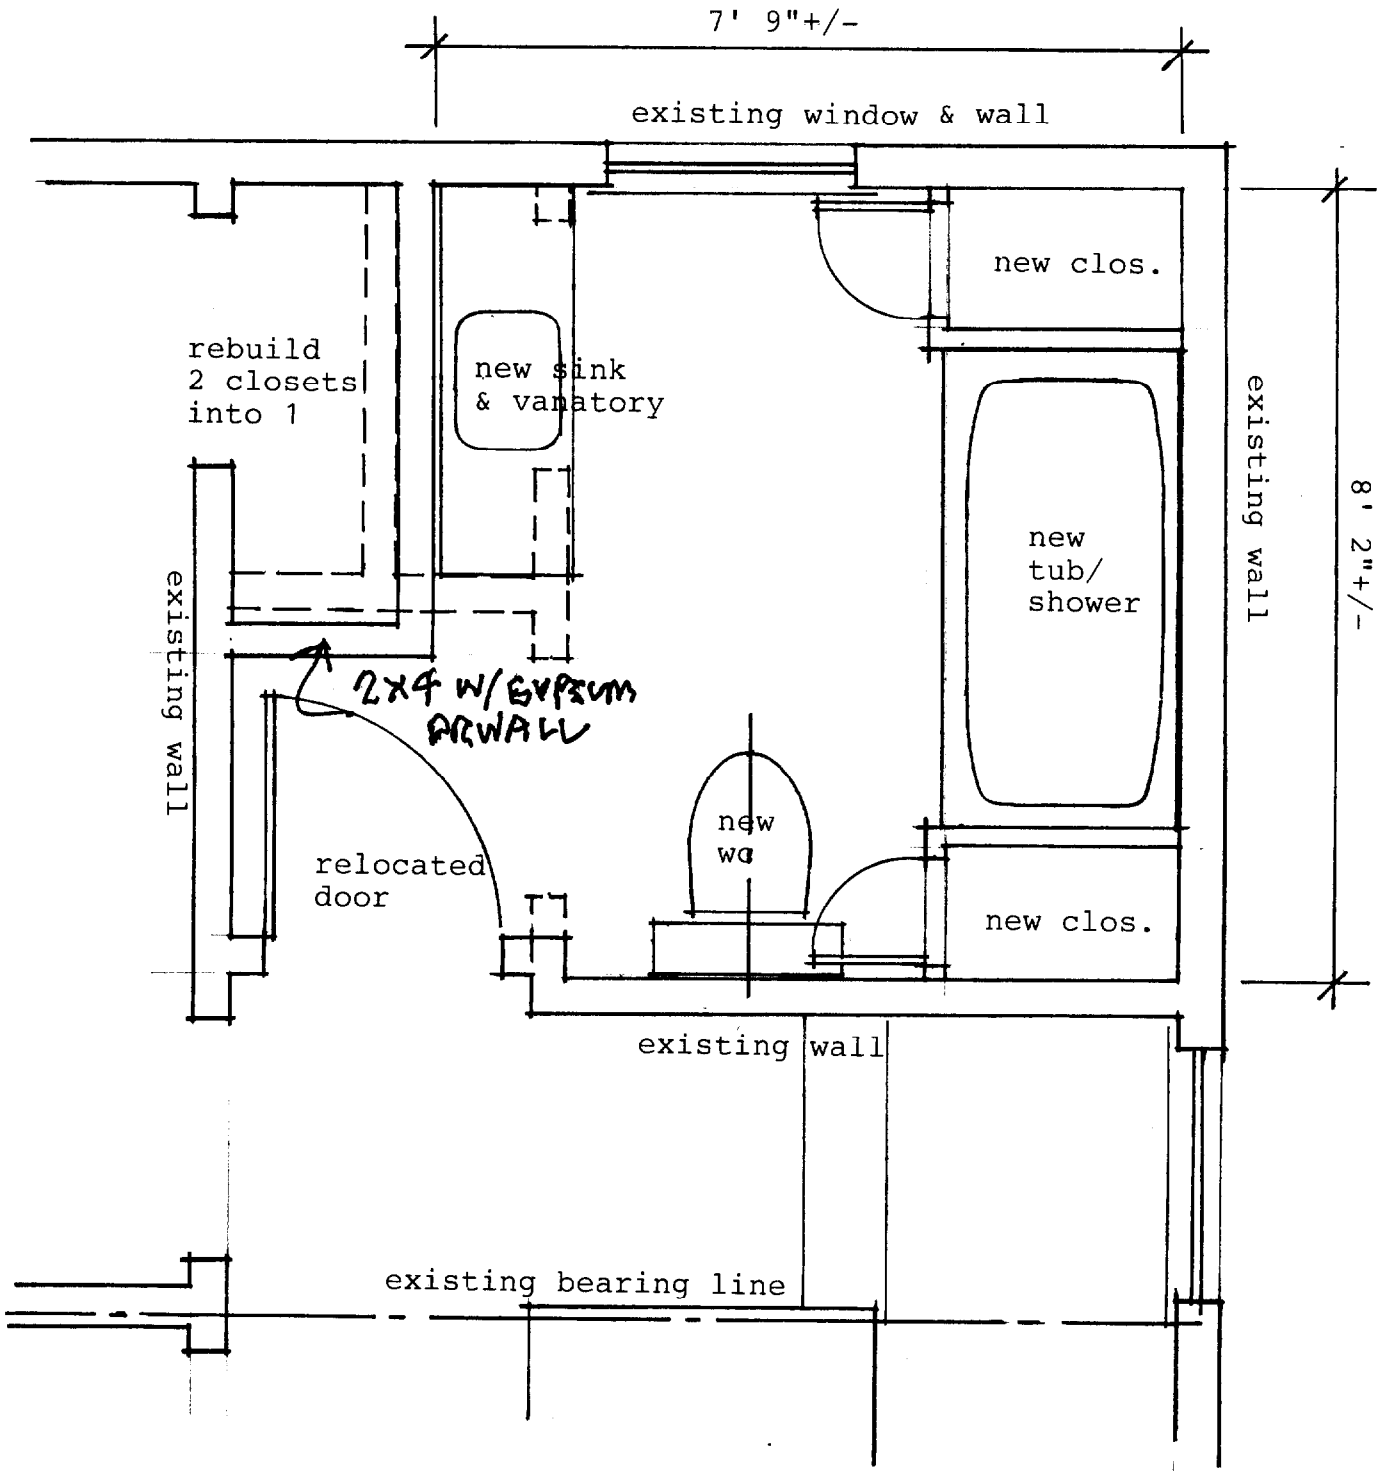

BATHROOM RENOVATION
 68 Maine Avenue
 Portland, Maine

Scale 1/2"=1'0"
 June 2002

Sylvanus Doughty
 (207) 582 7007
 (207) 797 4240

