


EXISTING	LEGEND	PROPOSED
— — — — —	RIGHT-OF-WAY	— — — — —
— — — — —	PROPERTY LINE	— — — — —
— — — — —	ABUTTER PROPERTY LINE	— — — — —
— — — — —	SETBACK LINE	— — — — —
///	BUILDING	■
— — — — —	EDGE OF PAVEMENT	— — — — —
— W —	WATER LINE	— W —
— S —	SEWER LINE	— S —
— SD —	STORM DRAIN	— SD —
— UD —	UNDERDRAIN	— UD —
□	CATCH BASIN	□
○	DRAIN MANHOLE	○
⊙	SEWER MANHOLE	⊙
⊗	CURB STOP	⊗
— 65 —	CONTOUR	— 65 —
— — — — —	STREET TREE	○
— — — — —	WETLAND	— — — — —
— — — — —	FOUNDATION DRAIN	— — — — —
— — — — —	SILT BARRIER	— — — — —
— — — — —	SILT SACK	○

NOTES:

- PLAN REFERENCE: "PLAN PROFILE, STREET EXTENSION, VAN VECHTEN STREET, PORTLAND, MAINE" BY DALFONSO ENGINEERING, DATED 10/12/2016, APPROVED PER CITY CODE SECTION 14-403, 11/08/2016.
- RECORD OWNER: MATILDA GIOBBI, 1184 WASHINGTON AVE. PORTLAND, ME 04103, CCRD BOOK 17863, PAGE 069.
- ELEVATIONS: DIMENSIONS REFERENCE CITY DATUM.
- TAX MAP REFERENCE: 410-C-30001
- ZONING: R-3
- SOIL TYPE: FROM NRCS SOIL MAP "SN" SCANTIC SILT LOAM.
- PARCEL AREA: 8,001 S.F.
- IMPERVIOUS AREA:
 HOUSE = 870 S.F.
 PORCH = 221 S.F.
 WALKWAY = 103 S.F.
 DRIVEWAY = 805 S.F.

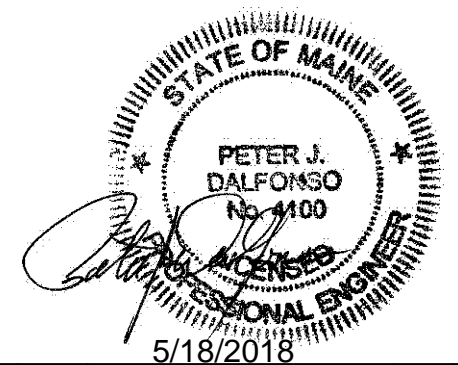


REV.	DATE	REVISION DESCRIPTION	DRAWN	CHK'D
1	4/05/2018	SUBMITTED FOR BUILDING PERMIT	DB	PJD

SITE PLAN

13 VAN VECHTEN STREET
 PORTLAND, MAINE

Client: **HIGGINS BUILDERS, INC.**
 83 BAY STREET
 PORTLAND, MAINE 04103

Prepared by:	DATE:	3/16/2018
Dalfonso Engineering	PROJ. #:	118
CIVIL ENGINEERING SERVICES 17 Ledge Hill Road Gorham, Maine 04038 Phone: 207-749-4801 Email: pjdal@maine.rr.com	SCALE:	1"=20'
		3 OF 4

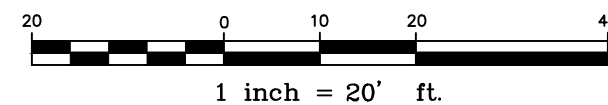



Exterior Elevation Front

Elevations are approximated and need to be verified on site prior to pouring foundation.



Exterior Elevation Left

NOTE:
SMOKE ALARMS/CO DETECTORS
SHALL BE INSTALLED IN THE
FOLLOWING LOCATIONS:
1: EACH SLEEPING AREA
2: OUTSIDE EACH SEPARATE SLEEPING
AREA IN THE IMMEDIATE VICINITY
OF THE BEDROOMS
3: ALL SMOKE ALARMS SHALL BE
INTERCONNECTED

Please add a note
about the sprinkler
installation

Rough openings to be determined by builder.
Placement of openings to be determined by builder.



Exterior Elevation Right



Exterior Elevation Back

THESE REPRESENTATIONS
PROVIDED TO ILLUSTRATE
CONCEPTS ONLY. CONTRACTOR
ARE NOT WORK OF AN
ARCHITECT. CONTRACTOR IS RESPONSIBLE
FOR VERIFYING ALL MECHANICAL ASPECTS OF THE
DESIGN AGAINST THE LATEST EDITIONS OF THE
CODES AND THE REQUIREMENTS OF THE
CONTRACT.

REVISION TABLE	NUMBER	DATE	DESCRIPTION

HIGGINS LOT 3

HIGGINS LOT 3

DRAWINGS PROVIDED BY:

DATE:

4/27/2018

SCALE:

AS NOTED

SHEET:


P-1

Elevations are approximated and need to be verified on site prior to pouring foundation.

Rough openings to be determined by builder.
Placement of openings to be determined by builder.


Please provide a Door Schedule

WINDOW SCHEDULE									
NUMBER	LABEL	QTY	FLOOR	SIZE	WIDTH	HEIGHT	EGRESS	DESCRIPTION	TEMPERED
W01	2440DH	1	2	2440DH	28"	48"		DOUBLE HUNG	
W02	2830DH	1	1	2830DH	32"	35 7/8"		DOUBLE HUNG	
W03	2840DH	1	1	2840DH	32"	48"		DOUBLE HUNG	YES
W04	2840DH	2	2	2840DH	32"	48"		DOUBLE HUNG	YES
W05	3050DH	4	1	3050DH	36"	60"		DOUBLE HUNG	
W06	3050DH	2	2	3050DH	36"	60"		DOUBLE HUNG	
W07	3050DH	3	2	3050DH	36"	60"	YES	DOUBLE HUNG	
W08	6016FX	1	2	6016FX	172"	18"		FIXED GLASS	

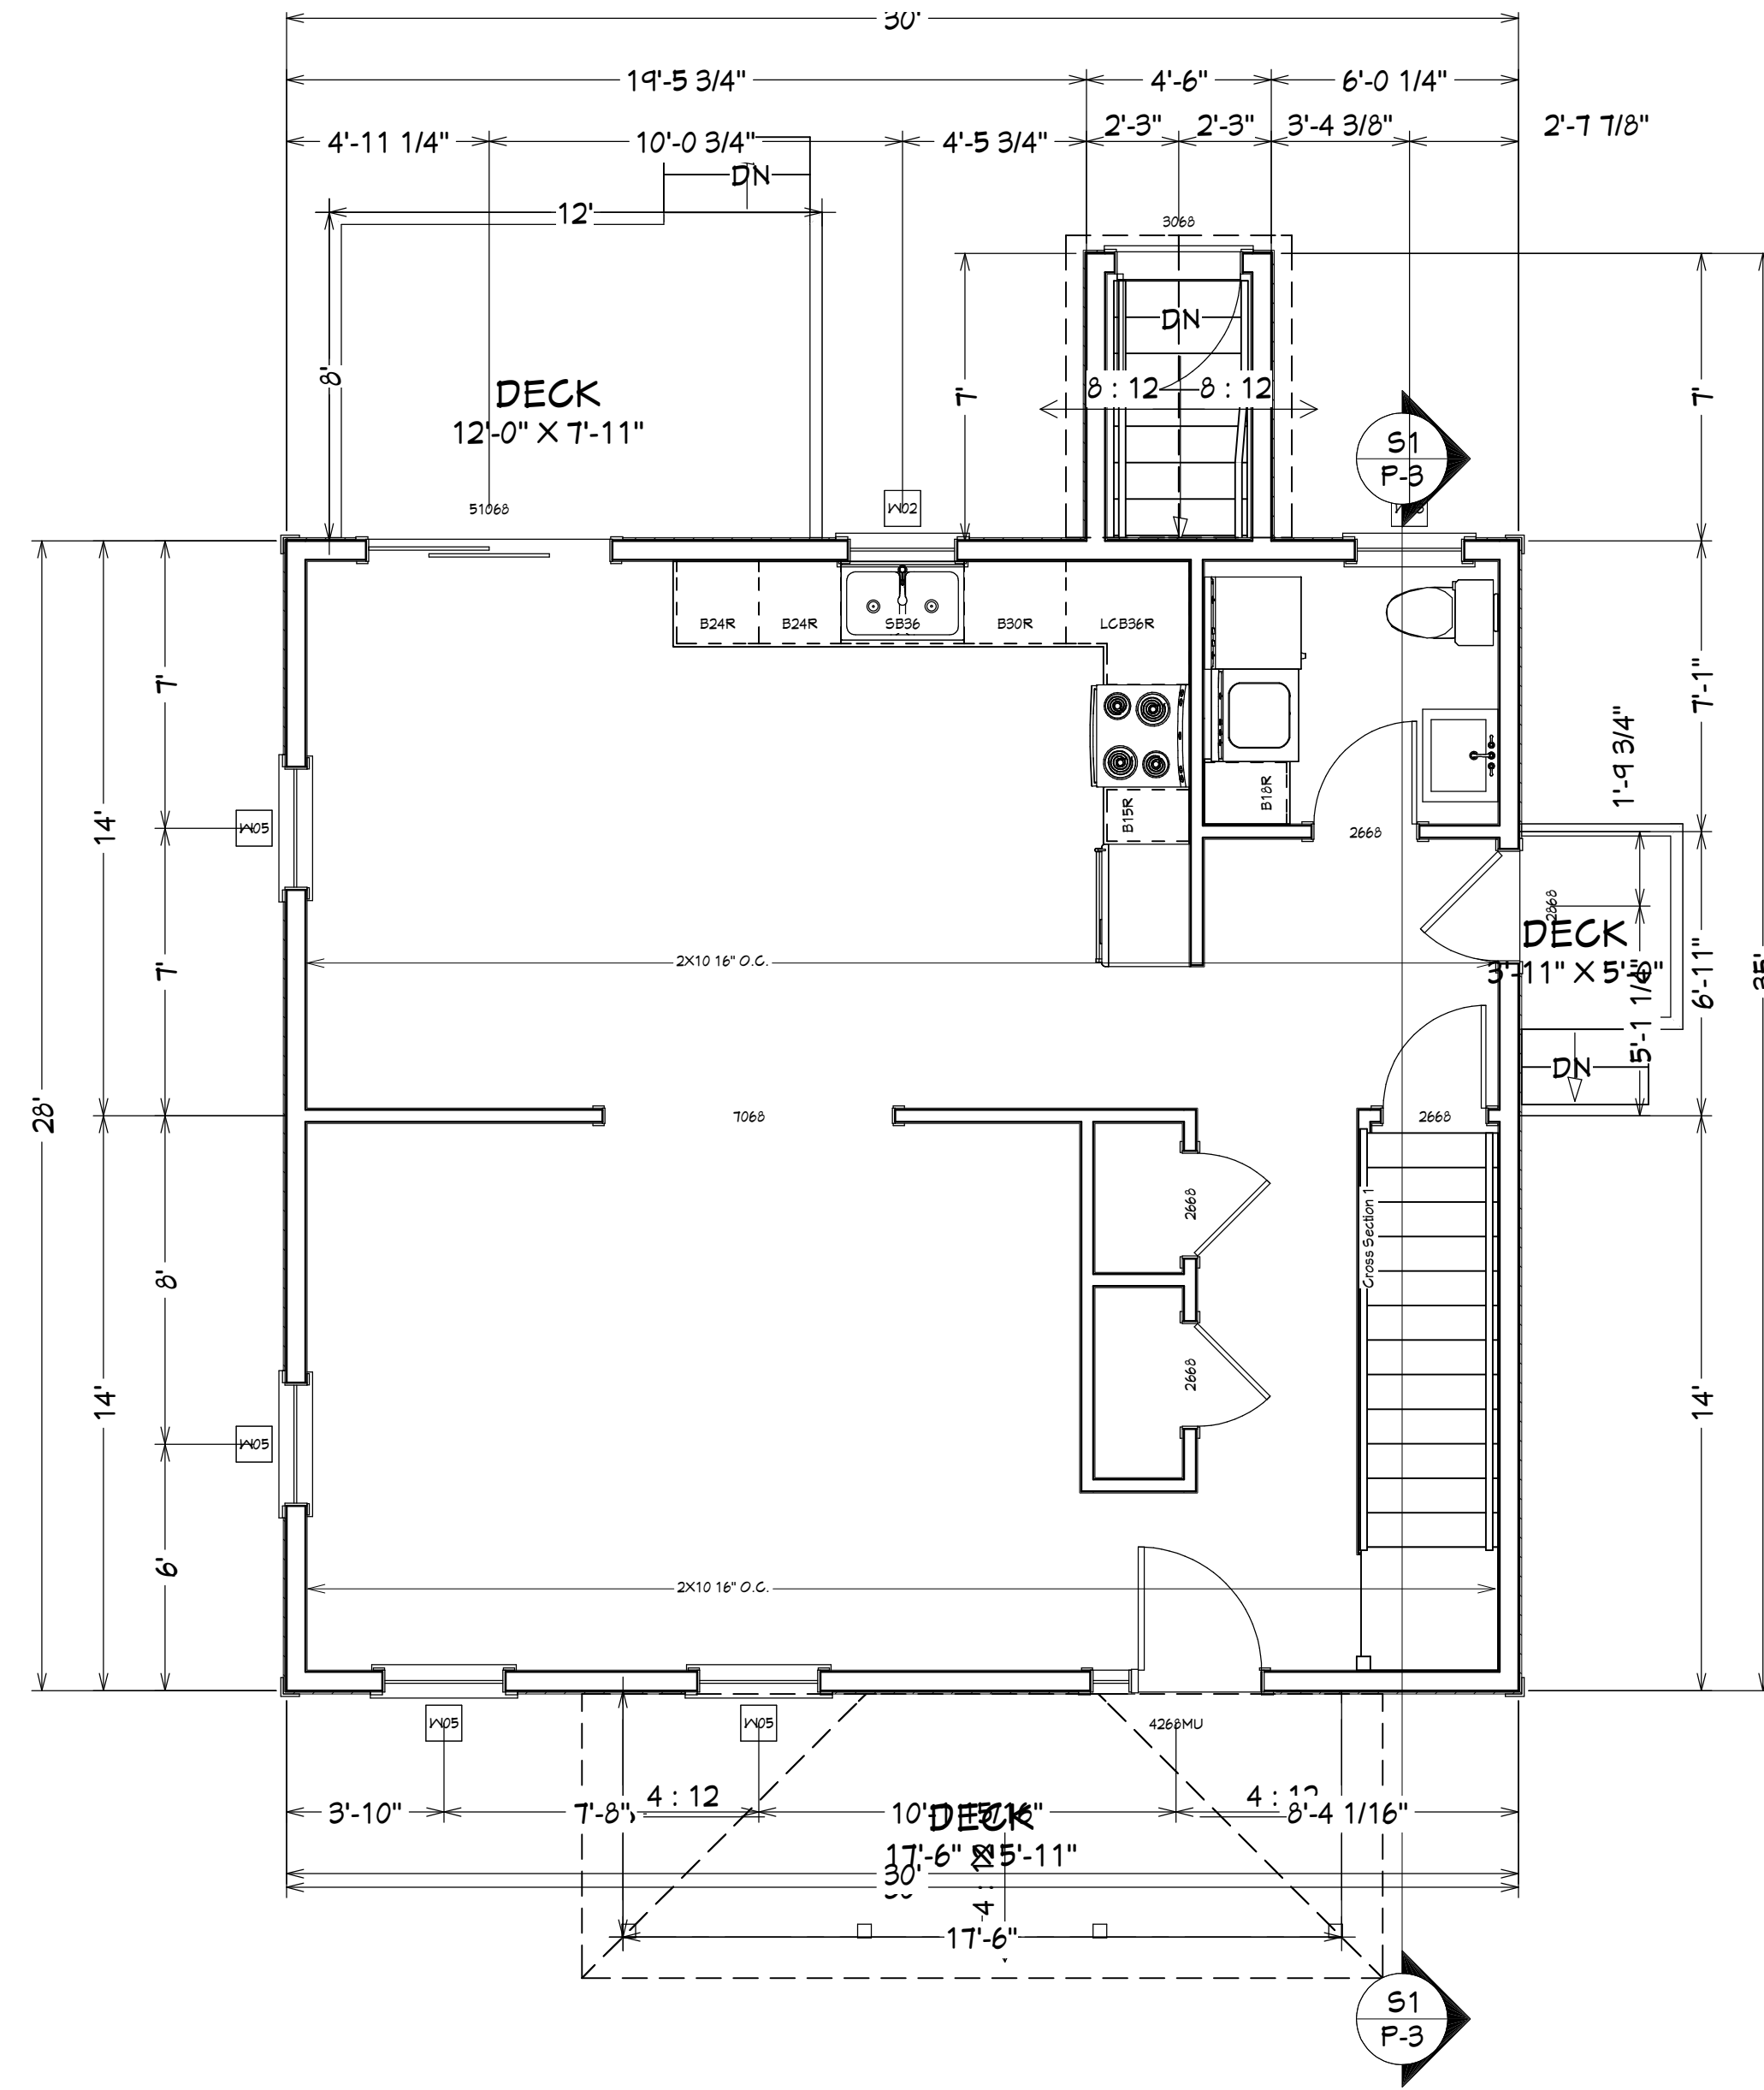

LIVING AREA
840 SQ FT
1st Floor 1/4 in = 1 ft

Please provide the location of the attic scuttle, dimensions, door R-value, and if using blown in cellulose, how it will comply with IECC Sec. 402.2.3

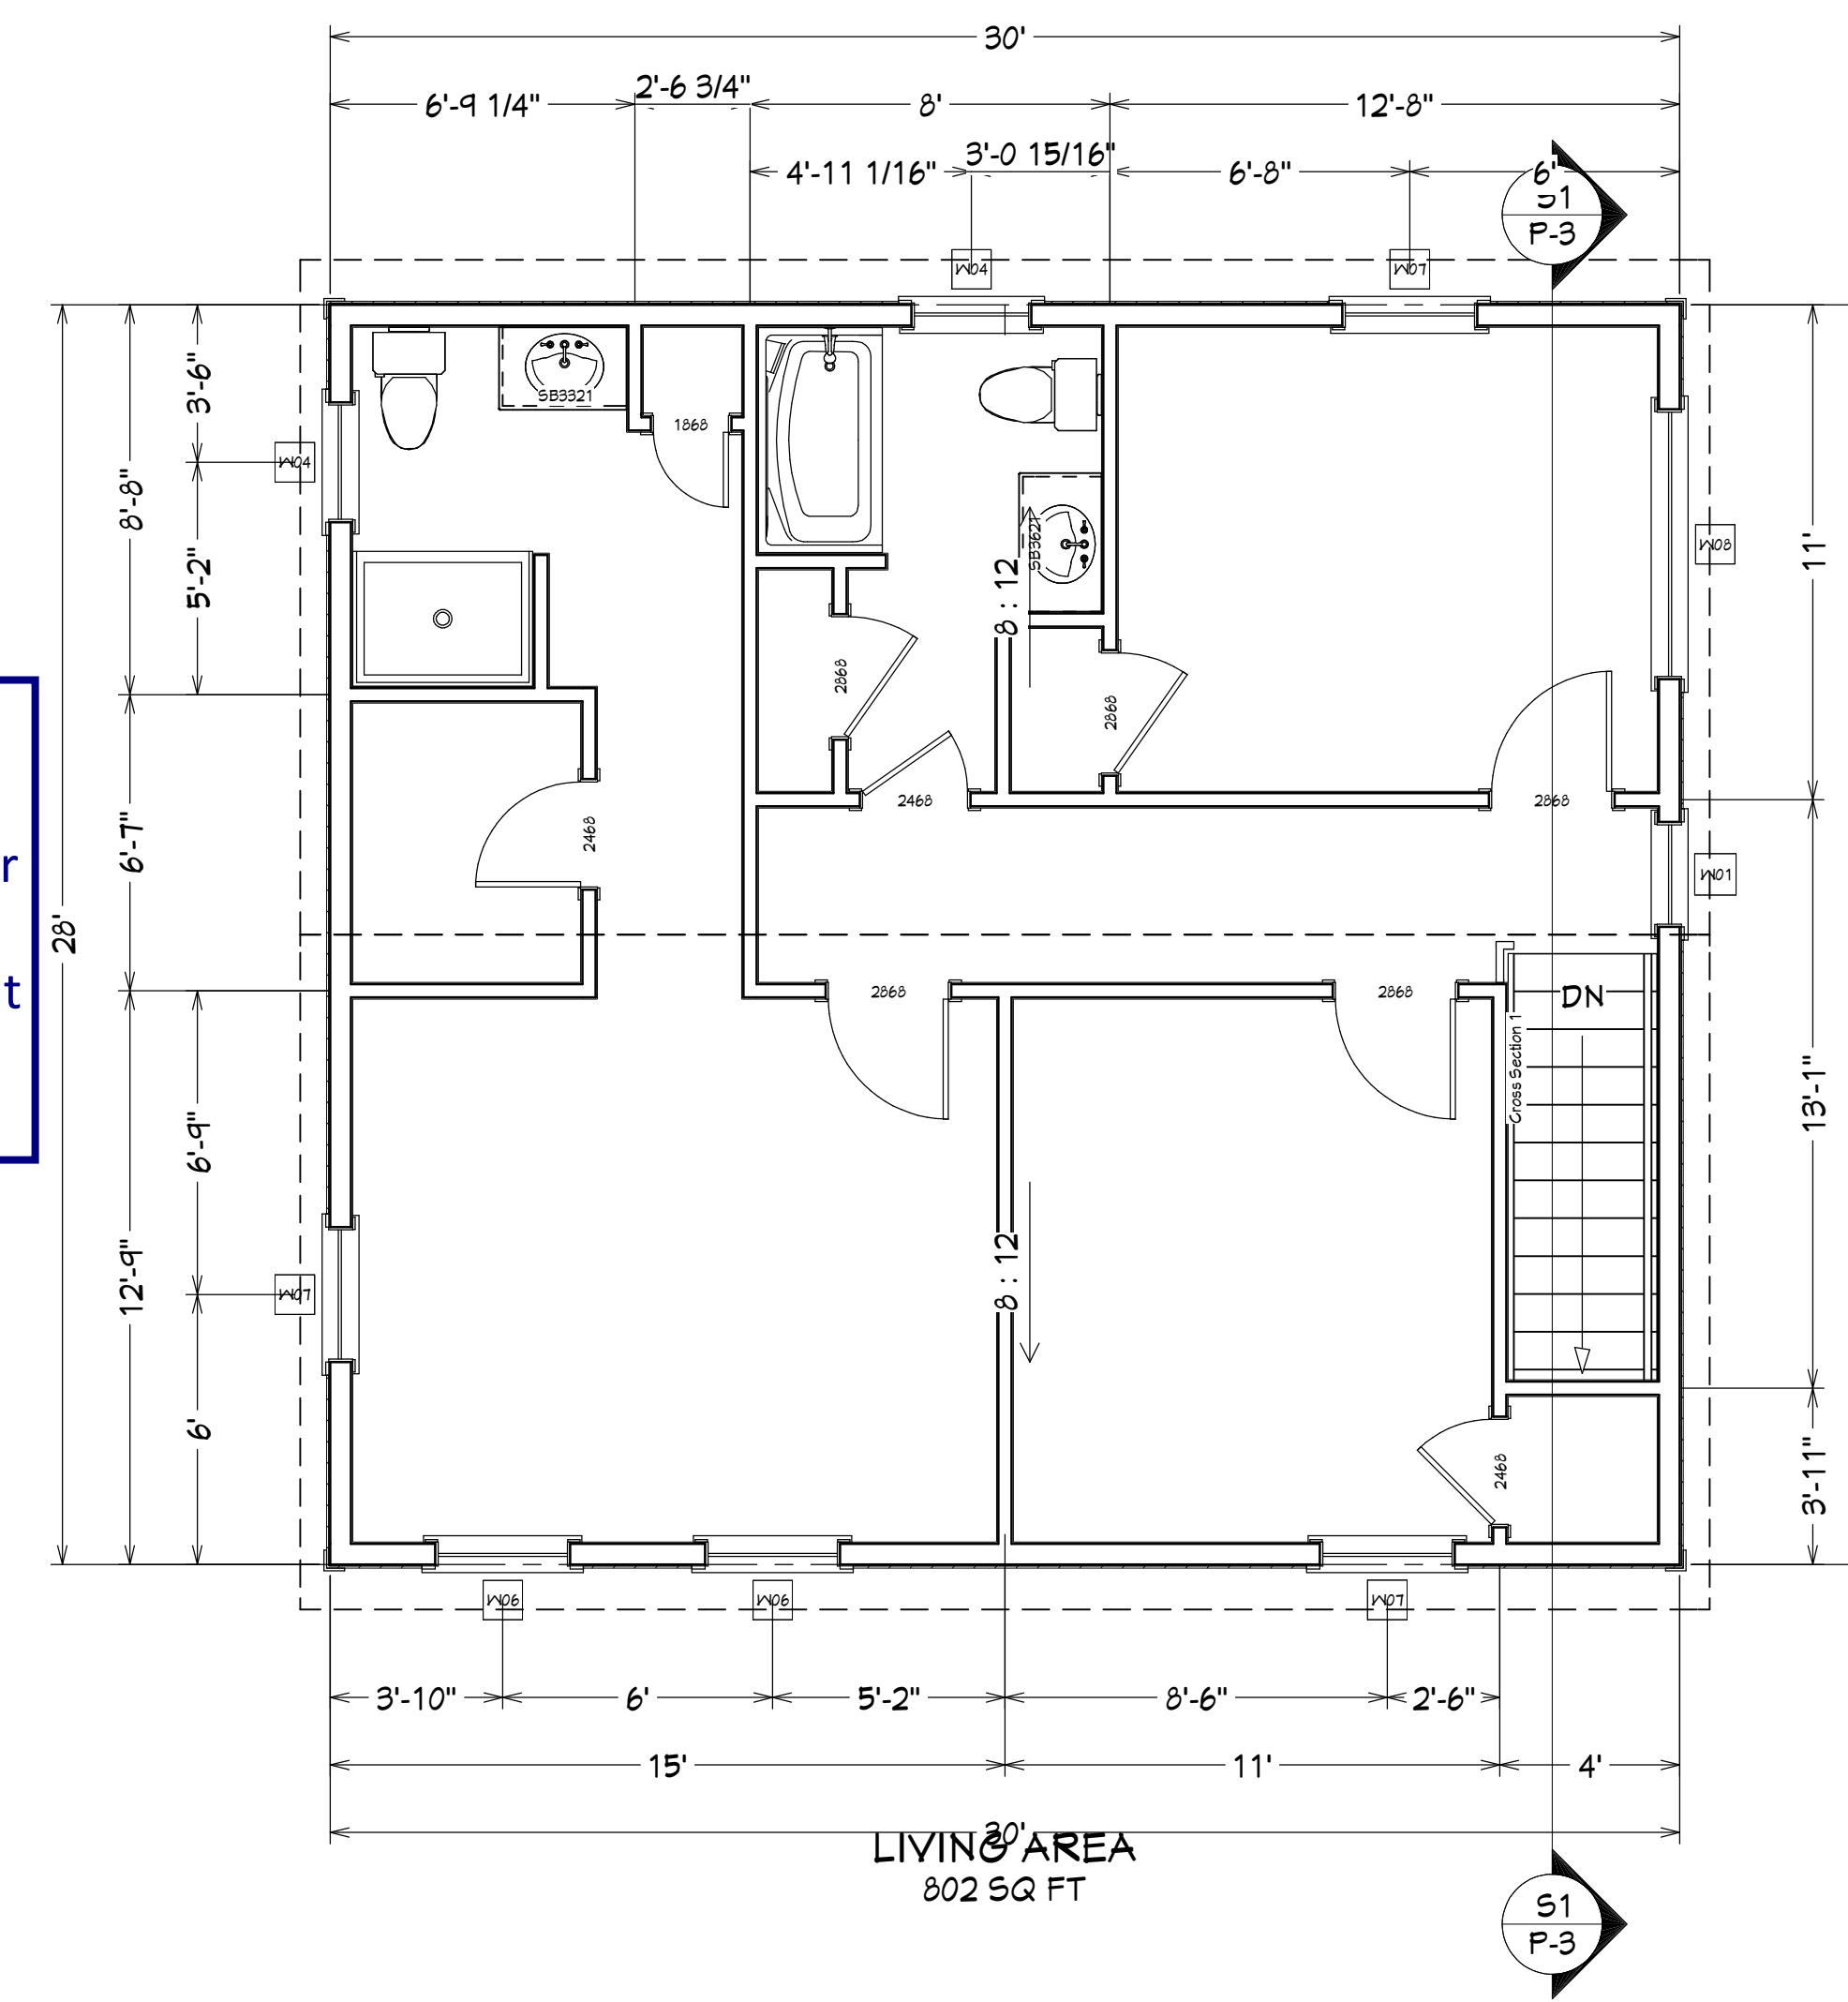

2nd Floor 1/4 in = 1 ft

NOTE:
SMOKE ALARMS/CO DETECTORS SHALL BE INSTALLED IN THE FOLLOWING LOCATIONS:
1: EACH SLEEPING AREA
2: OUTSIDE EACH SEPARATE SLEEPING AREA IN THE IMMEDIATE VICINITY OF THE BEDROOMS
3: ALL SMOKE ALARMS SHALL BE INTERCONNECTED

REVISION TABLE		REVISION BY	DESCRIPTION
NUMBER	DATE		

HIGGINS LOT 3

DRAWINGS PROVIDED BY:

DATE:
4/27/2018

SCALE:
AS NOTED

SHEET:
P-2



Exterior Elevation Front

Elevations are approximated and need to be verified on site prior to pouring foundation.



Exterior Elevation Left

NOTE:
SMOKE ALARMS/CO DETECTORS SHALL BE INSTALLED IN THE FOLLOWING LOCATIONS:
1: EACH SLEEPING AREA
2: OUTSIDE EACH SEPARATE SLEEPING AREA IN THE IMMEDIATE VICINITY OF THE BEDROOMS
3: ALL SMOKE ALARMS SHALL BE INTERCONNECTED

Rough openings to be determined by builder.
Placement of openings to be determined by builder.



Exterior Elevation Right



Exterior Elevation Back

THESE REPRESENTATIONS ARE PROVIDED TO ILLUSTRATE THE APPEARANCE OF THE WORK AND ARE NOT WORK OF AN ARCHITECT. THE CONTRACTOR IS RESPONSIBLE FOR OBTAINING ALL NECESSARY MECHANICAL AGREEMENTS OF THE CODES AND THE BUILDING CODES ARE THE RESPONSIBILITY OF THE CONTRACTOR.

REVISION TABLE	NUMBER	DATE	DESCRIPTION

HIGGINS LOT 3

HIGGINS LOT 3

DRAWINGS PROVIDED BY:

DATE:

3/9/2018

SCALE:

AS NOTED


SHEET:

P-1

This is a duplicate plan, please remove one P-2 plan


Elevations are approximated and need to be verified on site prior to pouring foundation.

Rough openings to be determined by builder.
Placement of openings to be determined by builder.

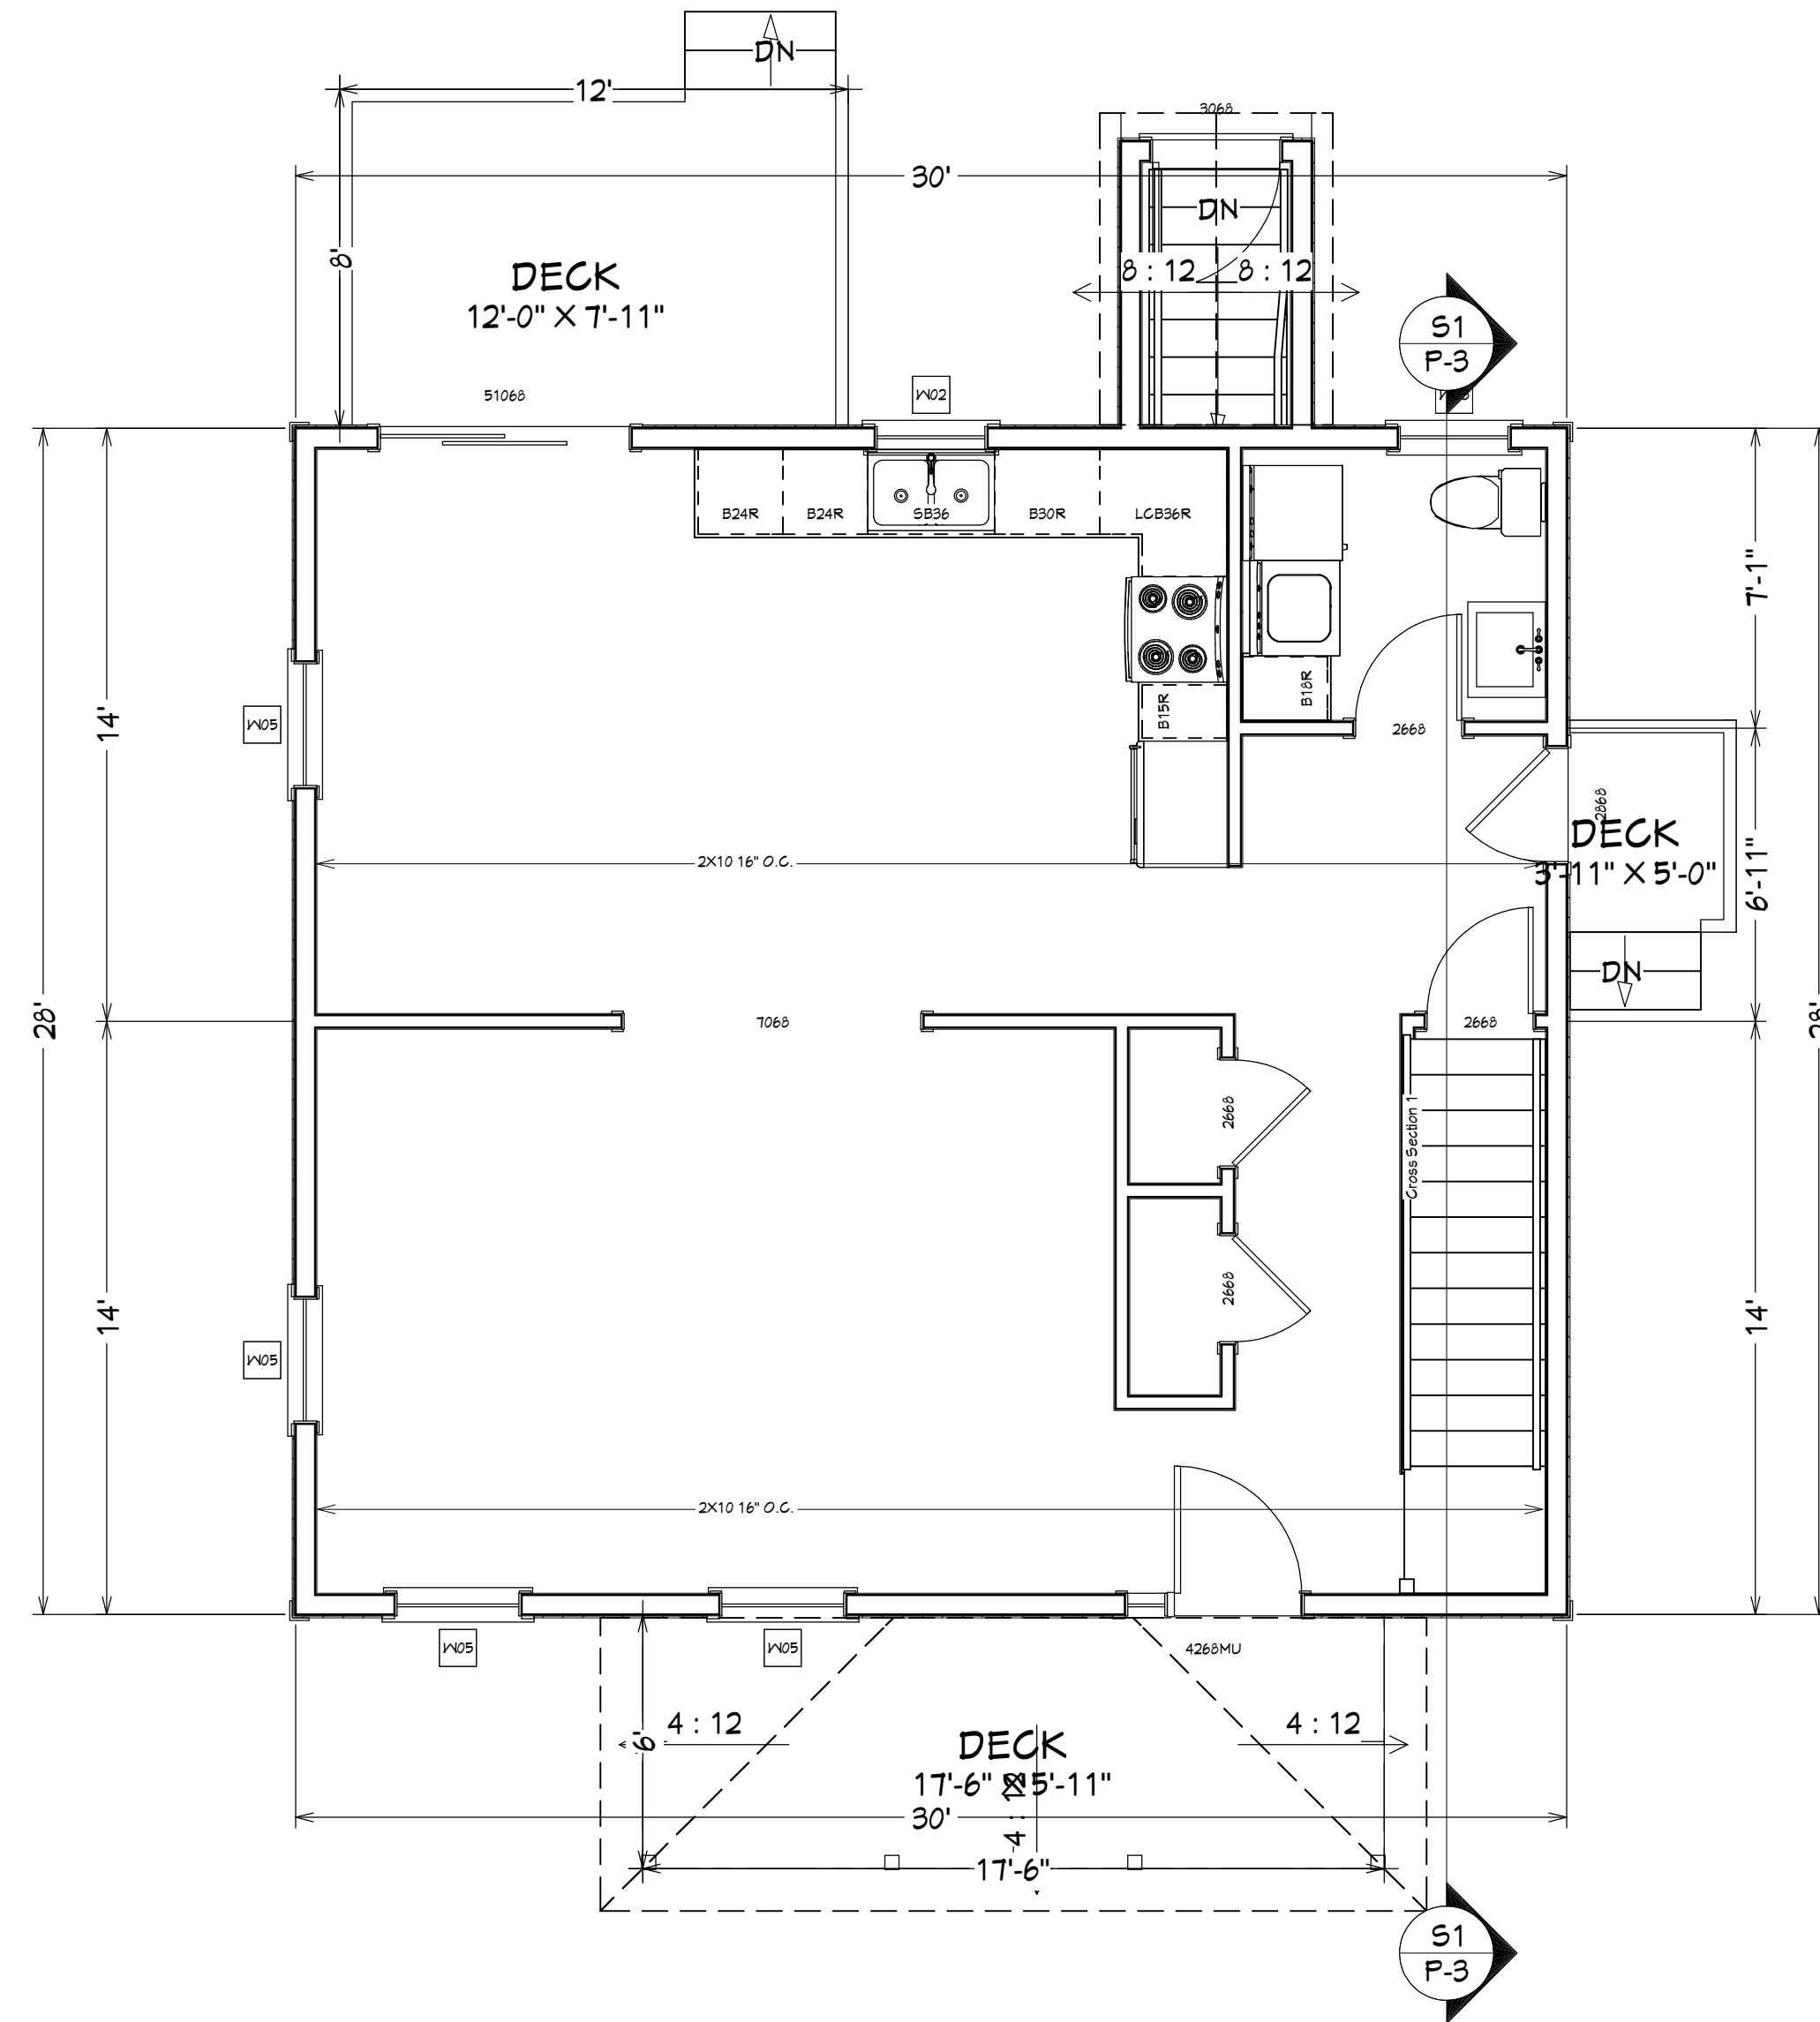

LIVING AREA
840 SQ FT
1st Floor 1/4 in = 1 ft

WINDOW SCHEDULE									
NUMBER	LABEL	QTY	FLOOR	SIZE	WIDTH	HEIGHT	EGRESS	DESCRIPTION	TEMPERED
W01	2440DH	1	2	2440DH	28"	48"		DOUBLE HUNG	
W02	2830DH	1	1	2830DH	32"	35 7/8"		DOUBLE HUNG	
W03	2840DH	1	1	2840DH	32"	48"		DOUBLE HUNG	YES
W04	2840DH	2	2	2840DH	32"	48"		DOUBLE HUNG	YES
W05	3050DH	4	1	3050DH	36"	60"		DOUBLE HUNG	
W06	3050DH	2	2	3050DH	36"	60"		DOUBLE HUNG	
W07	3050DH	3	2	3050DH	36"	60"	YES	DOUBLE HUNG	
W08	6016FX	1	2	6016FX	172"	18"		FIXED GLASS	

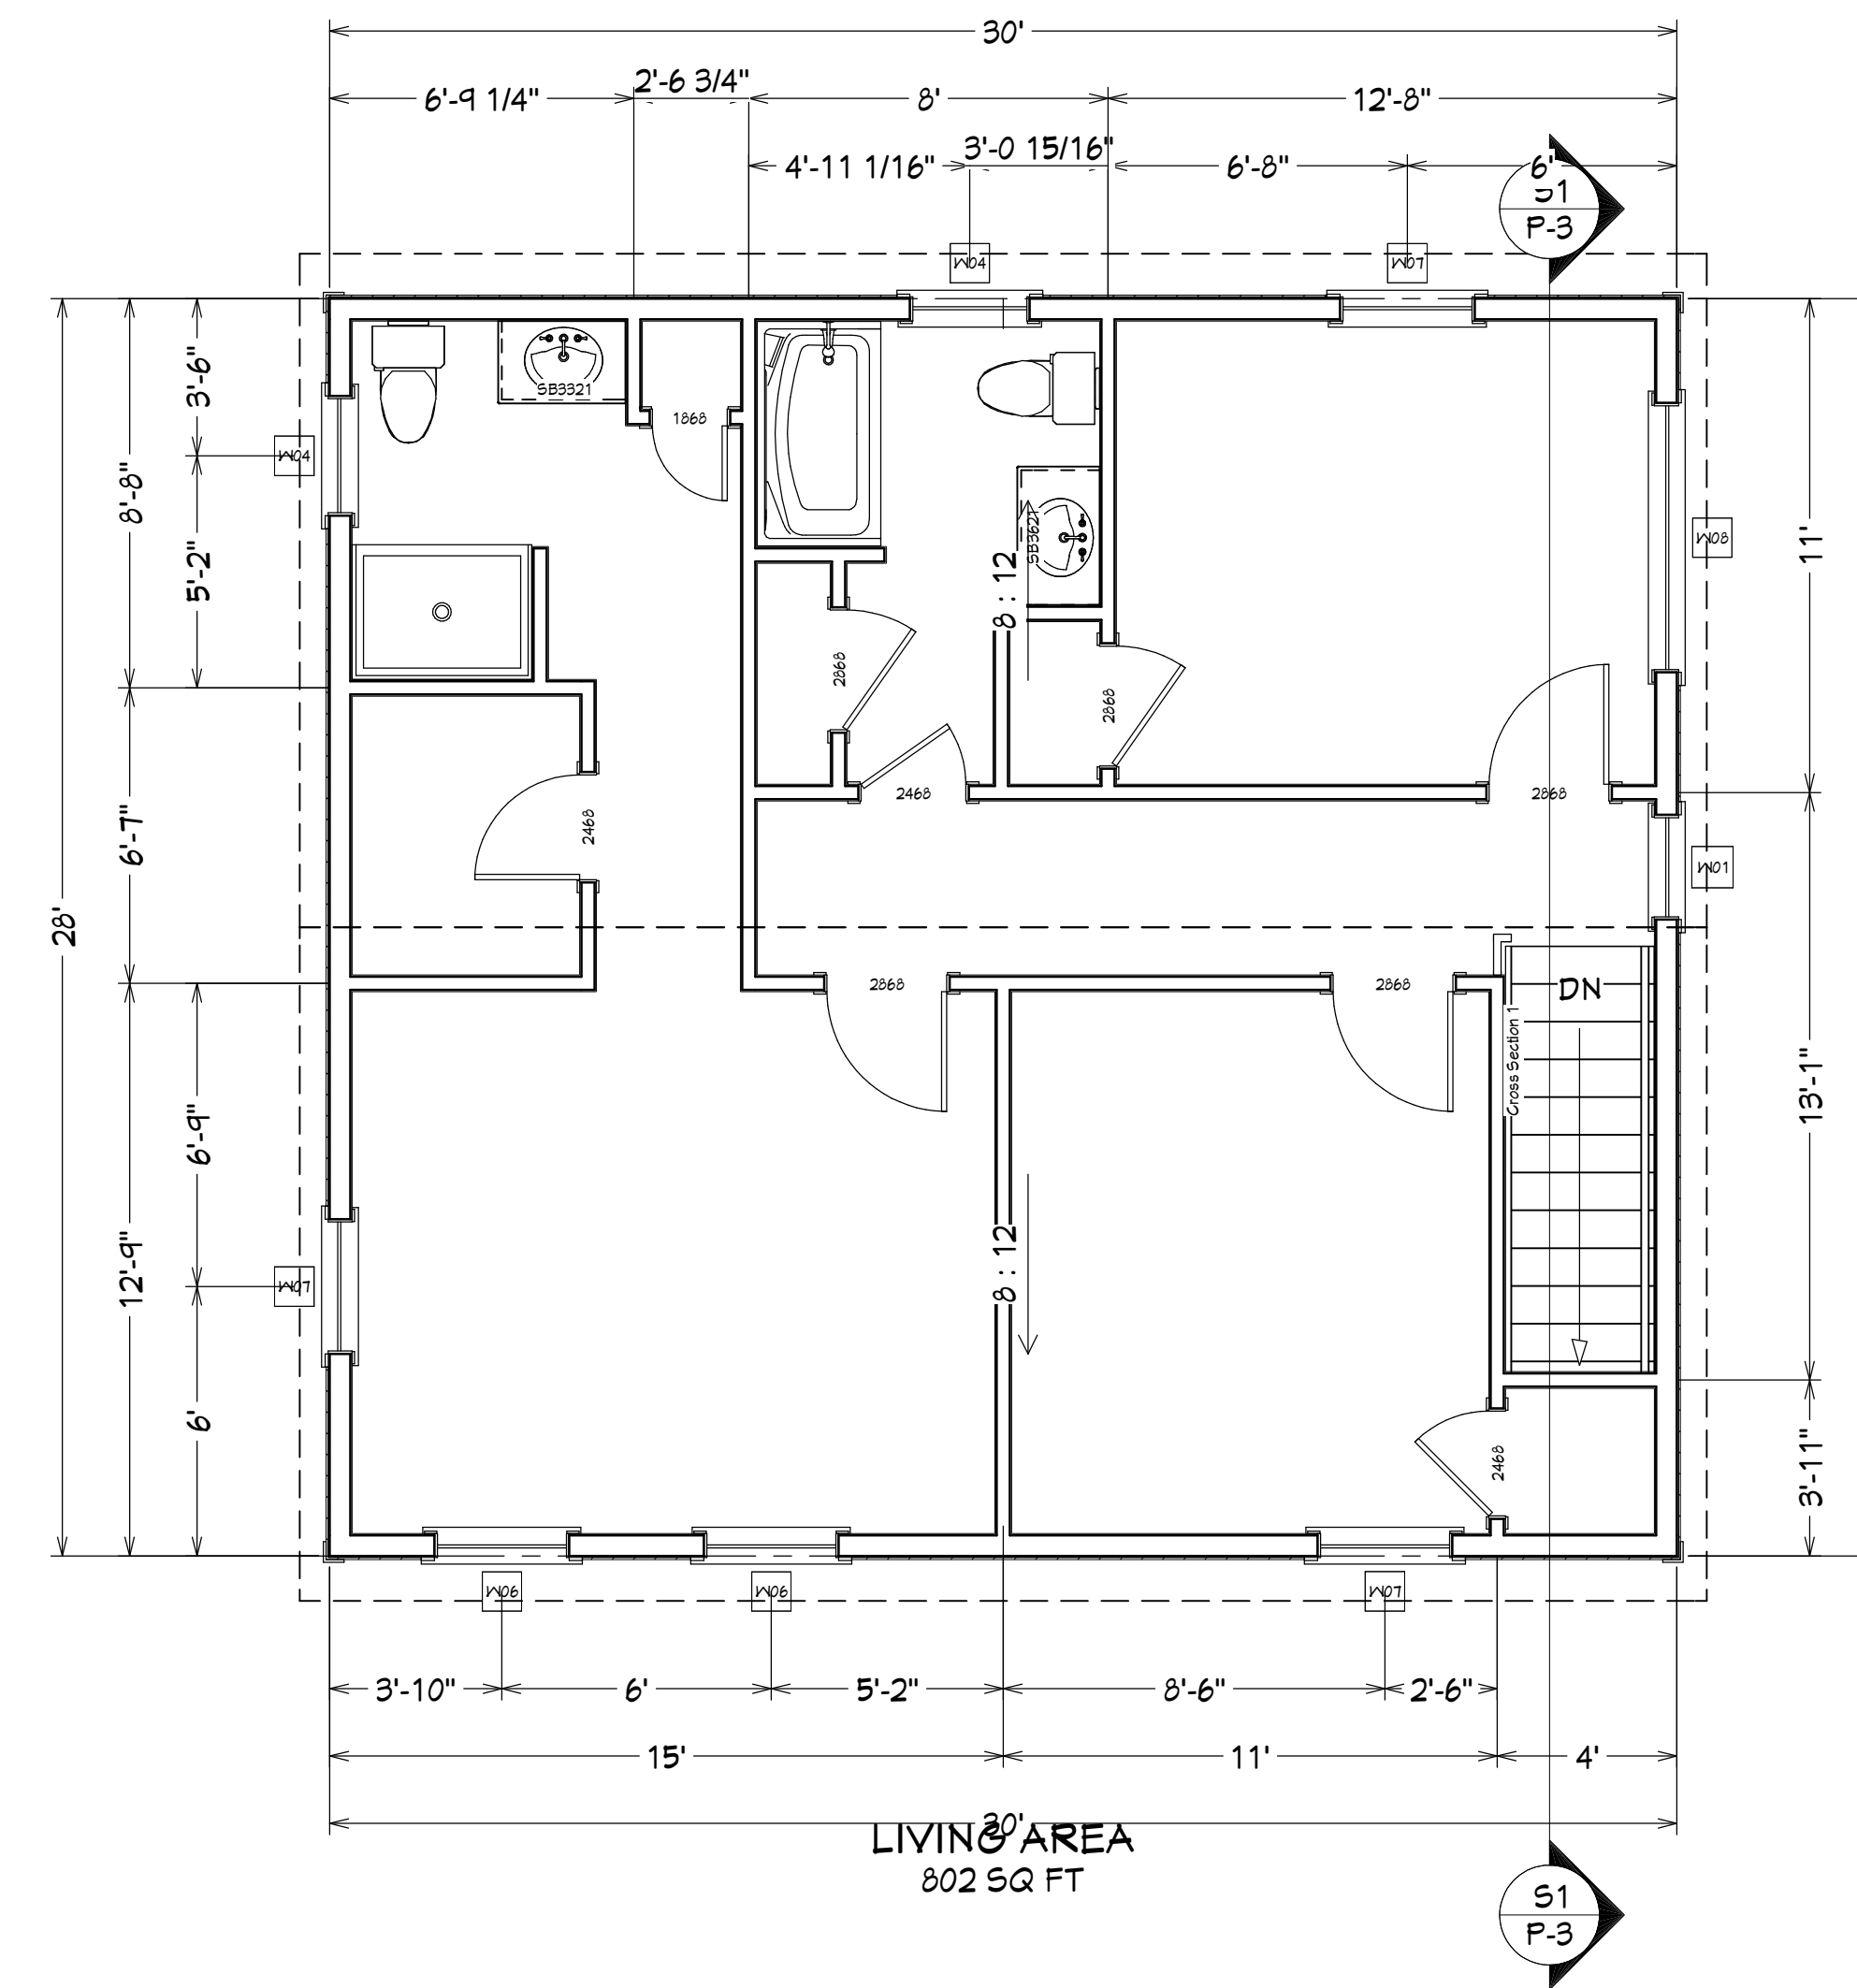

LIVING AREA
802 SQ FT
2nd Floor 1/4 in = 1 ft

NOTE:
SMOKE ALARMS/CO DETECTORS
SHALL BE INSTALLED IN THE
FOLLOWING LOCATIONS:
1: EACH SLEEPING AREA
2: OUTSIDE EACH SEPARATE SLEEPING
AREA IN THE IMMEDIATE VICINITY
OF THE BEDROOMS
3: ALL SMOKE ALARMS SHALL BE
INTERCONNECTED

THE INFORMATION
PROVIDED TO ILLUSTRATE
THESE PLANS IS FOR GENERAL
REFERENCE ONLY. THE CONTRACTOR IS RESPONSIBLE
FOR VERIFYING ALL MECHANICAL ASPECTS OF THE
PLANS AGAINST THE BUILDING
CODES AND THE CITY OF HOUSTON
CONTRACTOR.

REVISION TABLE	REVISION BY	DESCRIPTION
NUMBER	DATE	

HIGGINS LOT 3

DRAWINGS PROVIDED BY:


DATE:
3/9/2018

SCALE:
AS NOTED

SHEET:
P-2

This is a duplicate plan, please revise one P-3 plan and remove one

Elevations are approximated and need to be verified on site prior to pouring foundation.

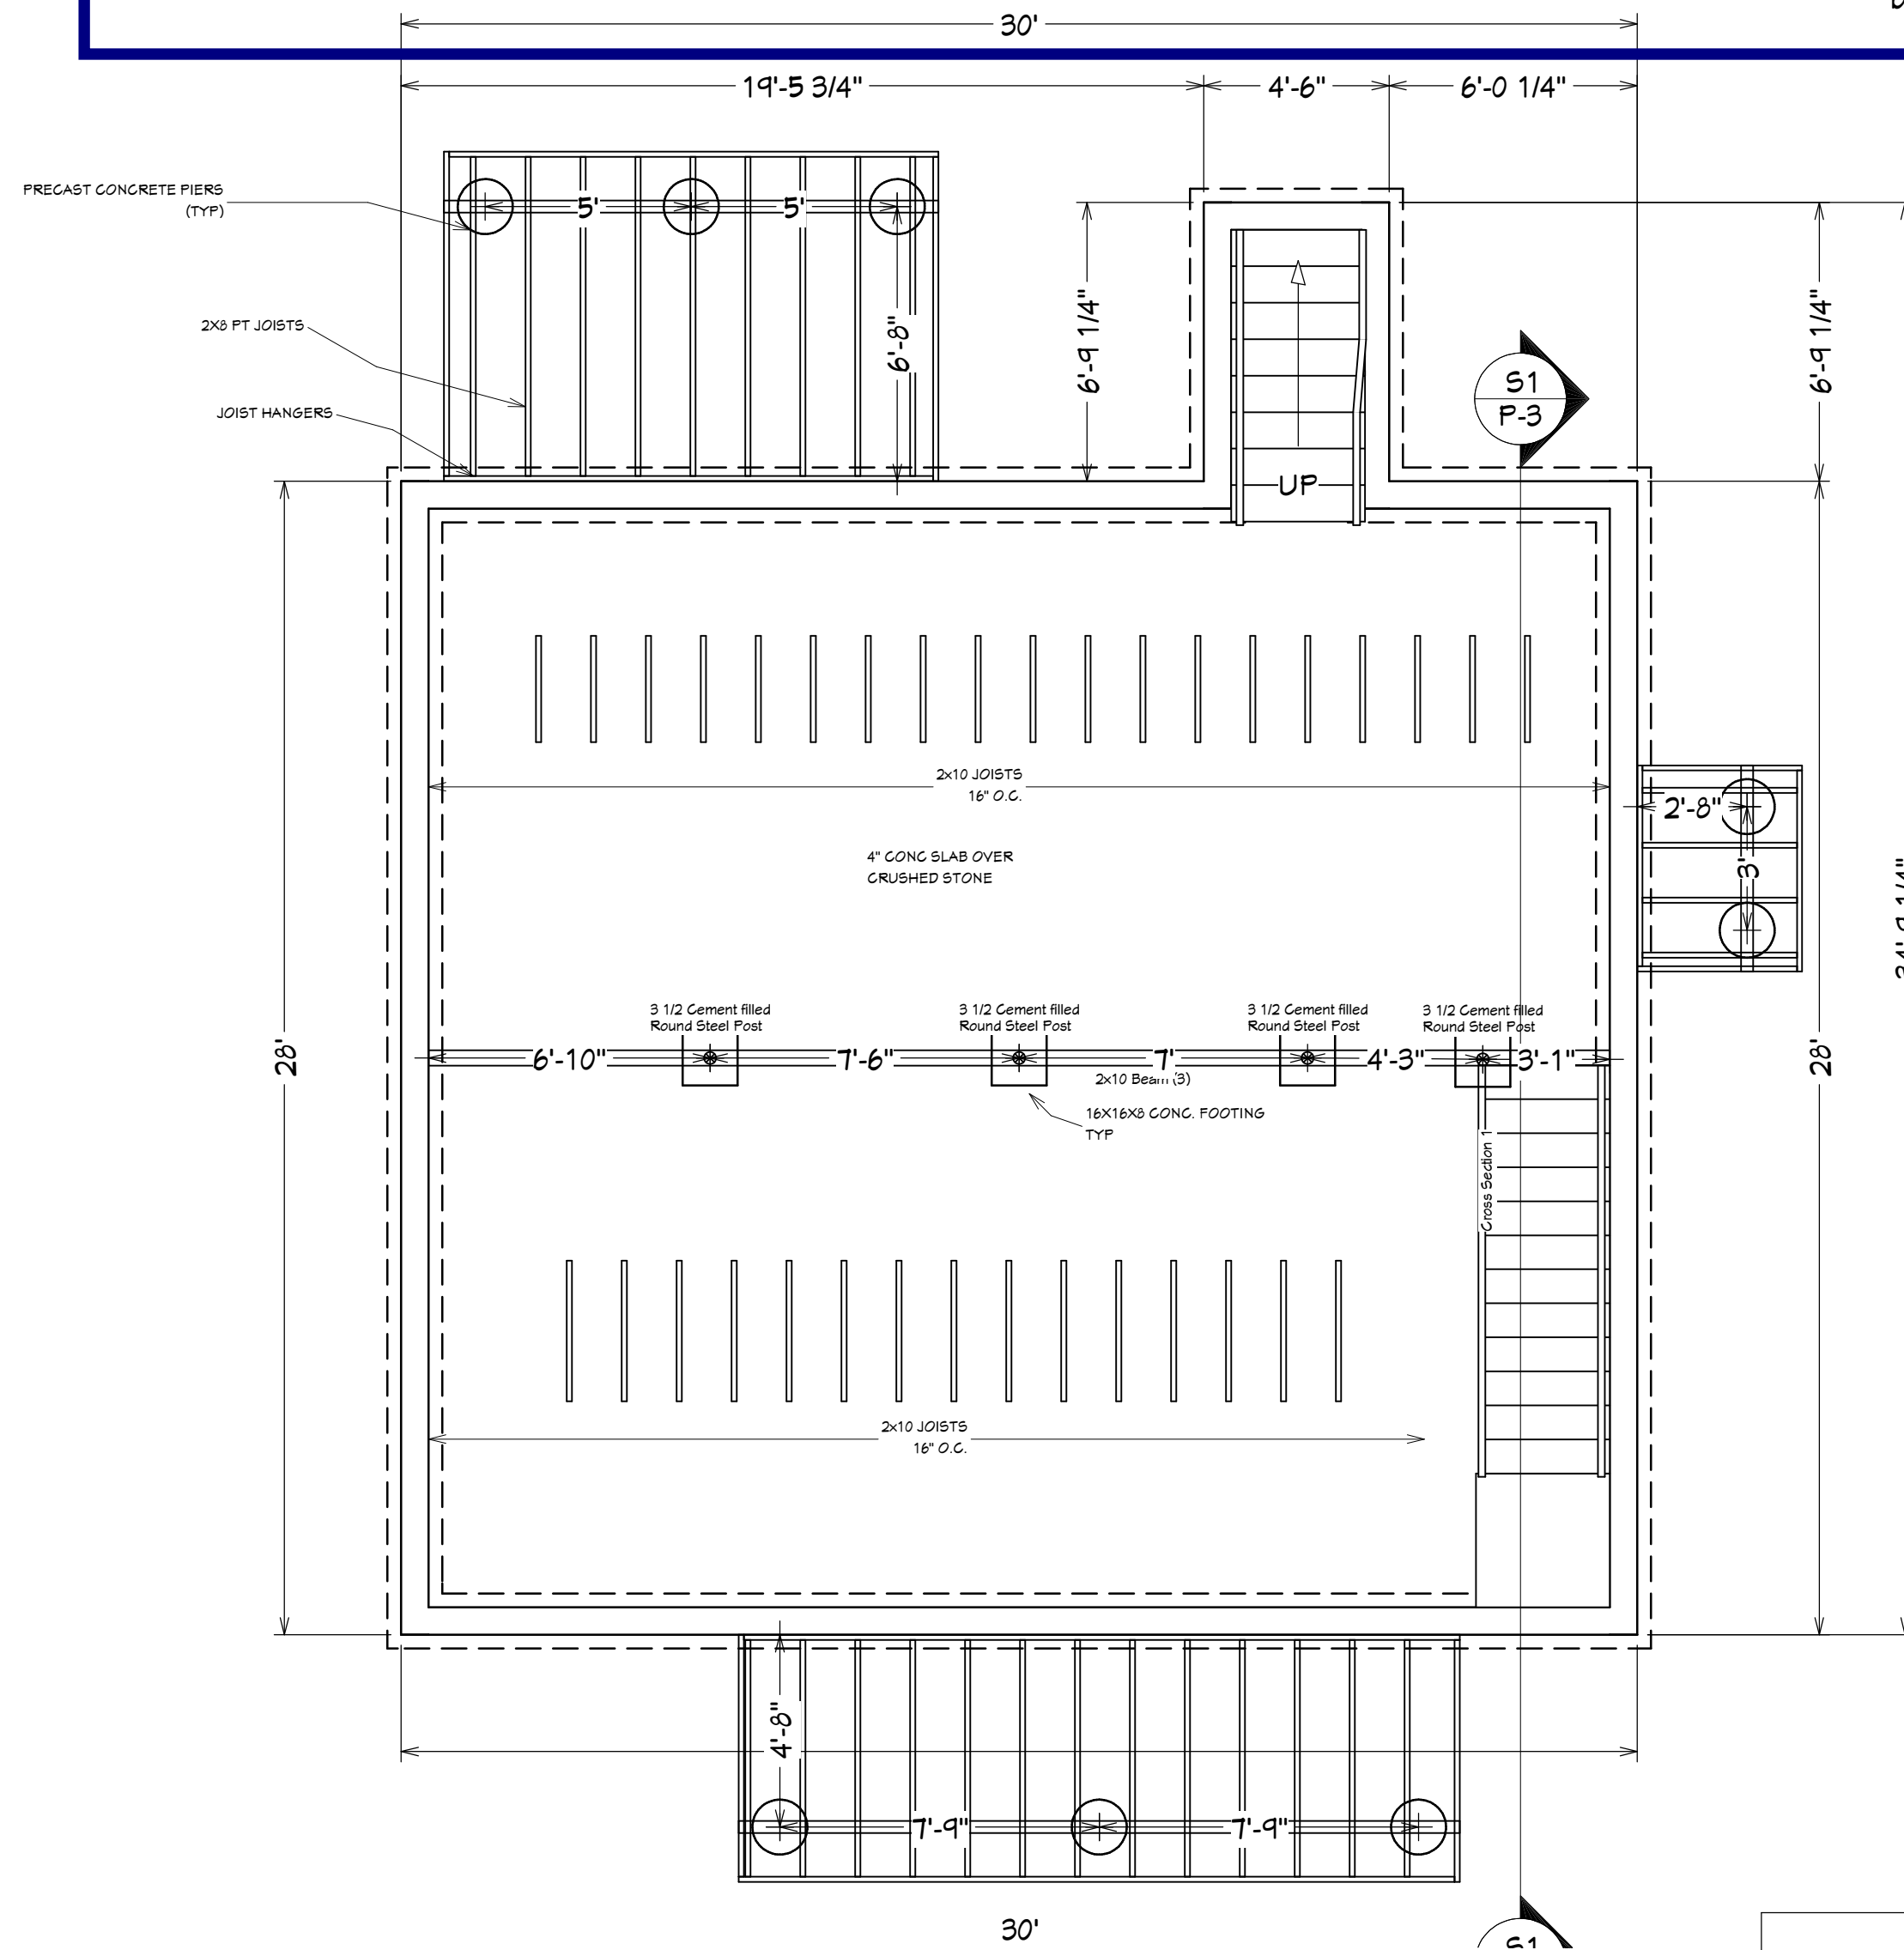

Foundation

TABLE R502.5(2)
GIRDER SPANS AND HEADER SPANS FOR INTERIOR BEARING WALLS
(Maximum spans for Douglas fir-larch, hem-fir, southern pine and spruce-pine-fir and required number of jack studs)

HEADERS AND GIRDERS SUPPORTING	SIZE	Building Width (feet)		
		Span NJ ^a		
		20	28	36
One floor only	2-2x4	3-1	2-8	1-2-5
	2-2x6	4-6	3-11	3-6
	2-2x8	5-9	5-0	2-4-5
	2-2x10	7-0	6-1	2-5-2
	2-2x12	8-1	7-0	2-6-3
	3-2x8	7-2	6-3	1-5-7
	3-2x10	8-9	7-7	2-6-9
	3-2x12	10-2	8-10	2-7-10
	4-2x8	5-10	5-1	2-4-6
	4-2x10	10-1	8-9	1-7-10
TWO floor only	2-2x4	2-2	1-10	1-7-1
	2-2x6	3-2	2-4	2-2-5
	2-2x8	4-1	3-6	2-3-2
	2-2x10	4-11	4-3	2-3-10
	2-2x12	5-9	2	3-4-5
	3-2x8	5-1	4-5	2-3-11
	3-2x10	6-2	5-4	2-4-10
	3-2x12	7-2	6-3	2-5-7
	4-2x8	4-2	3-7	2-3-2
	4-2x10	7-2	6-2	2-5-6
4-2x12	8-4	7-2	2-6-5	

DESCRIPTION OF BUILDING MATERIAL	DESCRIPTION OF FASTENER	SPACING OF FASTENERS	
		Edges (inches)	Intermediate support (inches)
wood structural panels, subfloor, roof and wall sheathing to framing, and particulate-board wall sheathing to framing	5/16" - 1/2" 8d common nail (subfloor, wall) 8d common nail (roof)	6	12"
1/2" gypsum sheathing	1-1/2" galvanized roofing nail 8d common nail staple 1/8ga., 1-1/2" long	3	6
1/2" regular cellular-fiberboard sheathing	1-3/4" galvanized roofing nail 8d common nail staple 1/8ga., 1-3/4" long	3	6
25/32" structural cellular-fiberboard sheathing	1-1/2" galvanized roofing nail 8d common nail staple galvanized 1-1/2" long 1-1/4" screws, type X or S	3	6
1/2" gypsum sheathing	1-1/2" galvanized roofing nail 8d common nail staple 1/8ga., 1-1/2" long	4	8
5/8" gypsum sheathing	1-1/2" galvanized roofing nail 8d common nail staple 1/8ga., 1-1/2" long	4	8
wood structural panels, combination subfloor underlayment to framing	3/4" and less 8d deformed nail or 8d common nail	6	12
1/2" - 1"	8d common nail or 8d deformed nail	6	12
1-1/2" - 1-1/4"	10d common nail or 8d deformed nail	6	12

For SI: 1 inch=25.4mm, 1 foot=304.8mm, 1 mile per hour=1.609km/h

a. All nails are smooth common, box or deformed shanks except where otherwise stated. Nails used for framing and sheathing connections shall have minimum average bending and strengths as shown: 50ksi (345 MPa) for shank diameter of 1/2 inch (20d common nail), 60ksi (415 MPa) for shank diameter larger than 1/2 inch but not larger than 1.125 inch, and 100ksi (689 MPa) for shank diameters of 1.125 inch and larger.

b. Staples are 18-gauge wire and have a minimum 7/16-inch on diameter crown width.

c. Nails shall be spaced at not more than 6 inches on center at all supports where spans are 48 inches or greater.

d. Four-foot by 8-foot or 4-foot by 8-foot panels shall be applied vertically.


e. Spacing of fasteners not included in this table shall be based on Table R502.5(1).

f. For regions having basic wind speed of 110mph or greater, 8d deformed nails shall be used for attaching plywood and wood structural panel roof.

g. For regions having basic wind speed of 100mph or less, nails for attaching wood structural panel roof sheathing to gable and wall framing shall be spaced 6 inches on center. When basic wind speed is greater than 100mph, nails for attaching panel roof sheathing to intermediate supports shall be spaced 8 inches on center. When basic wind speed is greater than 100mph, nails for attaching panel roof sheathing to gable and wall framing shall be spaced 6 inches on center for minimum 48-inch distance from ridges, eaves and gable walls, and 4 inches on center to gable and wall sheathing.

h. Gypsum sheathing shall conform to ASTM C94 and shall be installed in accordance with GA-255. Fiberboard sheathing shall conform to either ANSI A94.1 or ASTM C 225.

i. Spacing of fasteners on floor sheathing panel edges applies to panel edges supported by framing members and at all floor perimeters only. Spacing of fasteners on roof sheathing panel edges applies to panel edges supported by framing members and at all roof perimeters. Blocking of roof or floor sheathing panel edges perpendicular to the framing members shall not be required except at intersection of adjacent roof planes. Floor and roof perimeter shall be supported by framing members or solid blocking.

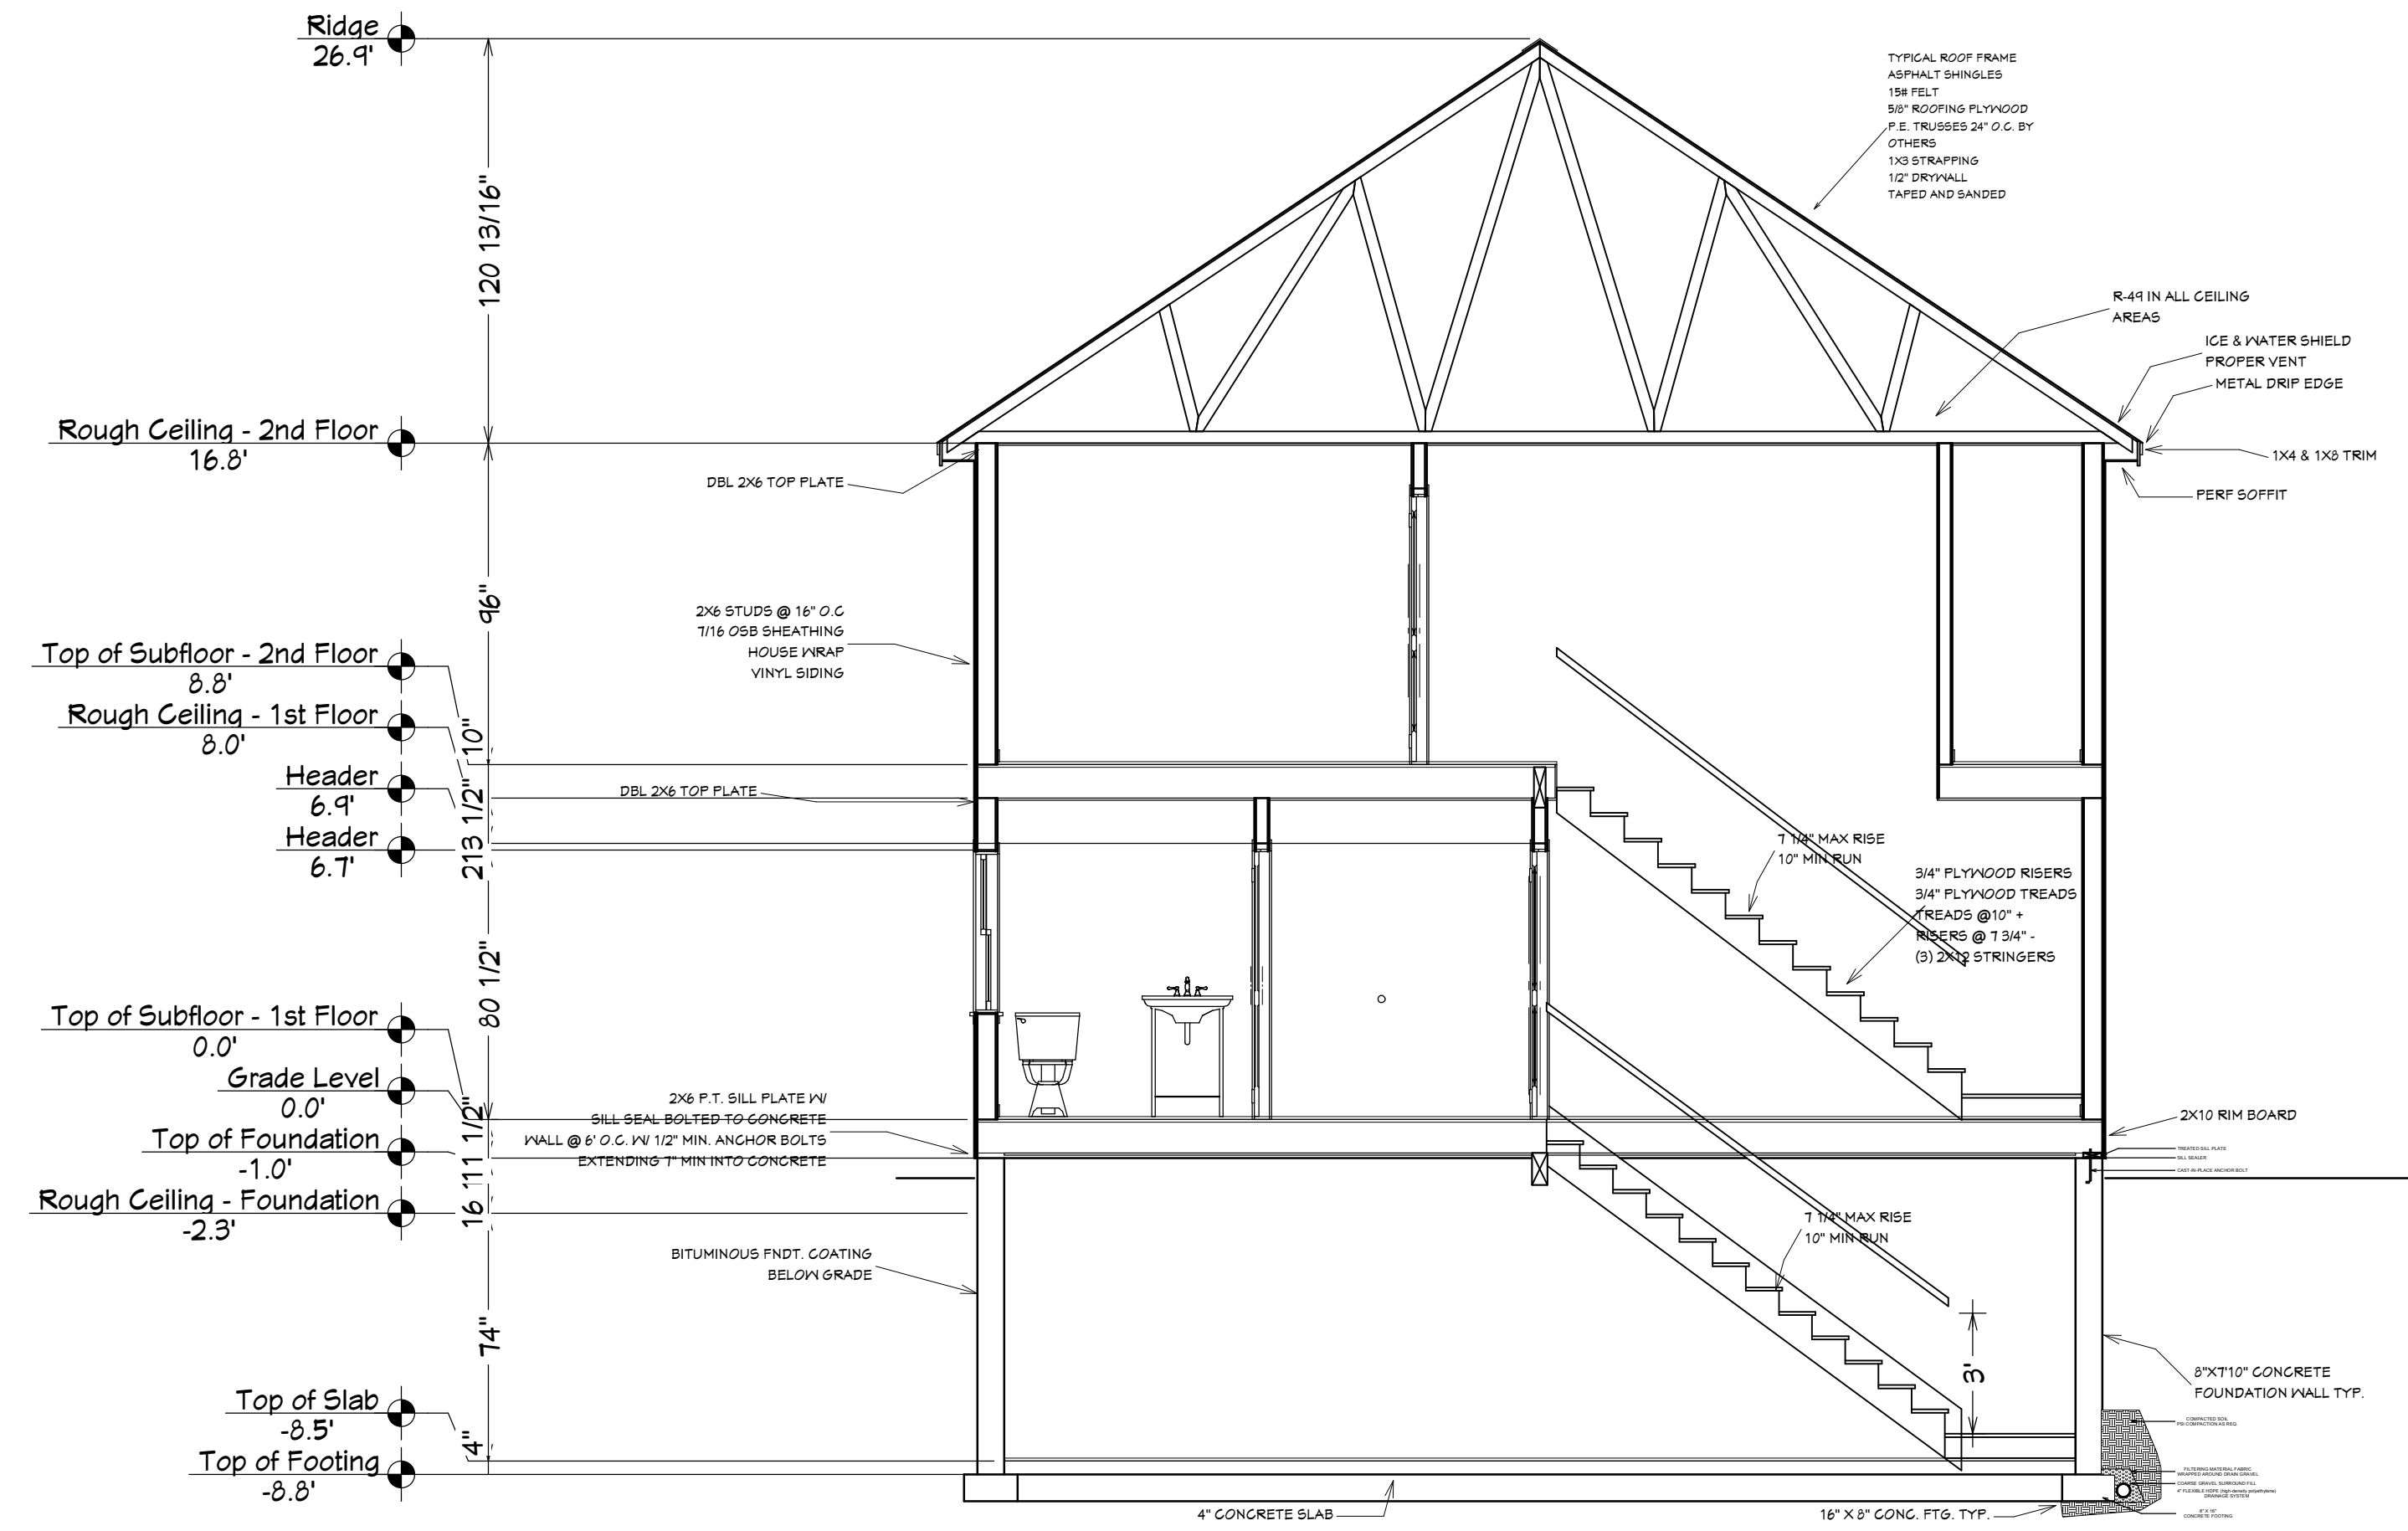

Cross Section 1

Rough openings to be determined by builder.
Placement of openings to be determined by builder.


NOTE:
SMOKE ALARMS/CO DETECTORS SHALL BE INSTALLED IN THE FOLLOWING LOCATIONS:
1: EACH SLEEPING AREA
2: OUTSIDE EACH SEPARATE SLEEPING AREA IN THE IMMEDIATE VICINITY OF THE BEDROOMS
3: ALL SMOKE ALARMS SHALL BE INTERCONNECTED

REVISION TABLE	REVISION BY	DESCRIPTION
NUMBER	DATE	


HIGGINS LOT 3

DRAWINGS PROVIDED BY:

DATE:
3/9/2018
SCALE:
AS NOTED
SHEET:
P-3

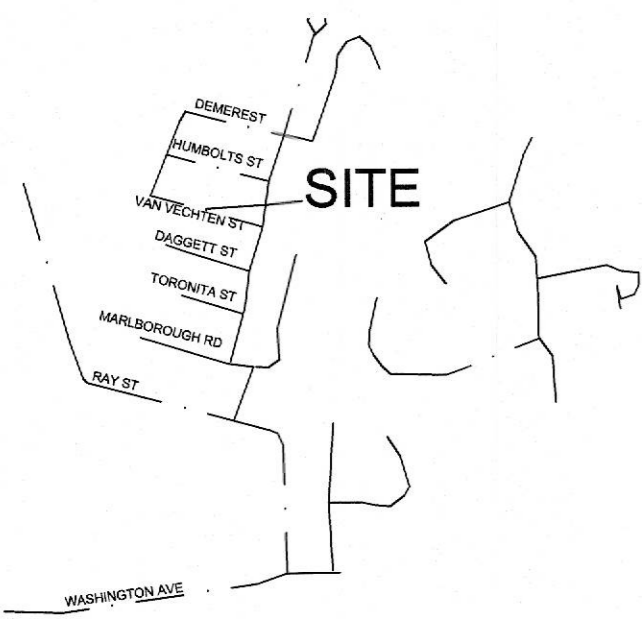

SITE MAP NOT TO SCALE

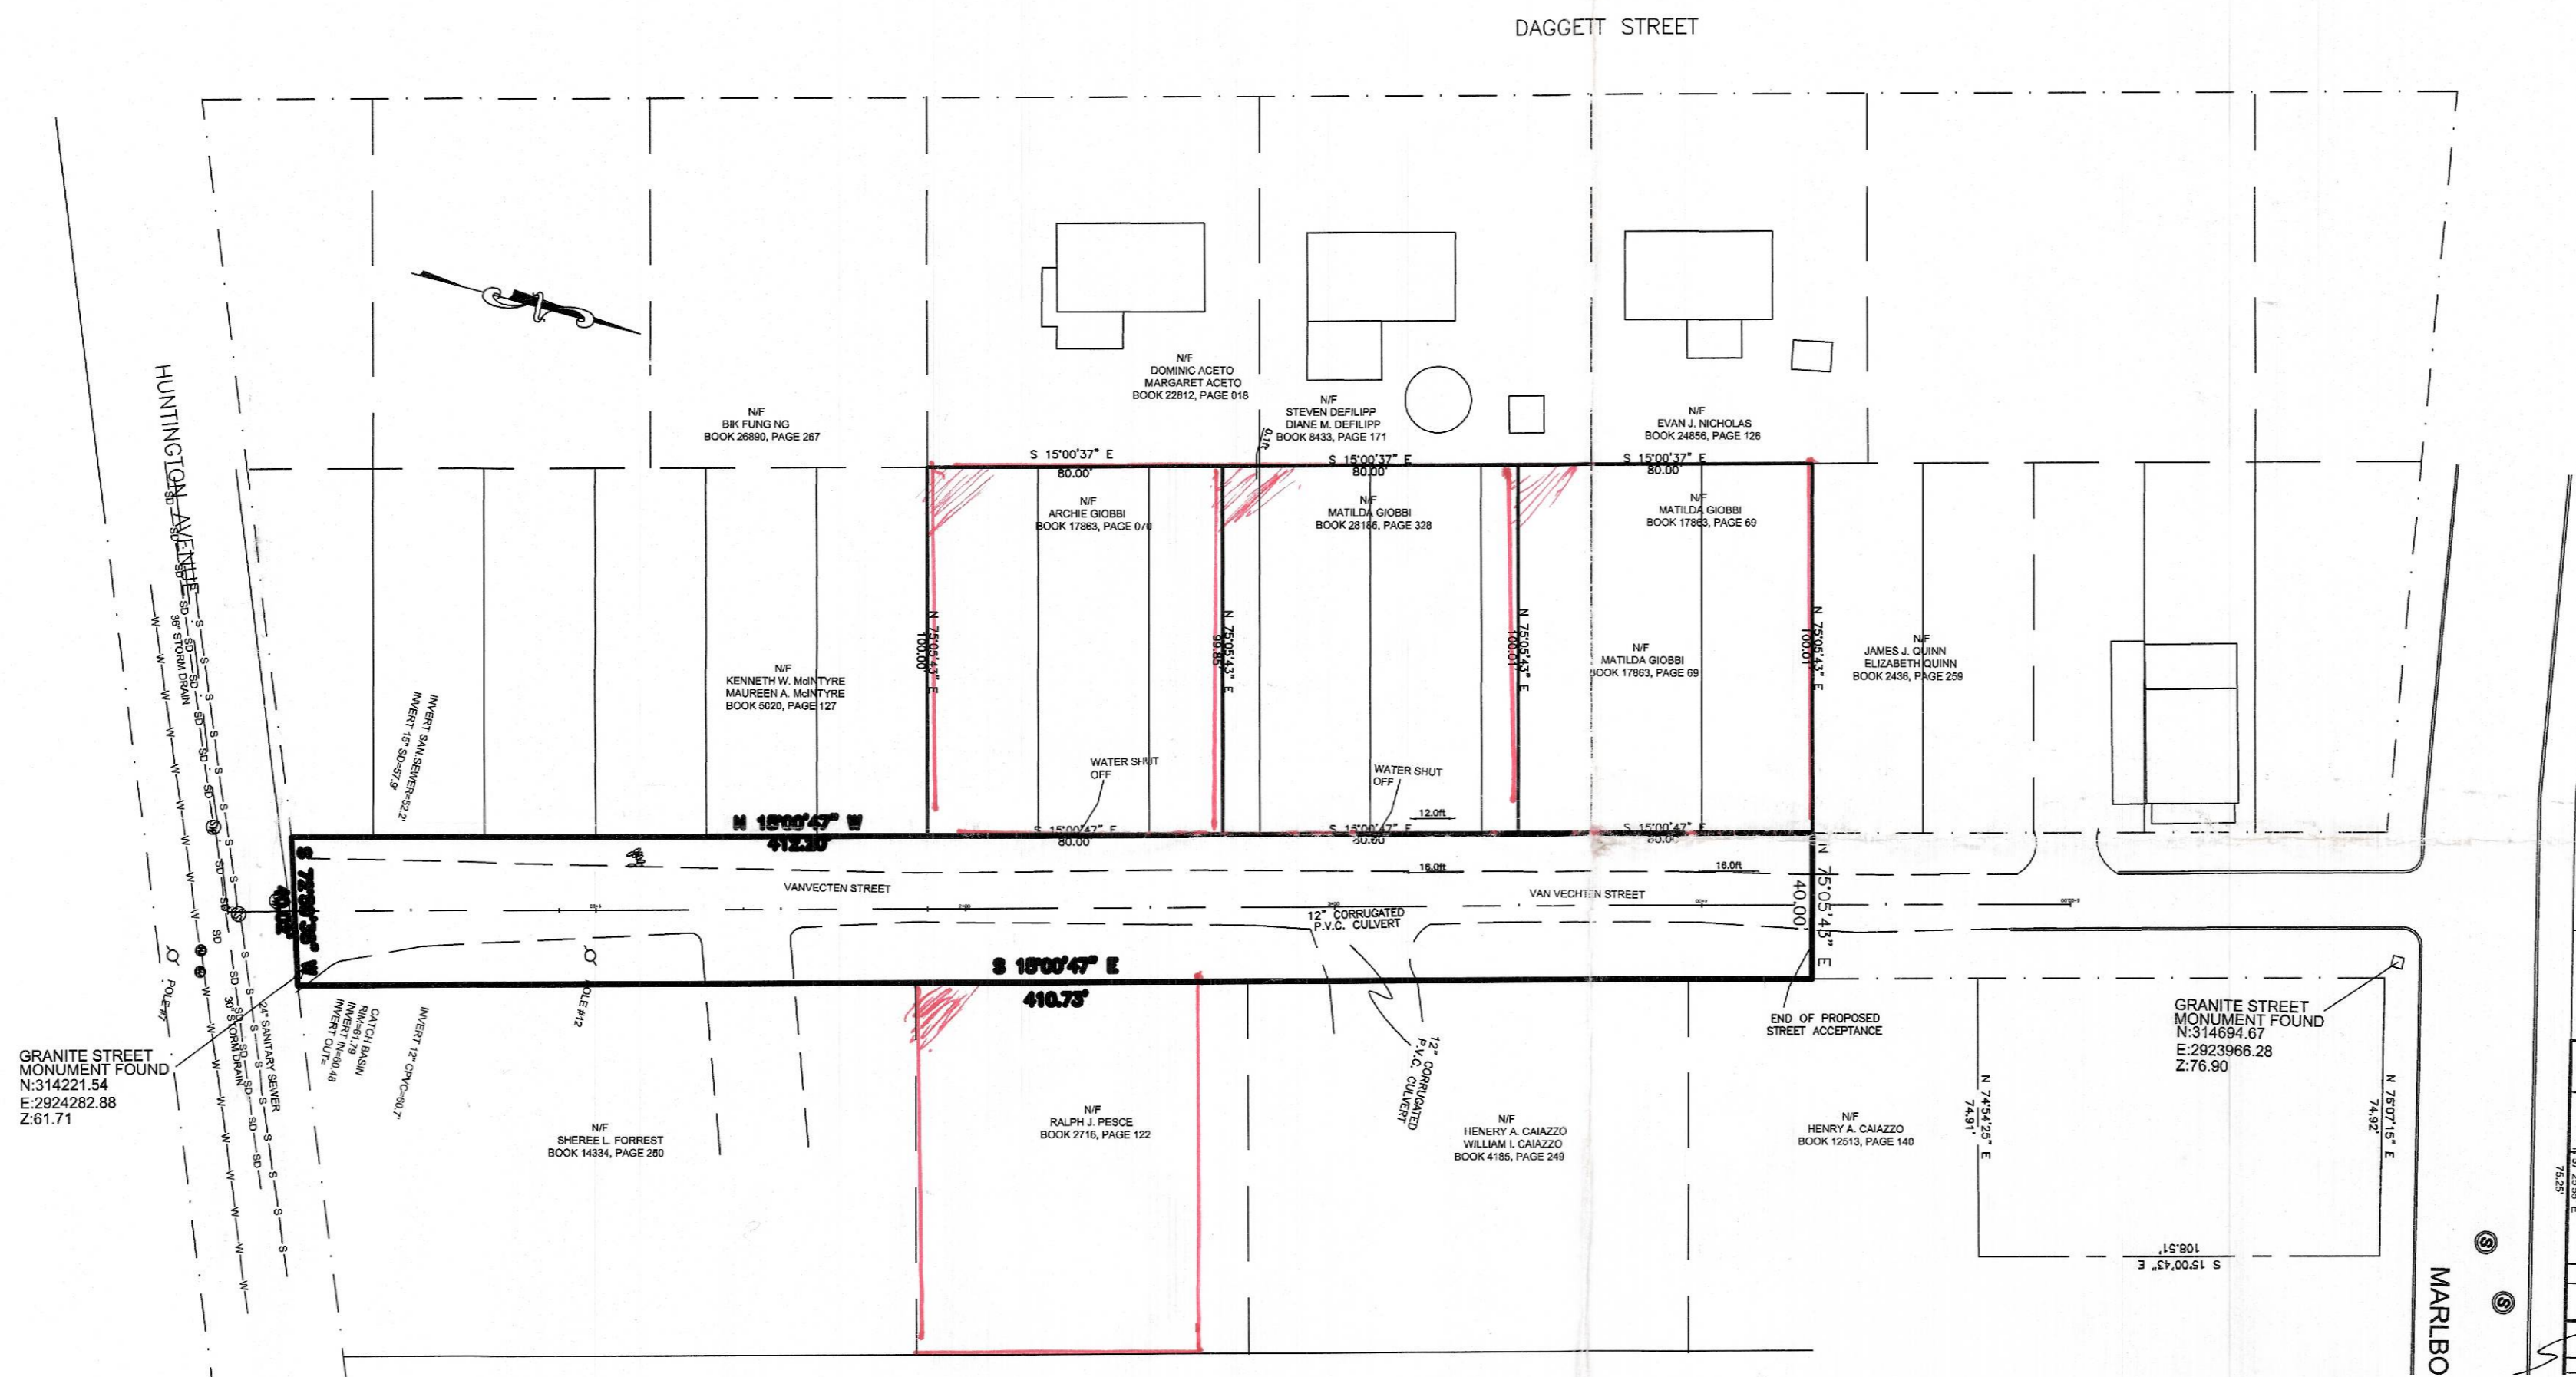

GENERAL NOTES:

1. RECORD OWNER OF PARCEL: RAY GARDEN DEVELOPERS AS NOTED IN THE PLAN REFERENCE INTENDED TO TURN THE STREET OVER TO THE CITY OF PORTLAND. THE SUBDIVISION CIRCA 1914 SHOWS THE STREET AND LOTS.
2. BEARINGS ARE BASED UPON A MAGNETIC OBSERVATION TAKEN AT THE TIME OF THIS SURVEY, UTILIZING THE FOLLOWING EQUIPMENT:
LIETZ SOKKISHA SET 4 TOTAL STATION, LIETZ SDR 33 DATA COLLECTOR.
SEE NOTE #
3. AREA OF SUBJECT PARCEL: 16458.7 SQ. FT., 0.38 ACRES
4. REFERENCE IS MADE TO THE FOLLOWING PLANS:
a.) RAY GARDENS, RECORDED IN THE CUMBERLAND COUNTY REGISTRY OF DEEDS PLAN BOOK 12 PAGE 103.
- 5.) **ELEVATION OF THE BENCHMARK** ELEVATION ON A COPPER BOLT IN A 3' OFFSET MONUMENT LOCATED ON THE NORTHERLY SIDE OF WASHINGTON AVENUE AT FIRST ANGLE POINT WESTERLY OF RAY STREET. SAID BM ELEVATION WAS REPORTED TO BE 66.387' N.G.V.D. 1929 CITY OF PORTLAND DATUM. A NEW BENCHMARK WAS ESTABLISHED ON THE COPPER BOLT SET IN THE NEW MONUMENT INSTALLED AT THE NORTHWEST CORNER OF MARLBOROUGH ROAD AND HUMBOLT STREET. THE BENCHMARK ELEVATION SET = 68.11 FEET N.G.V.D AND CITY OF PORTLAND DATUM.
6. HORIZONTAL DATUM SHOWN ON THE TWO MONUMENTS IS BASED UPON NORTH AMERICAN DATUM 1983 MAINE STATE WEST ZONE AND DERIVED FROM TWO CONTROL MONUMENTS WHOSE HORIZONTAL COORDINATES WERE REPORTED TO BACK BAY BOUNDARY, INC. BY THE CITY OF PORTLAND ENGINEERING DEPARTMENT. SAID CONTROL MONUMENTS WERE A P.K. NAIL FOUND NEAR THE CENTERLINE OF HUNTINGTON AVENUE IN FRONT OF #74 HUNTINGTON AVENUE. CITY OF PORTLAND IDENTITY NUMBER T124-67-1563, SAID P.K. NAIL HAVING COORDINATES OF: NORTH=314336.09, EAST = 2924441.85. THE SECOND CONTROL MONUMENT UTILIZED WAS A COPPER BOLT SET IN GRANITE MONUMENT FOUND IN A DRIP BOX AT OR NEAR THE INTERSECTION FORMED BY THE 3 FOOT OFFSET LINES OF THE NORTHERLY SIDE OF HUNTINGTON AVENUE AND THE EASTERLY SIDE LINE OF TORONITA STREET, SAID BOLT IDENTIFIED AS T124-73-1606 AND HAVING COORDINATES OF: NORTH= 3313906.07, EAST = 2923916.05. NEW SURVEY CONTROL MONUMENTS WERE SET AND LABELED HEREON WITH NORTH, EAST AND Z(ELEVATION) COORDINATES.
7. VAN VECHTEN STREET IS CURRENTLY AN UNACCEPTED GRAVEL STREET 40 FEET IN WIDTH.

ZONING:

- R-3 RESIDENTIAL ZONE
- a) FRONT SETBACKS: PRINCIPAL OR ACCESSORY STRUCTURES: TWENTY-FIVE (25) FEET.
 - b) REAR SETBACKS: PRINCIPAL OR ACCESSORY STRUCTURES: TWENTY-FIVE (25) FEET.
 - c) SIDE SETBACKS: PRINCIPAL OR ACCESSORY STRUCTURES: FOURTEEN (14) FEET, FOR TWO STORY BUILDINGS.

FLOOD NOTE:

BY GRAPHIC PLOTTING ONLY, THIS PARCEL APPEARS TO BE IN ZONE X, (AREA DETERMINED TO BE OUTSIDE THE 500 YEAR FLOOD-PLAIN), OF THE FLOOD INSURANCE RATE MAP, COMMUNITY #230051, PANEL 7C WHICH BEARS AN EFFECTIVE DATE OF DECEMBER 8, 1998. AND IS NOT IN A SPECIAL FLOOD HAZARD AREA.

LEGEND:

- Capped 5/8" Rebar To Be Set With Registration Number 2303. (50.00') Distance from reference Plan or deed.
- Iron Pipe or Solid Pin Found N/F Now Or Formerly
- ◁ Survey Instrument Point A.G. Above Grade B.G. Below Grade
- Abutter Line P Property Line
- Property Line — u — Overhead Utility
- - - Street Line U Utility Pole
- Direction of Bearing — Edge of traveled way

**BOUNDARY PLAN OF STREET
AT VAN VETCHEN ROAD PORTLAND, MAINE**

FOR: **ARCHIE GIOBBI**

PREPARED BY:
**OCEAN PARK LAND SURVEYING LLC
LAND SURVEYING**

134 PORTLAND AVE
OLD ORCHARD BEACH, MAINE
207-749-9471 - BOBGREENLAW@MYFAIRPOINT.NET

DRAWN BY:	RTG
CHECKED BY:	RJS
SCALE:	1" = 40'
DATE:	04-01-2003
JOB NUMBER:	200283
SHEET:	1 OF 1
DRAWER:	2002 NO: 83

CERTIFICATE:

I HEREBY CERTIFY THAT THIS SURVEY CONFORMS TO THE MAINE BOARD OF LICENSURE FOR PROFESSIONAL LAND SURVEYORS' STANDARDS OF PRACTICE AS ADOPTED APRIL 01, 2001 WITH THE FOLLOWING EXCEPTIONS:
a) NO WRITTEN REPORT
b) NO NEW DESCRIPTION
c) NO PROPERTY CORNERS SET AT THIS TIME.

ROBERT T. GREENLAW P.L.S.
PRESIDENT BACK BAY BOUNDARY, INC. DATE: 05-06-2011

REVISIONS:

REVISION 3: MAY 9, 2011, ROTATED VIEW AND ADDED ABUTTERS.

LOCATION: VAN VECHTEN STEET PORTLAND MAINE

STATE OF MAINE, CUMBERLAND SS
REGISTRY OF DEEDS

RECEIVED 2011
AT : H .M. AND RECORDED IN
PLAN BOOK PAGE

