


WALL TYPES:

GRAPHIC DEPICTION		DESCRIPTION			GRAPHIC DEPICTION		DESCRIPTION			GRAPHIC DEPICTION		DESCRIPTION		
		DEMISING WALL 1 HOUR FIRE RATED WITH DEFLECTION HEAD SLIP TRACK - 5/8" TYPE "X" GWB - 6" MTL STUDS AT 16" O.C. (18 GAUGE) - 6" ROXUL MINERAL BATT INSULATION - RESILIENT CHANNEL - 5/8" TYPE "X" GWB					- 3/8" GWB - 3/8" MTL STUDS AT 16" O.C. - 3/8" ROXUL MINERAL BATT INSULATION - 3/8" GWB					- 5/8" GWB - 3/8" MTL STUDS AT 16" O.C. - 3/8" ROXUL MINERAL BATT INSULATION - 1/2" SOUNDBOARD - 5/8" GWB		
TYPE	FIRE RATING	UL NUMBER	STC RATING	IIC RATING	TYPE	FIRE RATING	UL NUMBER	STC RATING	IIC RATING	TYPE	FIRE RATING	UL NUMBER	STC RATING	IIC RATING
1A	1 HR	U465	N/A	N/A	NA	N/A	N/A	N/A	N/A	NB	N/A	N/A	N/A	N/A

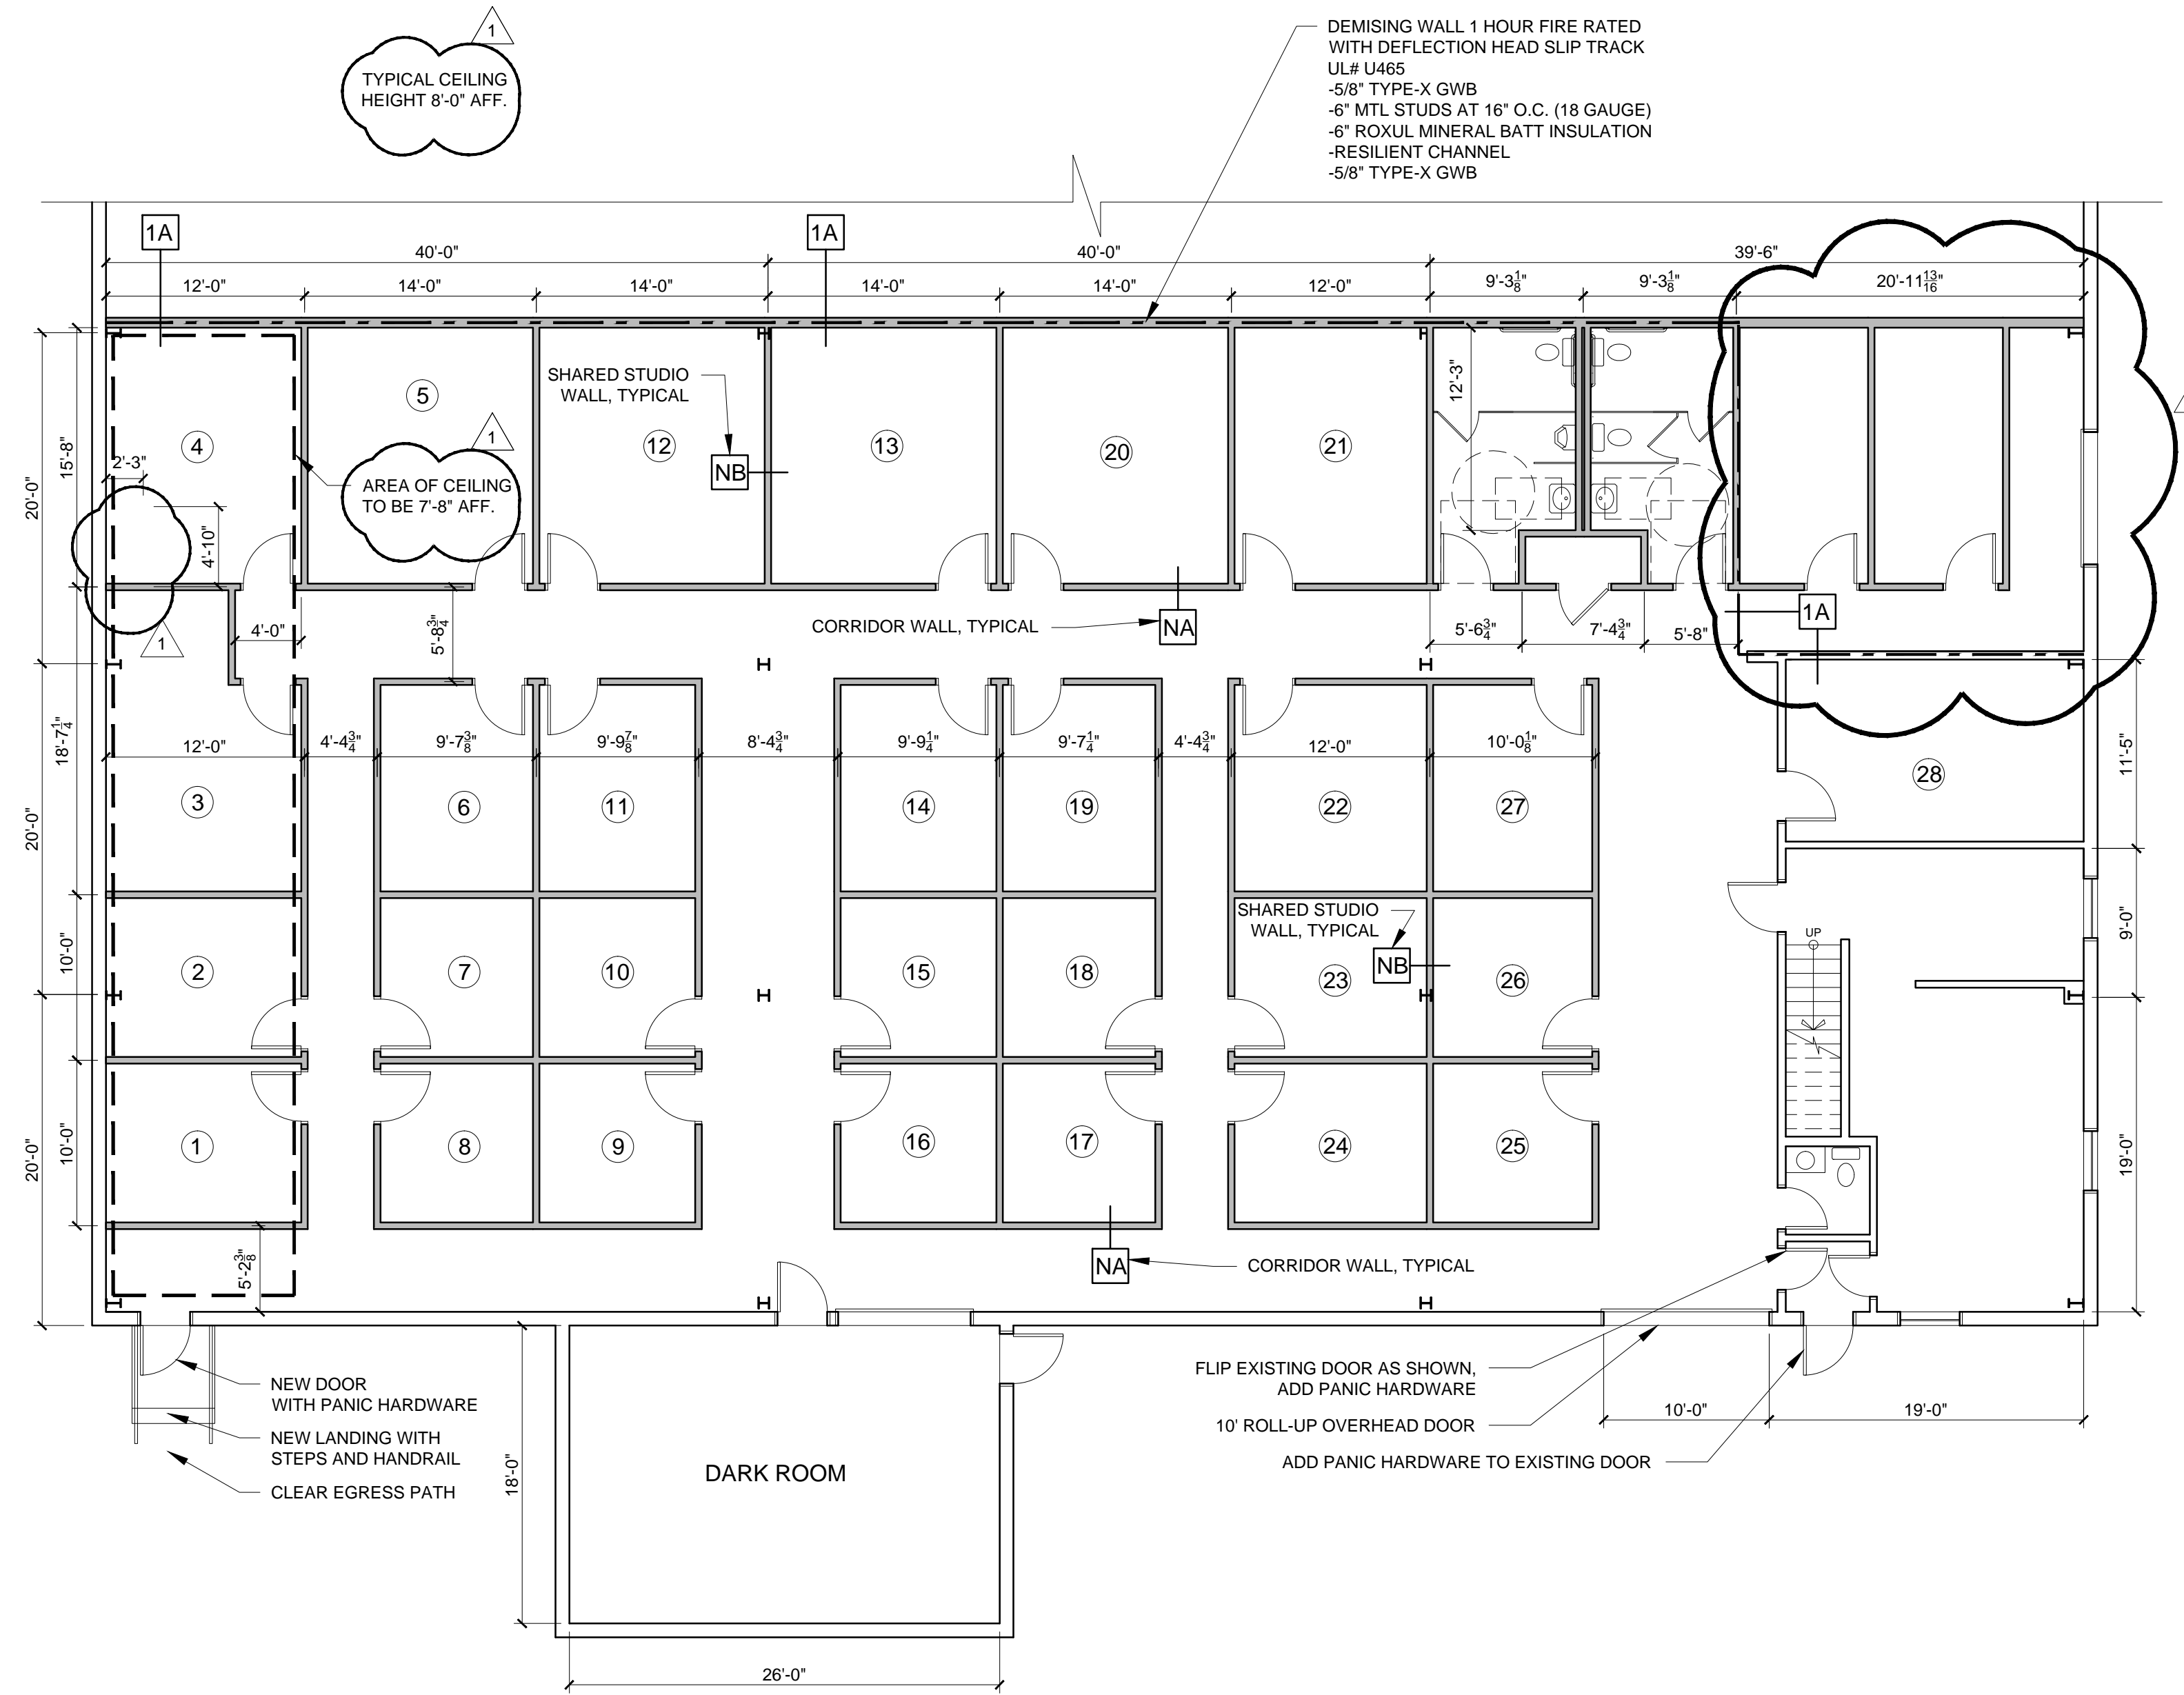

1 FIRST FLOOR PLAN
1/8" = 1'-0"

1 EXISTING SECOND FLOOR PLAN
1/8" = 1'-0"

GRIME STUDIOS
PORTLAND, MAINE



RYAN SENATORE
ARCHITECTURE
565 CONGRESS STREET, SUITE 304
PORTLAND, MAINE 04101
207-650-6414
senatorearchitecture.com

CONSULTANTS:

REVISIONS:
1 REVISION #1 - 11/14/14

DATE: SEPTEMBER 18, 2014

PROJECT No. 1428

DRAWN BY: RJS / RRT

CHECKED BY: RJS

SCALE: AS NOTED

SHEET TITLE:
FIRST FLOOR
PLAN

A1-1