

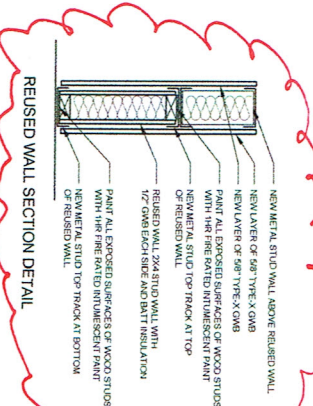


WALL TYPES:

TYPE	GRAPHIC DEPICTION	DESCRIPTION
1A		DEMISING WALL 1 HOUR FIRE RATED WITH DEFLECTION HEAD SLIP TRACK - 1/2" TYPE 'X' GWB - 1" O.C. (18 GAUGE) - 6" ROXUL MINERAL BATT INSULATION - RESILIENT CHANNEL - 1/2" TYPE 'X' GWB
NA		1/2" GWB STUDS AT 16" O.C. - 3/8" ROXUL MINERAL BATT INSULATION - 1/2" TYPE 'X' GWB
NB		3/8" MTL STUDS AT 16" O.C. - 1/2" SOUNDBOARD - 1/2" TYPE 'X' GWB
NC		NEW LAYER OF 1/2" TYPE 'X' GWB - EXISTING 1/2" GWB - EXISTING 2X4 WOOD STUDS - NEW TOP AND BOTTOM MTL STUD TRACK - NEW TOP AND BOTTOM MTL STUD TRACK - ALL EXPOSED SURFACES OF WOOD WITH INTERLOCKING PAINT WITH 1 HR FIRE RATING - EXISTING 3/8" BATT INSULATION - NEW LAYER OF 1/2" TYPE 'X' GWB - NEW LAYER OF 3/8" TYPE 'X' GWB

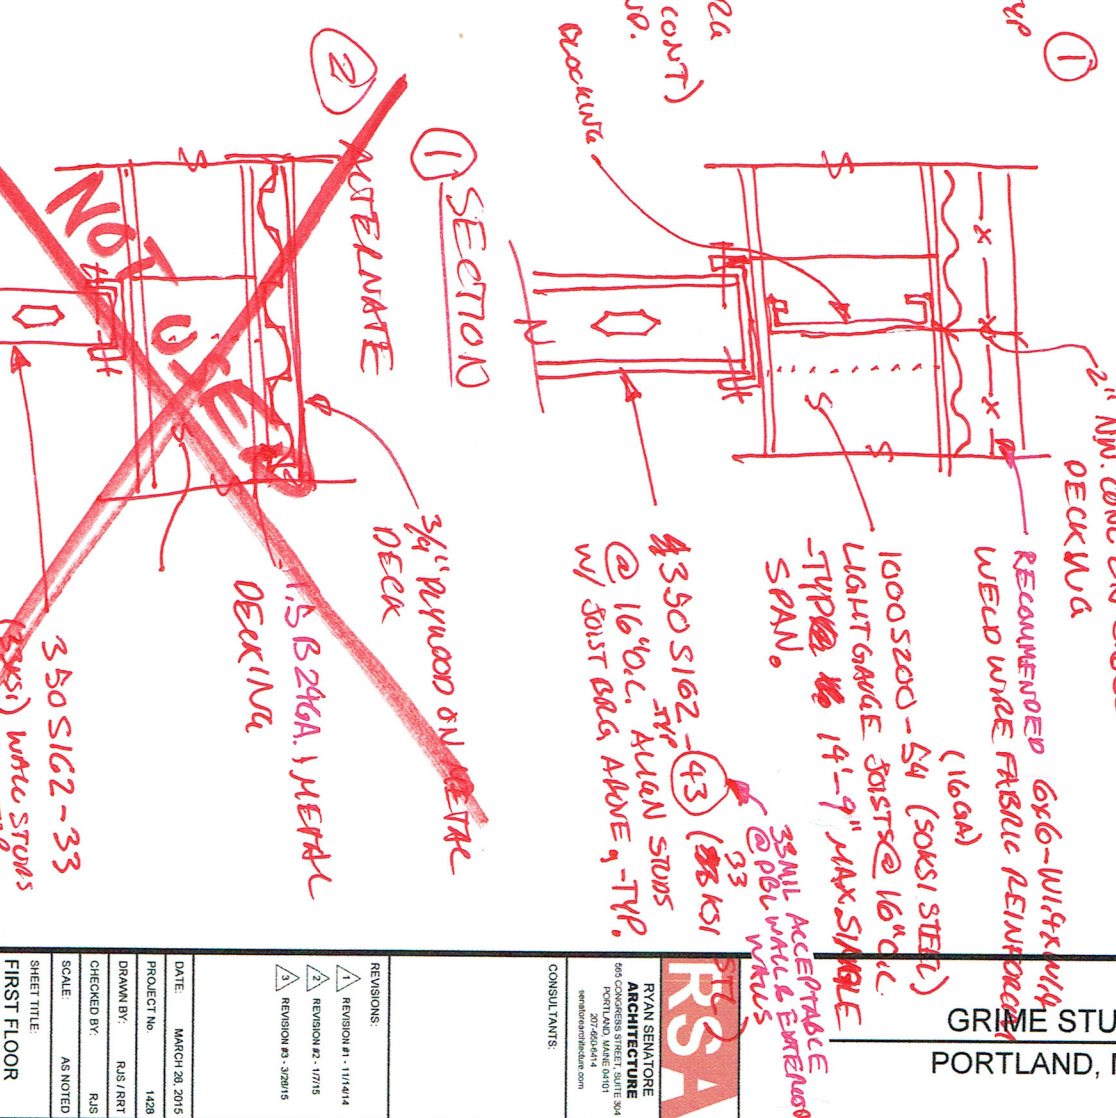

DO NOT BEAR ON THIS WALL - ALL COLUMNS USE ALL PLATE CANT FROM PLATE. PROVIDE DBL FULL HEIGHTS FOR RAY SENIGORE @ (E) PANEL ENDS

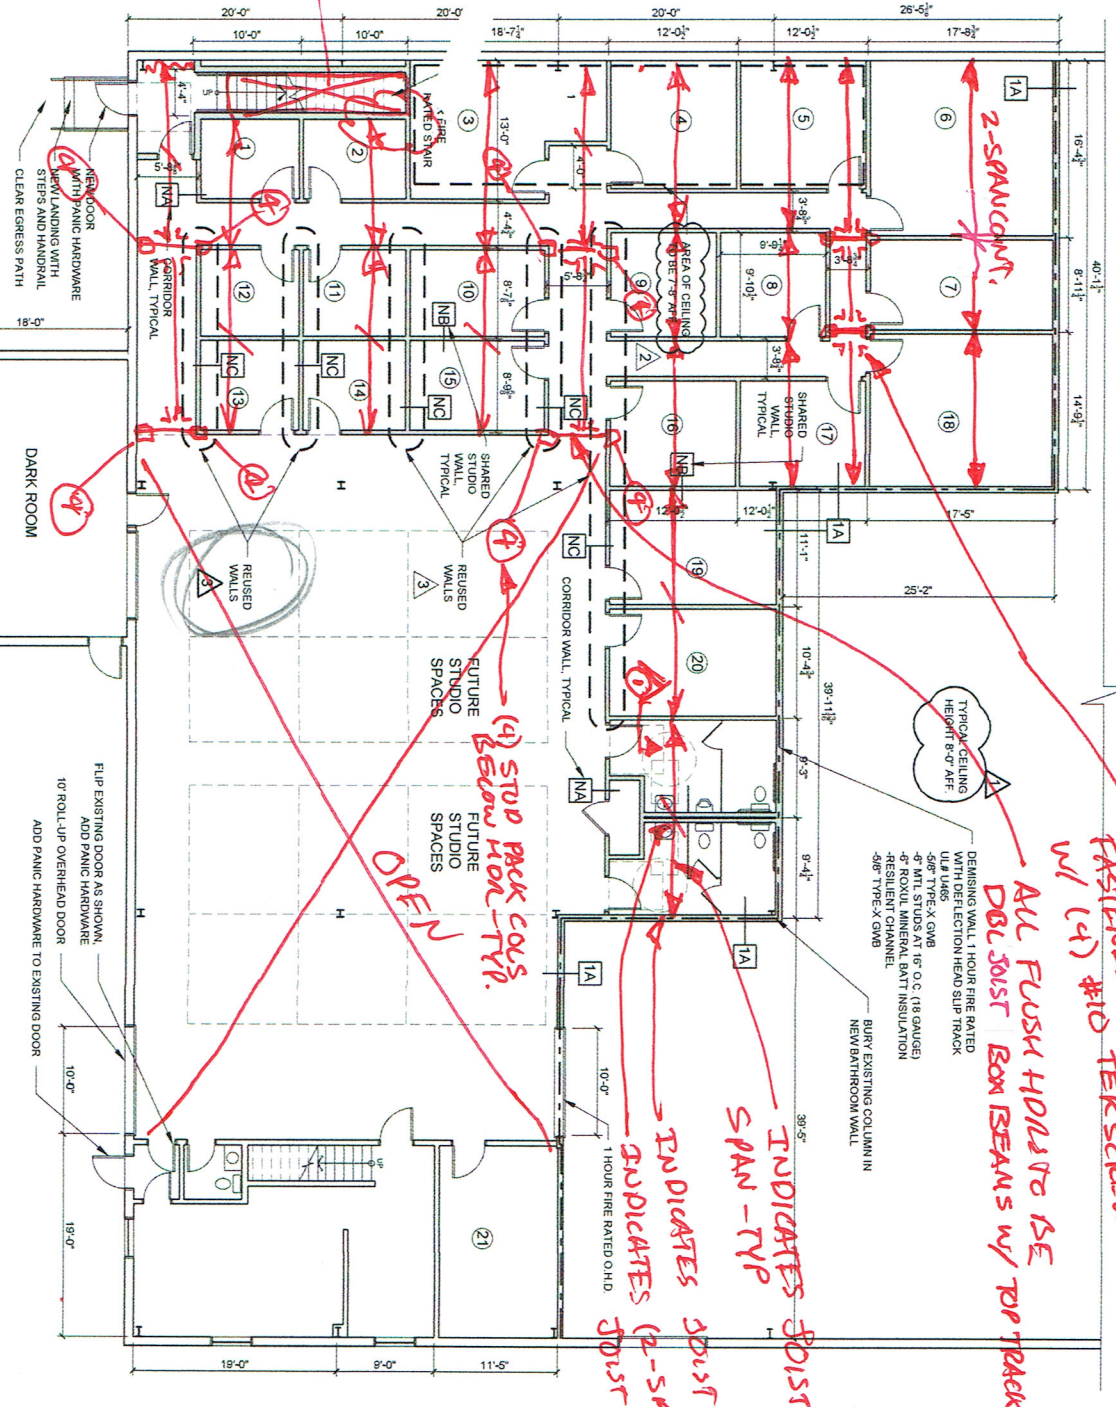

2ND FLR FLOORING PLAN NTS

SECTION

MKL S1 4/1/15
REDLINE 15-0062

A1-1
FIRST FLOOR PLAN

GRIME STUDIOS
PORTLAND, MAINE

RSA
RYAN SENIGORE
ARCHITECTURE
300 PORTLAND, MAINE 04101
207.604.6414
www.rsaarchitecture.com

CONSULTANTS:

REVISIONS:

REVISION 01 - 11/4/14
REVISION 02 - 1/7/15
REVISION 03 - 3/28/15

DATE: MARCH 28, 2015
PROJECT No: 1428
DRAWN BY: RJS /RSI
CHECKED BY: RJS
SCALE: AS NOTED

SHEET TITLE:
FIRST FLOOR PLAN