


# FLOOR PLAN

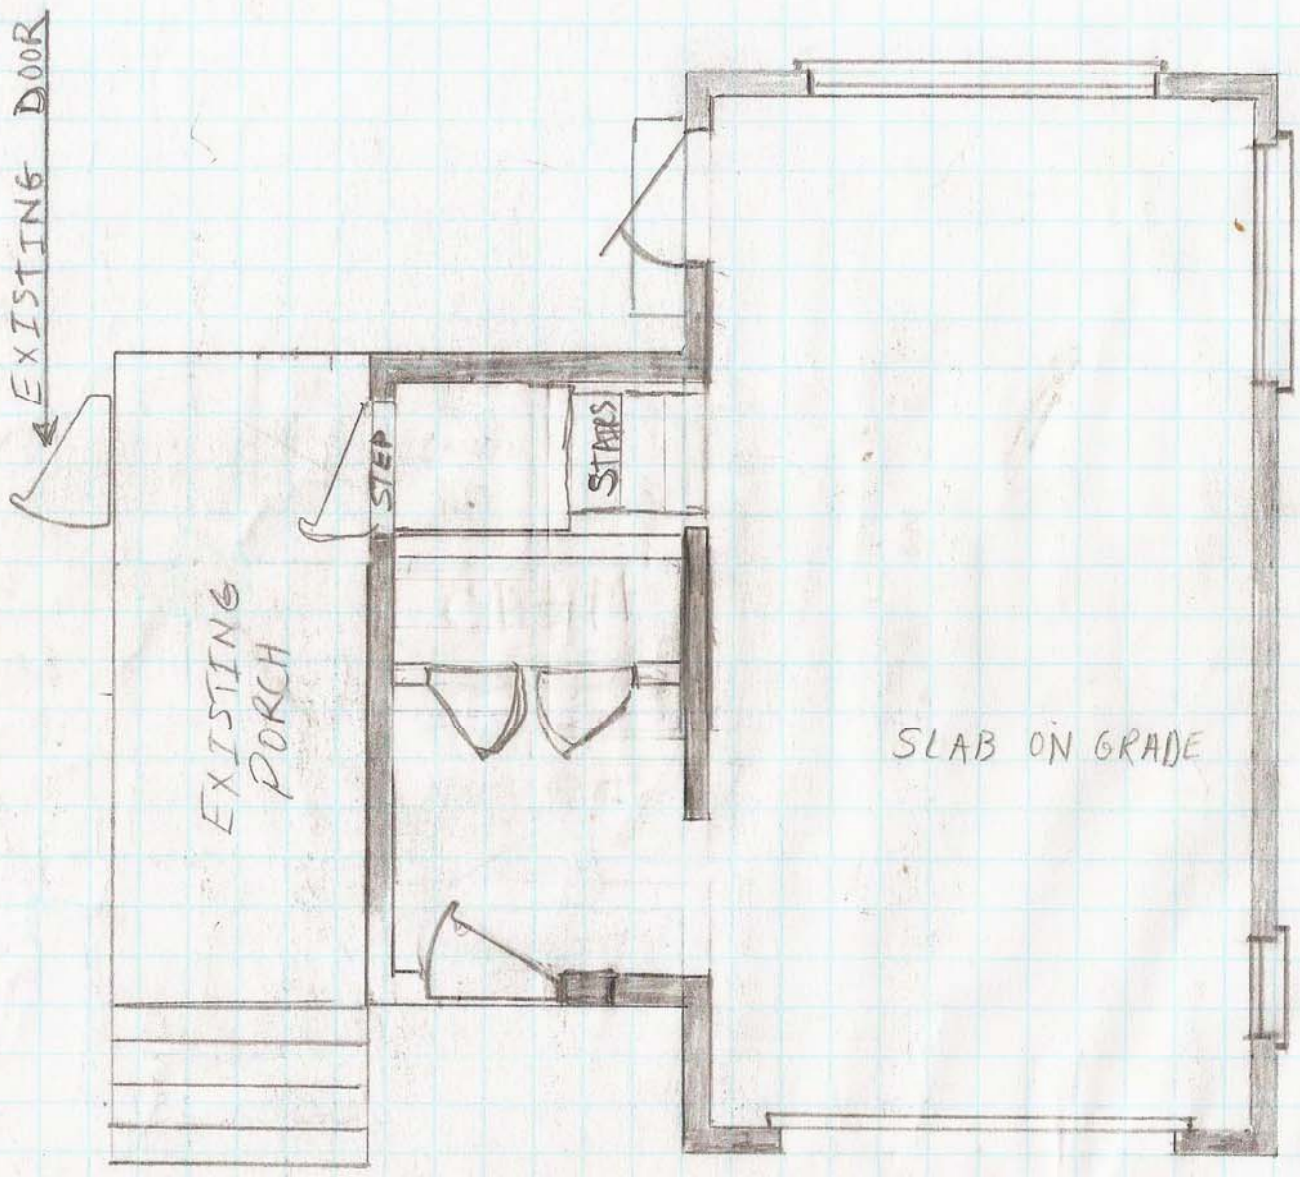

$\frac{1}{4}'' = 1'$