


840201

FILL IN AND SIGN WITH INK



APPLICATION FOR PERMIT FOR
HEATING, COOKING OR POWER EQUIPMENT

Portland, Maine, March 25, 1994

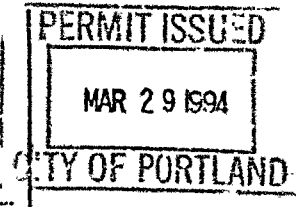

To the INSPECTOR OF BUILDINGS, PORTLAND, ME.

The undersigned hereby applies for a permit to install the following heating, cooking or power equipment in accordance with the Laws of Maine, the Building Code of the City of Portland, and the following specifications:

Location 1133 Washington Ave. Use of Building Nursing Home No. Stories 1 New Building Existing "X"

Name and address of owner of appliance St. Joseph's Manor

XXX Installer's name and address Scribner & Iverson, Inc. Telephone 797-9441

P.O. Box 1779 Portland, ME 04104

General Description of Work

To install new boiler

IF HEATER, OR TOWER BOILER

Location of appliance boiler room Any burnable material in floor surface or beneath? no

If so, how protected? Kind of fuel? propagas/oil

Minimum distance to burnable material, from top of appliance or casing top of furnace 5 feet

From top of smoke pipe ALL CONCRETE From front of appliance ALL CONCRETE From sides or back of appliance

Size of chimney flue 14 INCH Other connections to same flue no

If gas fired, how vented? roof Rated maximum demand per hour 2.8 mbh

Will sufficient fresh be supplied to the appliance to insure proper and safe combustion? yes

IF OIL BURNER

Name and type of burner Webster Labelled by underwriters' laboratories? yes

Will operator be always in attendance? no Does oil supply line feed from top or bottom of tank? top

Type of floor beneath burner concrete Size of vent pipe 14 inch

Location of oil storage above ground outside Number and capacity of tanks 1 10,000 gallons

Low water shut-off? yes Make MM No

Will all tanks be more than five feet from any flame? yes How many tanks enclosed? none

Total capacity of any existing storage tanks for furnace burners none

IF COOKING APPLIANCE

Location of appliance Any burnable material in floor surface or beneath?

If so, how protected? Height of Legs, if any

Skirting at bottom of appliance? Distance to combustible material from top of appliance?

From front of appliance From sides and back From top of smoke pipe

Size of chimney flue Other connections to same flue

Is hood to be provided? If so, how vented? Forced or gravity?

If gas fired, how vented? Rated maximum demand per hour

MISCELLANEOUS EQUIPMENT OR SPECIAL INFORMATION

License # 5512

Cost of work \$12,500

Amount of fee enclosed? \$85.00

APPROVED:

10-13-94

Will there be in charge of the above work a person competent to see that the State and City requirements pertaining thereto are observed? yes

CS 300

Signature of Installer

INSPECTION FILE APPLICANT'S ASSESSOR'S COPY

DAVID Jordan

NOTES

Tanks Installed outside
above ground and Covered by
a '54 Roof
dbl lined Tank on cradle

Permit No. 940201

Location 1133 Washington

Owner SJ Joseph P. Hume

Date of permit 4-24-94

Approved 12-13-94

940274
Permit # _____ City of Portland BUILDING PERMIT APPLICATION Fee 50.00 Zone _____ Map # _____ PERMIT ISSUED

Owner: St Joseph's Manor Phone # 797-0600 ext 171
Address: 1133 Washington Ave Pctd, ME 04103
LOCATION OF CONSTRUCTION 1133 Washington Ave
Contractor: MTR. Brewer Sub: _____
Address: _____ Phone # _____
Est. Construction Cost: 5,950.00 Proposed Use: Nursing Home w/reno
Past Use: Nursing Home
of Existing Res. Units _____ # of New Res. Units _____
Building Dimensions L _____ W _____ Total Sq. Ft. _____
Stories: _____ # Bedrooms _____ Lot Size: _____
Is Proposed Use: Seasonal _____ Condominium _____ Conversion _____
Explain Conversion Board up corridor by installing 4 fire doors \$ per

For Official Use Only
Date 11 Apr 94 Subdivision: _____
Inside Fire Limits _____ Name: _____
Bldg Code _____ Lot _____ CITY OF PORTLAND
Time Limit _____ Ownership: _____ Private _____
Estimated Cost _____
Zoning: Street Frontage Provided: _____
Provided Setbacks: Front _____ Back _____ Side _____
Review Required: Zoning Board Approval: Yes _____ No _____ Date: _____
Planning Board Approval: Yes _____ No _____ Date: _____
Conditional Use: _____ Variance _____ Site Plan _____ Subdivision _____
Shoreland Zoning Yes _____ No _____ Floodplain Yes _____ No _____
Special Exception _____
Other (Explain) _____

Foundation: 408-D-005
1. Type of Soil _____
2. Set Backs - Front _____ Rear _____ Side(s) _____
3. Footings Size: _____
4. Foundation Size: _____
5. Other _____
Floor: _____
1. Sills Size: _____ Sills must be anchored.
2. Girder Size: _____
3. Lally Column Spacing: _____ Size: _____
4. Joists Size: _____ Spacing 16" O.C.
5. Bridging Type: _____ Size: _____
6. Floor Sheathing Type: _____ Size: _____
7. Other Material: _____
Exterior Walls: _____
1. Studding Size _____ Spacing _____
2. No. windows _____
3. No. Doors _____
4. Header Sizes _____ Span(s) _____
5. Bracing: Yes _____ No _____
6. Corner Posts Size _____
7. Insulation Type _____ Size _____
8. Sheathing Type _____ Size _____
9. Siding Type _____ Weather Exposure _____
10. Masonry Materials _____
11. Metal Materials _____
Interior Walls: _____
1. Studding Size _____ Spacing _____
2. Header Sizes _____ Span(s) _____
3. Wall Covering Type _____
4. Fire Wall if required _____
5. Other Material: _____

Ceiling: _____
1. Ceiling Joists Size: _____
2. Ceiling Strapping Size _____ Spacing _____
3. Type Ceilings: _____
4. Insulation Type _____ Size _____
5. Ceiling Height: _____
Roof: _____
1. Truss or Rafter Size _____ Span _____
2. Sheathing Type _____ Size _____
3. Roof Covering Type _____
Chimneys: _____
Type: _____ Number of Fire Places _____
Heating: _____
Type of Heat: 17 1114 55 1450
Electrical: _____
Service Entrance Size: _____ Smoke Detector Required Yes _____ No _____
Plumbing: _____
1. Approval of soil test if required Yes _____ No _____
2. No. of Tubs or Showers _____
3. No. of Flushes _____
4. No. of Lavatories I-2 Type 5A
5. No. of Other Fixtures _____
Swimming Pools: _____
1. Type: _____
2. Pool Size: _____ x _____ Square Footage _____
3. Must conform to National Electrical Code and State Law.
Permit Received By Mary Gresik
Signature of Applicant _____ Date 11 Apr 94
CEO's District _____
CONTINUED TO REVERSE SIDE [7] Ma. Jordan
Ivory Tag - CEO

White - Tax Assessor

PLOT PLAN

N



FEES (Breakdown From Front)

Base Fee \$ _____
 Subdivision Fee \$ _____
 Site Plan Review Fee \$ _____
 Other Fees \$ _____
 (Explain) _____
 Late Fee \$ _____

Inspection Record

Type	Date
Heating	5/11/94
Door/Hanging	None
Door/Hanging	12/13/94
CLOSE X	


COMMENTS (5-11-94 no work on corridor) (Furnace system installation started) (Doors 3/4 hrs fire rated) (By S. Holmes)

CERTIFICATION


I hereby certify that I am the owner of record of the named property, or that the proposed work is authorized by the owner of record and that I have been authorized by the owner to make this application as has authorized agent and I agree to conform to all applicable laws of this jurisdiction. In addition, if a permit for work described in this application is issued, I certify that the code official or the code official's authorized representative shall have the authority to enter areas covered by such permit at any reasonable hour to enforce the provisions of the code(s) applicable to such permit.

SIGNATURE OF APPLICANT _____ ADDRESS _____ PHONE NO. _____
 RESPONSIBLE PERSON IN CHARGE OF WORK, TITLE _____ PHONE NO. _____

T. JOSEPH'S MANOR

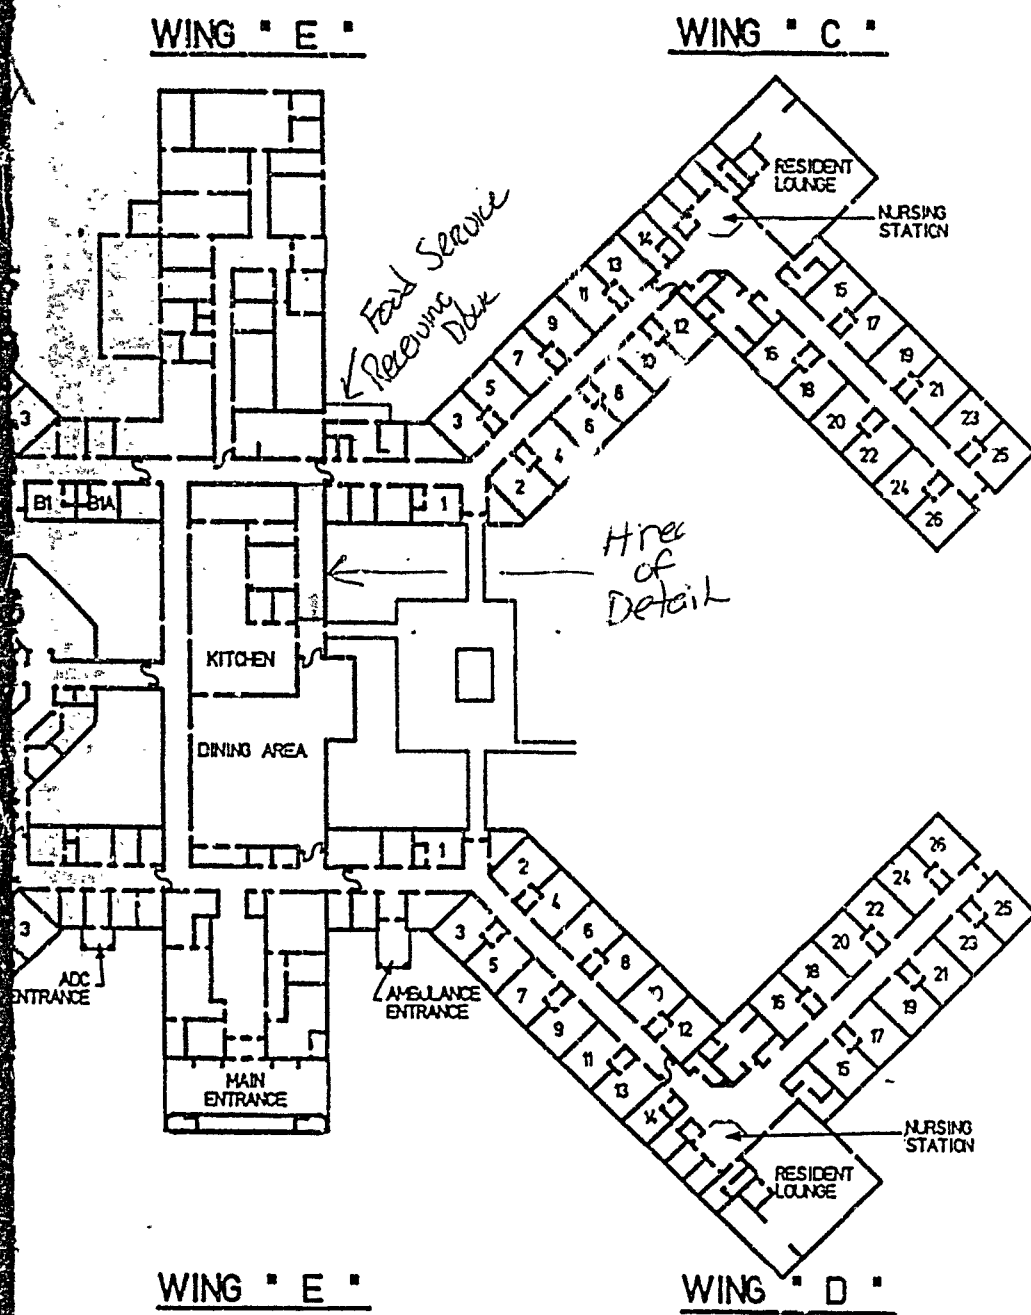


ST. JOSEPH'S MANOR

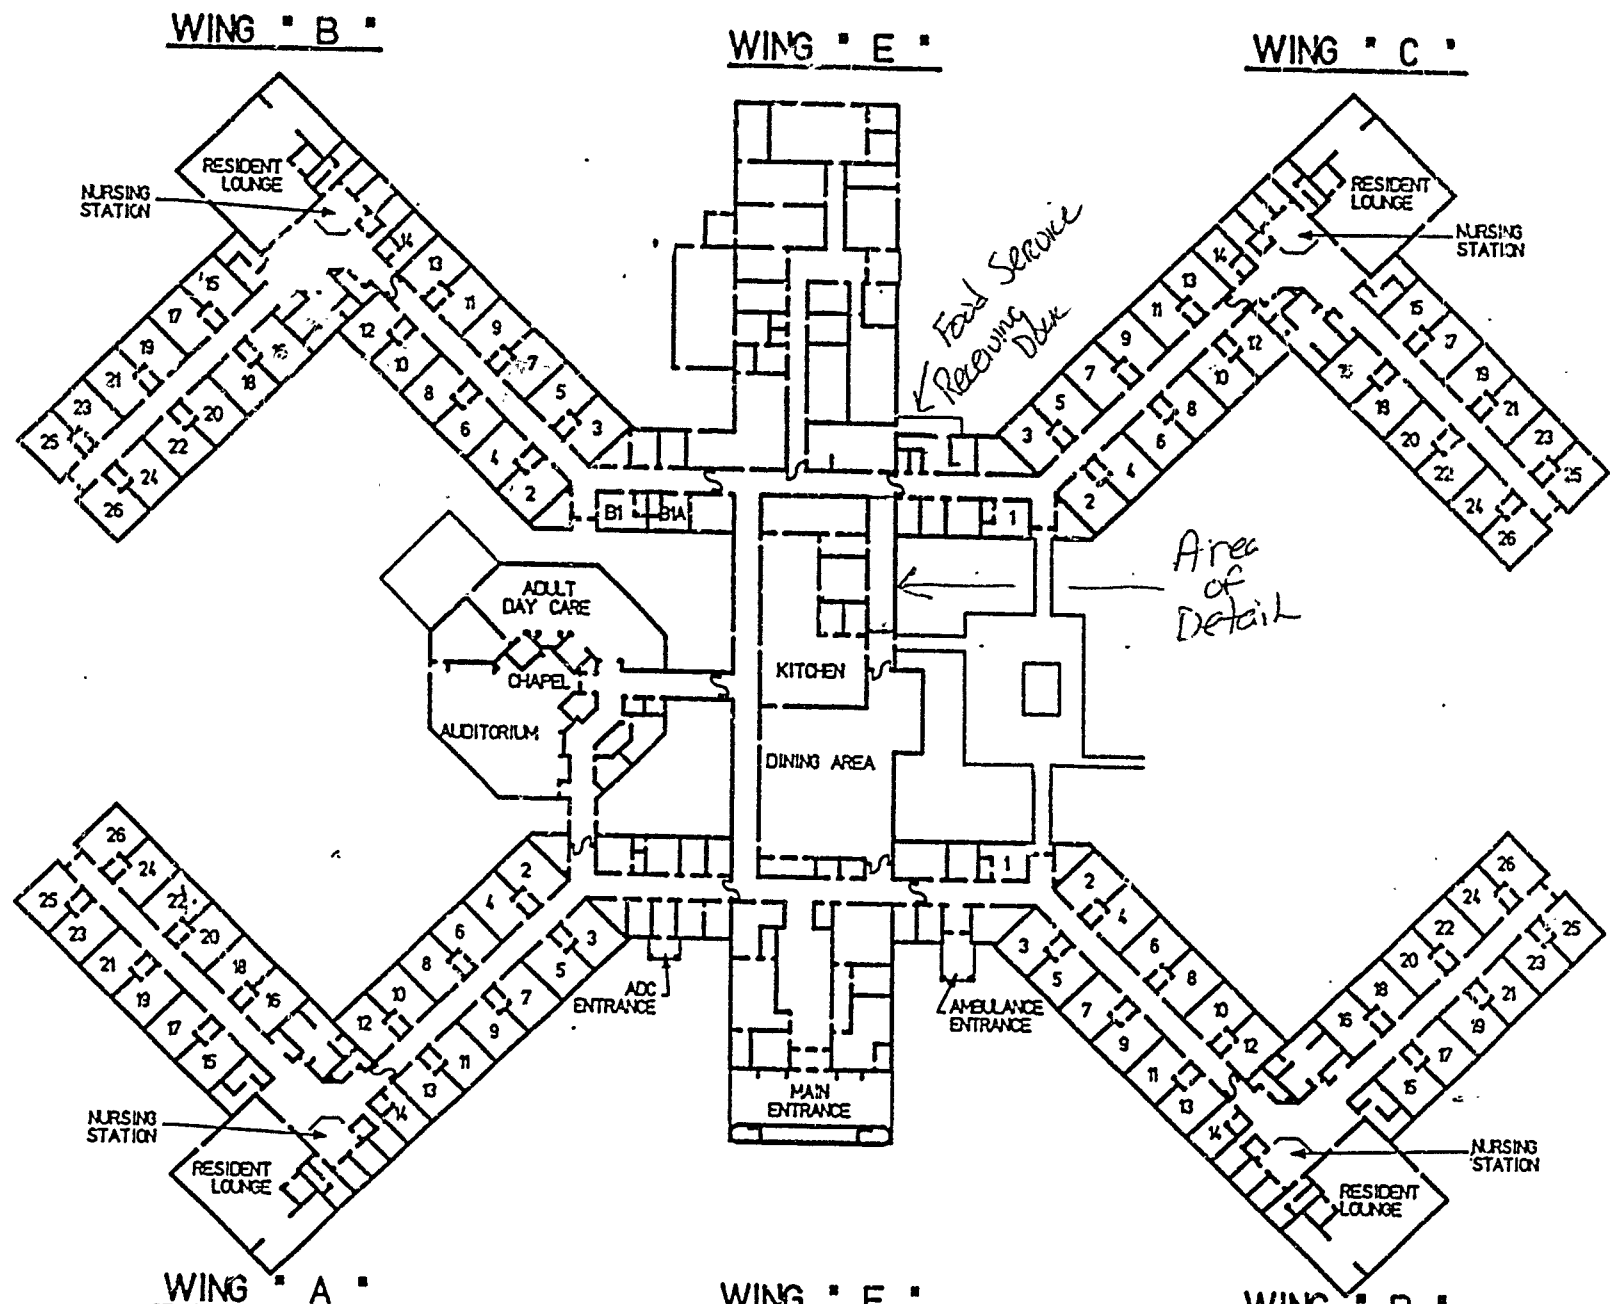


ST. JOSEPH'S MANOR


WING "E"

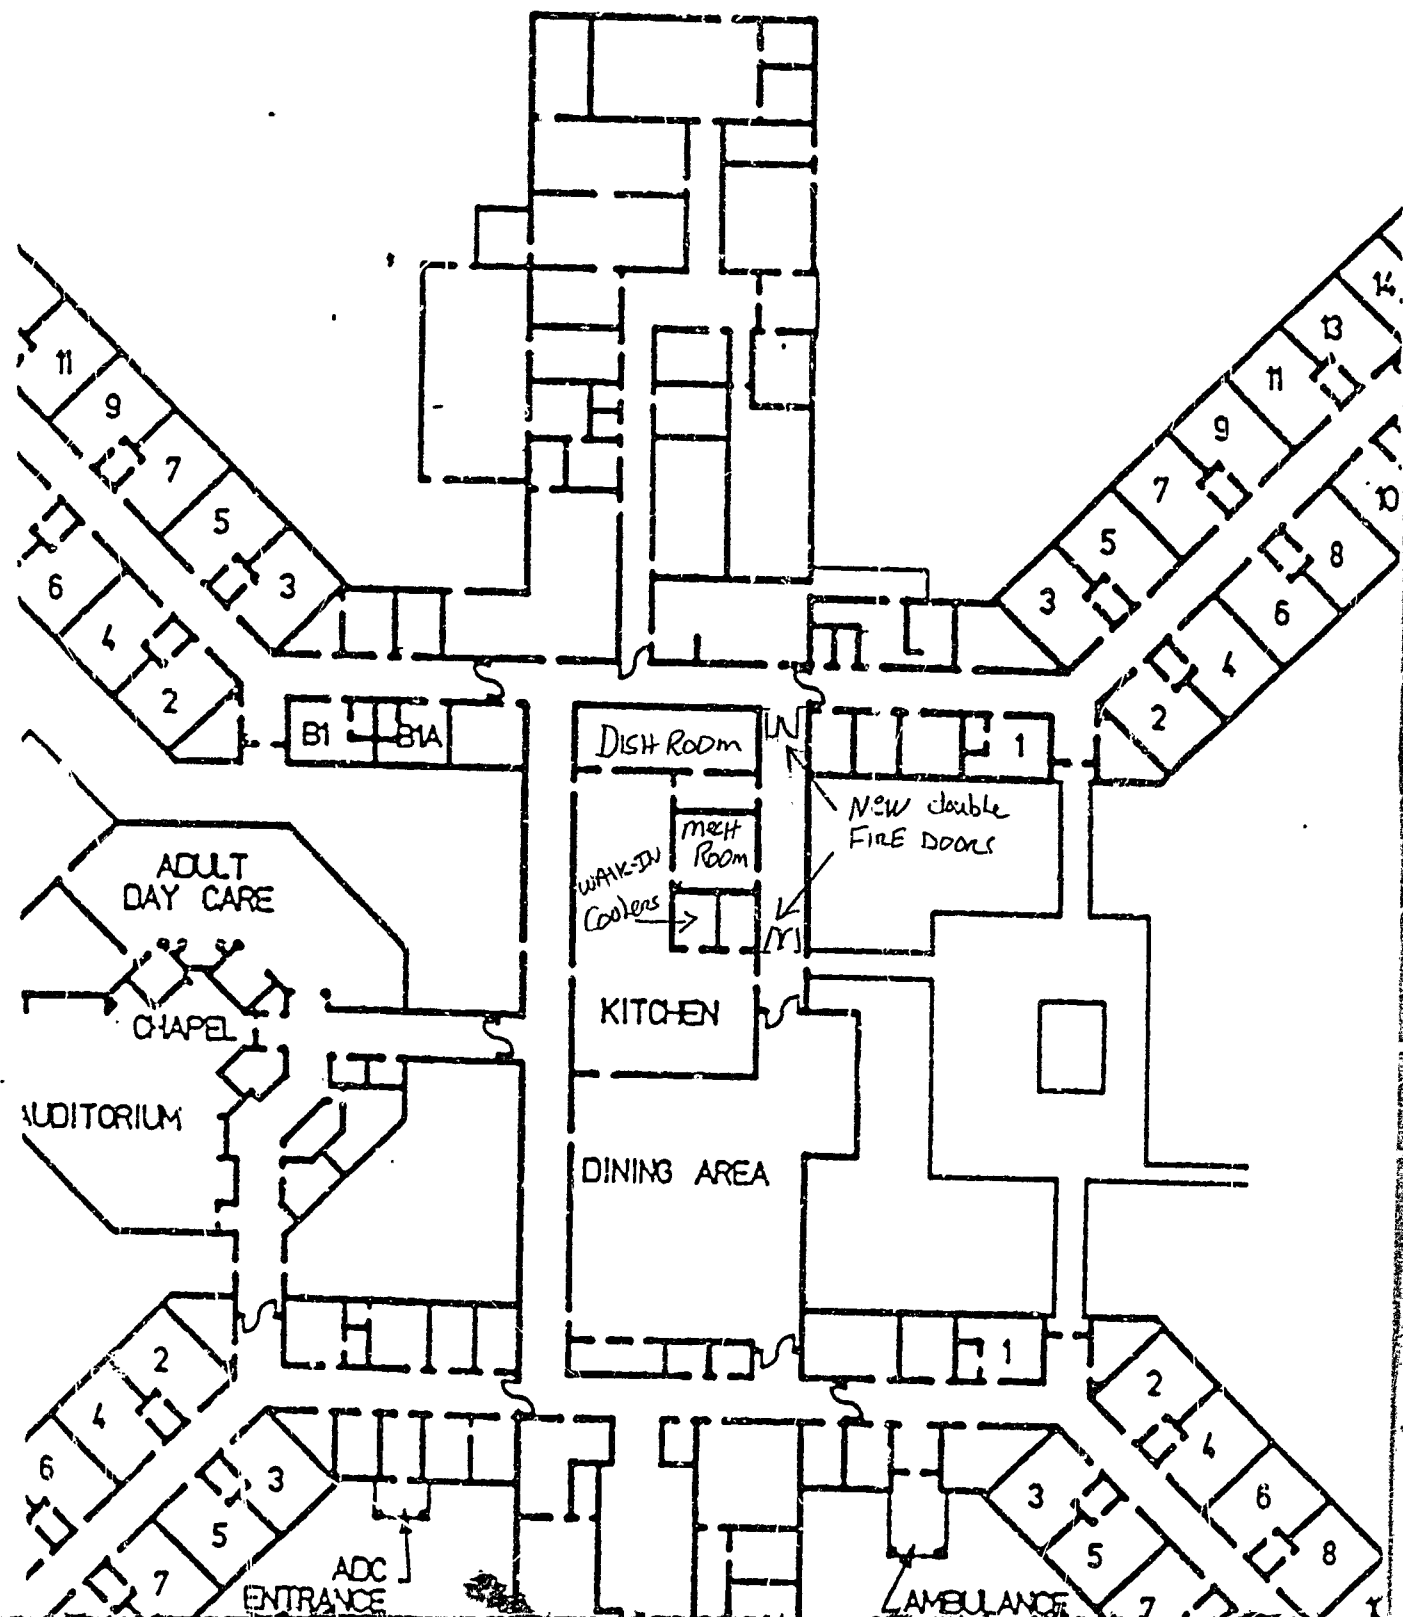

ST. JOSEPH'S MANOR

WING "E"

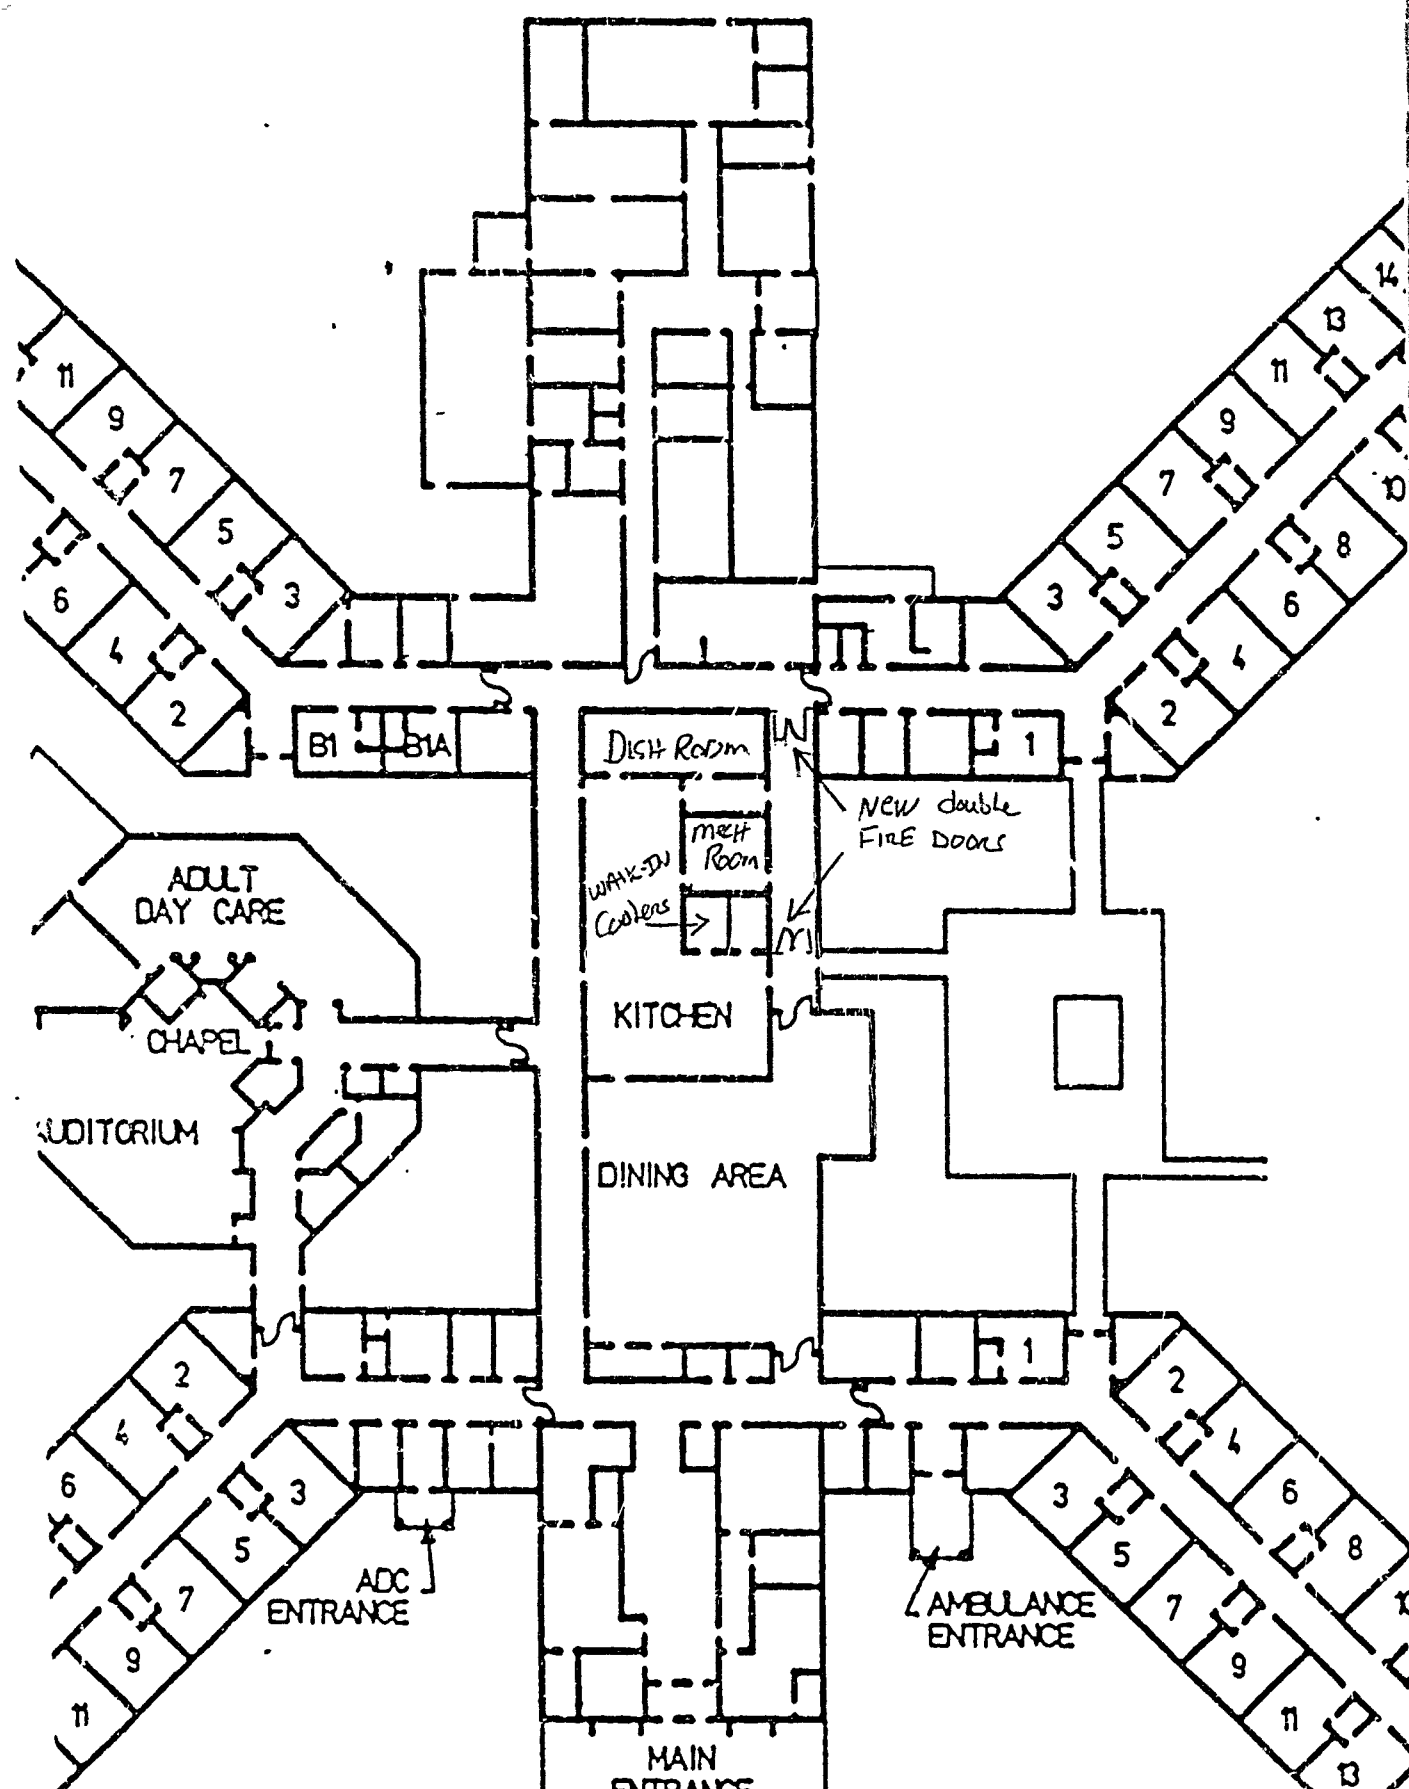

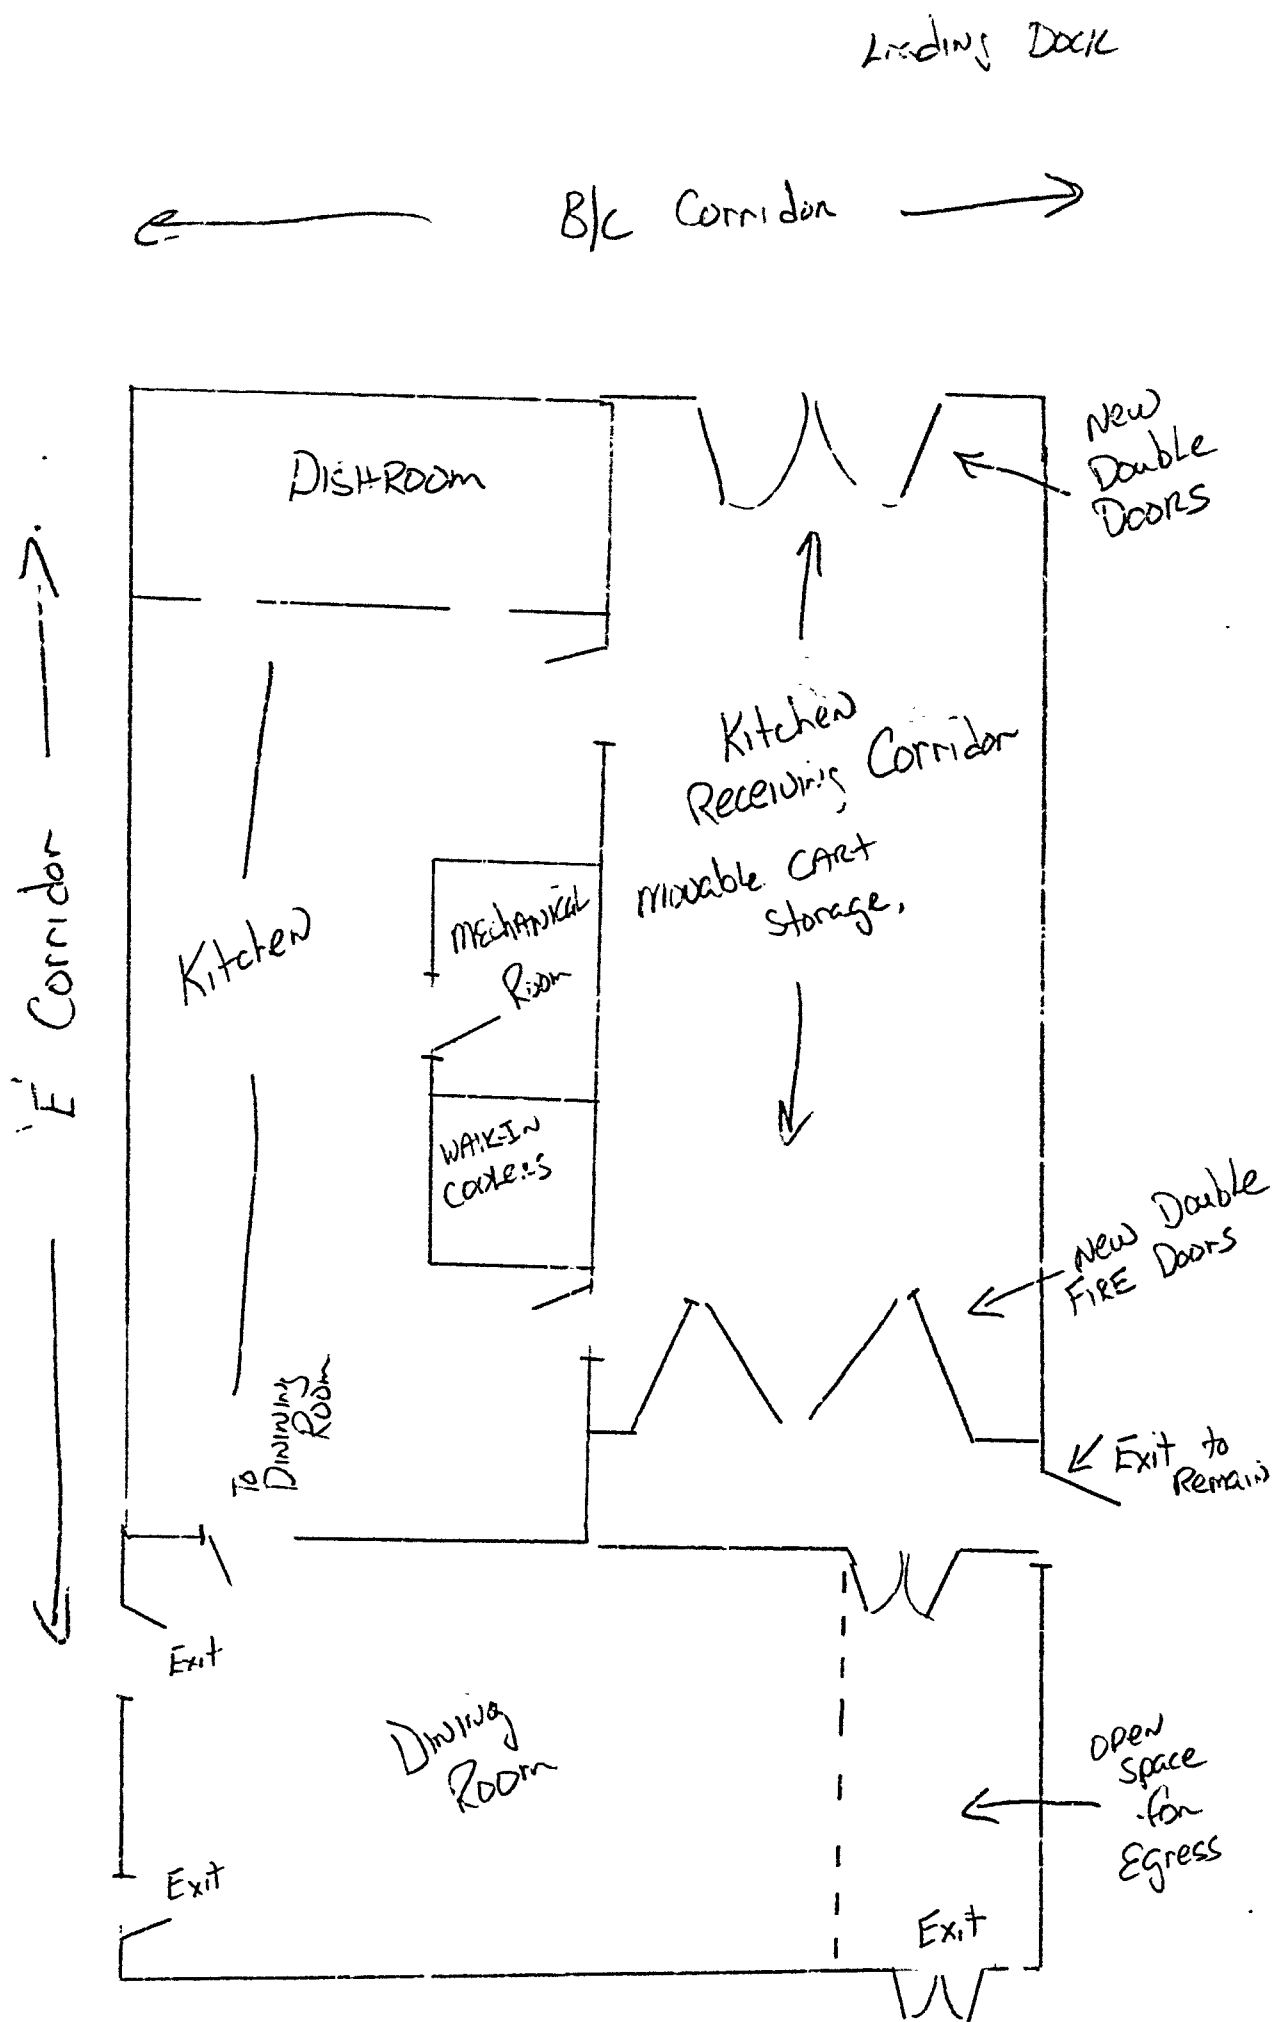

St. Joseph's Manor
1133 Washington Ave.
Portland, ME 04103

Project: Closing In Kitchen Receiving Corridor

Start Date: May 1994 Cost: \$ 6,000

Project Scope: Close in corridor behind kitchen for receiving function and storage of movable carts when not in use. Materials to be fire rated and wall to be sealed to upper floor joist.

Purpose: To maintain a safer environment for both food service employees and the residents of St. Joseph's Manor. Rear fire egress to patio area to remain as is for dining room function. Current corridor is not used as emergency egress and fire egresses do not change.

Permit Cost: \$ 25 for 1st \$ 1,000
\$ 5 for each additional \$ 1,000
Permit cost = \$ 50

Contractor Cost: \$ 5,950
See quotation dated 1/14/93 by M.R. Brewer Co.

In-house: Relocate existing light fixture
Rework wall railing system'

PROPOSAL

M.R. BREWER FINE WOODWORKING, INC.

P.O. Box 3035
PORTLAND, MAINE 04104
(207) 797-7534

PROPOSAL SUBMITTED TO		PHONE	DATE
STREET		JOB NAME	January 14, 1993
CITY, STATE AND ZIP CODE		JOB LOCATION	
ARCHITECT		DATE OF PLANS	JOB PHONE

We hereby submit specifications and estimates for:

We are pleased to quote you a price to close off corridor behind the kitchen by erecting two 2x4 walls with a pair of 3070 flush oak doors in each wall. Doors to be 20 minute fire rated. A 5"x24" glass window in one door of each pair, closers on all doors, automatic flush bolts on one door of each pair and panic hardware on the others. Install floor stops to keep door from hitting walls. Cut handrail back to accept new walls. Install new vinyl base. Walls to be prepped and ready for paint. Our price does not include any painting, electrical or plumbing.

Material	4,150.00
Labor	1,800.00
	<u>5,950.00</u>

We propose hereby to furnish material and labor — complete in accordance with above specifications, for the sum of: Five thousand nine hundred and fifty

Payment to be made as follows: _____ dollars (\$ 5,950.00)

as requisitioned

After 30 days 1 1/2% interest will be charged on all overdue bills (18% per annum)

All material is guaranteed to be as specified. All work to be completed in a workmanlike manner according to standard practices. Any alteration or deviation from above specifications involving extra costs will be executed only upon written orders, and will become an extra charge over and above the estimate. All agreements contingent upon strikes, accidents or delays beyond our control. Owner to carry fire, tornado and other necessary insurance. Our workers are fully covered by Workmen's Compensation Insurance.

Authorized Signature M. R. Brewer

Note: This proposal may be withdrawn by us if not accepted within _____ days.

Acceptance of Proposal — The above prices, specifications and conditions are satisfactory and are hereby accepted. You are authorized to do the work as specified. Payment will be made as outlined above.

Date of acceptance: _____

Signature _____

Sig. _____

NOTES

CHAI...

Permit No. _____
 Location _____
 Owner _____
 Date of permit _____
 Approved _____

1. 1 1/2 FILL PIPE
2. 1 1/4 VENT PIPE
3. Kind of heat
4. Burner rigidity & support
5. Name & Label
6. Remote control
7. High limit control
8. High limit switch
9. High limit cutoff
10. High limit control
11. Burner support & protection
12. Burner safety line
13. Burner safety switch
14. Tank safety & support
15. Oil gauge
16. Instruction card
17. Burner leaks
18. Burner ventilation
19. Burner combustibles
20. Burner safety switch


940201

FILL IN AND SIGN WITH INK



APPLICATION FOR PERMIT FOR HEATING, COOKING OR POWER EQUIPMENT

Portland, Maine, March 25, 1994

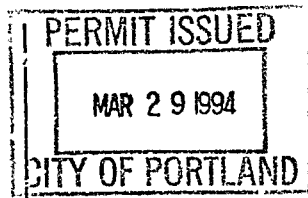

To the INSPECTOR OF BUILDINGS, PORTLAND, ME.

The undersigned hereby applies for a permit to install the following heating, cooking or power equipment in accordance with the Laws of Maine, the Building Code of the City of Portland, and the following specifications:

Location 1233 Washington Ave. Use of Building Nursing Home No. Stories 1 New Building Existing "X"

Name and address of owner of appliance St. Joseph's Manor

XXX Installer's name and address Scribner & Iverson, Inc. Telephone 797-9441

P.O. Box 8779 Portland, ME 04104
General Description of Work

To install 1 w. boiler

IF HEATER, OR POWER BOILER

Location of appliance boiler room Any burnable material in floor surface or beneath? no

If so, how protected? Kind of fuel? prop gas/oil

Minimum distance to burnable material, from top of appliance or casing top of furnace 5 feet

From top of smoke pipe ALL CONCRETE From front of appliance ALL CONCRETE From sides or back of appliance

Size of chimney flue 14 INCH Other connections to same flue no

If gas fired, how vented? roof Rated maximum demand per hour 2.8 mbh

Will sufficient fresh air be supplied to the appliance to insure proper and safe combustion? yes

IF OIL BURNER

Name and type of burner Webster Labelled by underwriters' laboratories? yes

Will operator be always in attendance? no Does oil supply line feed from top or bottom of tank? top

Type of floor beneath burner concrete Size of vent pipe 14 inch

Location of oil storage above ground outside Number and capacity of tanks 1 10,000 gallons

Low water shut off yes Make MM No

Will all tanks be more than five feet from any flame? yes How many tanks enclosed? none

Total capacity of any existing storage tanks for furnace burners none

IF COOKING APPLIANCE

Location of appliance Any burnable material in floor surface or beneath?

If so, how protected? Height of Legs, if any

Skirting at bottom of appliance? Distance to combustible material from top of appliance?

From front of appliance From side and back From top of smoke pipe

Size of chimney flue Other connections to same flue

Is hood to be provided? If so, how vented? Forced or gravity?

If gas fired, how vented? Rated maximum demand per hour

MISCELLANEOUS EQUIPMENT OR SPECIAL INFORMATION

License # 5512

Cost of work \$12,500

Amount of fee enclosed? \$85.00

APPROVED:

Will there be in charge of the above work a person competent to see that the State and City requirements pertaining thereto are observed? yes

CS 306

INSPECTION

FILE

APPLICANT'S

ASSESSOR'S COPY

Signature of Installer

7 DAVID JORDAN