FURNITURE PLAN GENERAL NOTES

1. All furnishings are by Owner

CALEB JOHNSON
STUDIO
110 EXCHANGE ST, 2ND FLOOR, PORTLAND, ME 04101
T: 207.283.8777
CJAB.ME

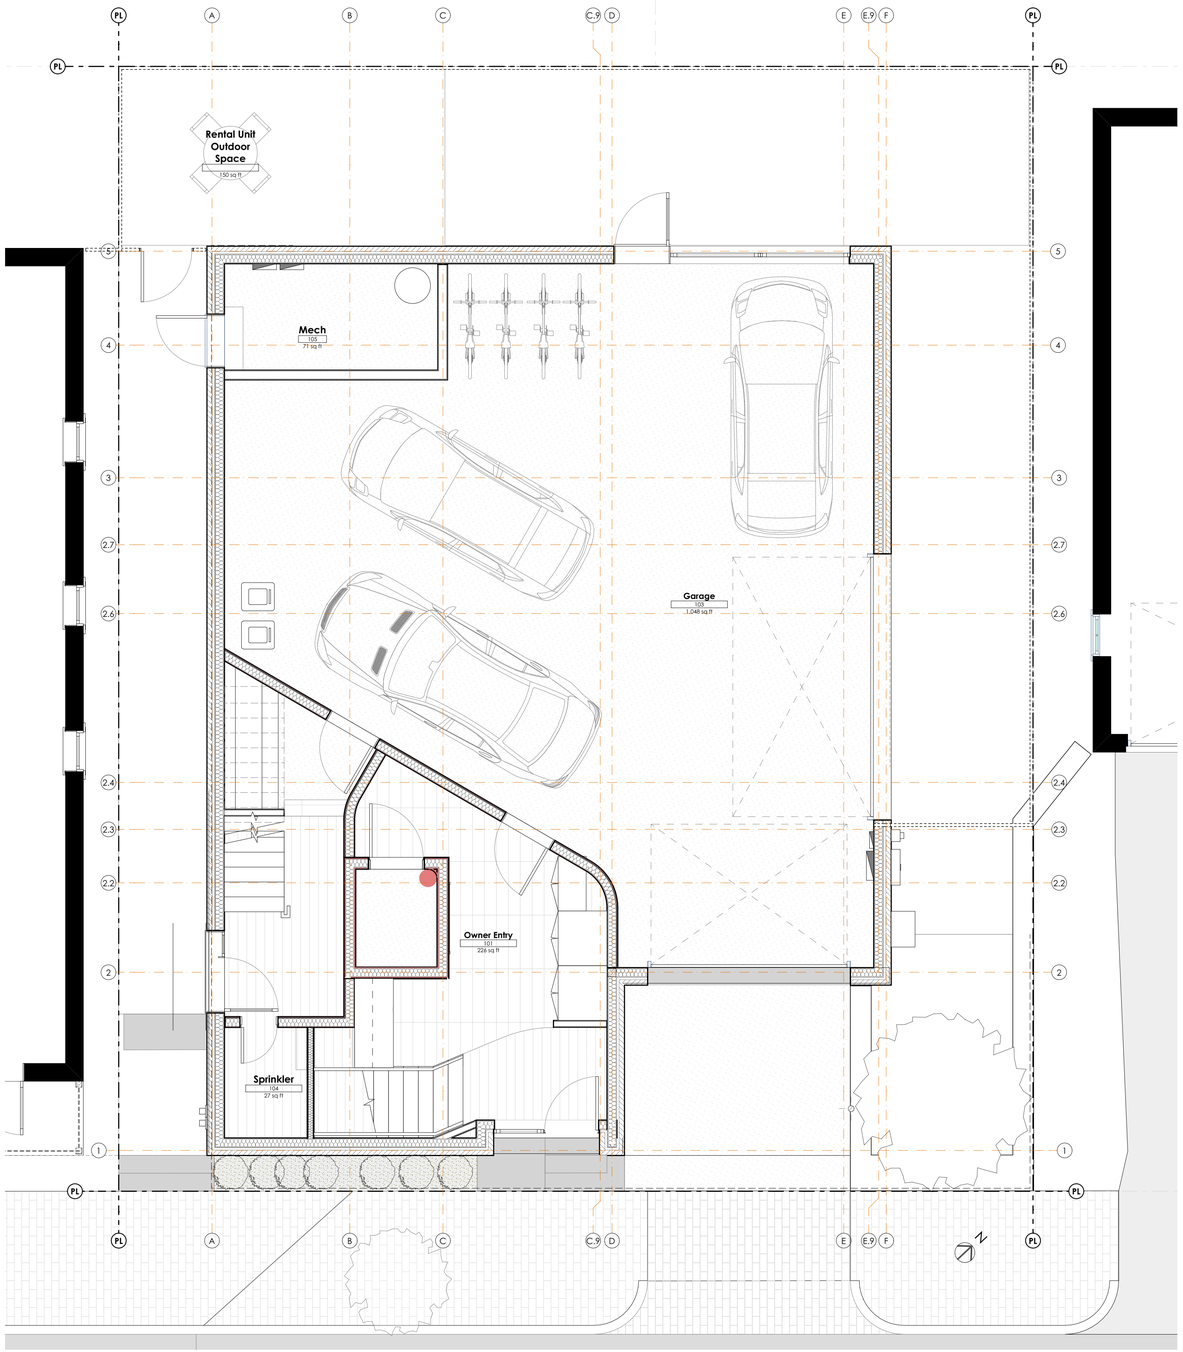

1 1ST FLOOR FURNITURE PLAN
SCALE: 1/4" = 1'-0"

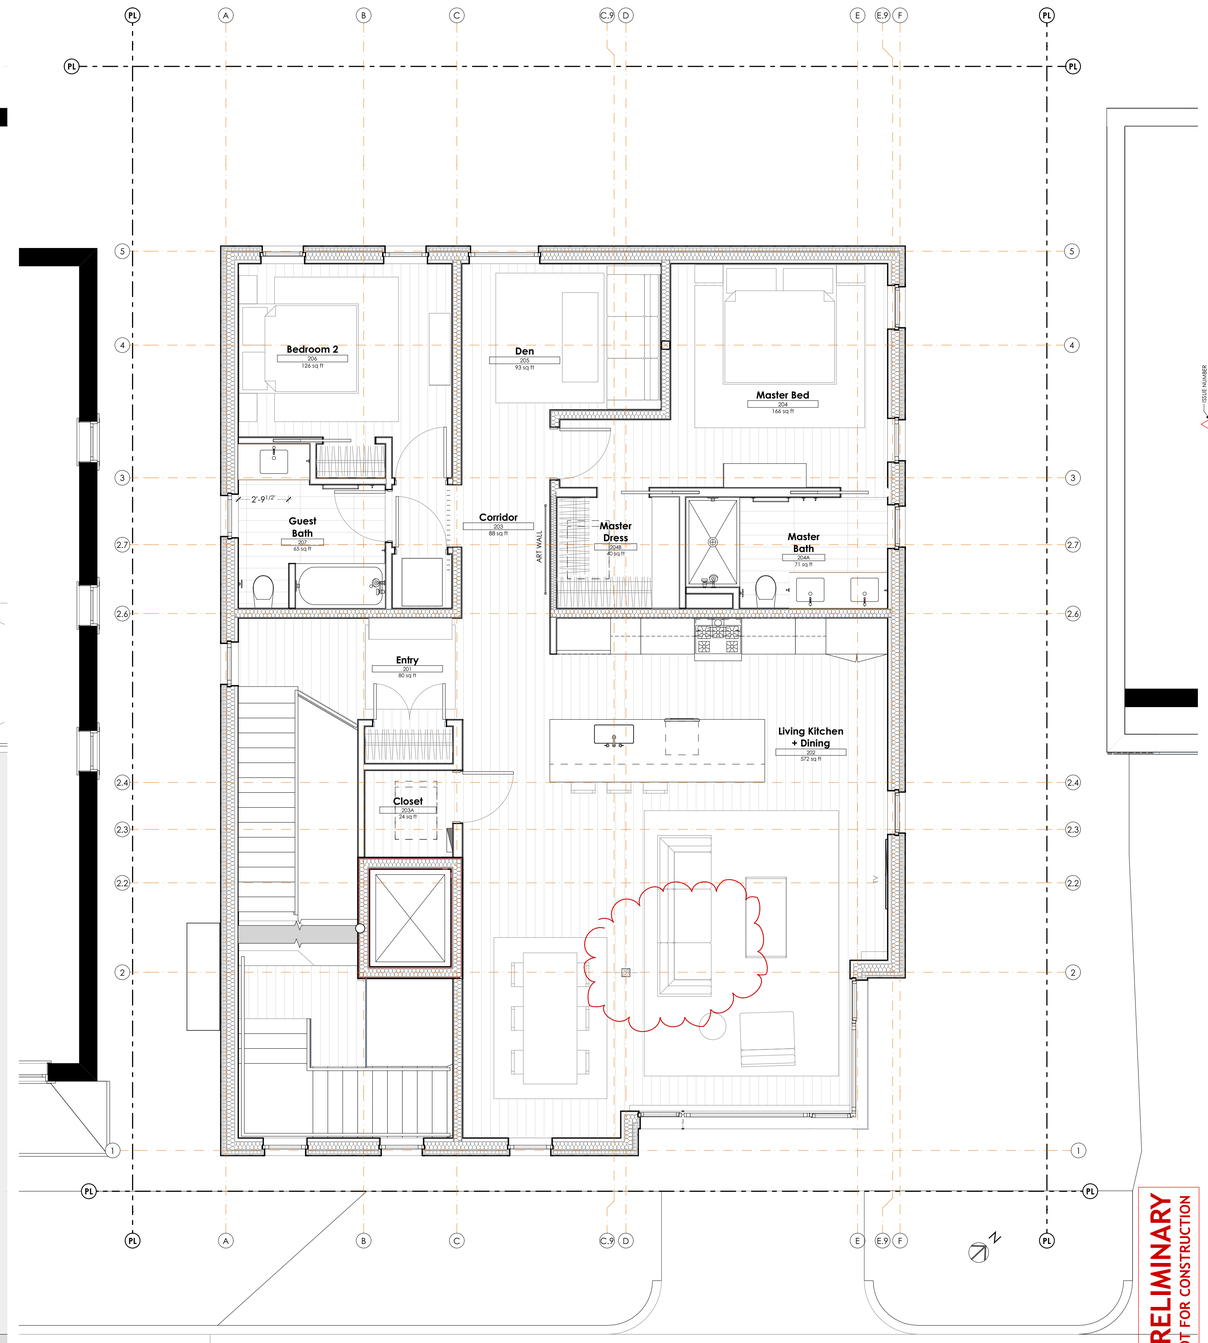

2 2ND FLOOR FURNITURE PLAN
SCALE: 1/4" = 1'-0"

PRELIMINARY
NOT FOR CONSTRUCTION

CHANGES THIS ISSUE:

ID	DESCRIPTION

ISSUE NUMBER X.X
CHANGE NUMBER CH-X.X

ISSUE	DATE	DESCRIPTION
001	12-01-2017	CITY REVIEW
002	03-07-2018	REVISED PER CITY REVIEW COMMENTS

SUBMISSIONS:

CONSULTANT:

ARCHITECT
DRAFTSPERSON: PB/JJ/JM
DATE OF ISSUE: 03.07.18
PROJECT STATUS: 90% CD's

Brady Residence

Jim and Julia Brady
9 Moody Street Portland ME 04101

FURNITURE PLANS - 1ST & 2ND FLOORS

A-106

BIM Server: bimserver.cjab.me - BIM Server 21/9 Moody Street/9 Moody Street_02152018