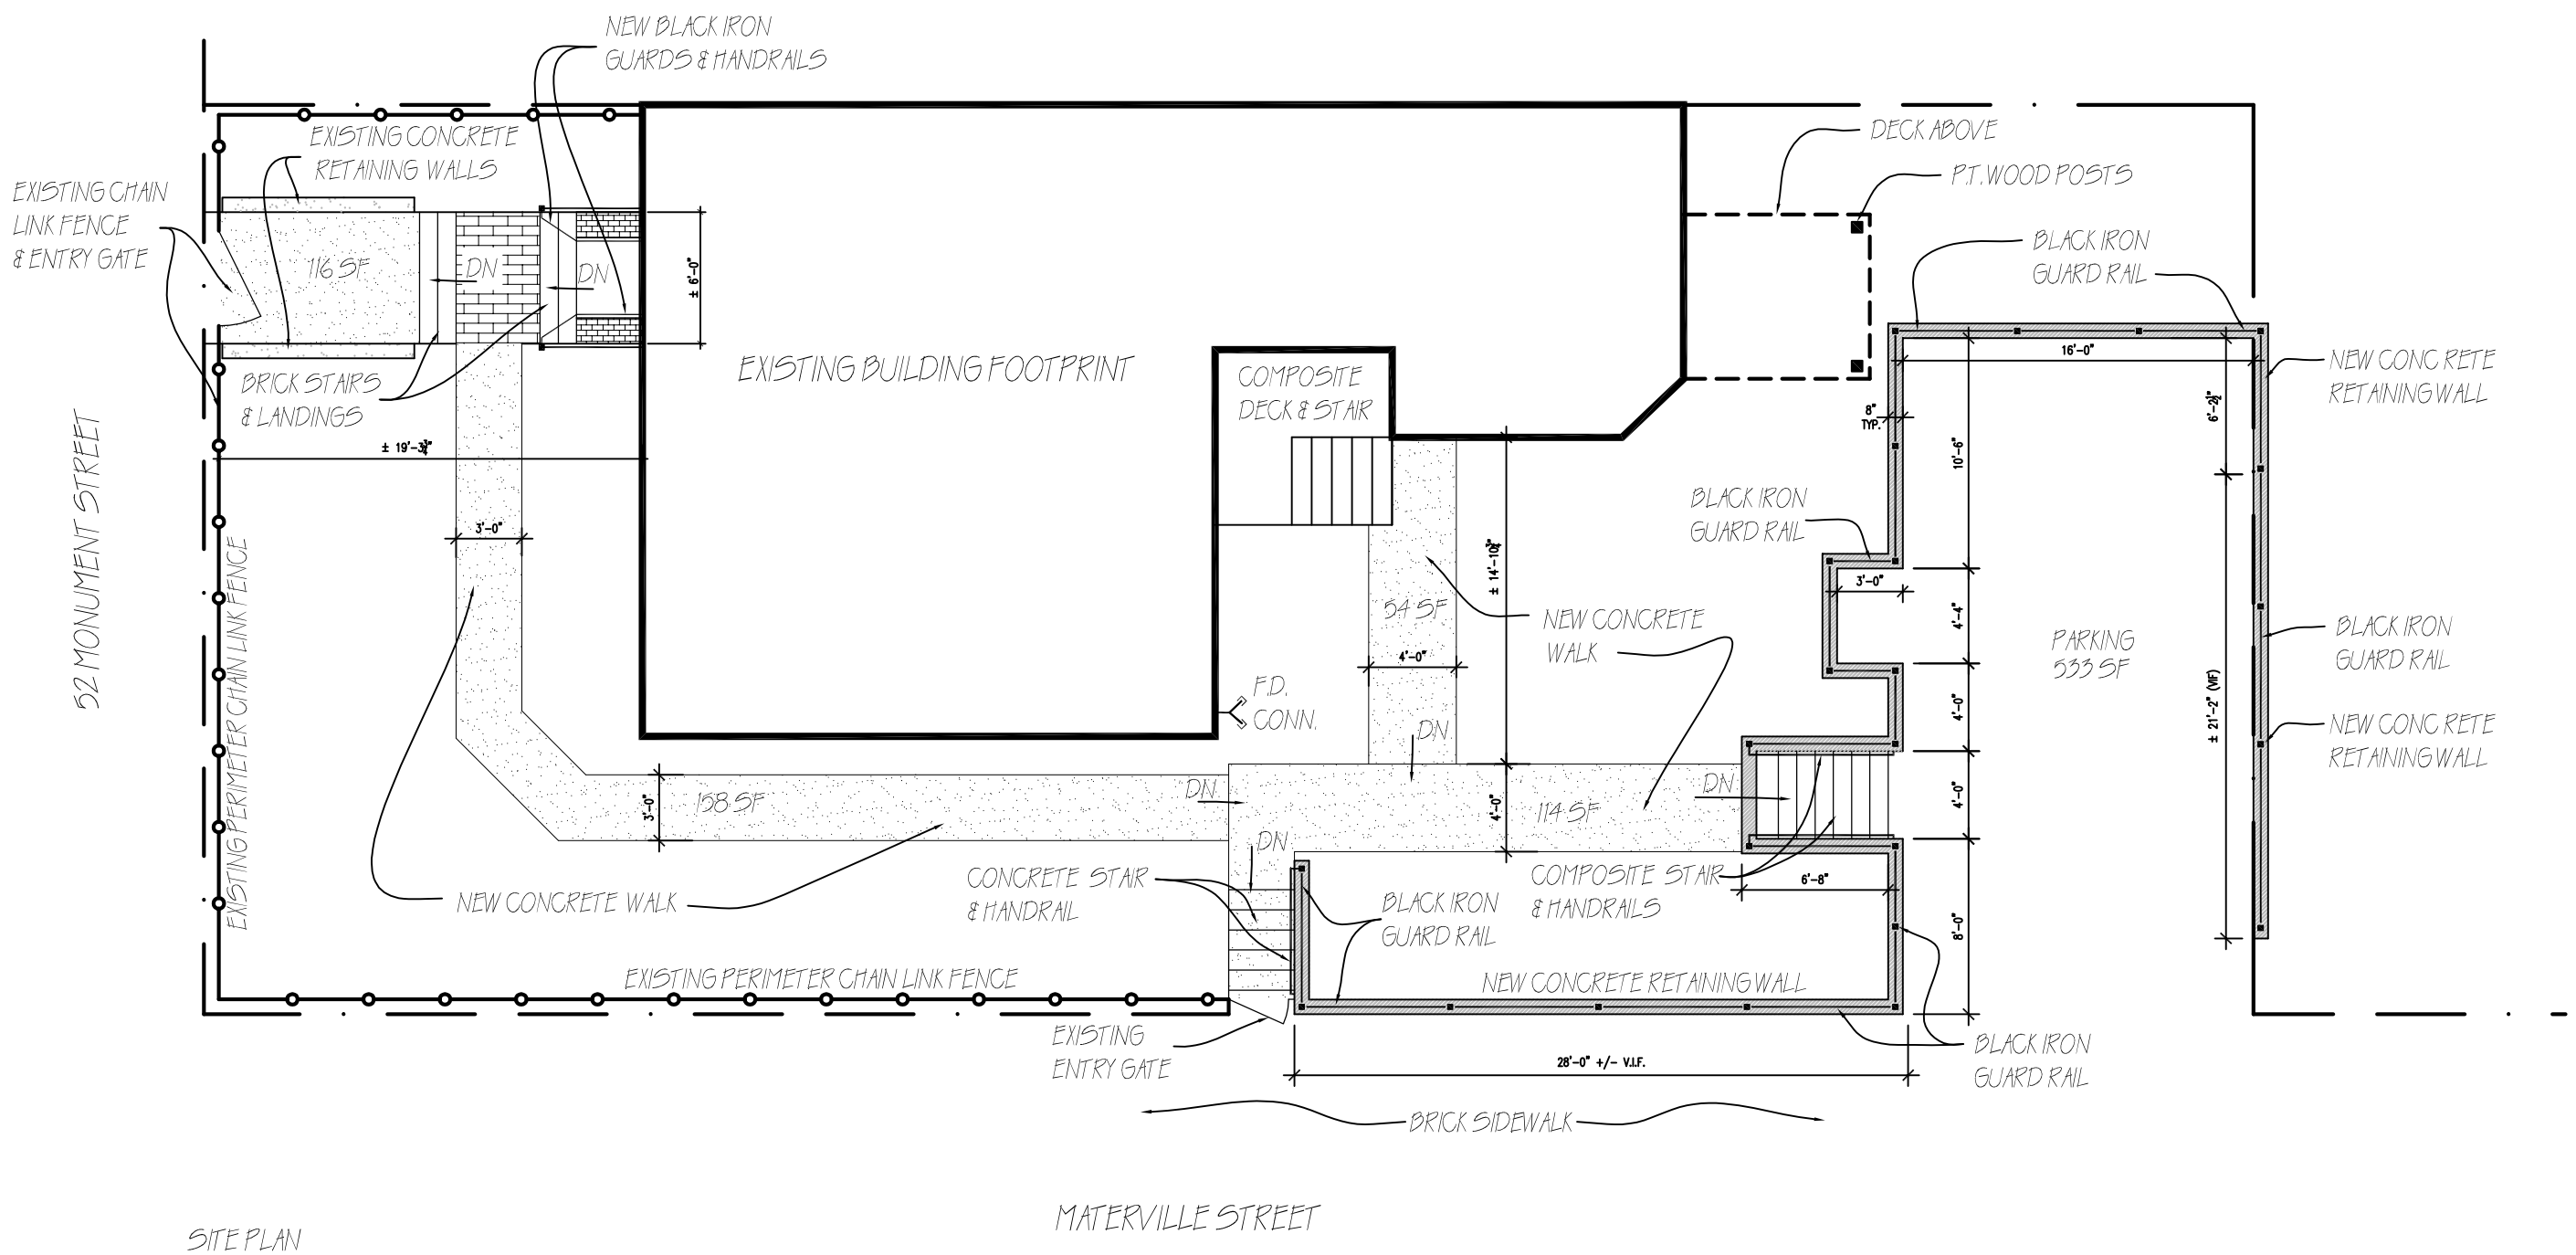

SITE PLAN
SCALE: 1/8" = 1'-0"

NOTES

1. SITE PLAN TAKEN FROM *LACHMAN ARCHITECTS* DRAWING L1 DATED 11-5-13.
2. AS-BUILT PARKING & WALKWAY DIMENSIONS SHOWN ON THIS PLAN TAKEN 4-26-16.
3. TOTAL IMPERVIOUS PARKING AND WALKWAY SURFACE AREA = 975 SQUARE FEET.

REV.	DATE	STATUS
	04-28-16	AS BUILT PARKING AND WALKS
1	05-31-16	ADDED CONCRETE RETAINING WALL

JOHN H. LEASURE ARCHITECT, INC.
6 Q STREET
SOUTH PORTLAND, MAINE 04106

RENOVATIONS AND ADDITIONS
52 MONUMENT STREET
PORTLAND, MAINE

ASBUILT PARKING AREA AND WALKS

REVISED

L1