sonell - Wed, 07 Jun 2006 - 11:28am

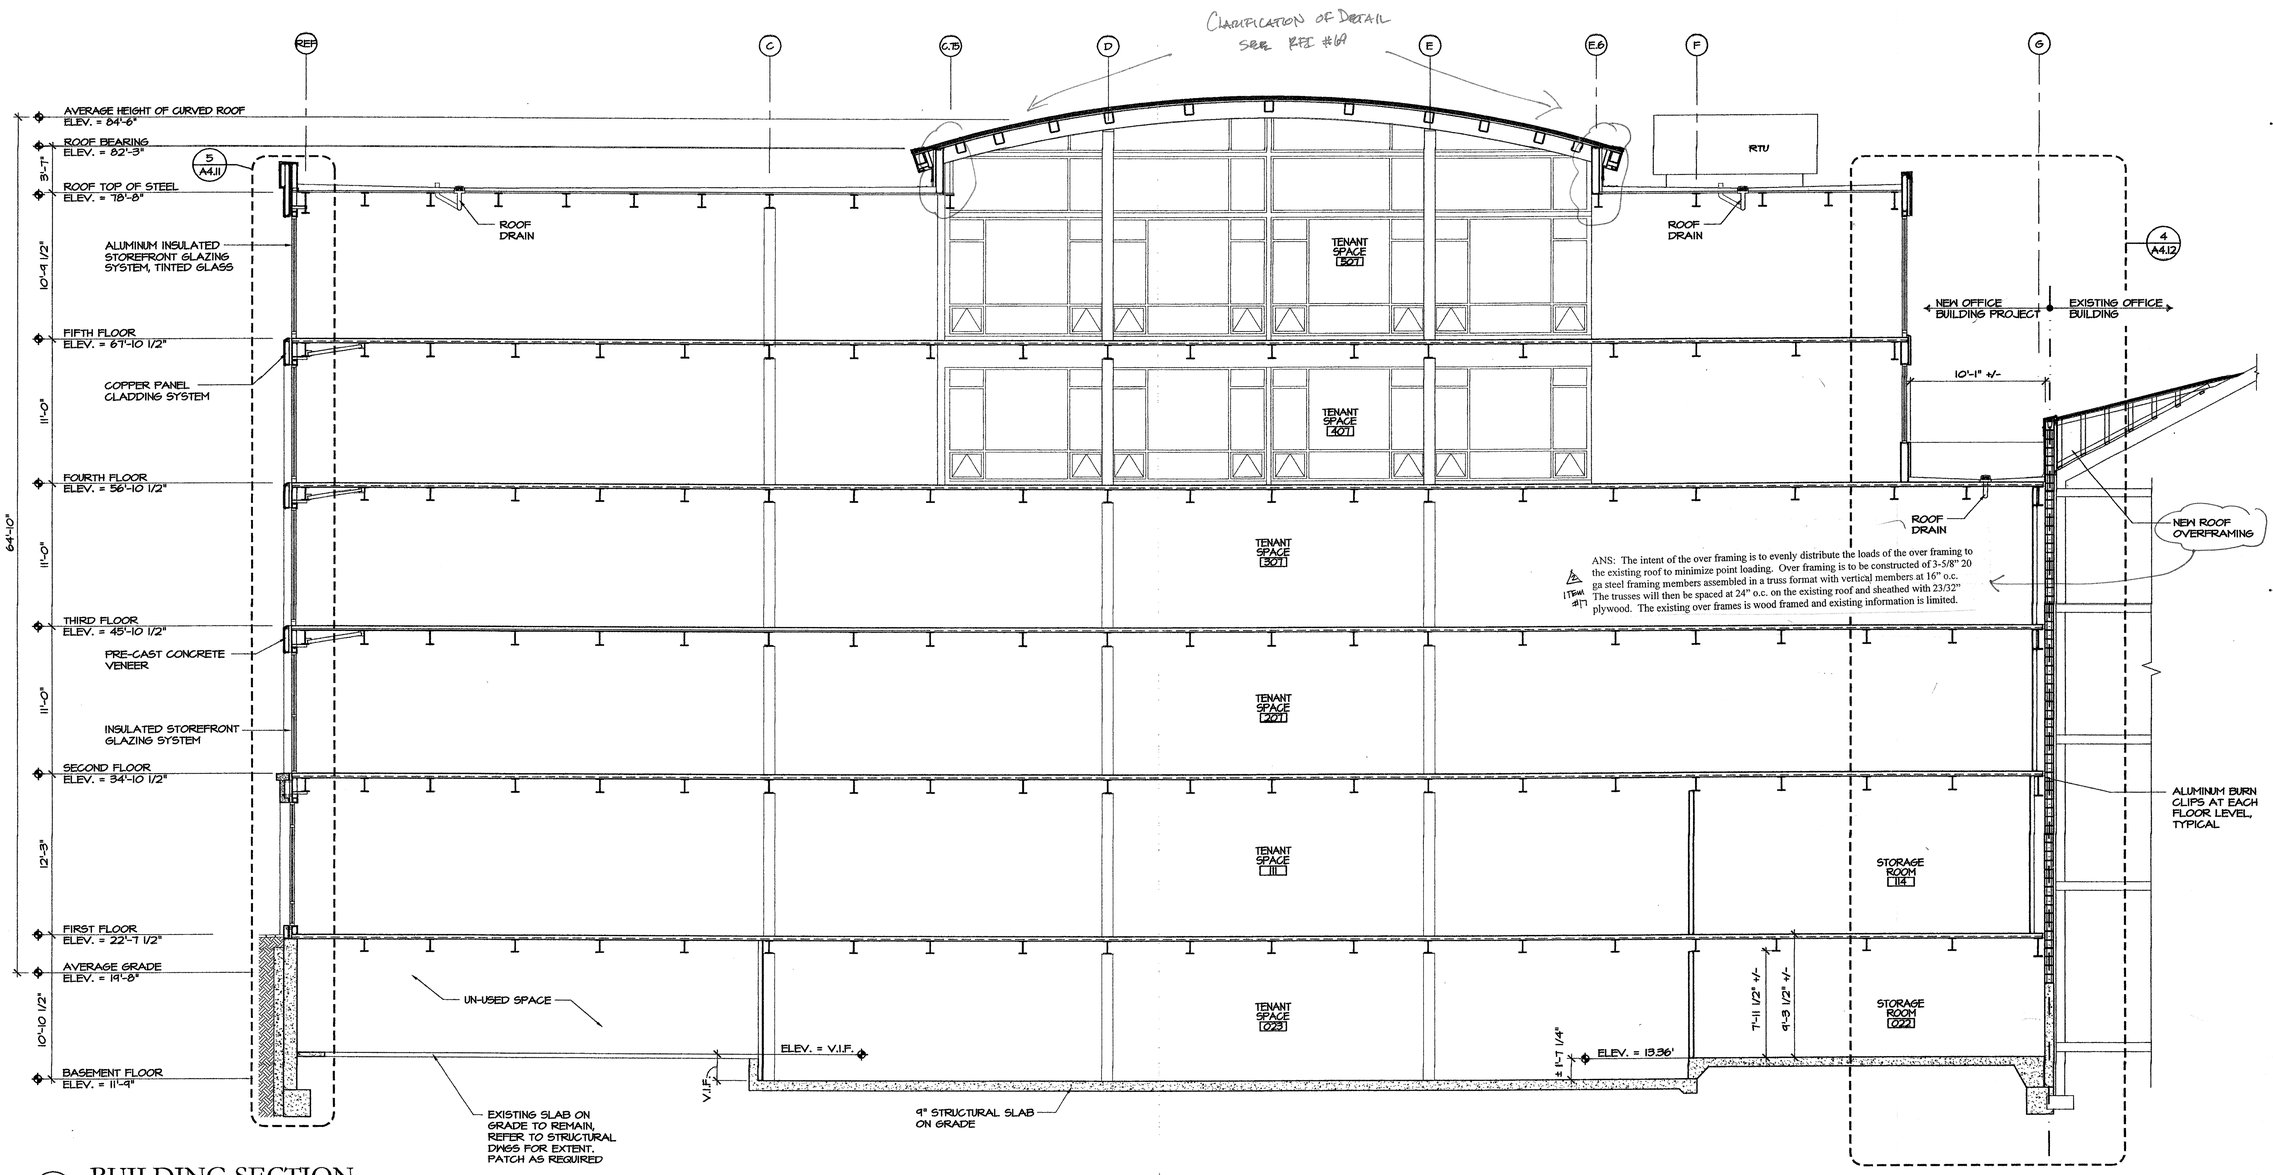

1 BUILDING SECTION

SCALE: 3/16" = 1'-0"

NOT FOR CONSTRUCTION
05/26/06

ISSUE:
05/26/2006: ISSUED FOR PRICING

PRO CON INCORPORATED
Design and Construction Management
ARCHITECTURE
P.O. Box 443, 12 Spring
Scarborough, ME 04070
207.883.8811 Fax: 688.625.7250
procontinc.com

CUSTOM HOUSE SQUARE
300 FORE STREET
PORTLAND, MAINE
BUILDING SECTION

PROJECT ARCHITECT: MW
DRAWN BY: SO, BR
PROJECT #: 300506

A4.4

DO NOT SCALE DRAWING. USE WRITTEN DIMENSIONS. WHERE NO WRITTEN DIMENSION IS PROVIDED, CONSULT THE ARCHITECT FOR CLARIFICATION BEFORE PROCEEDING WITH THE WORK.
©COPYRIGHT 2006 PRO CON INC

0506A4.04.dwg

G:\Proj\Year2005\300506_Custom_House_Square\DWG\0506A4.04.dwg