sonell - Wed, 07 Jun 2006 - 11:25am

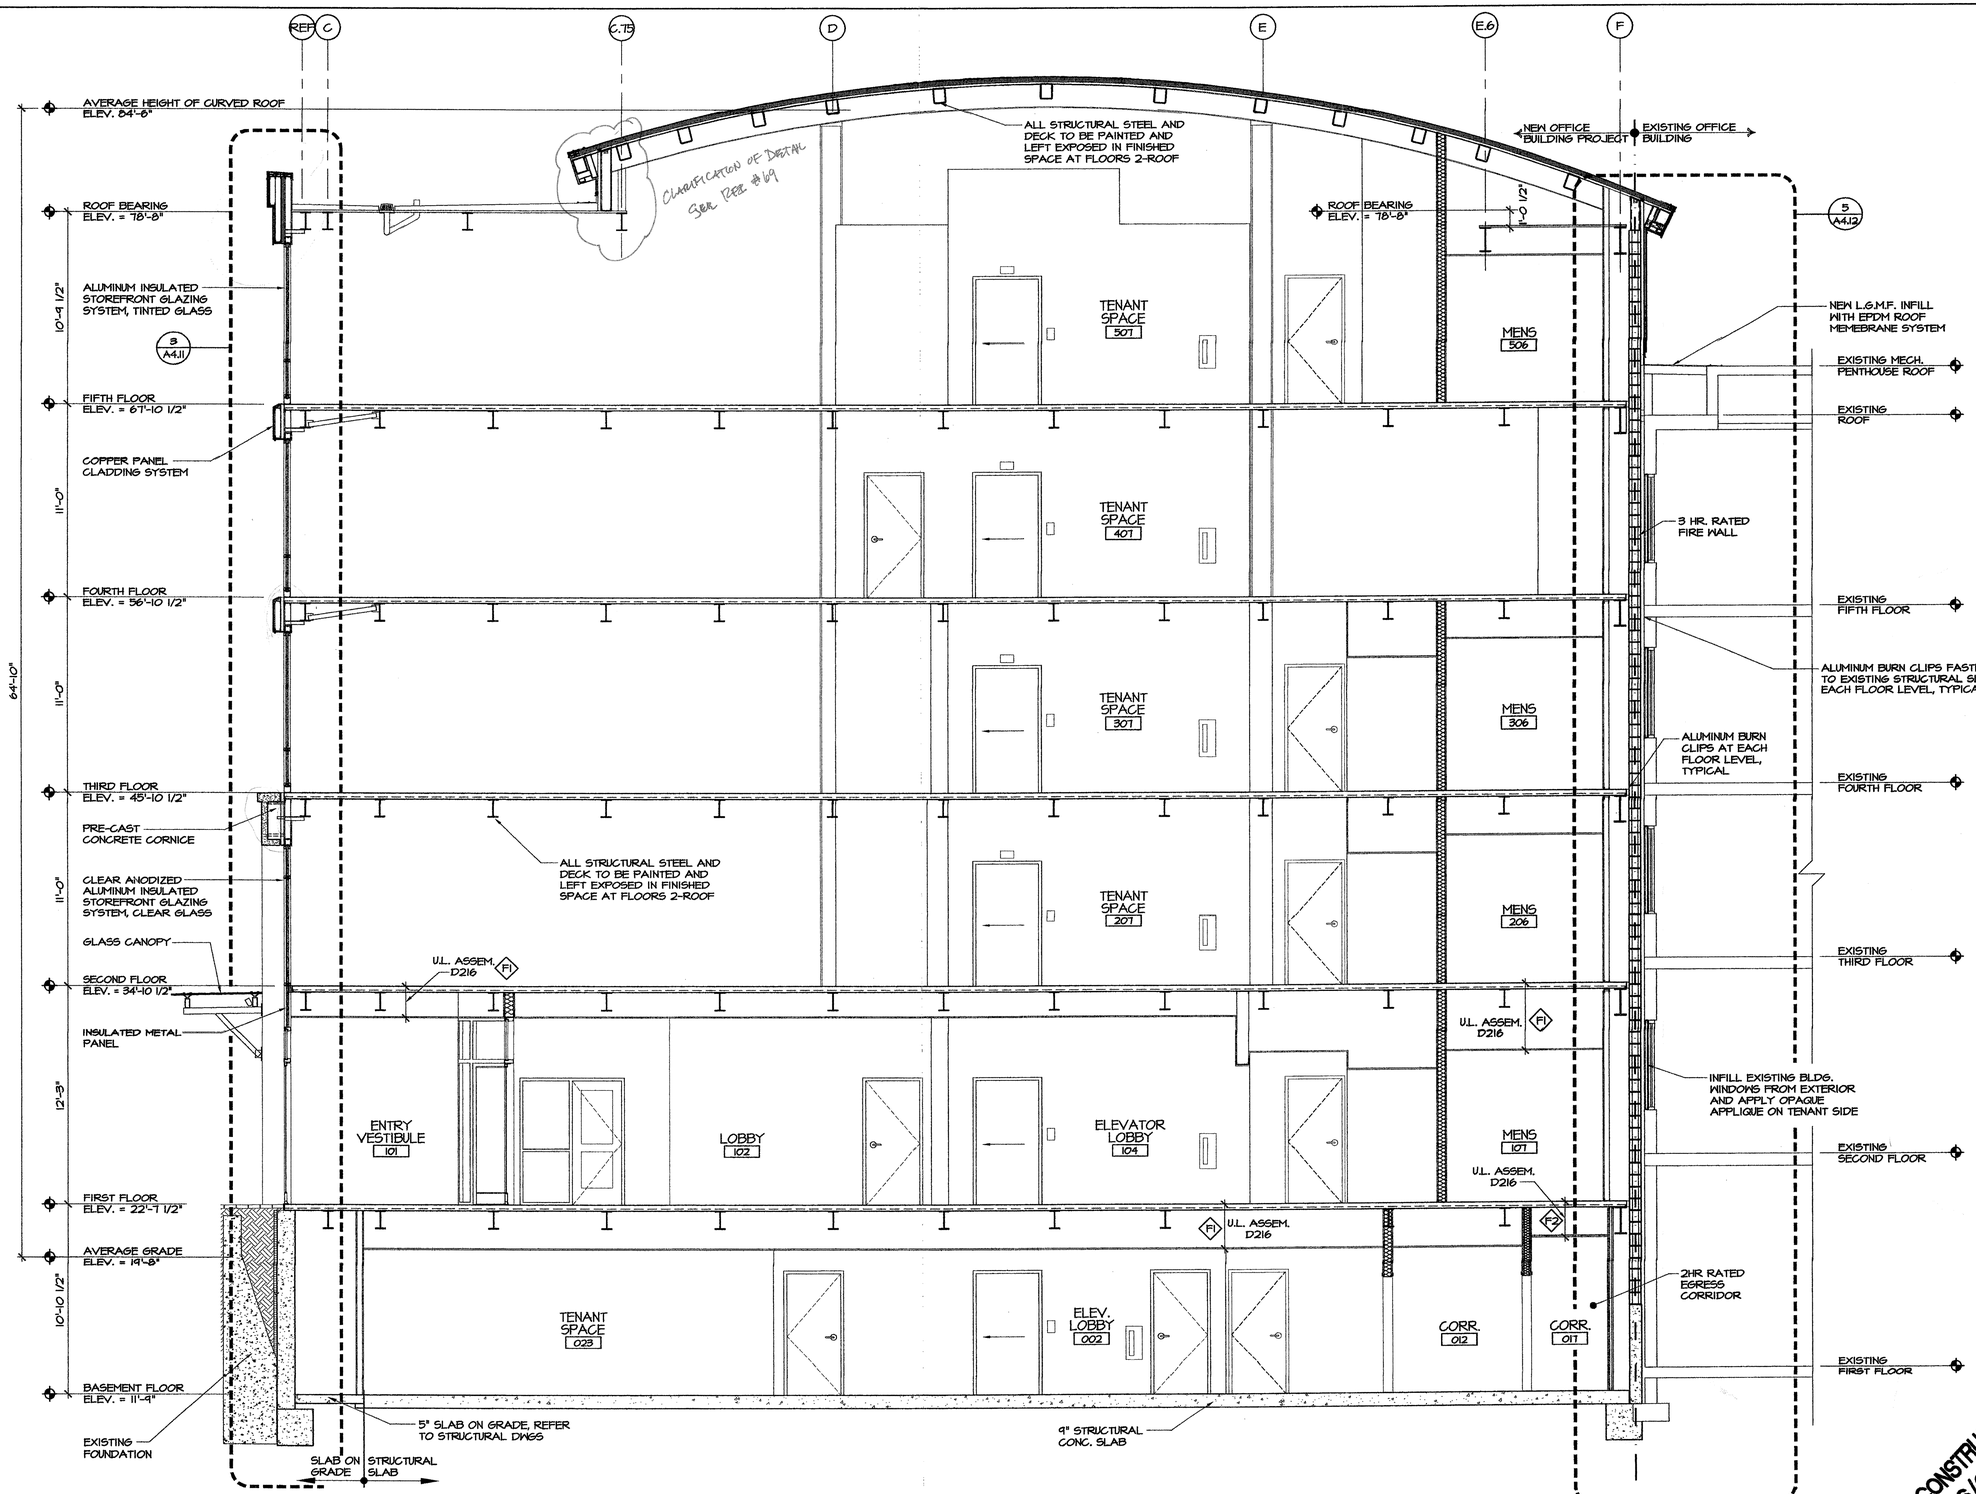

1 BUILDING SECTION

SCALE: 1/4" = 1'-0"

NOT FOR CONSTRUCTION
05/26/06

PRO CON INCORPORATED
Design and Construction Management
ARCHITECTURE
Andrew Wellenstein, NJ#13108 procontinc.com
P.O. Box 4400, Yarmouth, ME 04096
(207) 846-9111 Fax: (207) 846-9112

ISSUED:
05/26/2006: ISSUED FOR PRICING

CUSTOM HOUSE SQUARE

300 FORE STREET
PORTLAND, MAINE

BUILDING SECTION

PROJECT ARCHITECT:	MW
DRAWN BY:	SO,BR
PROJECT #:	300506

A4.2

DO NOT SCALE DRAWING. USE WRITTEN DIMENSIONS. WHERE NO WRITTEN DIMENSION IS PROVIDED, CONSULT THE ARCHITECT FOR CLARIFICATION BEFORE PROCEEDING WITH THE WORK.

©COPYRIGHT 2006 PRO CON INC

0506A4.02.dwg

G:\Prod\Year2005\300506_Custom_House_Square\DWG\0506A4.02.dwg