


- GENERAL REFLECTED CEILING PLAN NOTES**
1. ALL CONDUIT, MC CABLE, TEL/DATA WIRING, etc. LOCATED IN EXPOSED CEILING AREAS ARE TO BE MOUNTED, ROUTED AND BUNDLED IN A NEAT AND PROFESSIONAL MANNER, AND COORDINATED WITH ALL MECHANICAL, PLUMBING AND SPRINKLER ITEMS IN EXPOSED CEILING AREAS.
 2. CENTER ALL SPRINKLER HEADS, LIGHTS & FIXTURES IN CEILING TILES.
 3. LIGHTS ARE SHOWN TO HELP ESTABLISH RELATIONSHIP OF SPRINKLER HEAD LOCATIONS TO OTHER CEILING ELEMENTS. FOR INFORMATION ON ALL CEILING AND WALL MOUNTED LIGHT FIXTURES AND DEVICES, REFER TO ELECTRICAL DRAWINGS AND CUT SHEETS.
 4. REFER TO ELECTRICAL DOCUMENTS FOR ADDITIONAL LIGHT FIXTURE INFORMATION.
 5. LIGHT FIXTURE LOCATIONS AND QUANTITIES ARE THE RESPONSIBILITY OF THE DESIGN/BUILD ELECTRICAL ENGINEER. ENGINEER TO ENSURE THAT THE LIGHTING LEVELS MEET ALL APPLICABLE CODES.
 6. LIGHT FIXTURES SHALL BE LOCATED IN THE CENTER OF THE STAIR LANDINGS.
 7. LIGHT FIXTURES IN RATED CEILING ASSEMBLY REQUIRE 5/8" RATED ACOUSTICAL MATERIAL BOX ABOVE CEILING.
 8. ALL FIXTURES TO BE SUSPENDED AND STABILIZED PER UL#216
 9. AIR DUCTS REQUIRE DAMPERS

REFLECTED CEILING LEGEND

SYMBOL	DESCRIPTION	SYMBOL	DESCRIPTION
	WALL SCONCE LIGHT FIXTURE		FLUORESCENT STRIP FIXTURE
	WALL SCONCE FLUORESCENT LIGHT FIXTURE		WALL MOUNTED EXTERIOR LIGHT FIXTURE
	DECORATIVE CEILING MOUNTED LIGHT FIXTURE		EXIT LIGHT (EXACT LOCATION TO BE DETERMINED BY ELECTRICAL ENGINEER)
	RECESSED FLUORESCENT LIGHT FIXTURE		EXHAUST FAN
	RECESSED FLUORESCENT WALL WASHER		ACCESS PANEL TO CEILING FIRE DAMPERS
	PENDANT MOUNT FLUORESCENT FIXTURE		JUNCTION BOX
	24" x 48" RECESSED FLUORESCENT FIXTURE		ELECTRIC POWER PANEL
	24" x 24" RECESSED FLUORESCENT FIXTURE		SUPPLY DIFFUSER
	8" x 48" RECESSED FLUORESCENT FIXTURE		RETURN AIR DIFFUSER

NOTE: REFER TO ELECTRICAL DRAWINGS, LIGHT FIXTURE MANUFACTURERS, AND MODEL NUMBERS

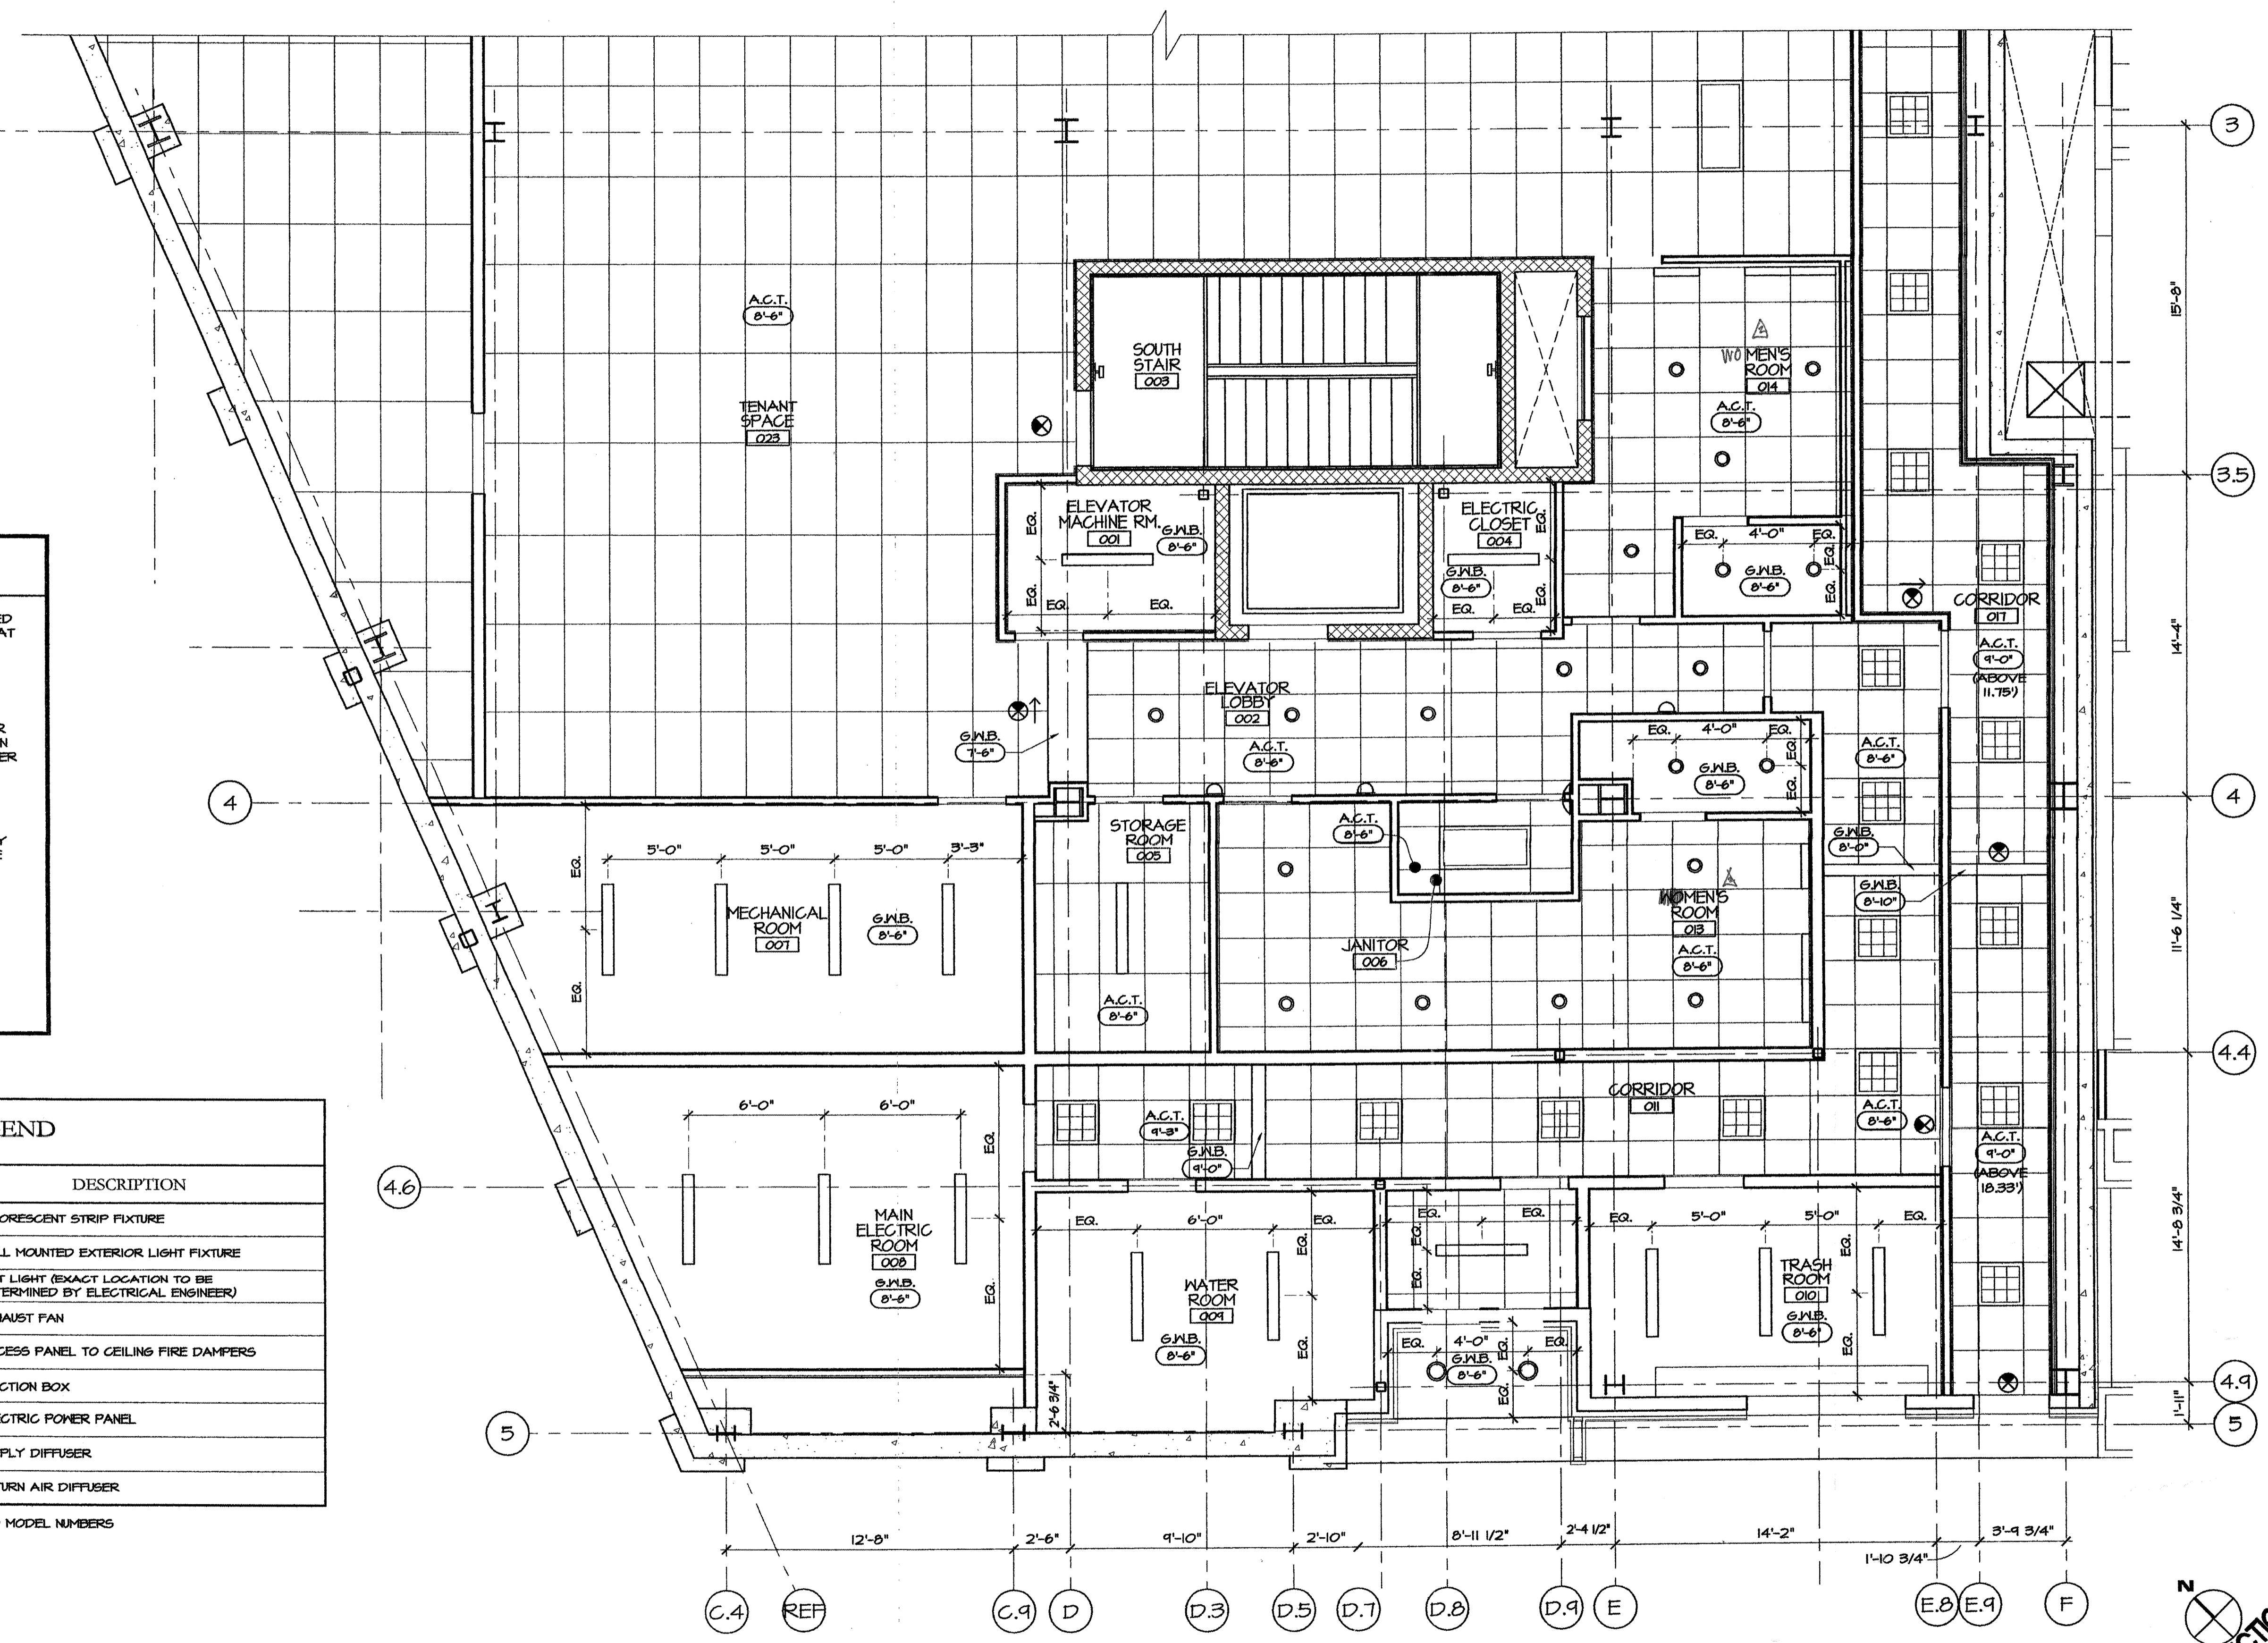

ENLARGED LOWER LEVEL REFLECTED CEILING PLAN
SCALE: 1/4" = 1'-0"

ISSUE: 05/26/06 ISSUED FOR PRICING

CUSTOM HOUSE SQUARE
300 FORE STREET
PORTLAND, MAINE
ENLARGED LOWER LEVEL REFLECTED CEILING PLAN

PROJECT ARCHITECT:
MW
DRAWN BY:
SO, BR
PROJECT #:
300506

A2.2

NOT FOR CONSTRUCTION
05/26/06