sorell - Wed, 07 Jun 2006 - 10:56am

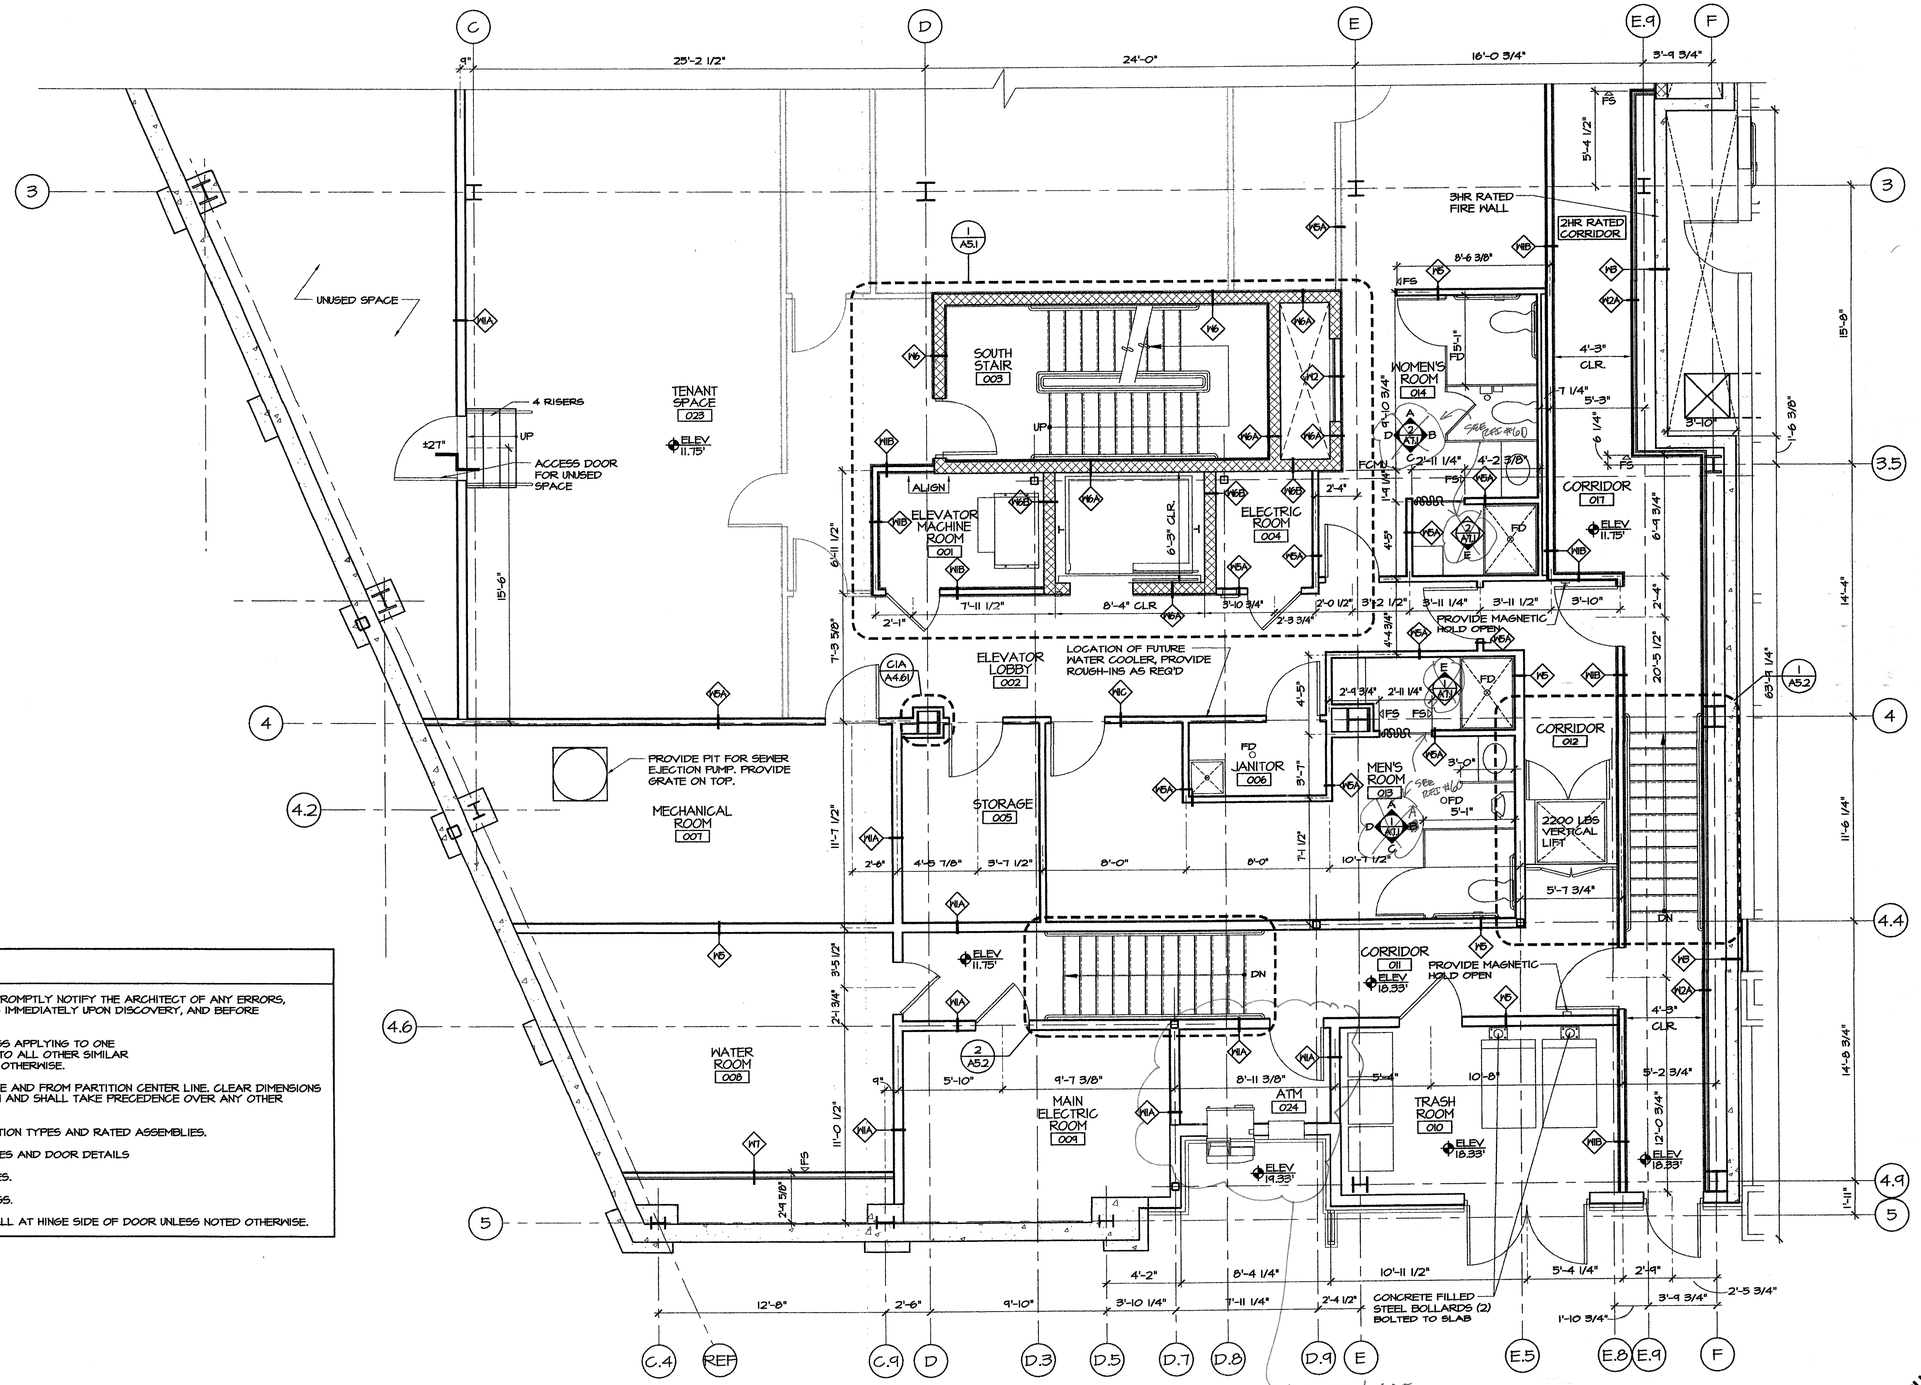

NOTES:
ATM MACHINE AND NIGHT DEPOSIT DROP BOX BY TENANT

GENERAL NOTES

1. FIELD VERIFY ALL DIMENSIONS AND CONDITIONS. PROMPTLY NOTIFY THE ARCHITECT OF ANY ERRORS, OMISSIONS, INCONSISTENCIES OR OTHER PROBLEMS IMMEDIATELY UPON DISCOVERY, AND BEFORE PROCEEDING WITH THE WORK.
2. ALL INDICATIONS AND NOTATIONS ON THE DRAWINGS APPLYING TO ONE AREA, COMPONENT OR CONDITIONS, SHALL APPLY TO ALL OTHER SIMILAR AREAS, COMPONENTS UNLESS CLEARLY INDICATED OTHERWISE.
3. DIMENSIONS ARE TAKEN FROM COLUMN CENTER LINE AND FROM PARTITION CENTER LINE. CLEAR DIMENSIONS ARE TO THE FINISHED FACE OF NEW CONSTRUCTION AND SHALL TAKE PRECEDENCE OVER ANY OTHER DIMENSION.
4. REFER TO SHEETS A4.60 - A4.61 FOR WALL PARTITION TYPES AND RATED ASSEMBLIES.
5. REFER TO SHEET A6.2 & A6.4 FOR DOOR SCHEDULES AND DOOR DETAILS
6. REFER TO SHEET A6.3 FOR ROOM FINISH SCHEDULES.
7. REFER TO OVERALL FLOOR PLANS FOR DOOR TAGS.
8. DOORS ARE TO BE LOCATED 4" MINIMUM FROM WALL AT HINGE SIDE OF DOOR UNLESS NOTED OTHERWISE.

ENLARGED LOWER LEVEL FLOOR PLAN

SCALE: 1/4" = 1'-0"

NOT FOR CONSTRUCTION 05/26/06

PRO CON INCORPORATED
Design and Construction Management
ARCHITECTURE
A Builders Company
P.O. Box 4430, Manchester, NH 03108 procon@aol.com
603.623.8811 Fax: 668.623.7250

ISSUE:
05/22/2006: ISSUED FOR PRICING

CUSTOM HOUSE SQUARE
300 FORE STREET
PORTLAND, MAINE

ENLARGED LOWER LEVEL FLOOR PLAN

PROJECT ARCHITECT: MW
DRAWN BY: SO, BR
PROJECT #: 300506

A2.1

DO NOT SCALE DRAWING. USE WRITTEN DIMENSIONS. WHERE NO WRITTEN DIMENSION IS PROVIDED, CONSULT THE ARCHITECT FOR CLARIFICATION BEFORE PROCEEDING WITH THE WORK.
©COPYRIGHT 2006 PRO CON INC

G:\Prod\Year 2005\300506_Custom_House_Square\DWG\0506A2.1.dwg