


Issue - Mod. CT Jun 2006 - 9.16am

MOMENT FRAME ELEVATIONS

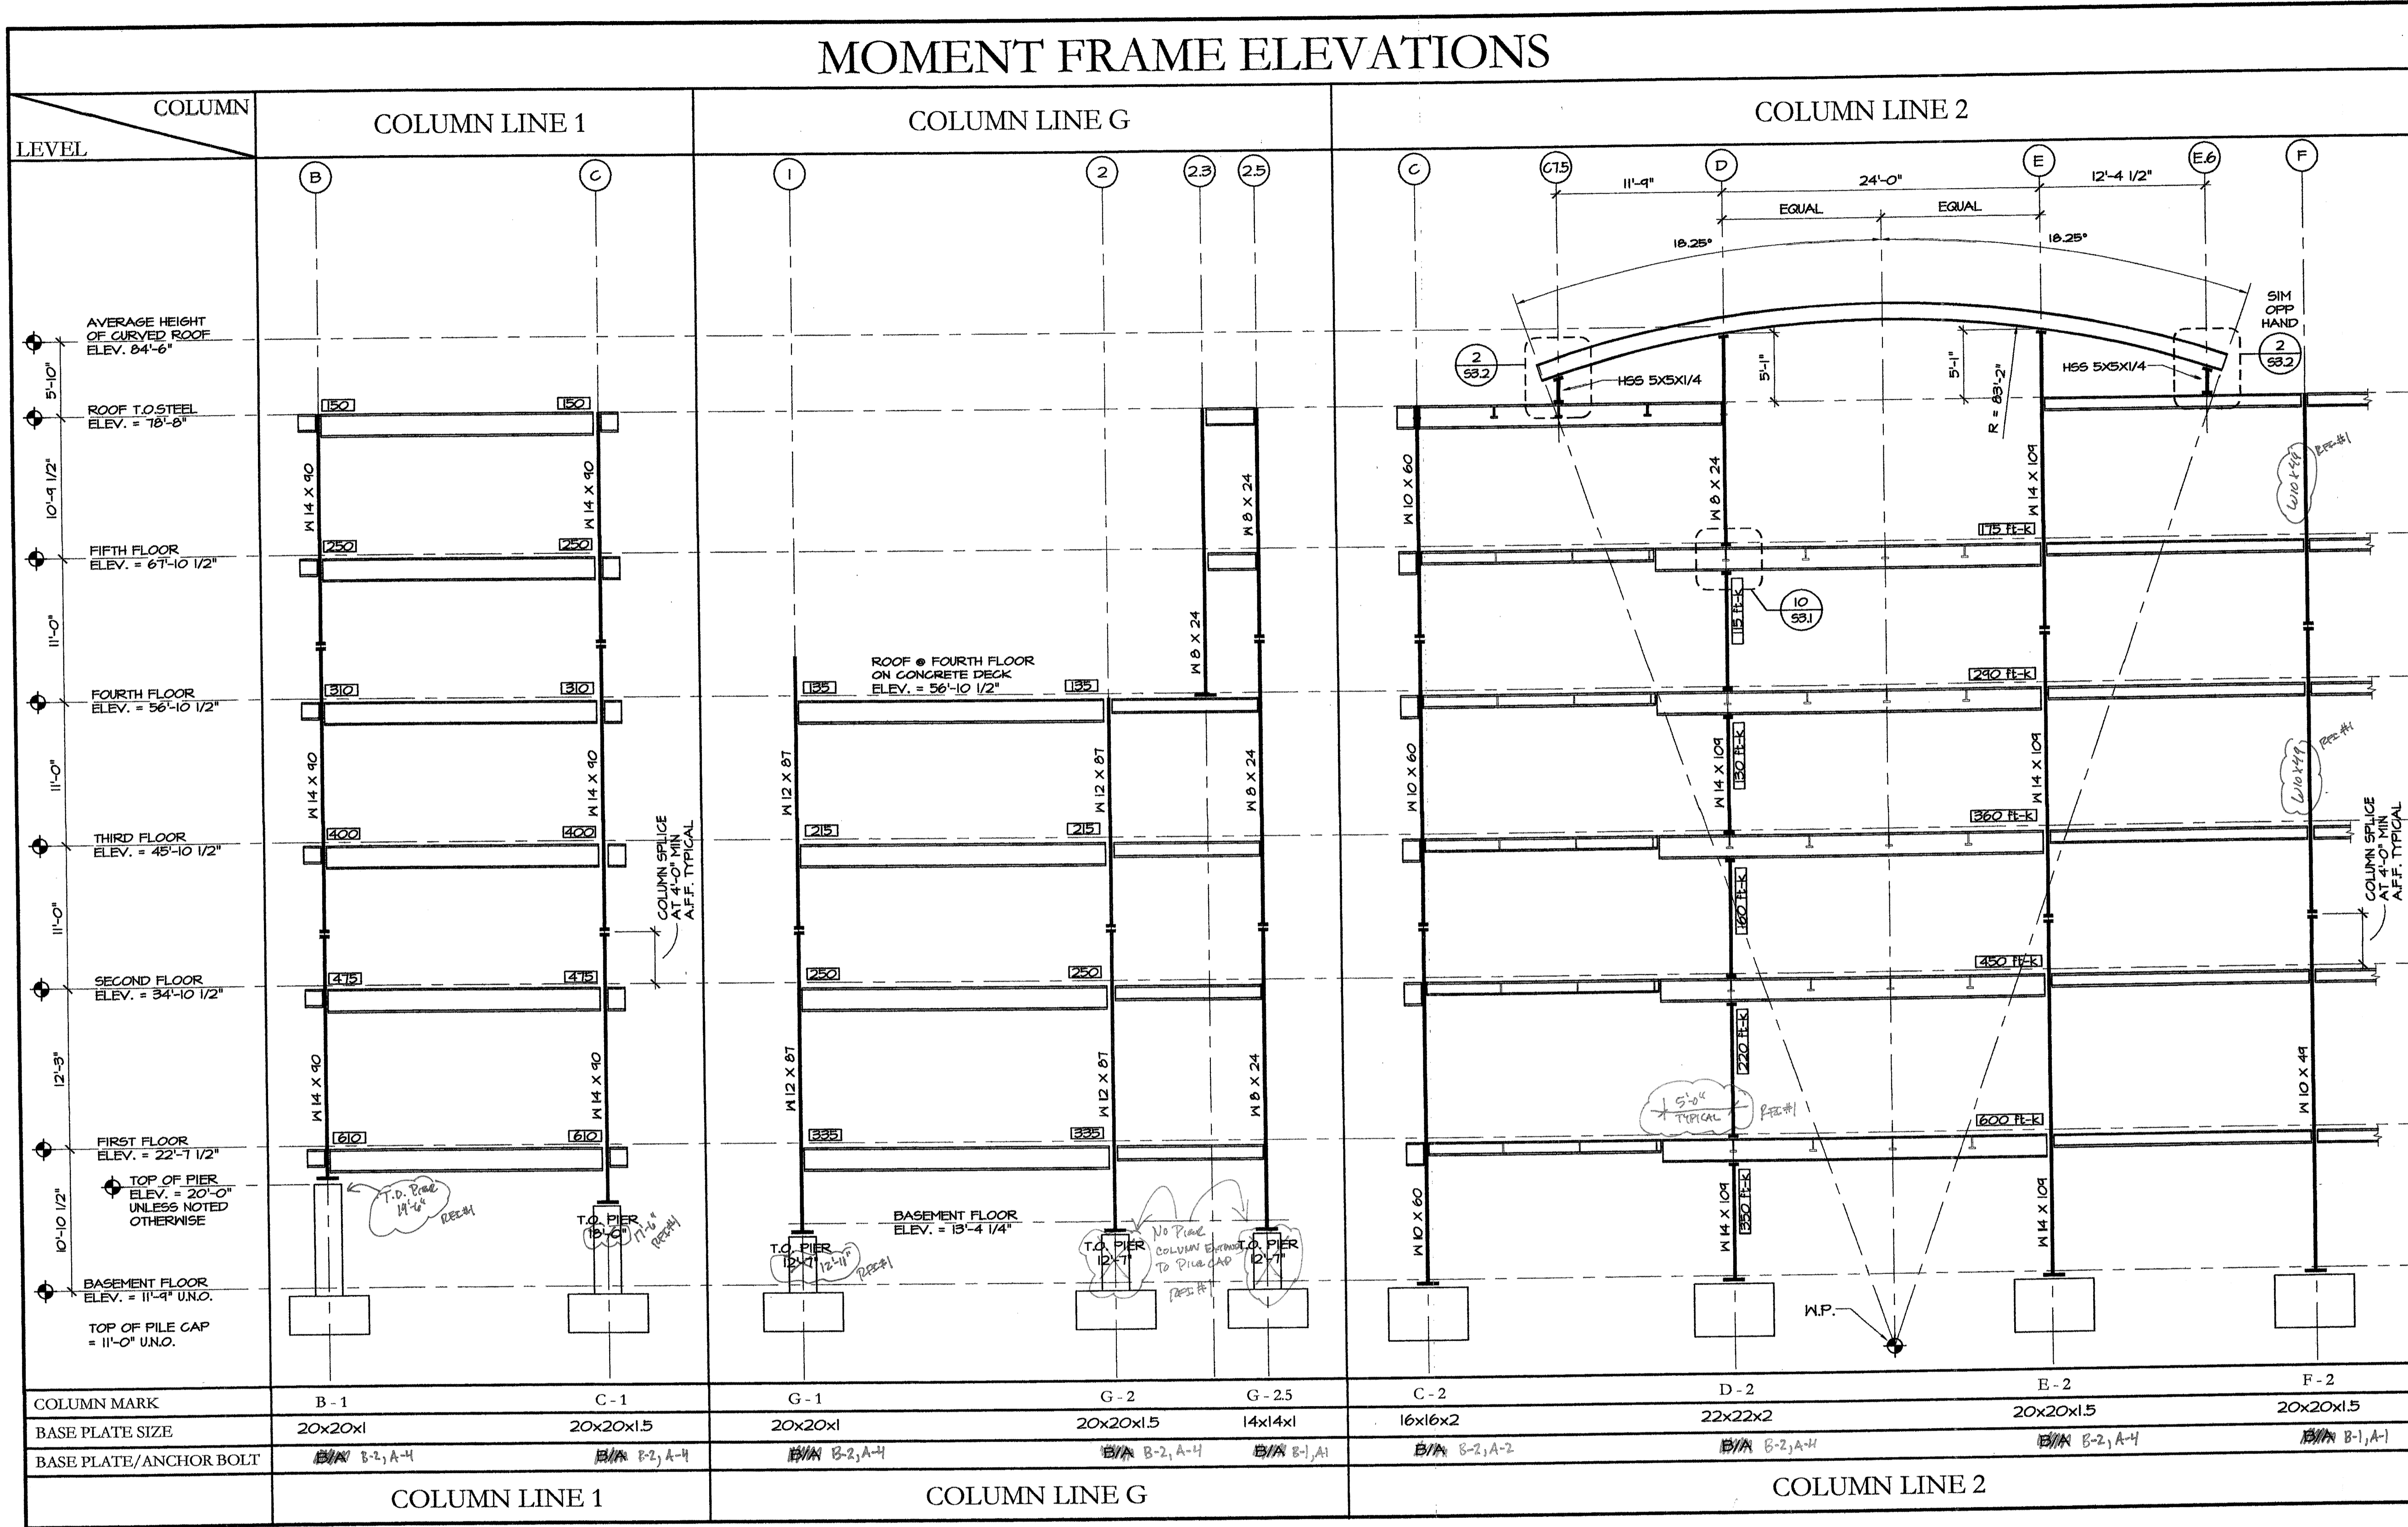

All BASE PLATE/ANCHOR BOLT DESIGNATIONS PER REF.#2

PRO CON
INCORPORATED
Design and Construction Management
ARCHITECTURE
P.O. Box 600, Manchester, NH 03108
603.633.9811 Fax 603.633.7290

ISSUE: 05/26/2006 - ISSUED FOR PRICING

CUSTOM HOUSE SQUARE
300 FORE STREET
PORTLAND, MAINE
MOMENT FRAME ELEVATIONS - 1

NOT FOR CONSTRUCTION
05/26/06

PROJECT ARCHITECT:
MW
DRAWN BY:
ET, AC, SO
PROJECT #:
300506

S4.2

G:\Prod\Year2005\B00506_Custm_House_Square\DWG\C50654.2.dwg