RFI #33

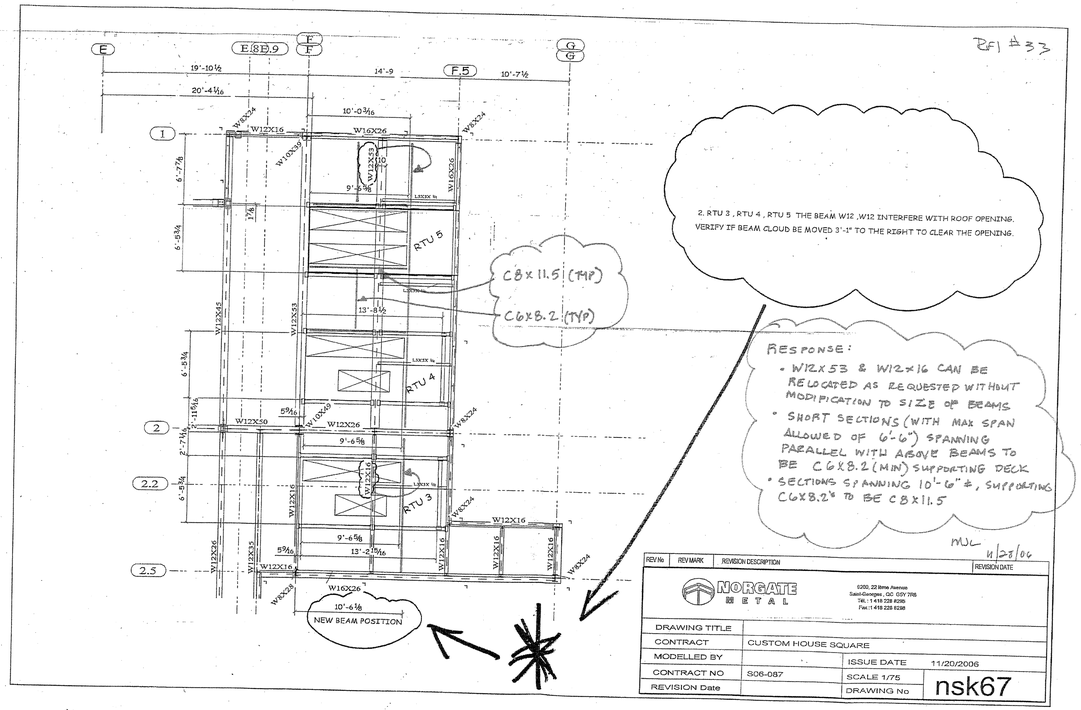

2. RTU 3 , RTU 4 , RTU 5 THE BEAM W12 ,W12 INTERFERE WITH ROOF OPENING.
VERIFY IF BEAM CLOUD BE MOVED 3'-1" TO THE RIGHT TO CLEAR THE OPENING.

RESPONSE:

- W12X53 & W12X16 CAN BE RELOCATED AS REQUESTED WITHOUT MODIFICATION TO SIZE OF BEAMS
- SHORT SECTIONS (WITH MAX SPAN ALLOWED OF 6'-6") SPANNING PARALLEL WITH ABOVE BEAMS TO BE C6X8.2 (MIN) SUPPORTING DECK
- SECTIONS SPANNING 10'-6" ±, SUPPORTING C6X8.2's TO BE C8X11.5

MUL 11/28/06

REV No	REV MARK	REVISION DESCRIPTION	REVISION DATE

NORGATE METAL

6200, 22 Bima Avenue
Saint-Georges, QC G5Y 7R6
Tel.: 1 418 228 8298
Fax.: 1 418 228 8298

DRAWING TITLE			
CONTRACT	CUSTOM HOUSE SQUARE		
MODELLED BY		ISSUE DATE	11/20/2006
CONTRACT NO	S06-087	SCALE 1/75	nsk67
REVISION Date		DRAWING No	