jferzese - Wed, 07 Jun 2006 - 9:49am

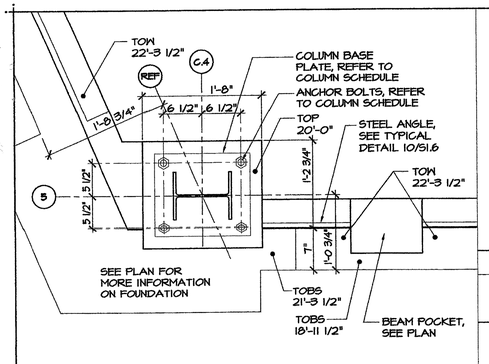

15 PIER DETAIL
SCALE: 1" = 1'-0"

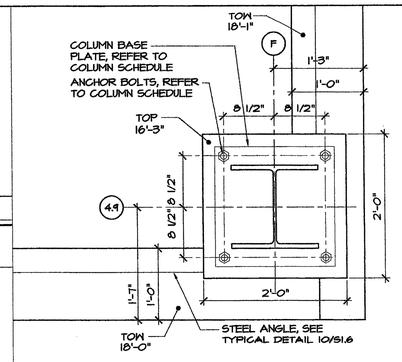

11 PIER DETAIL
SCALE: 1" = 1'-0"

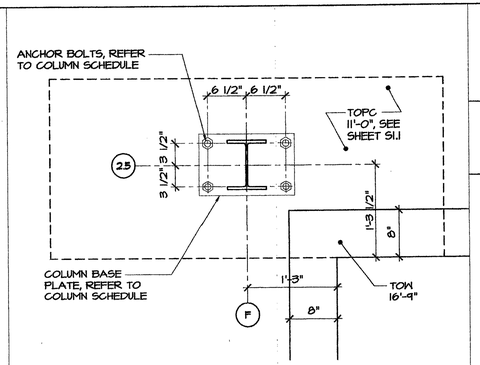

7 PILE CAP DETAIL
SCALE: 1" = 1'-0"

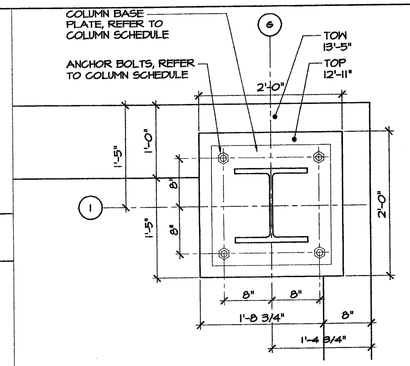

4 PIER DETAIL
SCALE: 1" = 1'-0"

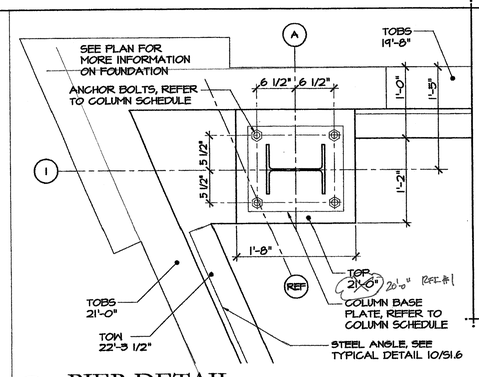

1 PIER DETAIL
SCALE: 1" = 1'-0"

PRO CON INCORPORATED
Design and Construction Management
ARCHITECTURE
A Subchapter S Corporation
P.O. Box 1000, Manchester, NH 03105 procon@ne.com
603.623.8811 Fax: 603.623.7250

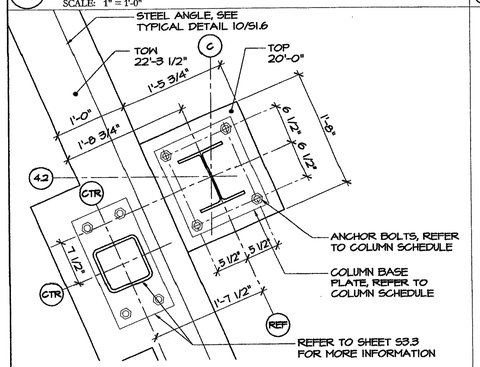

16 PIER DETAIL
SCALE: 1" = 1'-0"

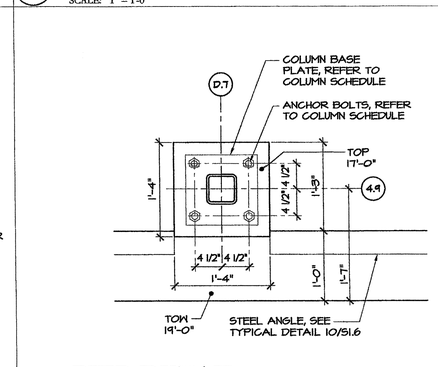

12 PIER DETAIL
SCALE: 1" = 1'-0"

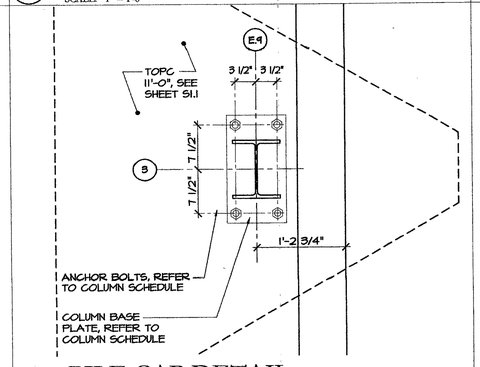

8 PILE CAP DETAIL
SCALE: 1" = 1'-0"

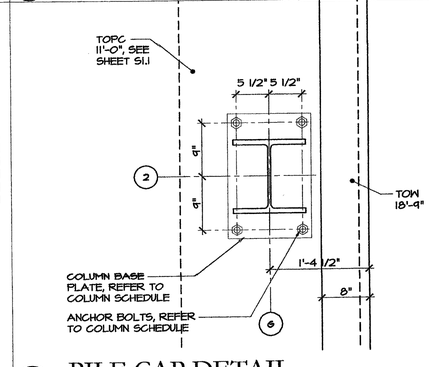

5 PILE CAP DETAIL
SCALE: 1" = 1'-0"

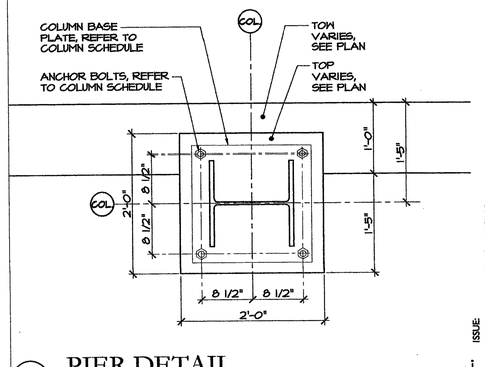

2 PIER DETAIL
SCALE: 1" = 1'-0"

ISSUE:
05/26/2006 - ISSUED FOR PRICING

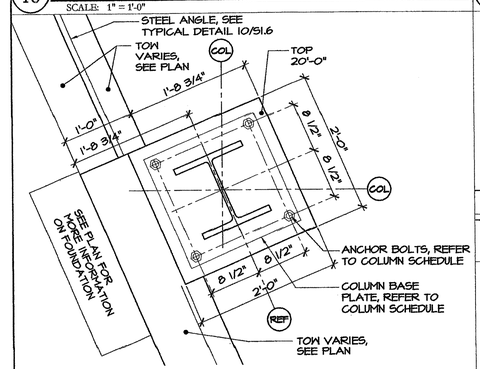

17 PIER DETAIL
SCALE: 1" = 1'-0"

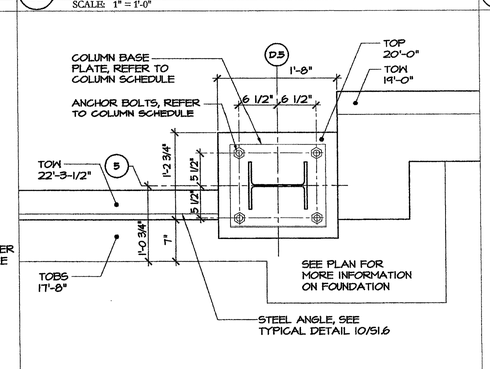

13 PIER DETAIL
SCALE: 1" = 1'-0"

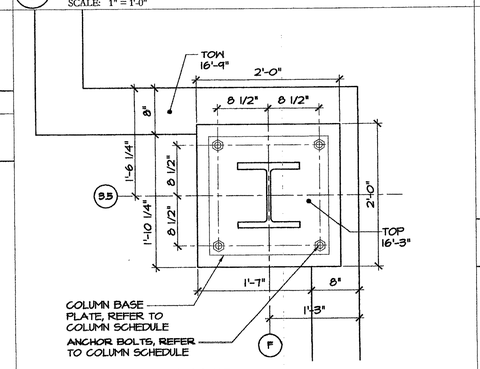

9 PIER DETAIL
SCALE: 1" = 1'-0"

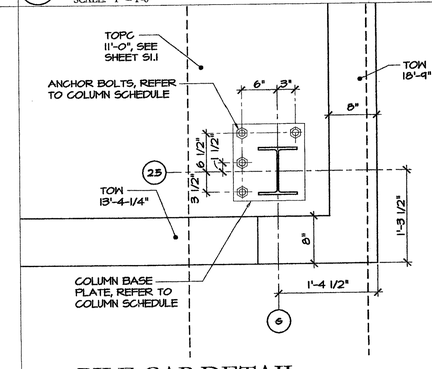

6 PILE CAP DETAIL
SCALE: 1" = 1'-0"

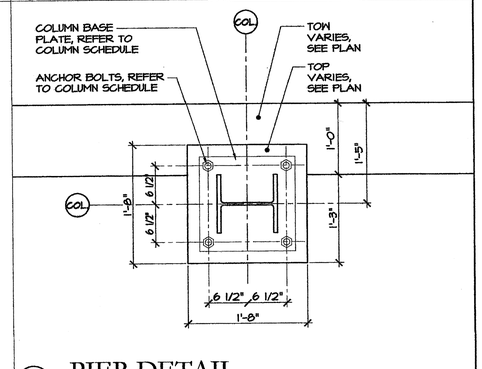

3 PIER DETAIL
SCALE: 1" = 1'-0"

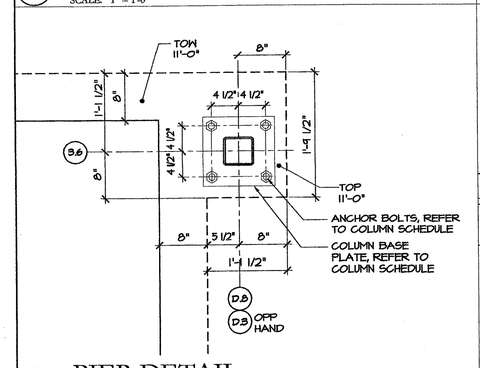

18 PIER DETAIL
SCALE: 1" = 1'-0"

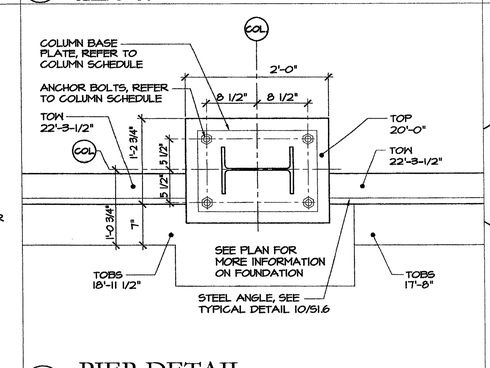

14 PIER DETAIL
SCALE: 1" = 1'-0"

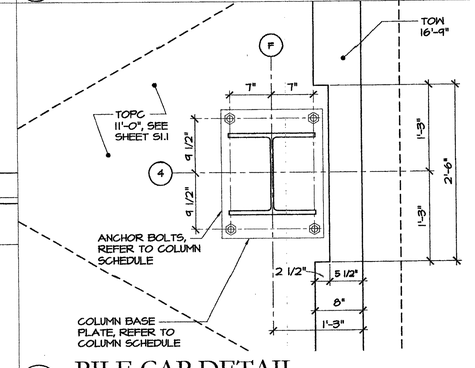

10 PILE CAP DETAIL
SCALE: 1" = 1'-0"

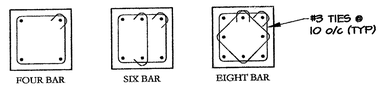

TYPICAL PIER TIE DETAILS
SCALE: N.T.S.

SYMBOLS LEGEND:

TOW XX'-XX"	TOP OF WALL
TOBS XX'-XX"	TOP OF BRICK SHELF
TOP XX'-XX"	TOP OF PIER

NOT FOR CONSTRUCTION
05/26/06

CUSTOM HOUSE SQUARE
300 FORE STREET
PORTLAND, MAINE

BASE PLATE PLAN DETAILS

PROJECT ARCHITECT: MW
DRAWN BY: BR, AC, SO
PROJECT #: 300506

S1.5

DO NOT SCALE DRAWING. USE WRITTEN DIMENSIONS. WHERE NO WRITTEN DIMENSION IS PROVIDED, CONSULT THE ARCHITECT FOR CLARIFICATION BEFORE PROCEEDING WITH THE WORK.
©COPYRIGHT 2006 PRO CON INC

050651.5.dwg

G:\Pro\Year 2005\300506_Custom_House_Square\DWG\050651.5.dwg