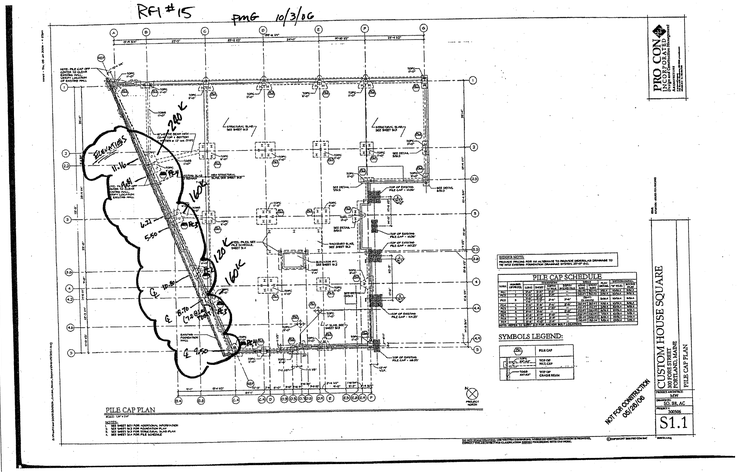

RFI #15

240K -5'-0"x5'-0"x1'-8" w/8-#5 EW BOT

160K 4'-0"x4'-0"x1'-6" w/10-#4 EW BOT

120K 3'-6"x3'-6"x1'-8" w/8-#4 EW BOT

ALL DEPTHS ARE MIN

PMG
10/3/06

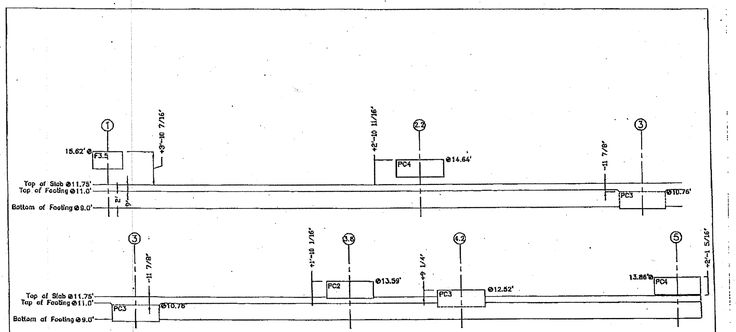

Profile of pilecap elevations along reference line from A/1 to C.4/5

Newman Concrete Services		
CUSTOMER: Wright–Ryan Construction		
DATE: 10/06/06	DRN. BY: AWL	JOB NO.: 06-18
SCALE: NTS	FILE NO.:	REVISIONS:
CONTENTS: Profile of Pilecaps		SHEET 1 OF 1

10/06/2006 14:00 PM 12078222282