

### CONSTRUCTION NOTES:

- A. RECONSTRUCT BRICK SIDEWALK LAY BRICK IN RUNNING BOND PATTERN.

ZONING DISTRICT: B-3  
 PERMITTED USE: OFFICE BUILDING

### SPACE AND BULK REQUIREMENTS:


|                          |          |
|--------------------------|----------|

### LAYOUT TABLE

| ID    | NORTHING   | EASTING    | DESCRIPTION              |
|-------|------------|------------|--------------------------|

### CURBING LEGEND

- TYPE 1 VERTICAL GRANITE CURB
- 7' TYPICAL
- FULL DEPTH RECONSTRUCTION
- SPECIAL CUSTOM HOUSE STREET RECONSTRUCTION


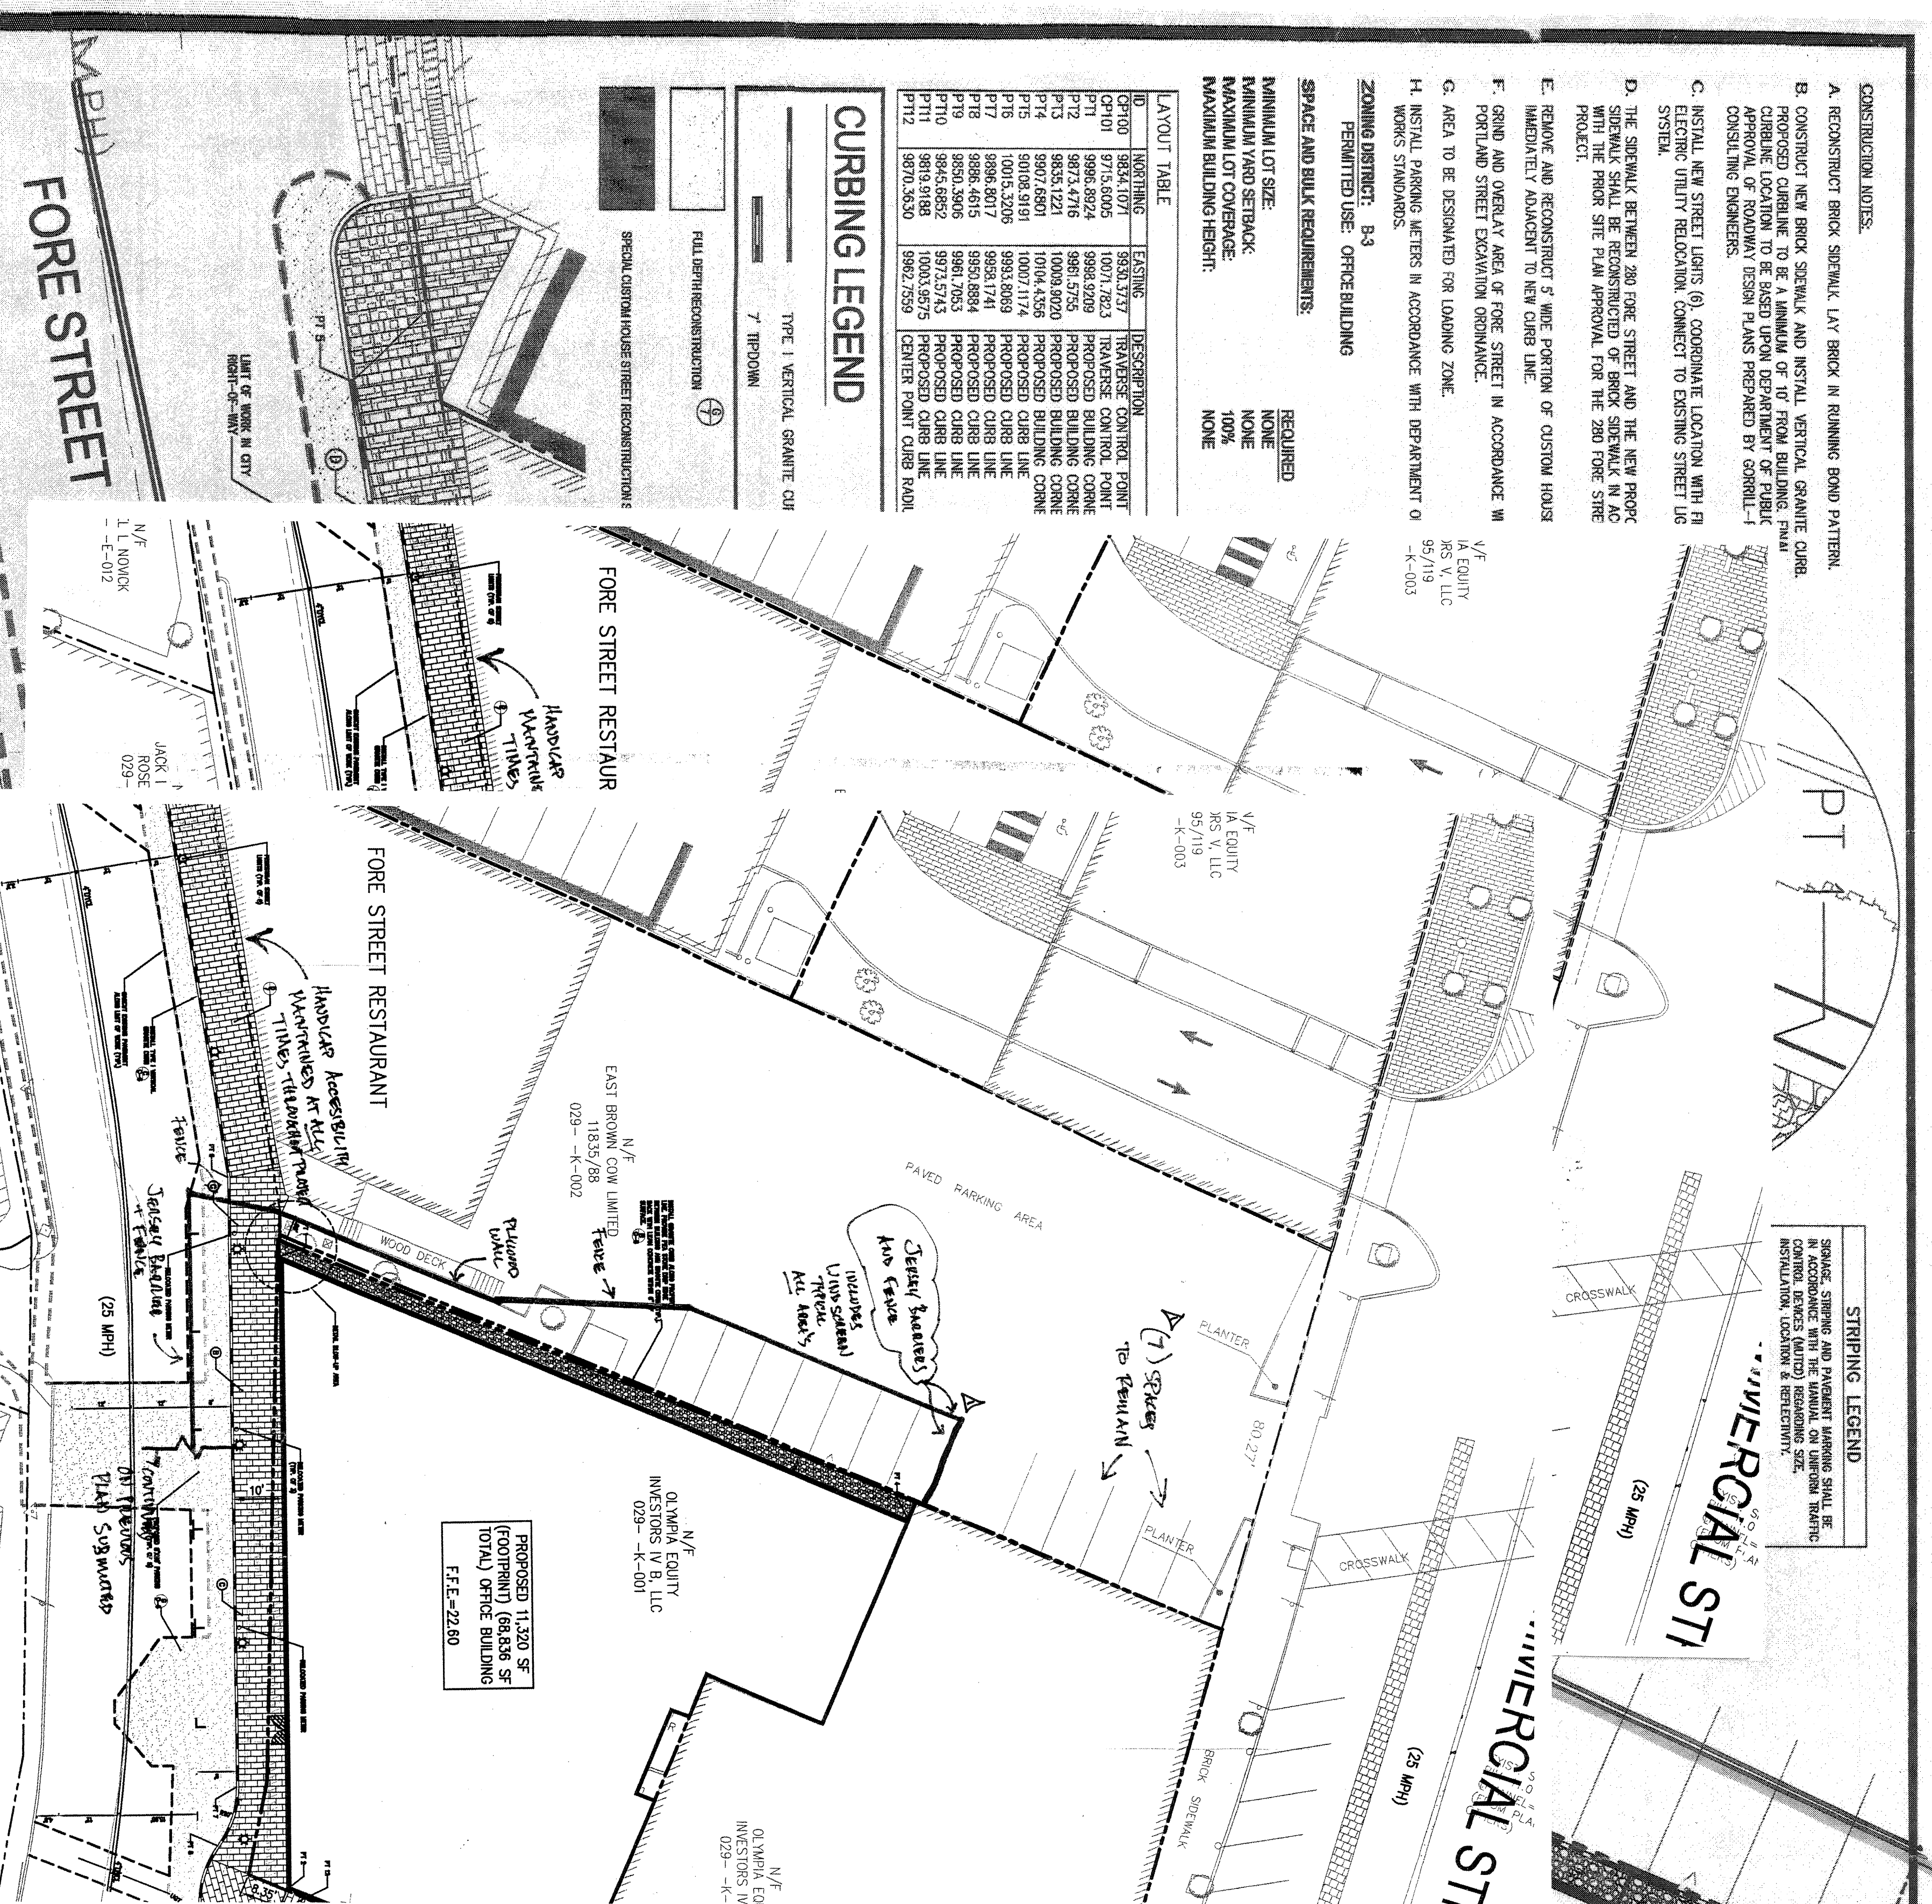


#### STRIPING LEGEND


PROPOSED 11,320 SF  
 (FOOTPRINT) (68,836 SF  
 TOTAL) OFFICE BUILDING  
 F.F.E.=22.60

*Address for utility*

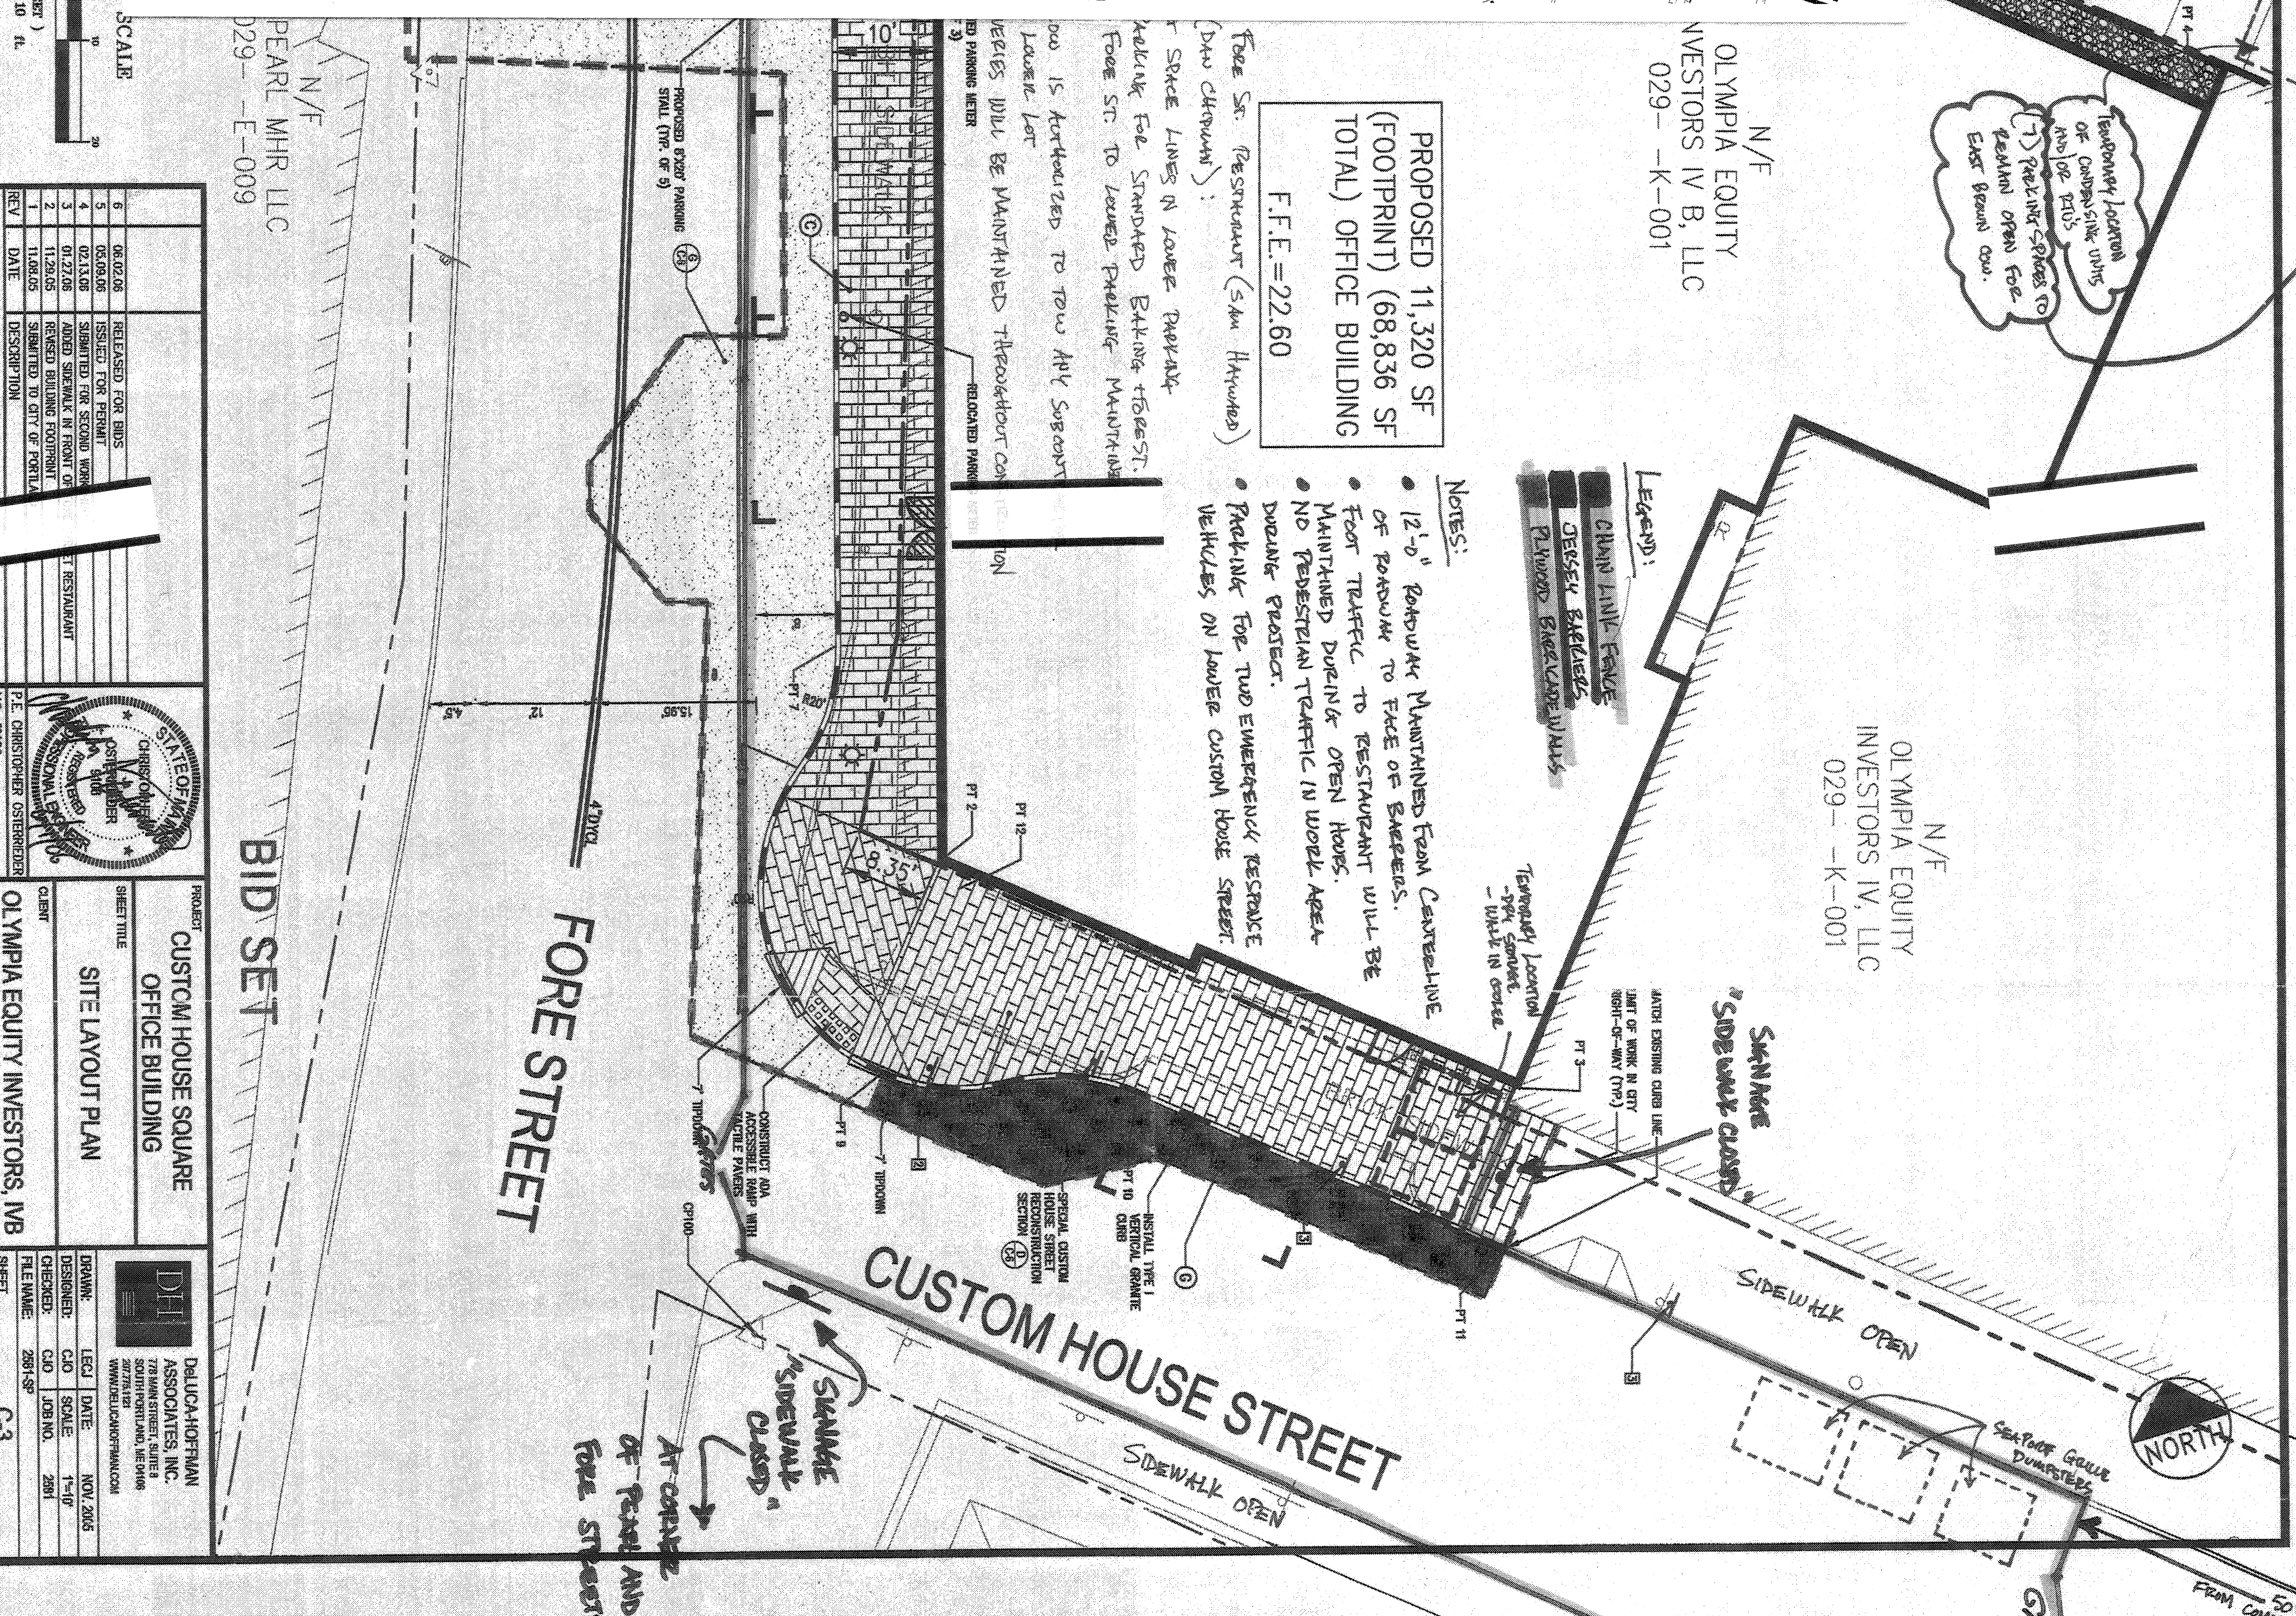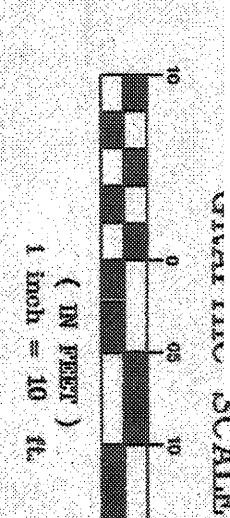

PROPOSED 11,320 SF  
 (FOOTPRINT) (68,836 SF  
 TOTAL) OFFICE BUILDING  
 F.F.E.=22.60

- Notes:

#### REVISIONS

| REV | DATE     | DESCRIPTION                           |
|-----|----------|---------------------------------------|



**BID SET**  
 PROJECT: CUSTOM HOUSE SQUARE  
 OFFICE BUILDING  
 SHEET TITLE: SITE LAYOUT PLAN  
 CLIENT: OLYMPIA EQUITY INVESTORS, INC.

|            |             |          |
|------------|-------------|----------|
| SHEET:     |             | C-3      |