NOTE:

1. SEE SHEET E-001 FOR LEGEND AND GENERAL NOTES.

KEYED NOTE:

1. EXISTING STAIR LIGHTING TO REMAIN, MODIFY LOCATIONS IF REQUIRED FOR INSTALLATION OF NEW DOORS.
2. EXTERIOR LIGHTING TO BE CONTROLLED BY A SINGLE PHOTOCELL MOUNTED TO EXTERIOR OF BUILDING.

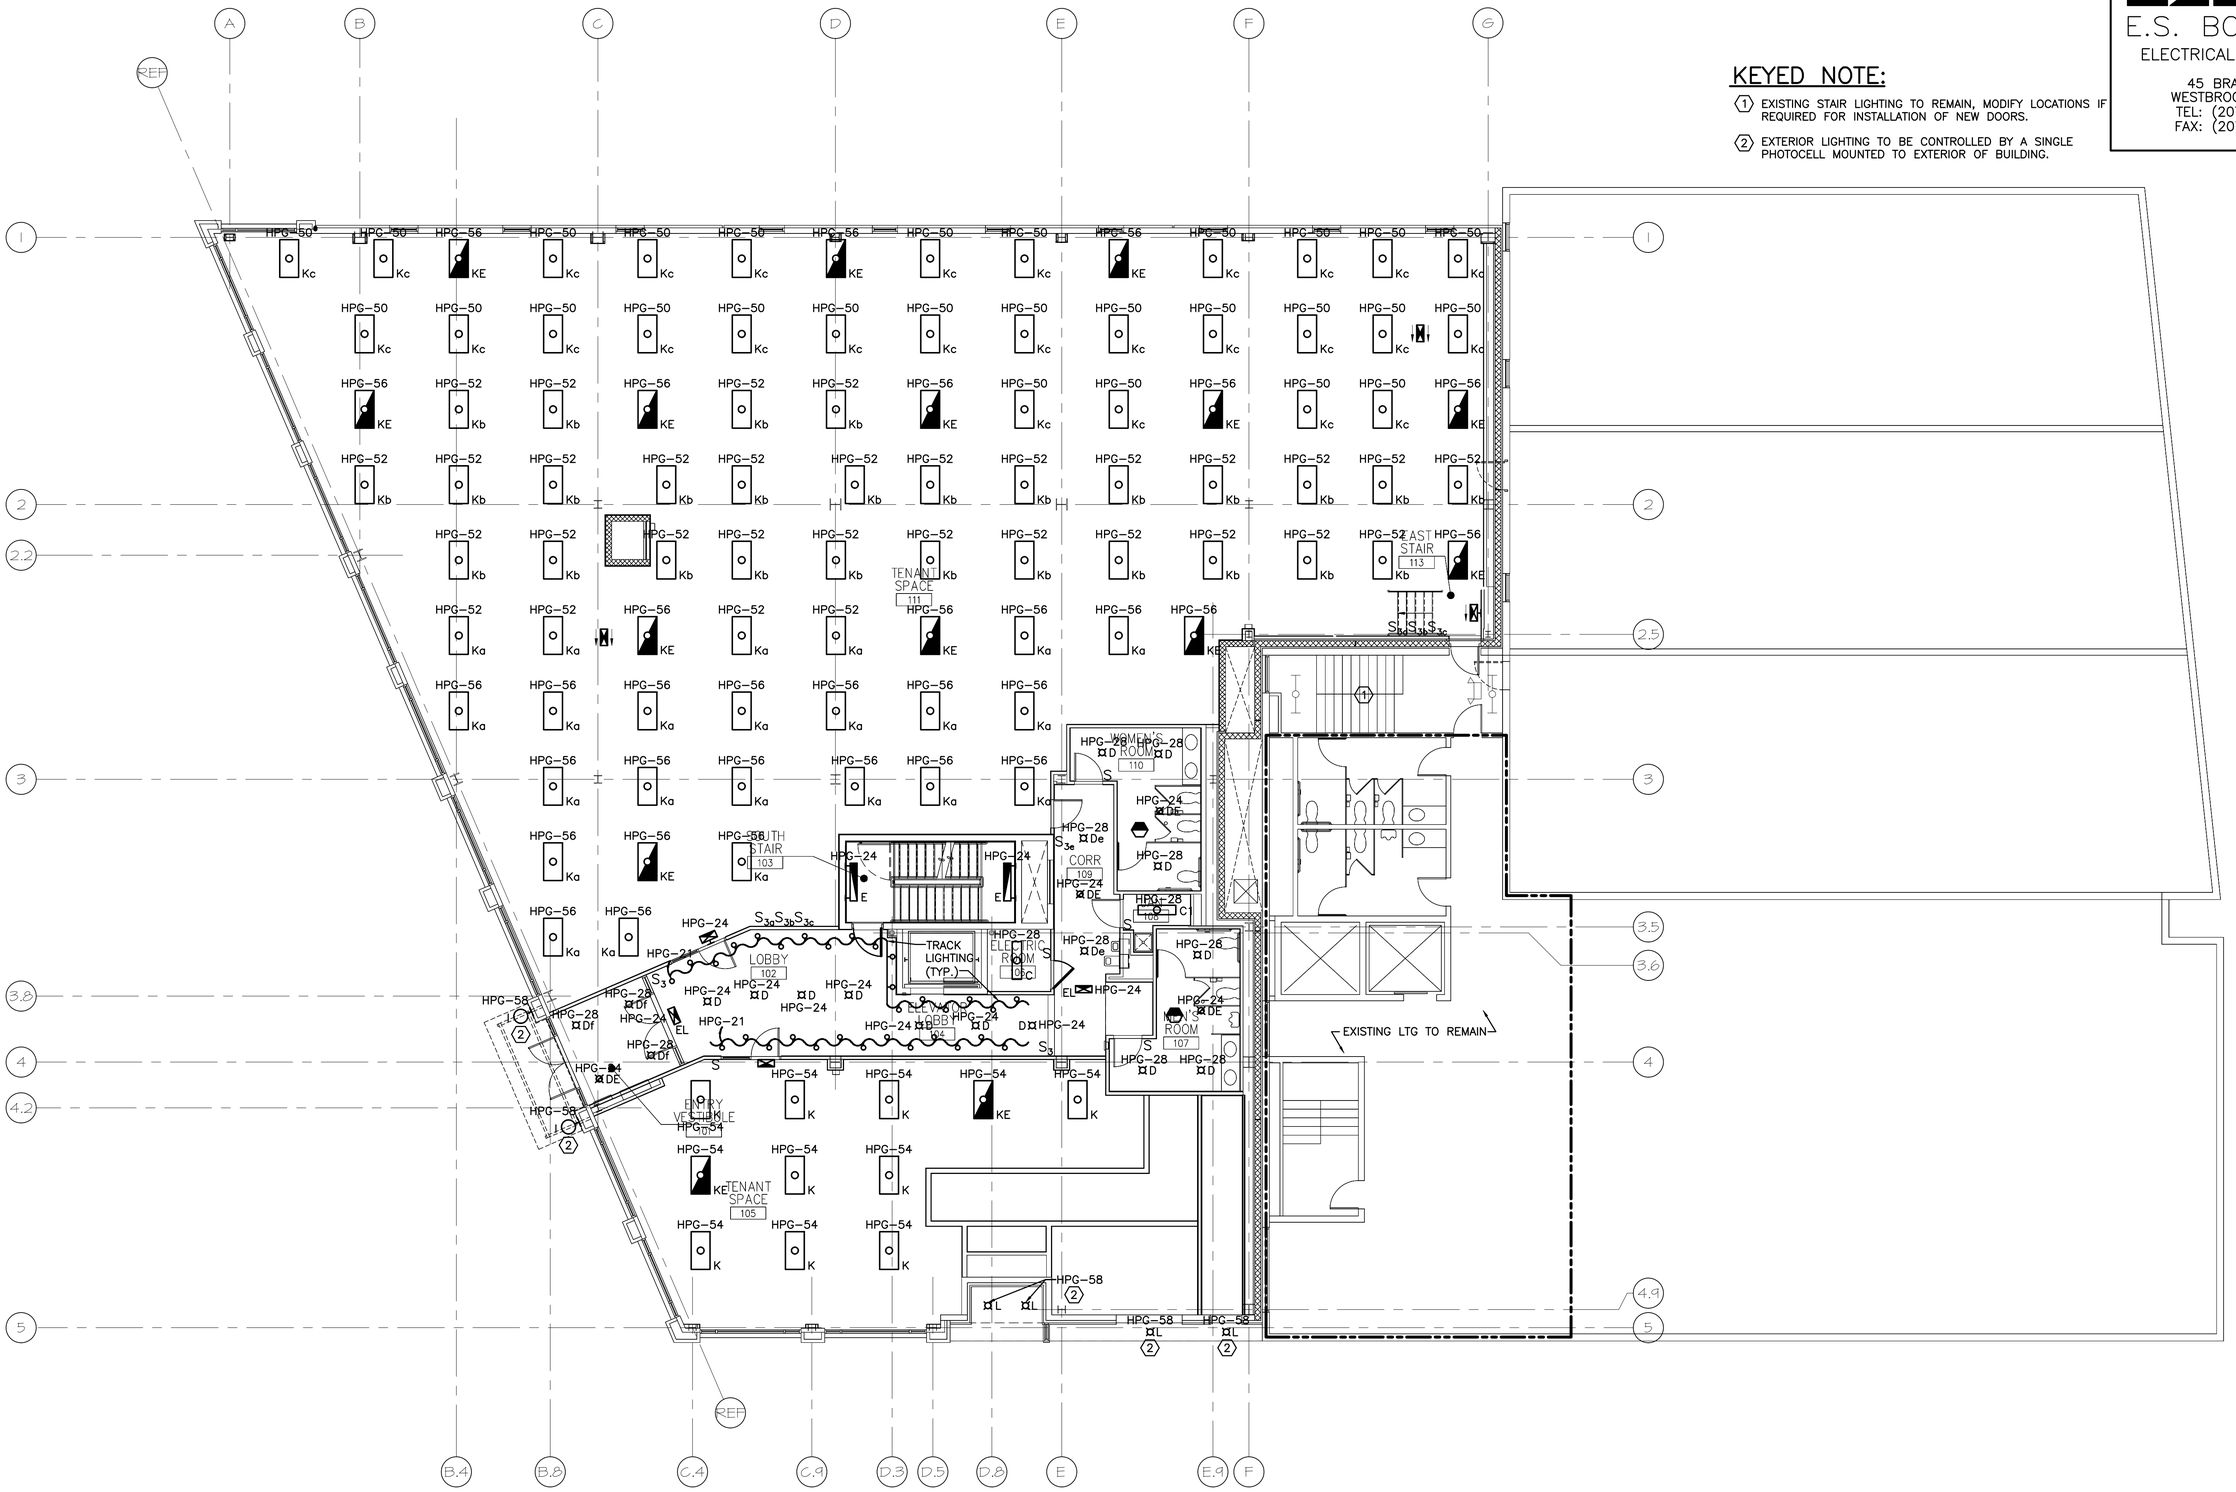

ESB
E.S. BOULOS CO
ELECTRICAL CONTRACTORS
45 BRADLEY DRIVE
WESTBROOK, ME 04092
TEL: (207) 464-3706
FAX: (207) 464-1833

SMRT
ARCHITECTURE ENGINEERING PLANNING
SMRT
144 Fore Street/P.O. Box 618
Portland, Maine 04104
tel. (207) 772-3846
fax. (207) 772-1070

PROJECT TITLE: CUSTOM HOUSE SQUARE
FORE STREET
PORTLAND, MAINE

CURRENT ISSUE STATUS: RECORD DRAWINGS 9-19-07

REV	DESCRIPTION	DATE
2	RECORD DRAWINGS	9-19-07
1	ISSUED FOR REVISION	3-5-07
0	ISSUED FOR CONSTRUCTION	12-20-06

GRAPHIC SCALE: 0" 1"

SCALE:	AS NOTED
PROJECT MANAGER:	DJT
JC/DRAWN BY:	CDS
A/E OF RECORD:	DJT
CAD FILE:	EL102-06068
PROJECT NO:	06068
DATE:	12-20-06

SHEET TITLE: FIRST FLOOR LIGHTING PLAN

SHEET No. EL102

© COPYRIGHT 2005 SMRT, INC.

A1 FIRST FLOOR PLAN

1/8"=1'-0"