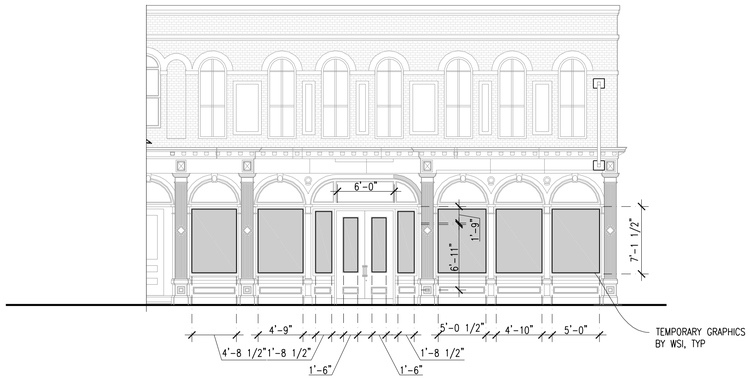

D1 EXTERIOR ELEVATION – WEST

1/8"=1'-0"

0 4' 8' 16'

TEMPORARY GRAPHICS ARE APPLIED TO THE iINSIDE OF THE WINDOWS DURING CONSTRUCITON. THEY INDICATE THE SOON TO BE OPEN WEST ELM STORE, SHOW IMAGES OF PRODUCT ETC AND SERVE TO SCREEN THE INTERIOR CONSTRUTION FROM PUBLC VIEW. THEY ARE REMOVED PRIOR TO STORE OPENING.

Please clarify what is meant by temporary graphics.

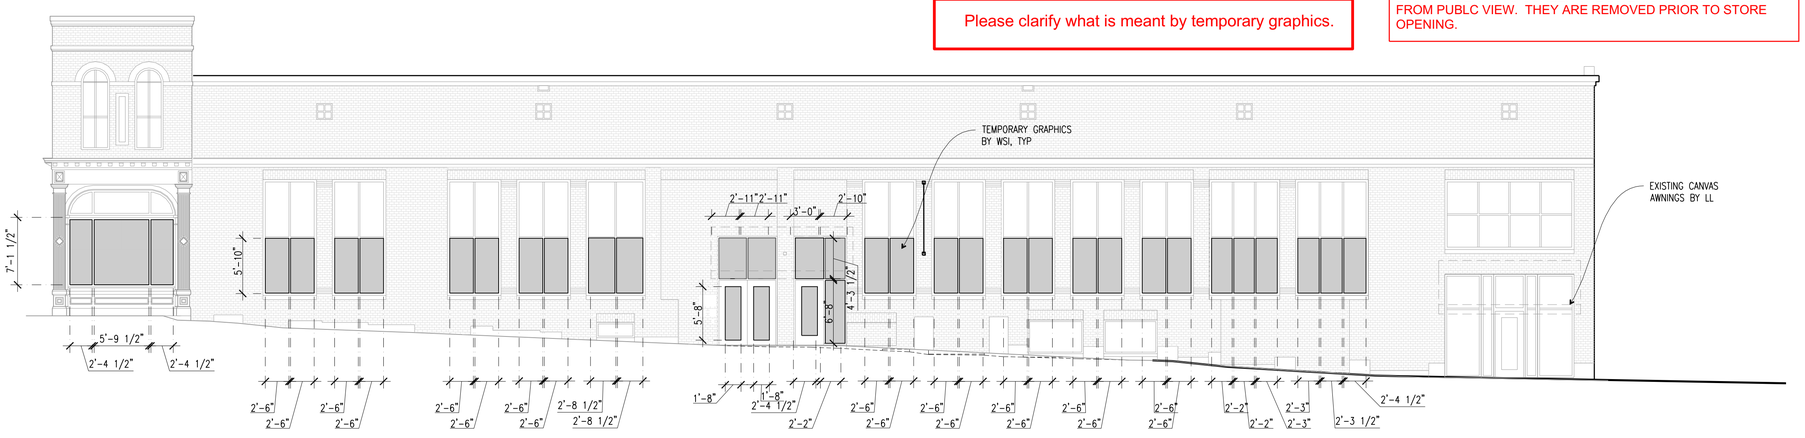

A1 EXTERIOR ELEVATION – SOUTH

1/8"=1'-0"

0 4' 8' 16'

NOTE: ALL WINDOW DIMENSIONS TO BE VERIFIED BY GRAPHICS VENDOR

OWNER:
WILLIAMS-SONOMA, INC.
3250 Van Ness Avenue
San Francisco, CA 94
T 415 616 8602
F 415 439 8164
www.williams-sonomain

Reviewed for Code Compliance
Approved Building Inspector
Date: 04/26/17

LICENSED ARCHITECT
TODD K. TENOKI
No. 4417
STATE OF MAINE

CALLISONRTKL™
A DESIGN CONSULTANCY OF ARCADIS
CALLISONRTKL, INC.
www.callisonrtkl.com

west elm

Downtown Portland

164 Middle Street
Portland, ME 04101

PROJECT #006-160335.00

ISSUED / REVISED	DATE
PRELIMINARY SET	09/08/16
LL COORDINATION SET	11/08/16
LL/PERMIT SET	11/21/16

TEMPORARY STORE OPENING GRAPHICS

A-010

COPYRIGHT © 2016 CallisonRTKL Inc.