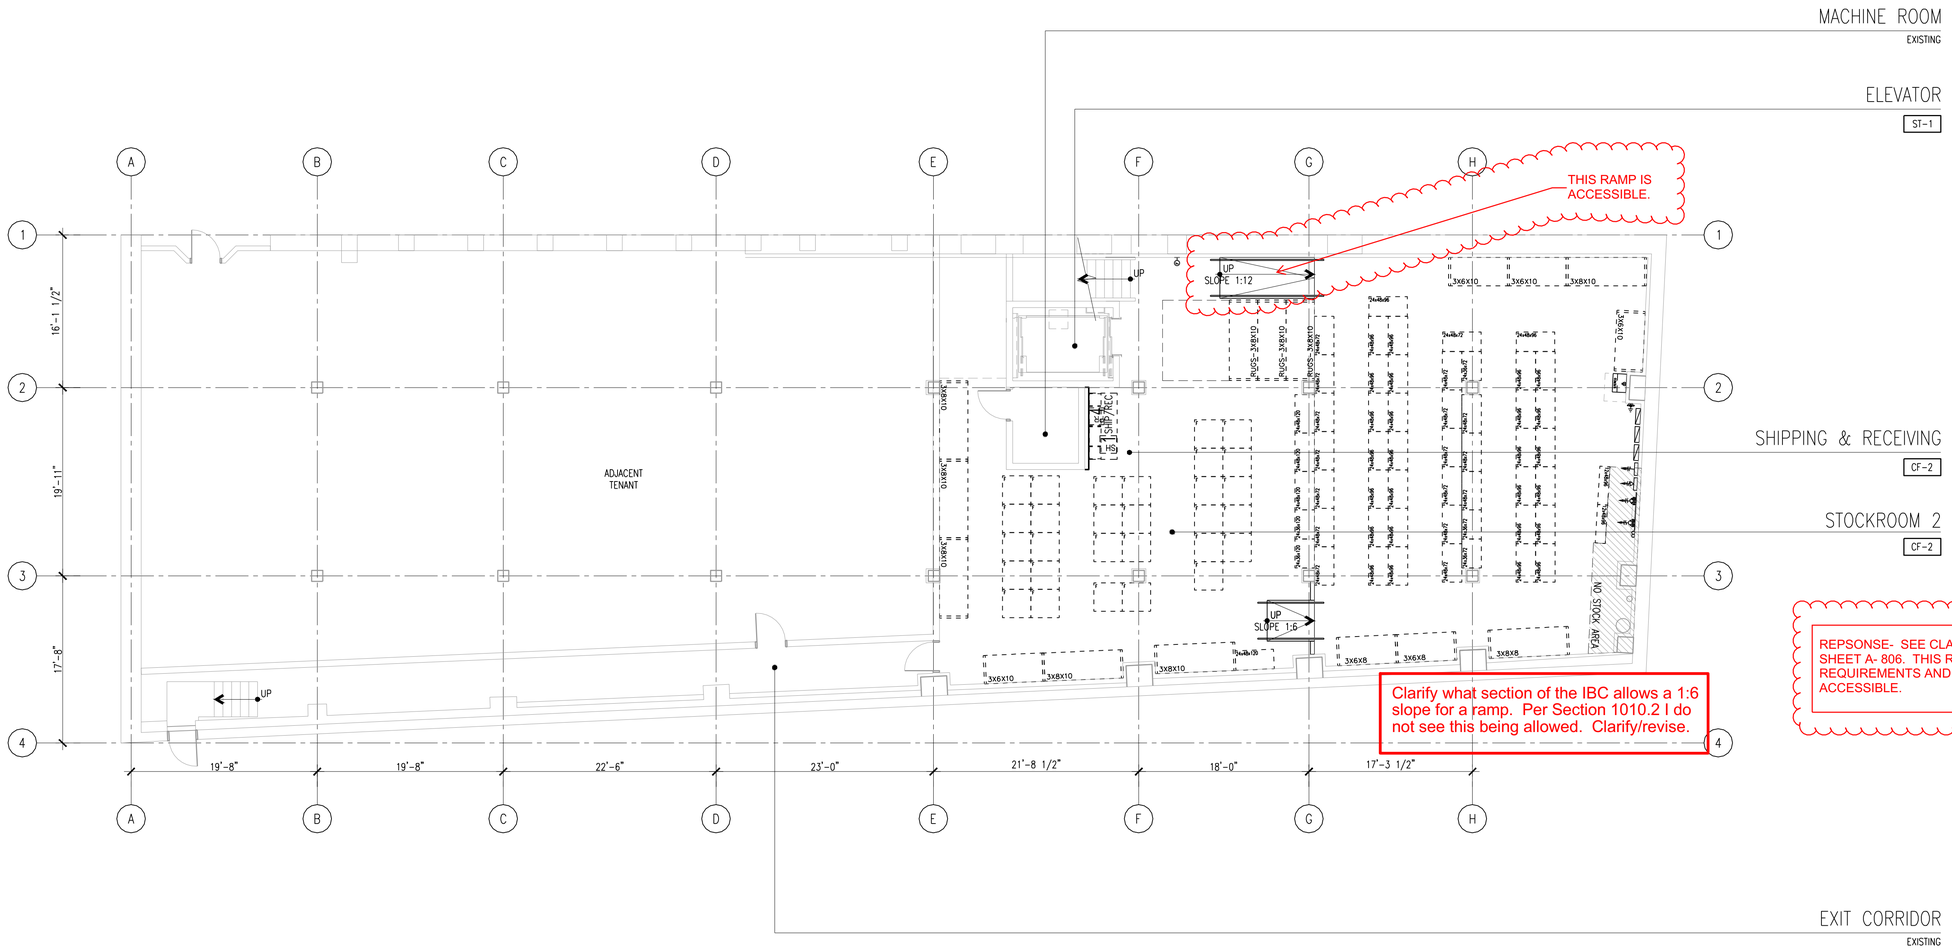

REPSONSE- SEE CLARIFICATION ON SHEET A- 806. THIS RAMP MEETS OSHA REQUIREMENTS AND IS NOT PUBLIC ACCESSIBLE.

A1 OVERALL BASEMENT/FINISH PLAN

1/8"=1'-0"

0 4' 8' 16'

PROJECT NORTH

OWNER:
WILLIAMS-SONOMA, INC.
3250 Van Ness Avenue
San Francisco, CA 94
T 415 616 8602
F 415 439 8164
www.williams-sonomair

Reviewed for Code Compliance
Approved as Noted
Approved as Noted Subject to Field Inspection
Date: 04/26/17

LICENSED ARCHITECT
TODD K. KENOKI
STATE OF MAINE

CALLISONRTKL™
A DESIGN CONSULTANCY OF ARCADIS
CALLISONRTKL, INC.
www.callisonrtkl.com

west elm
Dowtown Portland
164 Middle Street
Portland, ME 04101
PROJECT #006-160335.00

ISSUED / REVISED	DATE
PRELIMINARY SET	09/08/16
LL COORDINATION SET	11/08/16
LL/PERMIT SET	11/21/16

OVERALL BASEMENT / FINISH PLAN

A-120

COPYRIGHT © 2016 CallisonRTKL Inc.