COPYRIGHT: Reuse or reproduction of the contents of this document is not permitted without written permission of Bild Architecture LLC

IBC OCCUPANCY CALCULATION			
OCCUPANCY LOAD	TOTAL SQUARE FOOTAGE	FLOOR AREA IN SF PER OCCUPANT	TOTAL OCCUPANTS
STANDING SPACE	1284 SF	5 NET	257
UN-CONCENTRATED ASSEMBLY SPACE	94 SF	15 NET	7
BUSINESS AREA	404 SF	100 GROSS	5
KITCHENS	267 SF	200 GROSS	2
PLATFORM	303 SF	15 NET	21
MERCANTILE	47 SF	60 GROSS	1
STORAGE	239 SF	300 GROSS	1
TOTAL OCCUPANCY			294

NFPA OCCUPANCY CALCULATION			
OCCUPANCY LOAD	TOTAL SQUARE FOOTAGE	FLOOR AREA IN SF PER OCCUPANT	TOTAL OCCUPANTS
CONCENTRATED ASSEMBLY	1284	5 NET ALLOWED	257
UN-CONCENTRATED ASSEMBLY SPACE	94 SF	15 NET	7
BUSINESS	404 SF	100 GROSS	5
KITCHENS	267 SF	100 GROSS	3
STAGES	303 SF	15 NET	21
STORAGE	239 SF	500 GROSS	1
MERCANTILE	47 SF	30 NET	2
TOTAL OCCUPANCY			296

KEY

- EMERGENCY LIGHTING
- EXIT SIGN
- EXIT DISCHARGE
- CONCRETE BLOCK WALL
- 2 HOUR RATED STICK FRAME WALL
- 2 HOUR RATED FLOOR ASSEMBLY (UL-L505 ASSEMBLY)

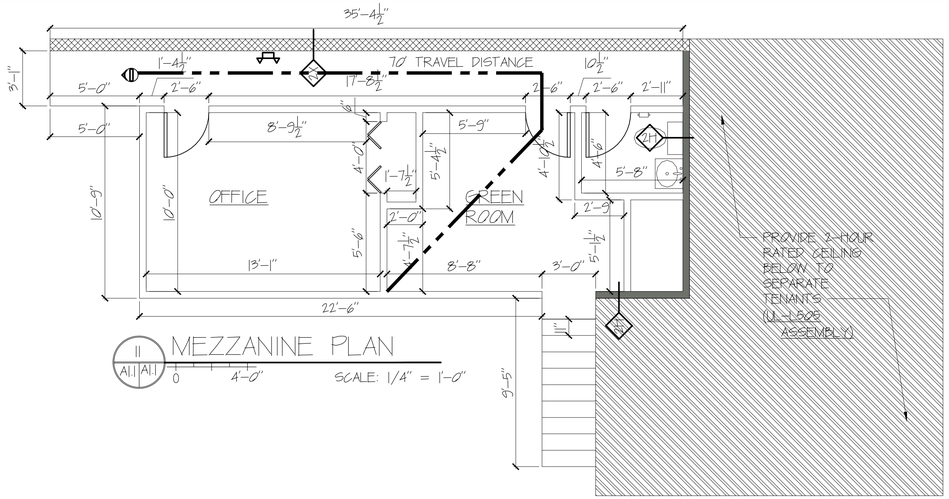

II A1.1 | A1.1 MEZZANINE PLAN
0 4'-0" SCALE: 1/4" = 1'-0"

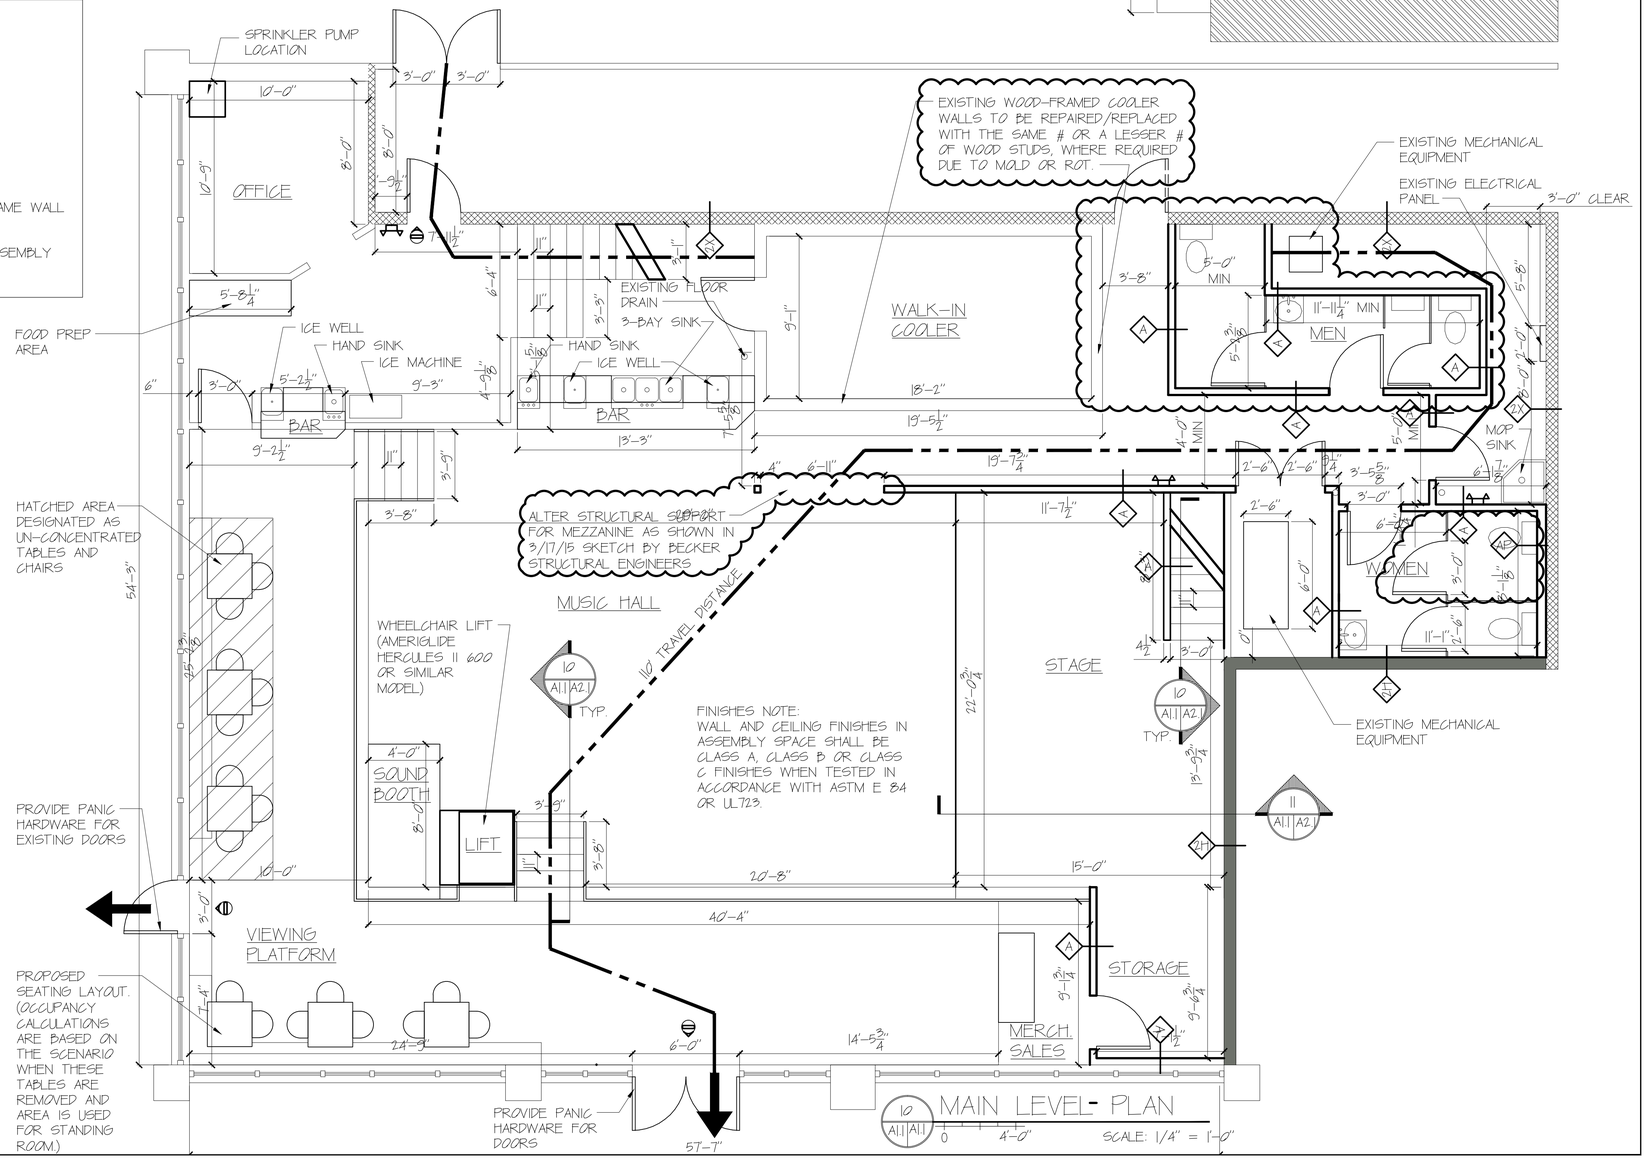

10 A1.1 | A1.1 MAIN LEVEL- PLAN
0 4'-0" SCALE: 1/4" = 1'-0"

Bild Architecture
PO Box 8235
Portland, ME
04104
207.408.0168
evan@bildarchitecture.com

bild ARCHITECTURE

LICENSED ARCHITECT
EVAN A. CARROLL
No. 3887
STATE OF MAINE
11/21/14

PROJECT NO. 14034
PROJECT NAME TEMPLE STREET MUSIC VENUE

REVISIONS
1 | 01/23/15
2 | 01/30/15
3 | 02/04/15
4 | 03/23/15
5 | -

PERMITTING DOCUMENTS

PROPOSED PLAN

DRAWN BY EAC
SHEET TITLE

ISSUE DATE 11/21/14
SHEET SCALE 1/4" = 1'-0"

A
1.1