



Sign Schedule

Existing Sign Inventory		Proposed Sign Inventory					
#	Qty	Description	RC#	#	Qty	Sign Code	Description
1	1	Pylon	017680	1	1	REFACE PYLON	Reface Pylon
2	1	D/F Blade Sign	017680	2	1	REFACE BLADE	Reface D/F Blade Sign
3	1	Wall Plaque	017680	3	1	EWP-24x24	Exterior Wall Plaque
4	1	Wall Plaque	017680	4	1	EWP-24x24	Exterior Wall Plaque
5	1	Brass Wall Plaque	017680	5	1	IWP-9x38-BRA	Interior Brass Wall Plaque

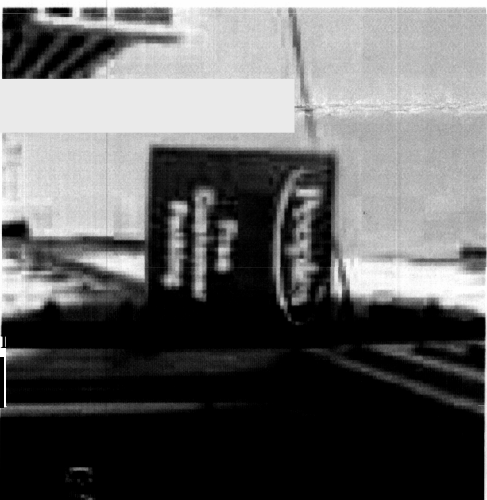


Existing Blade-36" x 36" =

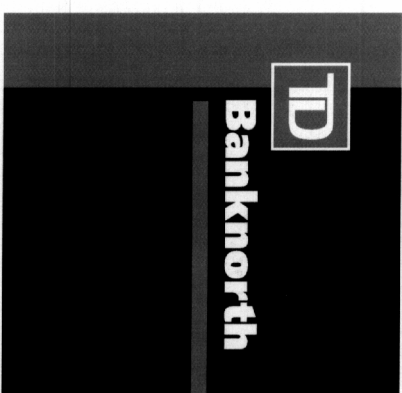


2 Blade Reface

NOTES
Plex face with applied 3M Scotchlcal #VQ-10019 Dk green vinyl background, applied 3M Scotchlcal #VQ-10018 light green vinyl rule line, 3M Scotchlcal 3650-10 trans white vinyl.

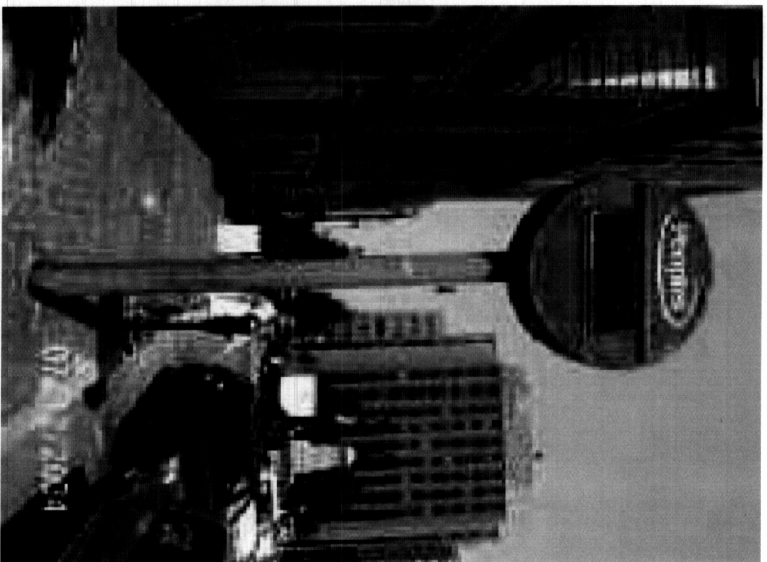

Existing Pylon-36" x 36"

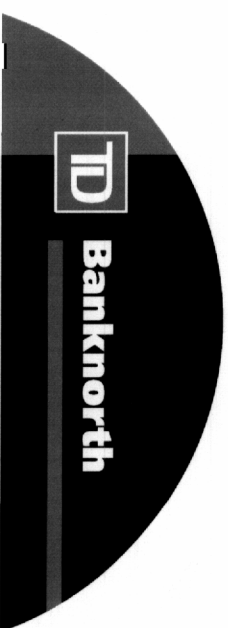


1 Reface Pylon


NOTES
Plex face with applied Scotchlcal # VQ-10019 Dk Green vinyl background with applied white and VQ-10018 light green vinyl graphics.



Existing Signs 11" x 19"

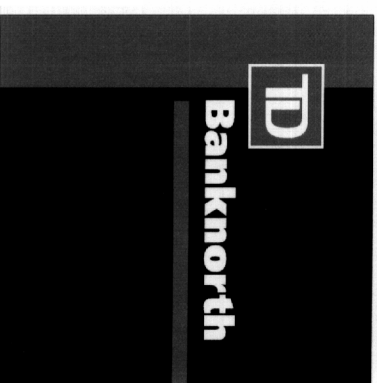

Ext Wall Plaque - EWP-24x24

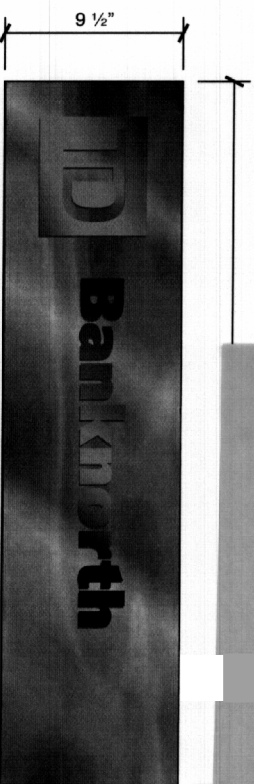

5 Brass Wall Plaque - IWP-9x38-BRA

NOTES
Brushed Brass Face with Polished brass F.C.O logo.

This one looks larger than existing does it fit w/curse? narrow course?



Existing Sign 30" x 38"

Customer Review:

- Approved as submitted
- Approved as noted
- See Notes - Resubmit Drawing for Review and Approval

INITIAL
HERE

NAME _____ DATE _____

THIS IS AN ORIGINAL, UNPUBLISHED DRAWING CREATED BY NW SIGN INDUSTRIES, INC. IT IS PROVIDED FOR THE EXCLUSIVE USE BY THE CUSTOMER AND FOR THE PROJECT NAMED IN THIS TITLE BLOCK. IT SHALL NOT BE PROVIDED TO ANY OTHER SIGN MANUFACTURER OR USED FOR ANY OTHER PROJECT WITHOUT THE WRITTEN PERMISSION OF NW SIGN INDUSTRIES, INC. THIS DRAWING IS AN INSTRUMENT OF SERVICE AND SHALL REMAIN THE EXCLUSIVE PROPERTY OF NW SIGN INDUSTRIES, INC. © NW SIGN INDUSTRIES, INC. 2005

REVISION	DATE
Bl/revise layout of Pylon	6-7-05mlh

NW SIGN INDUSTRIES
of New Jersey
360 CRIDER AVENUE
MOORESTOWN, NJ 08057
(856) 802-1677 • fax: (856) 802-0412



CUSTOMER: **ID Banknorth**
ADDRESS: 477-481 Congress Street
Portland, ME
SITE #: 017680
5-13-05
FILE NAME: 07380-06-475 ID Banknorth 477-481 Congress Street Portland, ME
SALES REP: **DOH**
DESIGNER: **mg**
DRAWING NUMBER: **05-475-1**
PAGE 1 OF 1