PROJECT NORTH

o PROPOSED Stair Width REVISION — 5/11/16

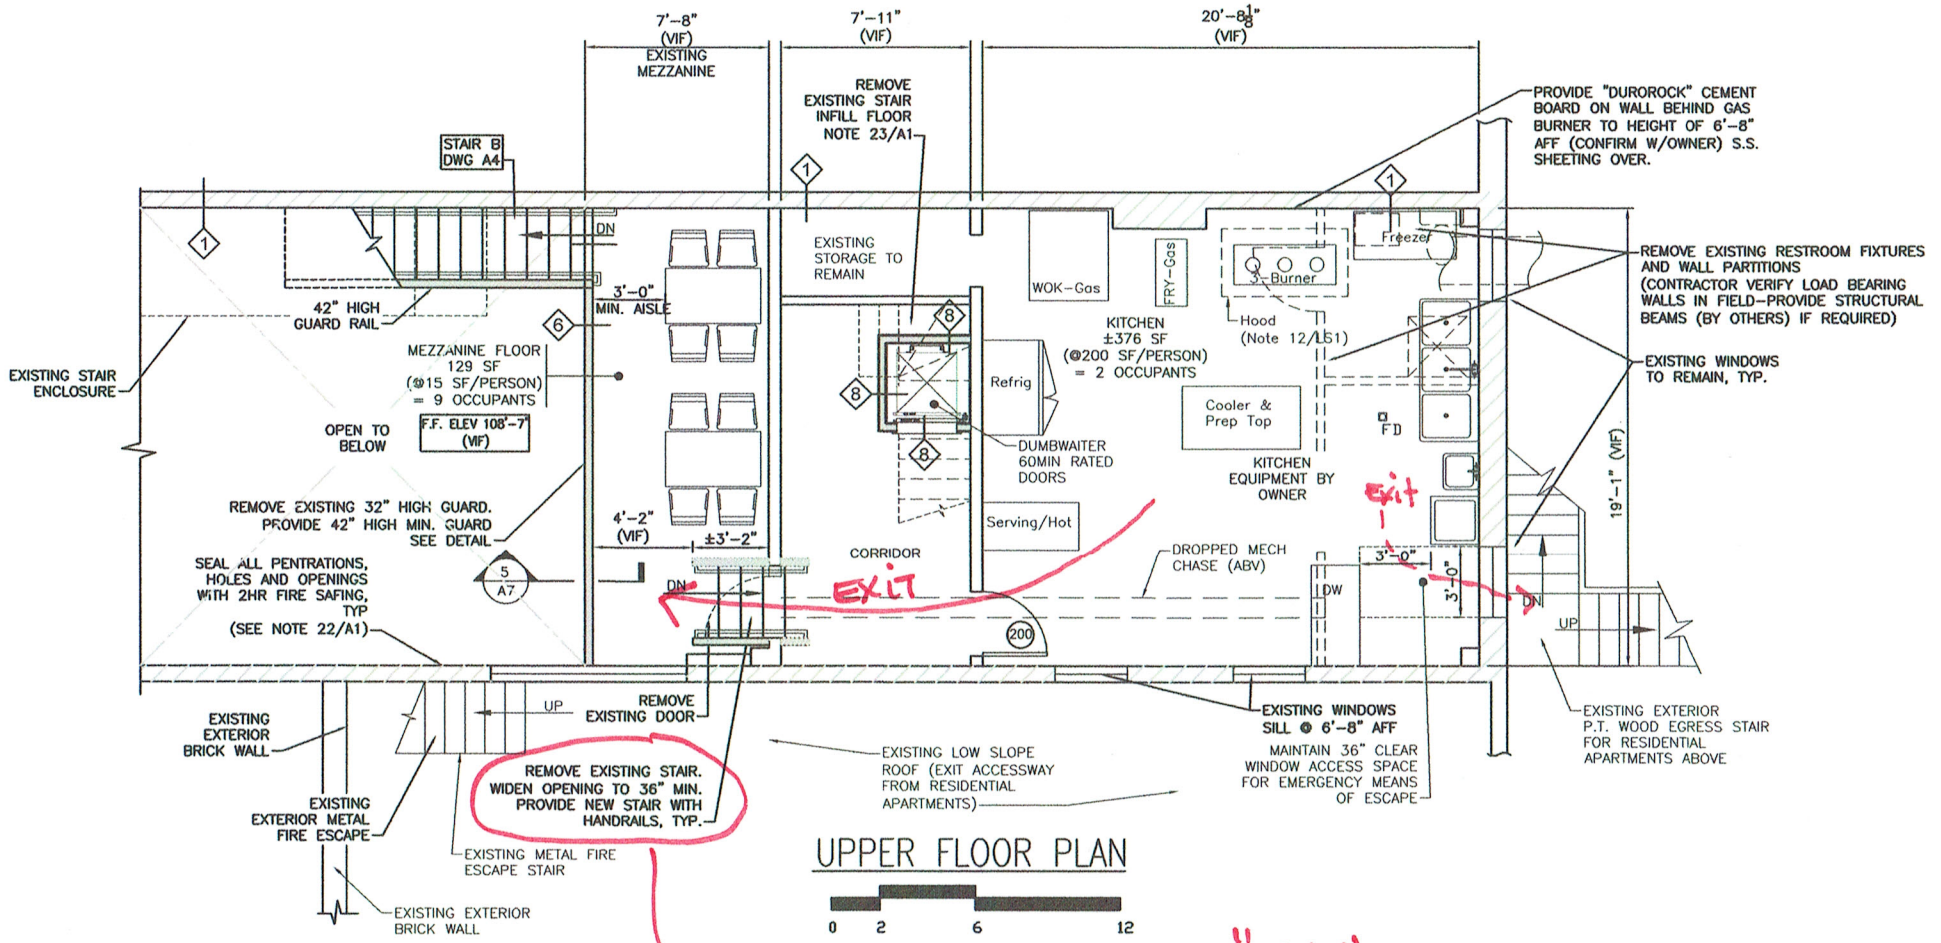

UPPER FLOOR PLAN

0 2 6 12

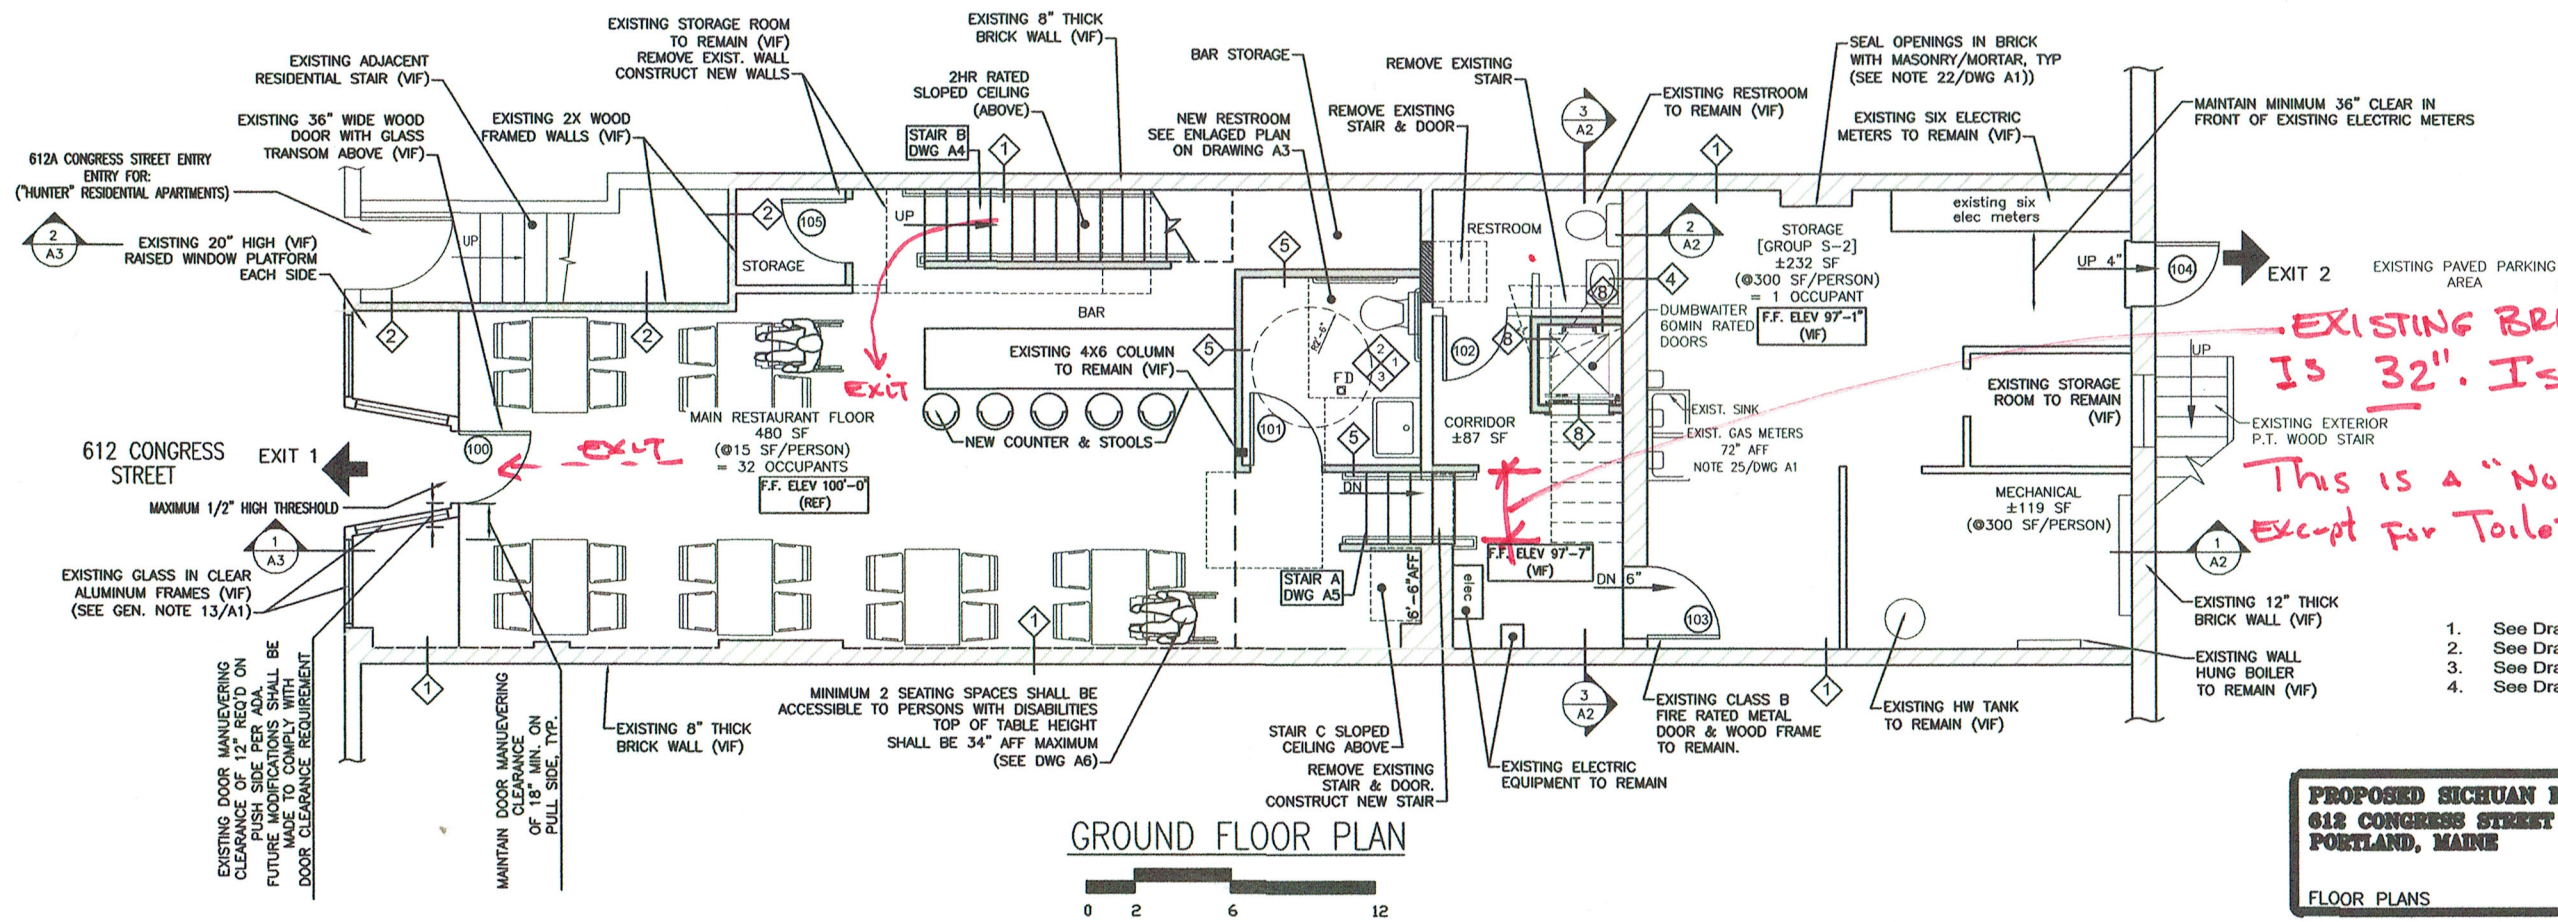

GROUND FLOOR PLAN

0 2 6 12

NOTES

1. See Drawing A1 for General Notes
2. See Drawing A8 for Wall Types
3. See Drawing A9 for Ceiling Types
4. See Drawing A10 for Door Schedule

REGISTERED ARCHITECT JOHN H. LEASURE No. 310 STATE OF MAINE

REV.	DATE	STATUS
	2-04-16	PERMIT SUBMISSION
	2-12-16	PERMIT RESUBMISSION

JOHN H. LEASURE ARCHITECT, INC.
6 Q STREET
SOUTH PORTLAND, MAINE 04106

PROPOSED SICHUAN KITCHEN - RESTAURANT
612 CONGRESS STREET
PORTLAND, MAINE

FLOOR PLANS

A2