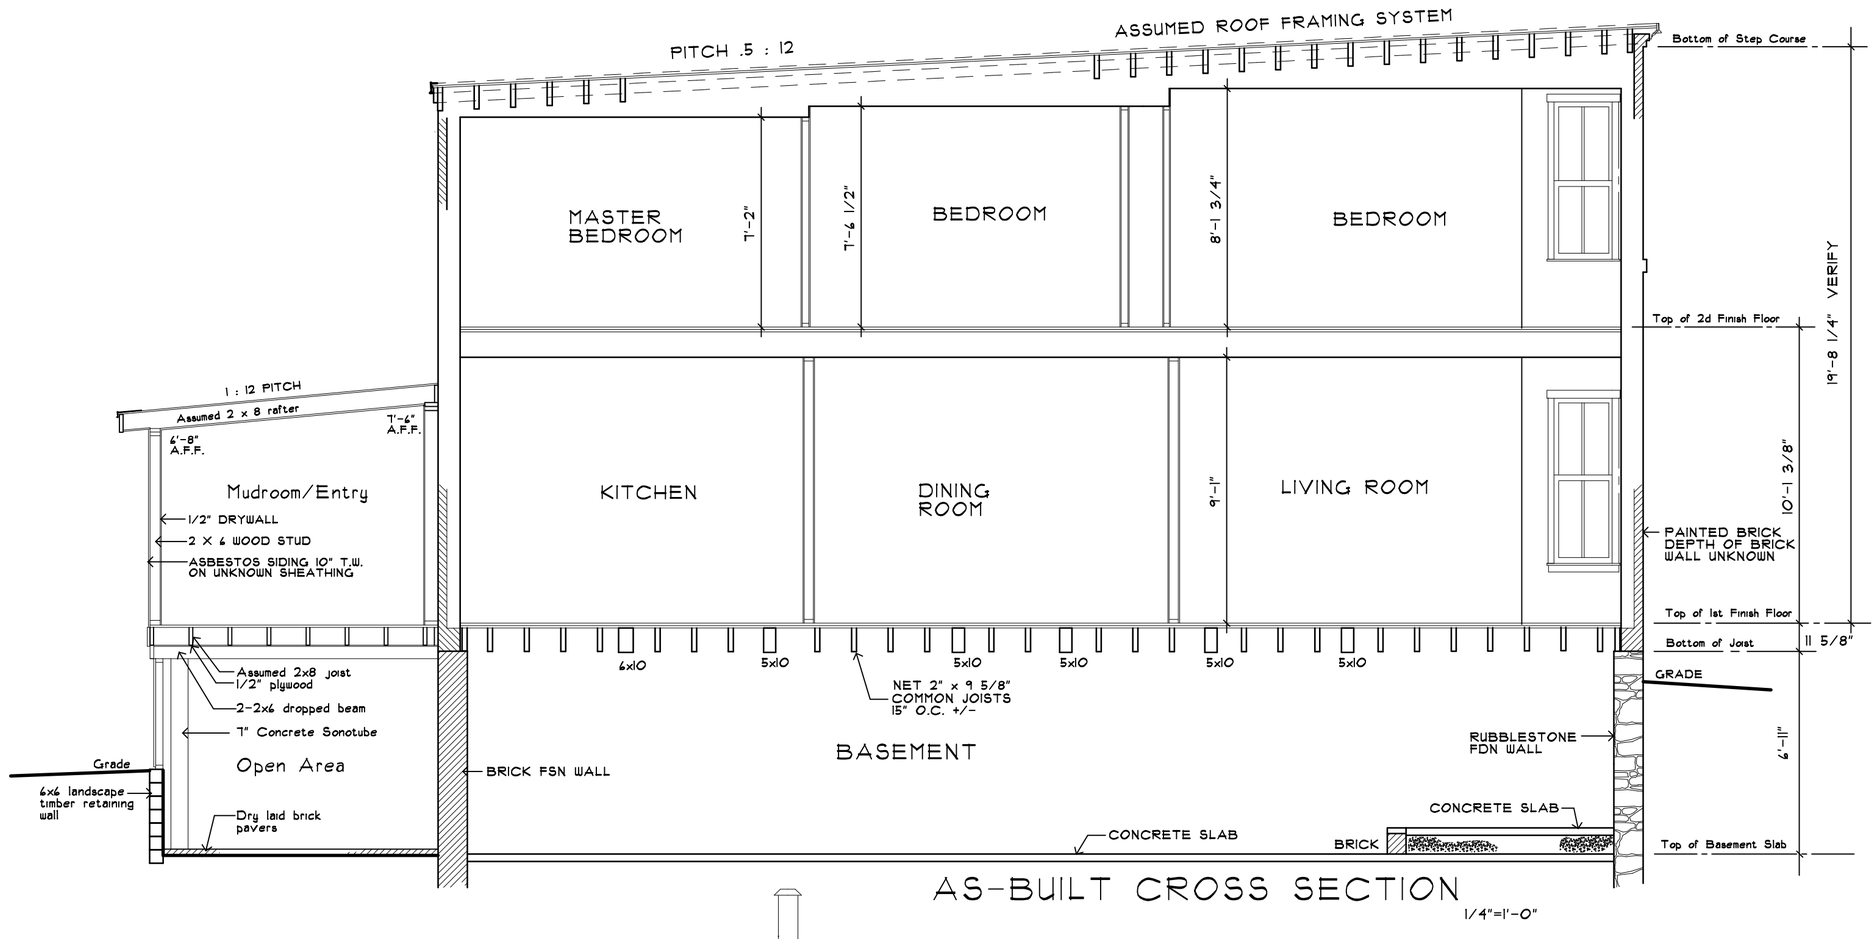

AS-BUILT CROSS SECTION

1/4"=1'-0"

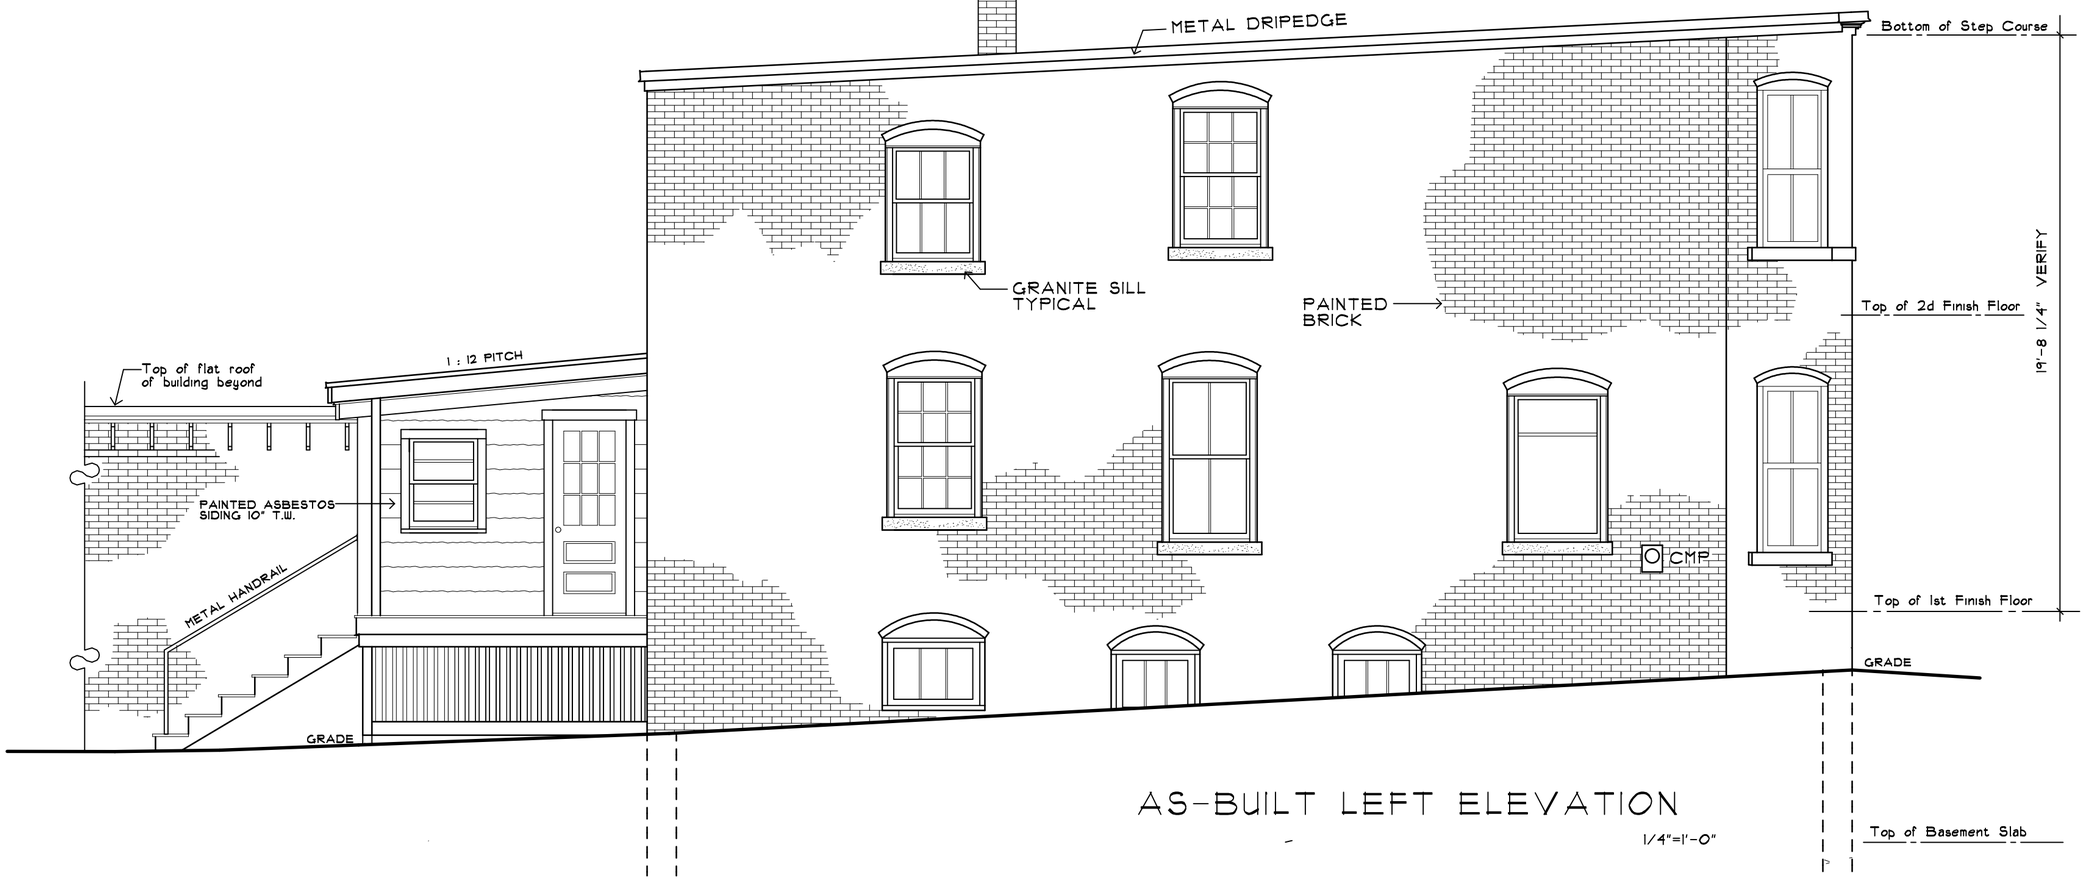

AS-BUILT LEFT ELEVATION

1/4"=1'-0"

4/15/2012

6 Meeting House Lane, WEST BATH, MAINE 04530
JAMES HOARE Architectural Design
Phone (207)443-6251 cell 751-2134

REVISIONS

ALEX FISHER RESIDENCE
67 HIGH STREET
PORTLAND, MAINE

DRAWINGS THIS SHEET
AS-BUILT CROSS SECTION
AS-BUILT ELEVATION

DATE	
Number	
Drawn By	JH
Checked By	

AB-3