


C:\CAD WORKING\3018 - York Street\dwg\3018-Grade.dwg 11/17/2015 11:45 AM

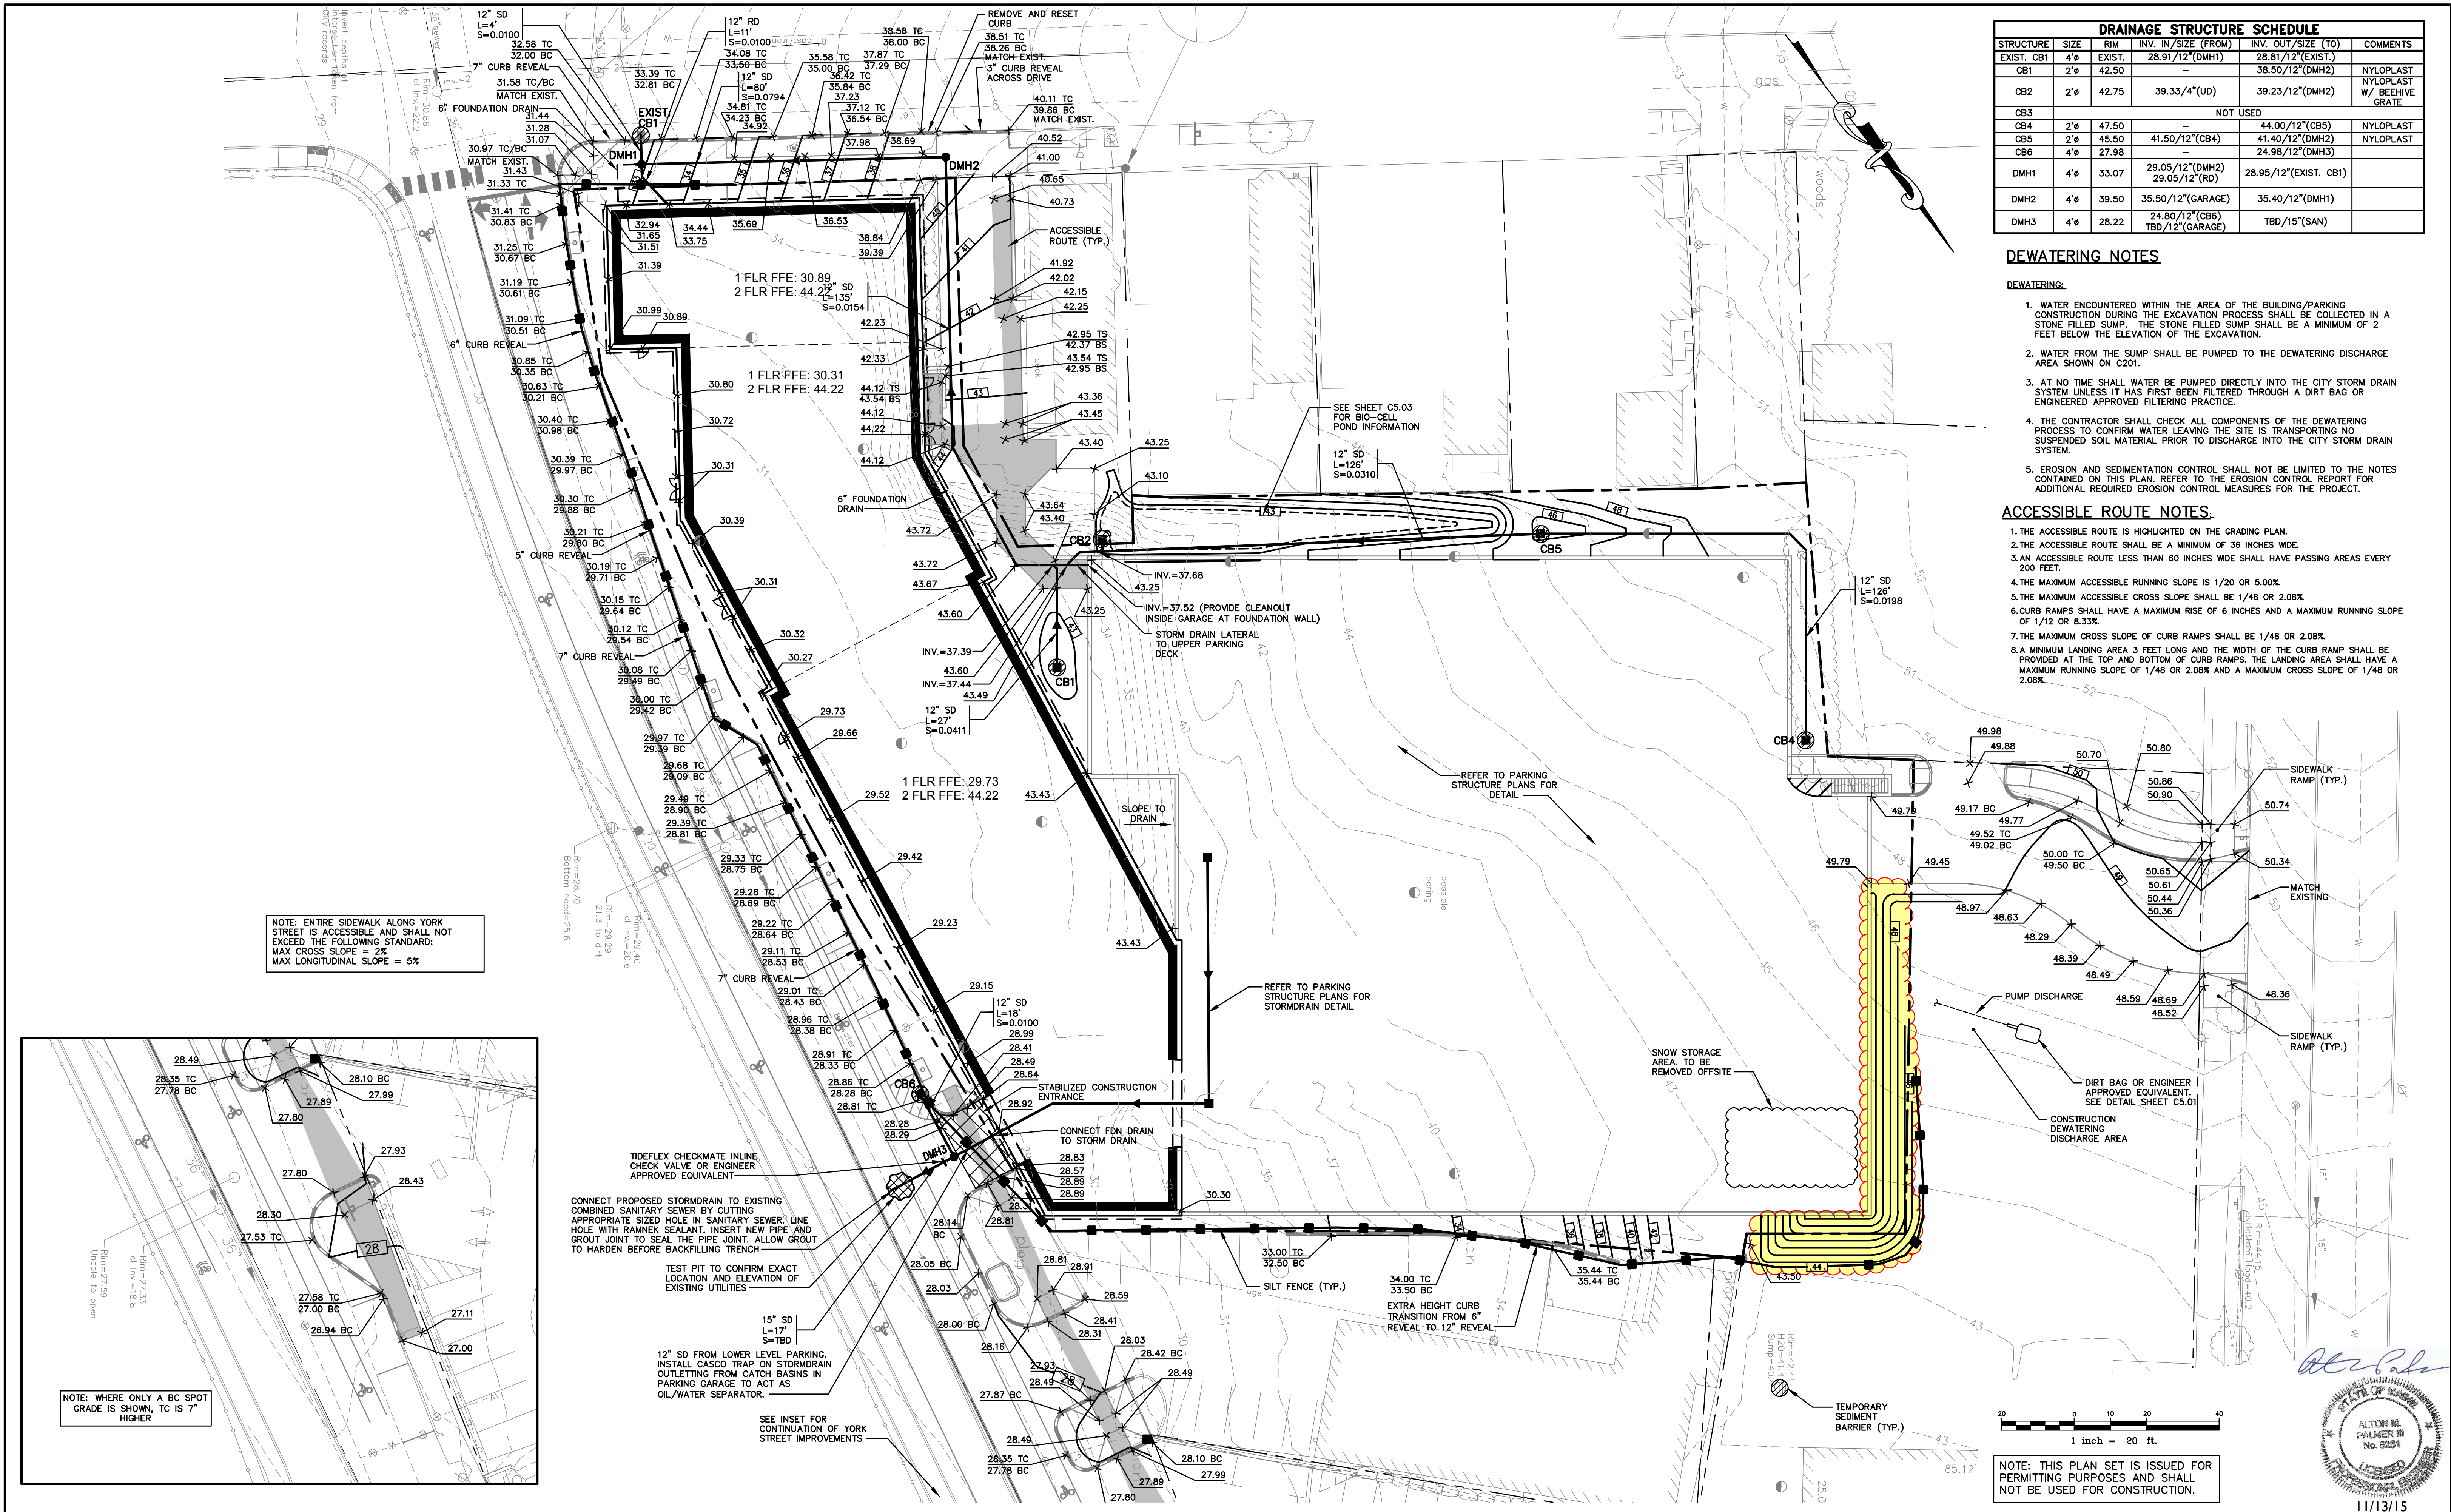

| DRAINAGE STRUCTURE SCHEDULE |      |        |                                   |                       |                            |
|-----------------------------|------|--------|-----------------------------------|-----------------------|----------------------------|
| STRUCTURE                   | SIZE | RIM    | INV. IN./SIZE (FROM)              | INV. OUT./SIZE (TO)   | COMMENTS                   |
| EXIST. CB1                  | 4"   | EXIST. | 28.91/12"(DMH1)                   | 28.81/12"(EXIST.)     |                            |
| CB1                         | 2"   | 42.50  | -                                 | 38.50/12"(DMH2)       | NYLOPLAST W/ BEEHIVE GRADE |
| CB2                         | 2"   | 42.75  | 39.33/4"(UD)                      | 39.23/12"(DMH2)       |                            |
| CB3                         |      |        | NOT USED                          |                       |                            |
| CB4                         | 2"   | 47.50  | -                                 | 44.00/12"(CB5)        | NYLOPLAST                  |
| CB5                         | 2"   | 45.50  | 41.50/12"(CB4)                    | 41.40/12"(DMH2)       | NYLOPLAST                  |
| CB6                         | 4"   | 27.98  | -                                 | 24.98/12"(DMH3)       |                            |
| DMH1                        | 4"   | 33.07  | 29.05/12"(DMH2)<br>29.05/12"(RD)  | 28.95/12"(EXIST. CB1) |                            |
| DMH2                        | 4"   | 39.50  | 35.50/12"(GARAGE)                 | 35.40/12"(DMH1)       |                            |
| DMH3                        | 4"   | 28.22  | 24.80/12"(CB6)<br>TBD/12"(GARAGE) | TBD/15"(SAN)          |                            |

#### DEWATERING NOTES

##### DEWATERING:

1. WATER ENCOUNTERED WITHIN THE AREA OF THE BUILDING/PARKING CONSTRUCTION DURING THE EXCAVATION PROCESS SHALL BE COLLECTED IN A STONE FILLED SUMP. THE STONE FILLED SUMP SHALL BE A MINIMUM OF 2 FEET BELOW THE ELEVATION OF THE EXCAVATION.
2. WATER FROM THE SUMP SHALL BE PUMPED TO THE DEWATERING DISCHARGE AREA SHOWN ON C201.
3. AT NO TIME SHALL WATER BE PUMPED DIRECTLY INTO THE CITY STORM DRAIN SYSTEM UNLESS IT HAS FIRST BEEN FILTERED THROUGH A DIRT BAG OR ENGINEERED APPROVED FILTERING PRACTICE.
4. THE CONTRACTOR SHALL CHECK ALL COMPONENTS OF THE DEWATERING PROCESS TO CONFIRM WATER LEAVING THE SITE IS TRANSPORTING NO SUSPENDED SOIL MATERIAL PRIOR TO DISCHARGE INTO THE CITY STORM DRAIN SYSTEM.
5. EROSION AND SEDIMENTATION CONTROL SHALL NOT BE LIMITED TO THE NOTES CONTAINED ON THIS PLAN. REFER TO THE EROSION CONTROL REPORT FOR ADDITIONAL REQUIRED EROSION CONTROL MEASURES FOR THE PROJECT.

#### ACCESSIBLE ROUTE NOTES:

1. THE ACCESSIBLE ROUTE IS HIGHLIGHTED ON THE GRADING PLAN.
2. THE ACCESSIBLE ROUTE SHALL BE A MINIMUM OF 36 INCHES WIDE.
3. AN ACCESSIBLE ROUTE LESS THAN 60 INCHES WIDE SHALL HAVE PASSING AREAS EVERY 200 FEET.
4. THE MAXIMUM ACCESSIBLE RUNNING SLOPE IS 1/20 OR 5.00%.
5. THE MAXIMUM ACCESSIBLE CROSS SLOPE SHALL BE 1/48 OR 2.08%.
6. CURB RAMPS SHALL HAVE A MAXIMUM RISE OF 6 INCHES AND A MAXIMUM RUNNING SLOPE OF 1/12 OR 8.33%.
7. THE MAXIMUM CROSS SLOPE OF CURB RAMPS SHALL BE 1/48 OR 2.08%.
8. A MINIMUM LANDING AREA 3 FEET LONG AND THE WIDTH OF THE CURB RAMP SHALL BE PROVIDED AT THE TOP AND BOTTOM OF CURB RAMPS. THE LANDING AREA SHALL HAVE A MAXIMUM RUNNING SLOPE OF 1/48 OR 2.08% AND A MAXIMUM CROSS SLOPE OF 1/48 OR 2.08%.

| Rev. | Date     | Revision                  |
|------|----------|---------------------------|
| 1    | 11/13/15 | RESPONSE TO CITY COMMENTS |

| SITE PLAN REVIEW | 8/7/15 | AMP |
|------------------|--------|-----|
| Issued For       | Date   | By  |

|   |               |                 |
|---|---------------|-----------------|
| Design: CEH   | Draft: CG     | Date: JUNE 2015 |
| Checked: AMP   | Scale: 1"=20' | Job No.: 3018   |
| File Name: 3018-Grade.dwg   |               |                 |
| This plan shall not be modified without written permission from Gorrill-Palmer Consulting Engineers, Inc.(GPCEI). Any alterations, authorized or otherwise, shall be at the user's sole risk and without liability to GPCEI. |               |                 |



Relationships. Responsiveness. Results.  
www.gorrillpalmer.com  
207.657.6910


#### Grading, Drainage, and Erosion Control Plan

Project: York Street - Mixed Use Development  
Portland, Maine

Client: York Street, LLC  
36 Danforth Street, Portland, ME 04101

Drawing No.

C4.01

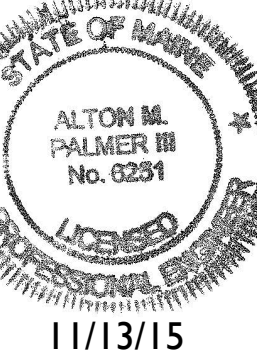

11/13/15