


## As-Built 1st (Lower) Floor Plan

SCALE: 1/4"=1'-0"

0 2 4 8FT.

NOTE: BASEMENT PLAN BASED ON PERMITTED FLOOR PLAN DRAWING

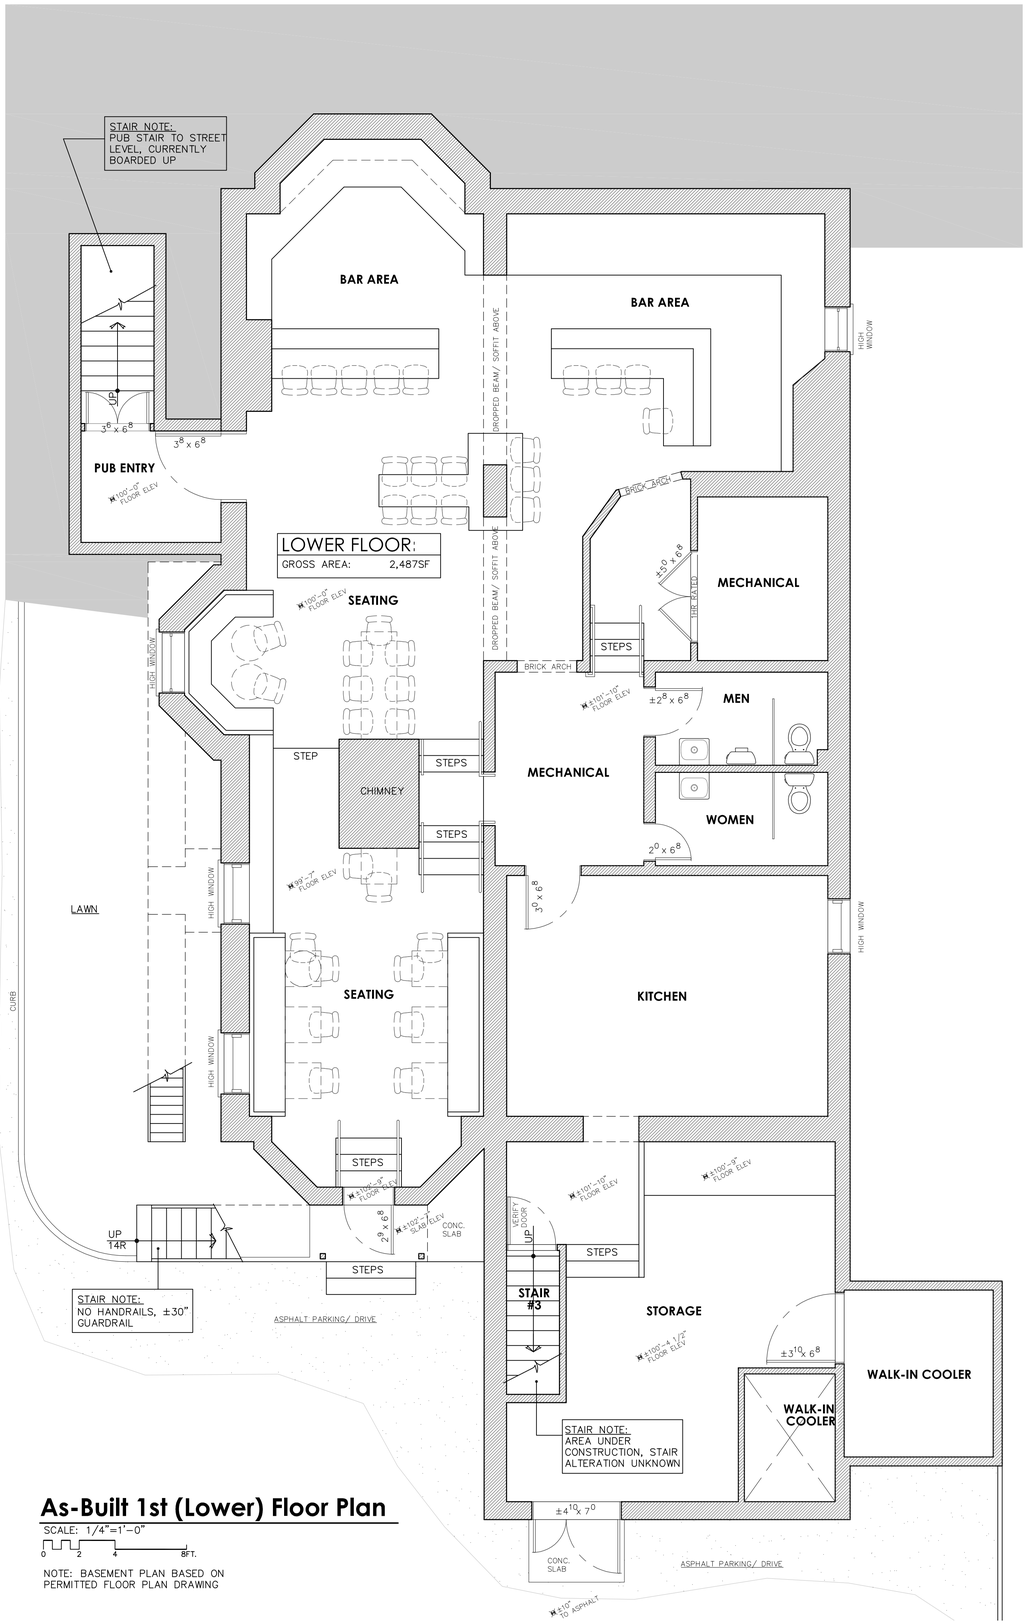


## As-Built 2nd (Street) Floor Plan

SCALE: 1/4"=1'-0"

0 2 4 8FT.


2A architects, llc

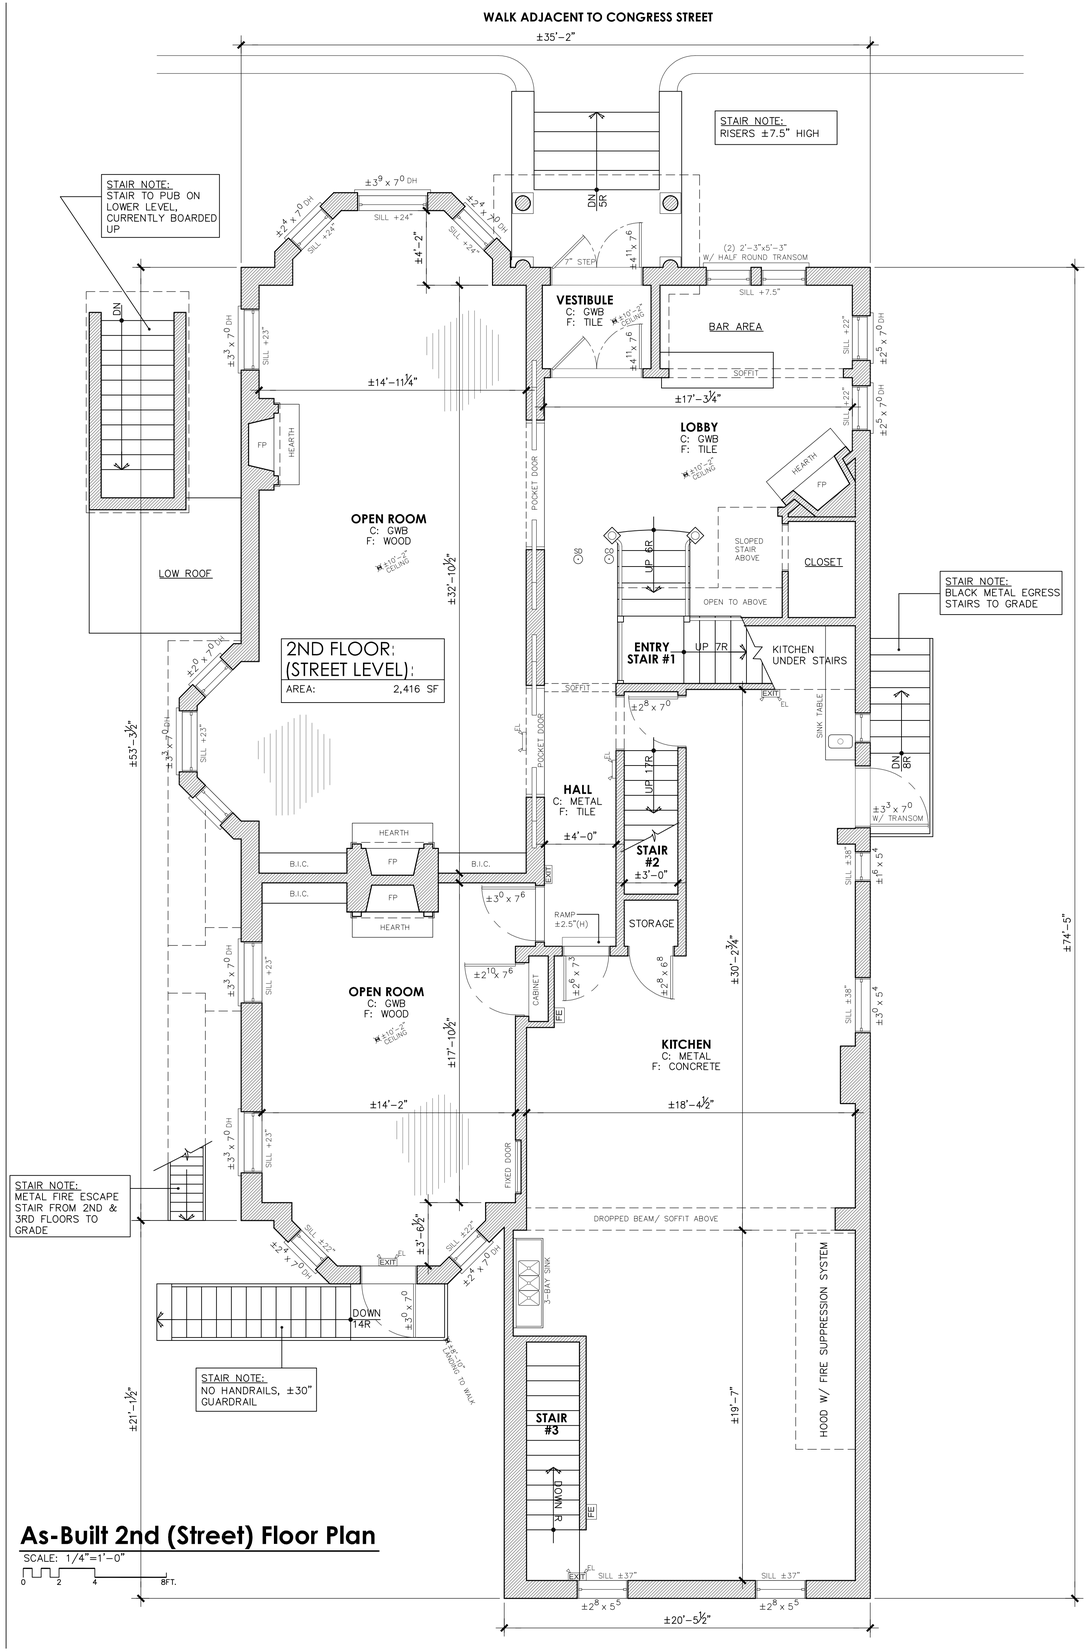724 Rockland Street (Office)
P.O. Box 189 (Mailing)
Rockport, Maine 04856

Tel: 207.236.6545
Web: www.2Aarch.com


©Copyright 2010, 2A architects llc

Registration:

Project:

# 769 Congress Street

**Portland, Maine**

Client ■ Community ■ Environment

Consultant:

**AS-BUILT FOR DESIGN PLANNING ONLY**

Sheet Issue Date:

| | |
|---|---|
| **As-Built Plan Issue** | **09.10.14** |

Project Start Date: **August 2014**

Project Number: **14-119**

Sheet Title:

**AS-BUILT FIRST & SECOND FLOOR**

Sheet Plot Date:

*09/10/2014 AB3.1_769Congress_FirstFlr.dwg*

Sheet Number:

**AB3.0**