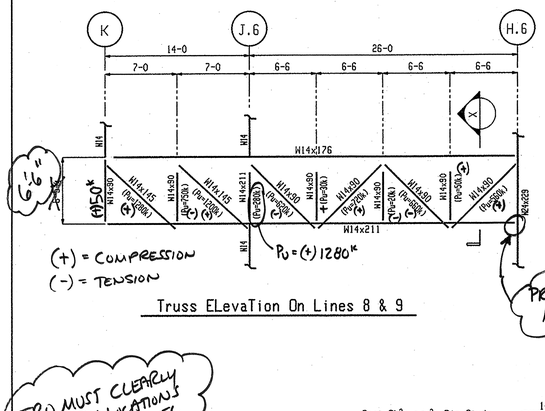

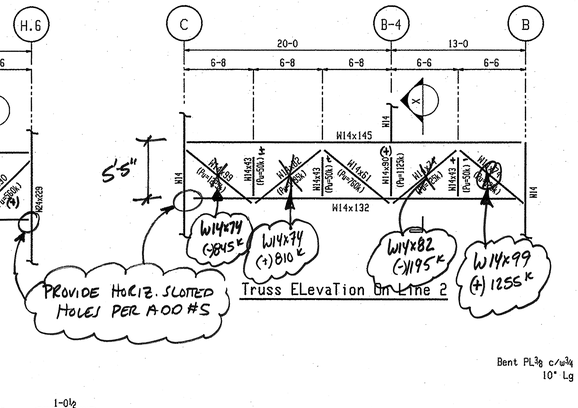

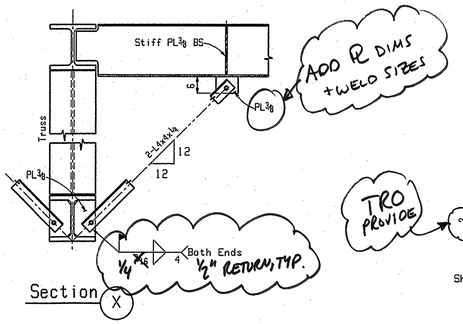

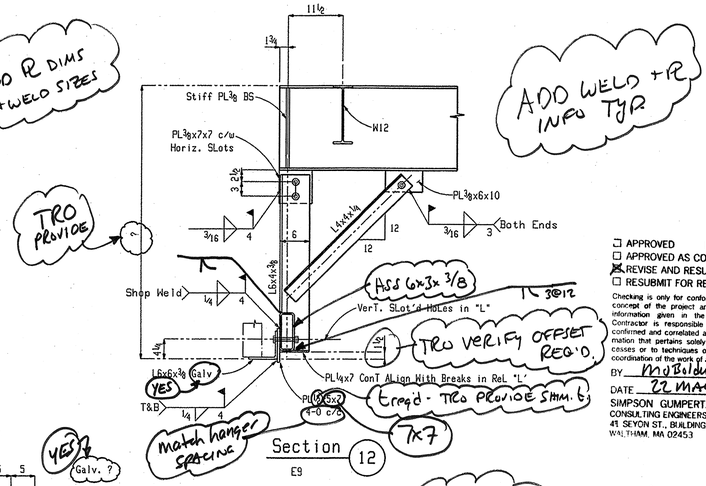

❑ APPROVED ☐ NOT APPROVED
☐ APPROVED AS CORRECTED
☒ REVISE AND RESUBMIT
☐ RESUBMIT FOR RECORD COPY

Checking is only for conformance with the design concept of the project and compliance with the information given in the Contract Documents. Contractor is responsible for dimensions to be confirmed and correlated at the job site; for information that pertains solely to the fabrication processes or to techniques of construction; and for coordination of the work of all trades.

BY Mg Baldwin
DATE 22 MAY 06

SIMPSON GUMPERTZ & HEGER INC
CONSULTING ENGINEERS
41 SEYON ST., BUILDING 1, SUITE 500
WALTHAM, MA 02453

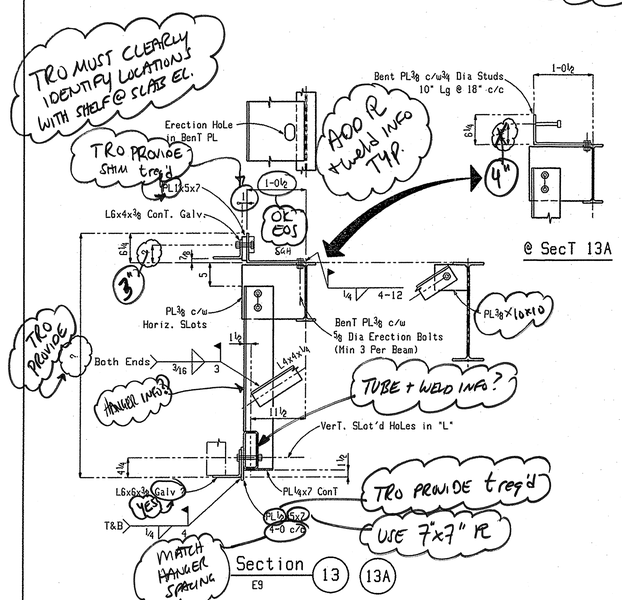

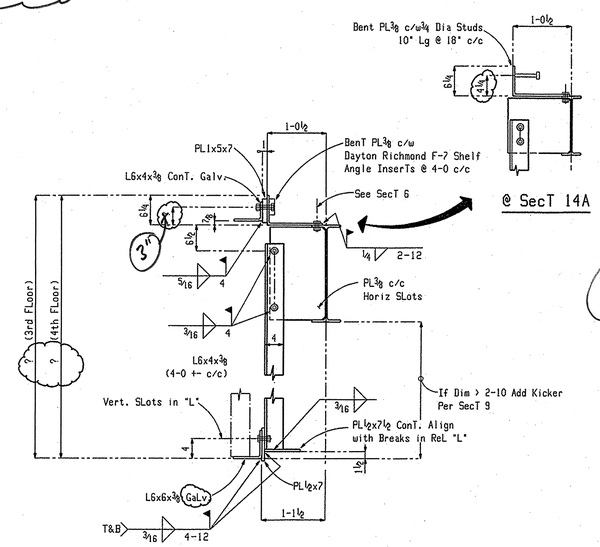

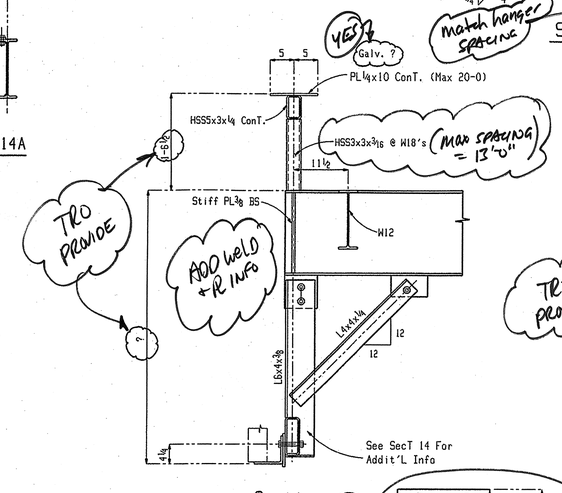

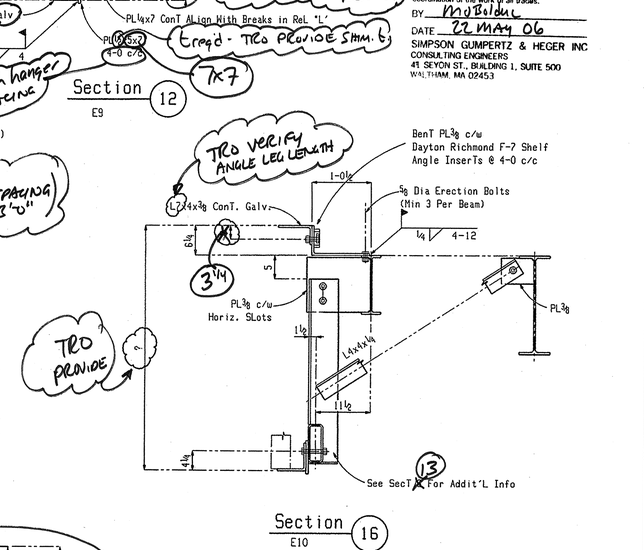

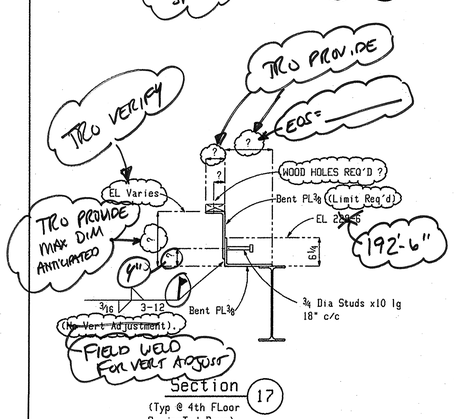

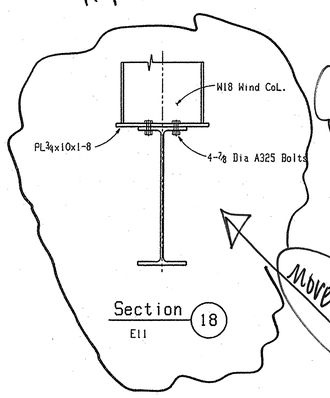

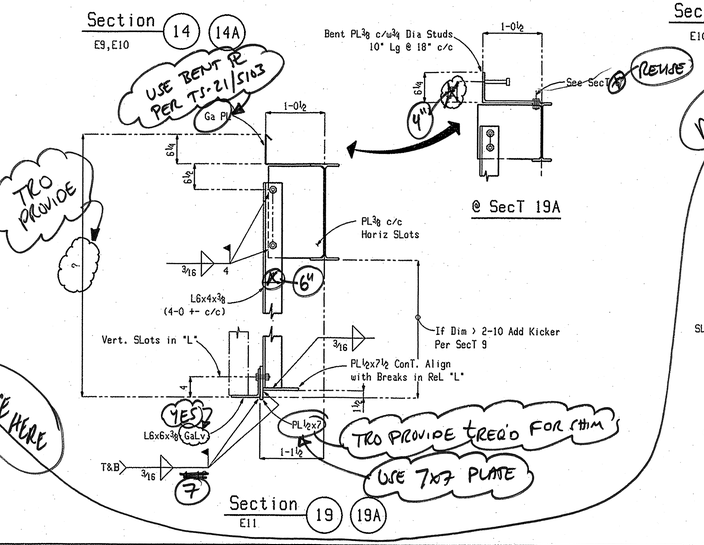

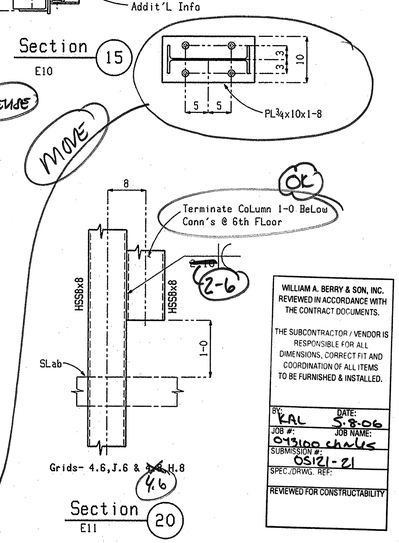

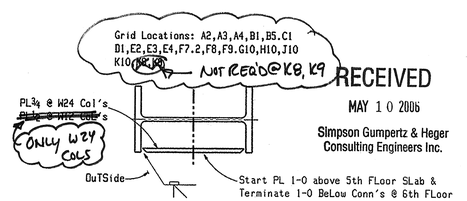

RECEIVED
MAY 10 2006
Simpson Gumpertz & Heger Consulting Engineers Inc.

CoLumn STrengthening DeTaiL

WILLIAM A. BERRY & SON, INC. REVIEWED IN ACCORDANCE WITH THE CONTRACT DOCUMENTS.

THE SUBCONTRACTOR / VENDOR IS RESPONSIBLE FOR ALL DIMENSIONS, CORRECT FIT AND COORDINATION OF ALL ITEMS TO BE FURNISHED & INSTALLED.

BY: KAL DATE: 5.8.06
JOB #: 049100 JOB NAME: charles
SUBMISSION #: 05121-21
SPEC/DRWG. REF:
REVIEWED FOR CONSTRUCTABILITY

FOR APPROVAL
MAY 02 2006

Revisions		
No.	Date	Description

NOVEL IRON WORKS
250 Ocean Road
Greenland, NH 03840

	Holes 13/16(uno)	Weld ER70S	AISC Certified Category III
Project	Maine Medical Center		Date: Apl-06
Description	SecTions & DeTaiLs		Drawn By JD
Architect	TRO		Chk By W.J.L
Engineer	Simpson Gumpertz & Heger Inc.		Job No. 316
Customer	William Berry & Son Inc.		Sht. No. E16